



**Oregon Water Resources
Department**
725 Summer Street NE, Suite A
Salem, Oregon 97301-1266
(503) 986-0900
www.wrd.state.or.us

District Permanent Water Right Transfer Claim of Beneficial Use

1. APPLICANT INFORMATION

District: CENTRAL OREGON IRRIGATION DISTRICT

Contact Person: LESLIE CLARK

Phone: 541-548-6047

Mailing Address: 1055 SW LAKE COURT

City: REDMOND

State: OR

Zip: 97756

E-Mail address:

lesliec@coid.org

Transfer Number: T - 11660

2. WATER RIGHT(S)

Pursuant to OAR Chapter 690, Division 385, the district is submitting to the Water Resources Department this claim of beneficial use, with the appropriate fee, for the following water right(s):

PERMIT NUMBER	CERTIFICATE NUMBER	DECREE (name, volume, and page)	PRIMARY (P) OR SUPP (S)
-	83571		<input checked="" type="checkbox"/> P <input type="checkbox"/> S
-	76714		<input type="checkbox"/> P <input checked="" type="checkbox"/> S
-			<input type="checkbox"/> P <input type="checkbox"/> S
-			<input type="checkbox"/> P <input type="checkbox"/> S

3. AUTHORIZED POINT(S) OF DIVERSION (POD) / APPROPRIATION (POA)

The authorized point(s) of diversion / appropriation for the water right modified by the transfer are as follows:

PERMIT NUMBER	DECREE or CERTIFICATE	POD / POA #	SOURCE	LOCATION - MEASURED DISTANCES
-	83571	1	Deschutes River	SW ¼ NE ¼ SEC. 13, T. 18 S., R. 11 E., W.M.; 1520' S. & 1535' W. FROM THE NE CORNER OF SEC. 13
-	83571	11	Deschutes River	SE ¼ NE ¼ SEC. 29, T. 17 S., R. 12 E., W.M.; 850' N. AND 630' W. FROM THE E ¼ CORNER OF SEC. 29
-				
-				

RECEIVED BY OWRD

September 2, 2016

Kate Fitzgerald
Oregon Water Resources Department
725 Summer St NE Ste 100
Salem, OR 97301-1271

RE: FINAL PROOFS – Claim of Beneficial Use for T-11660

Dear Kate,

Central Oregon Irrigation District is submitting our claim of beneficial use for a permanent District transfer ("385").


Attached is a list of the "ON" lands. Site reports are attached to each map and any specific details about the properties are contained in each site report.

Please Note: The below noted properties have had the following changes:

- 1) 14-13-32 NENW 00102: Change of Ownership – current owners are John and Diane Kiesler.
- 2) 14-13-32 NWNE 00500: Change of Ownership – current owners are Steven and Terri Ahlberg.
- 3) 17-12-25 NWNE 00202: Change of Ownership – current owners are Karl and Brenda Scronce.
- 4) 18-13-12 NESW 00603: Change of Ownership – current owners are Peter Lupi and Kelly Riley.

The District has inspected all of the above parcels to confirm that the changes have been made as mapped and contained in the final proof report.

I am authorized to sign on behalf of Central Oregon Irrigation District.



Craig Horrell
District Manager, Central Oregon Irrigation District

Date: 9-2-16

RECEIVED BY OWRD

SEP 12 2016

SALEM, OR

T-11660 "On Lands"

PRIMARY SUPP	TRANSFER NBR	POD	USE	TWP	RNG	SEC	QQ	LOT	ACRES	Applicant	Current Owner	
83571	76714	T-2013-003	#11	IRRIG	14	13	20	SWNE	00203	0.70	Every, Jeff/Kristy	
83571	76714	T-2013-002	#11	IRRIG	14	13	32	NENW	00102	0.50	Hatchell, Rodney G./Michele R	Kiesler, John and Diane
83571	76714	T-2013-002	#11	IRRIG	14	13	32	NENW	00102	1.20	Hatchell, Rodney G./Michele R	Kiesler, John and Diane
83571	76714	T-2013-002	#11	IRRIG	14	13	32	NWNE	00500	3.35	Hatchell, Rodney G./Michele R	Ahlberg, Steven & Terri
83571	76714	T-2013-006	#1	IRRIG	17	12	25	NWNE	00202	1.16	Judson, Joel/Tabree	Scronce,Karl & Brenda
83571	76714	T-2013-006	#1	IRRIG	17	12	25	NWNE	00202	1.10	Judson, Joel/Tabree	Scronce,Karl & Brenda
83571	76714	T-2013-006	#1	IRRIG	17	12	25	NWNE	00202	0.74	Judson, Joel/Tabree	Scronce,Karl & Brenda
83571	76714	T-2013-006	#1	IRRIG	17	12	25	NWNE	00202	0.25	Judson, Joel/Tabree	Scronce,Karl & Brenda
83571	76714	T-2013-006	#1	IRRIG	17	12	25	NWNE	00202	0.23	Judson, Joel/Tabree	Scronce,Karl & Brenda
83571	76714	T-2013-006	#1	IRRIG	17	12	25	NWNE	00202	0.12	Judson, Joel/Tabree	Scronce,Karl & Brenda
83571	76714	T-2013-001	#1	IRRIG	17	14	22	NESE	00801	0.60	Nelsen, Jean	
83571	76714	T-2013-001	#1	IRRIG	17	14	22	NESE	00801	0.01	Nelsen, Jean	
83571	76714	T-2013-001	#1	IRRIG	17	14	22	SENE	00801	1.48	Nelsen, Jean	
83571	76714	T-2013-007	#1	IRRIG	18	13	05	NESW	00700	2.24	Leisz, Bruce Kimball Family Trust	
83571	76714	T-2013-007	#1	IRRIG	18	13	05	NESW	00700	0.75	Leisz, Bruce Kimball Family Trust	
83571	76714	T-2013-007	#1	IRRIG	18	13	05	NESW	00700	0.70	Leisz, Bruce Kimball Family Trust	
83571	76714	T-2013-007	#1	IRRIG	18	13	05	NESW	00700	0.48	Leisz, Bruce Kimball Family Trust	
83571	76714	T-2013-007	#1	IRRIG	18	13	05	NESW	00700	0.25	Leisz, Bruce Kimball Family Trust	
83571	76714	T-2013-005	#1	IRRIG	18	13	12	NESW	00603	0.51	Roy, James/Nannette	Lupi, Peter and Riley, Kelly

RECEIVED BY OWRD
 SEP 12 2016
 SALEM, OR

FINAL PROOF SITE REPORT

Claim of Beneficial Use

Property Owner (Applicant): Every, Jeff R. & Kristy L.

Petition #: P-2013-001

Current Owner: **SAME**

OWRD#: T-11660

Property Address: 2675 NW Odem Ave, Terrebonne

Notice #: T-2013-003

POD	USE	HG	TWP	RNG	SEC	QQ	TAX LOT	ACRES
11	IRRIG	F-6-1	14	13	20	SWNE	203	0.7

- Person interviewed (if any): None
- Method of irrigation (pump, flood, etc): Flood
- Use (crops produced): Pasture grass
- Method used to calculate area irrigated: GPS
- Is beneficial use achieved: Yes
- Are there any mapping changes: No
- Dated photos of beneficial use: _____

IF NO:

- Failure to Prove up _____ acres of transferred water right
- Extension Filed: _____

NOTES:

RECEIVED BY OWRD

SEP 12 2016

SALEM, OR

Final Inspection by: AW Date: 02/10/14



2013 AERIAL PHOTO
TAKEN: JULY 9, 2013



WATER RIGHTS MAP

TAX MAP: 141320 SWNE 203
TOTAL WATER RIGHTS: 0.7 ac.
EVERY, JEFF & KRISTY

1 inch = 150 feet

RECEIVED BY OWRD

SEP 12 2016

SALEM, OR

Legend

- | | |
|-----------------|--------------------|
| TAXLOTS | PETITIONED_ON |
| IL | PETITIONED_ON POND |
| INSTREAM | QC |
| PENDING_OFF | QC-INSTREAM |
| PENDING_ON | TP-OFF |
| PENDING_ON POND | TP-ON |

FINAL PROOF SITE REPORT

Claim of Beneficial Use

Property Owner (Applicant): Hatchell, Rodney & Michelle
 Current Owner: Kiesler, John & Diane
 Property Address: 2828 NW Coyner Ave, Redmond

Petition #: P-2013-001
 OWRD#: T-11660
 Notice #: T-2013-002

POD	USE	HG	TWP	RNG	SEC	QQ	TAX LOT	ACRES
11	IRRIG	C-28	14	13	32	NENW	102	1.7

- Person interviewed (if any): None
- Method of irrigation (pump, flood, etc): Flood
- Use (crops produced): Grass, Hay
- Method used to calculate area irrigated: GPS
- Is beneficial use achieved: Yes
- Are there any mapping changes: No
- Dated photos of beneficial use: _____

IF NO:

- Failure to Prove up _____ acres of transferred water right
- Extension Filed: _____

NOTES:

RECEIVED BY OWRD

SEP 12 2013

SALEM, OR

Final Inspection by: [Signature] Date: 06/10/14



2013 AERIAL PHOTO
TAKEN: JULY 9, 2013



WATER RIGHTS MAP

TAX MAP: 141332 NEW 102
TOTAL WATER RIGHTS: 0.7 ac.
KIESLER, JOHN & DIANE

1 inch = 100 feet

RECEIVED BY OWRD

SEP 12 2016

SALEM, OR

Legend

- | | |
|-----------------|--------------------|
| TAXLOTS | PETITIONED_ON |
| IL | PETITIONED_ON POND |
| INSTREAM | QC |
| PENDING_OFF | QC-INSTREAM |
| PENDING_ON | TP-OFF |
| PENDING_ON POND | TP-ON |

Deschutes County Property Information

Sales for account # 128547

The Deschutes County Assessor's Office is responsible for the appraisal and assessment of all taxable property within the County. Contact this department if you need additional information or if you have questions.

Account Information

Mailing Name: KIESLER, JOHN M & DIANE L
 Map and Taxlot: 1413320000100
 Account: 128547
 Situs Address: 2828 NW COYNER AVE, REDMOND, OR 97756
 Tax Status: Assessable

Sales History

View more recently recorded transactions - Clerks Office Web Query

Sale Date	Seller	Buyer	Sale Amount	Sale Type	Recording Instrument
07/03/2013	HATCHELL FAMILY LIVING TRUST	KIESLER, JOHN M & DIANE L	\$395,000	35-MULTIPLE ACCOUNTS INVOLVED IN SALE	2013-28201
05/02/2013	AHLBERG, STEVEN J & TERRIE	HATCHELL, RODNEY G TTEE ET AL	\$0	06-GRANTEE IS RELATED/FRIENDS /BUSINESS ASSOCIATES	2013-18085
04/16/2013	HATCHELL FAMILY LIVING TRUST	AHLBERG, STEVEN J & TERRIE	\$710,000	14-RE-RECORDING/OTHER /CONSIDERATION UNDER \$500	2013-15680
02/04/2013	HATCHELL FAMILY LIVING TRUST	HATCHELL, RODNEY G & MICHELE R TTEES	\$0	08-GRANTOR/GRANTEE ARE THE SAME	2013-5112
12/17/2009	HATCHELL, RODNEY G & MICHELE R	HATCHELL, RODNEY G & MICHELE R TTEE	\$0	08-GRANTOR/GRANTEE ARE THE SAME	2009-53958
05/23/2008	RODNEY G HATCHELL AND MICHELE R ... ETAL	HATCHELL, RODNEY G & MICHELE R	\$0	08-GRANTOR/GRANTEE ARE THE SAME	2008-24330
03/28/2003	HATCHELL, RODNEY G	HATCHELL, RODNEY G TRUSTEE OF RODNEY G HA	\$0	08-GRANTOR/GRANTEE ARE THE SAME	2003-21172
03/21/2003	TANNER, EARL C JR TRUSTEE OF TANNER FAMILY REVOCABL	HATCHELL, RODNEY G	\$405,000	35-MULTIPLE ACCOUNTS INVOLVED IN SALE	2003-19341
02/11/1997	TANNER, EARL C JR	TANNER, EARL C JR TRUSTEE OF TANNER FAMIL	\$0	08-GRANTOR/GRANTEE ARE THE SAME	1997-4390109
10/14/1991	TANNER EARL C	TANNER, EARL C JR	\$50,000	06-GRANTEE IS RELATED/FRIENDS /BUSINESS ASSOCIATES	1991-2471977

THE INFORMATION AND MAPS ACCESSED THROUGH THIS WEB SITE PROVIDE A VISUAL DISPLAY FOR YOUR CONVENIENCE. EVERY REASONABLE EFFORT HAS BEEN MADE TO ASSURE THE ACCURACY OF THE MAPS AND ASSOCIATED DATA. DESCHUTES COUNTY MAKES NO WARRANTY, REPRESENTATION OR GUARANTEE AS TO THE CONTENT, SEQUENCE, ACCURACY, TIMELINESS OR COMPLETENESS OF ANY OF THE DATA PROVIDED HEREIN. DESCHUTES COUNTY EXPLICITLY DISCLAIMS ANY REPRESENTATIONS AND WARRANTIES, INCLUDING, WITHOUT LIMITATION, THE IMPLIED WARRANTIES OF MERCHANTABILITY AND FITNESS FOR A PARTICULAR PURPOSE. DESCHUTES COUNTY SHALL ASSUME NO LIABILITY FOR ANY ERRORS, OMISSIONS, OR INACCURACIES IN THE INFORMATION PROVIDED REGARDLESS OF HOW CAUSED. DESCHUTES COUNTY ASSUMES NO LIABILITY FOR ANY DECISIONS MADE OR ACTIONS TAKEN OR NOT TAKEN BY THE USER OF THIS INFORMATION OR DATA FURNISHED HEREUNDER.

© 2016 - Deschutes County. All rights reserved.

RECEIVED BY OWRD

SEP 12 2016

SALEM, OR

FINAL PROOF SITE REPORT

Claim of Beneficial Use

Property Owner (Applicant): Hatchell, Rodney & Michelle
 Current Owner: Ahlberg, Steven & Terri
 Property Address: 2550 NW Coyner Ave, Redmond

Petition #: P-2013-001
 OWRD#: T-11660
 Notice #: T-2013-002

POD	USE	HG	TWP	RNG	SEC	QQ	TAX LOT	ACRES
11	IRRIG	C-28	14	13	32	NWNE	500	3.35

- Person interviewed (if any): Terri Ahlberg
- Method of irrigation (pump, flood, etc): pump / sprinkle
- Use (crops produced): pasture
- Method used to calculate area irrigated: GPS
- Is beneficial use achieved: yes
- Are there any mapping changes: NO
- Dated photos of beneficial use: 7/17/15

IF NO:

- Failure to Prove up _____ acres of transferred water right
- Extension Filed: _____

NOTES:

RECEIVED BY OWRD
 SEP 12 2016
 SALEM, OR

Final Inspection by: Jenny Hayslett Hill Date: 7/17/15



2013 AERIAL PHOTO
TAKEN: JULY 9, 2013



WATER RIGHTS MAP

TAX MAP: 141332 NWNE 500
TOTAL WATER RIGHTS: 2.35 ac.
AHLBERG, STEVEN & TERRI

1 inch = 200 feet

SEP 2 2016

SALEM, OR

Legend

- | | |
|-----------------|--------------------|
| TAXLOTS | PETITIONED_ON |
| IL | PETITIONED_ON POND |
| INSTREAM | QC |
| PENDING_OFF | QC-INSTREAM |
| PENDING_ON | TP-OFF |
| PENDING_ON POND | TP-ON |

Deschutes County Property Information

Sales for account # 128574

The Deschutes County Assessor's Office is responsible for the appraisal and assessment of all taxable property within the County. Contact this department if you need additional information or if you have questions.

Account Information

Mailing Name: AHLBERG, STEVEN J & TERRIE
 Map and Taxlot: 141332A000500
 Account: 128574
 Situs Address: 2550 NW COYNER AVE, REDMOND, OR 97756
 Tax Status: Assessable

Sales History

View more recently recorded transactions - Clerks Office Web Query

Sale Date	Seller	Buyer	Sale Amount	Sale Type	Recording Instrument
05/02/2013	HATCHELL FAMILY LIVING TRUST	AHLBERG, STEVEN J & TERRIE	\$710,000	30-UNCONFIRMED SALE	2013-18086
02/04/2013	HATCHELL FAMILY LIVING TRUST	HATCHELL, RODNEY G & MICHELE R TEES	\$0	08-GRANTOR/GRANTEE ARE THE SAME	2013-5113
12/17/2009	HATCHELL, RODNEY G & MICHELE R	HATCHELL, RODNEY G & MICHELE R TEE	\$0	08-GRANTOR/GRANTEE ARE THE SAME	2009-53958
05/23/2008	RODNEY G HATCHELL AND MICHELE R... ETAL	HATCHELL, RODNEY G & MICHELE R	\$0	08-GRANTOR/GRANTEE ARE THE SAME	2008-24330
03/28/2003	HATCHELL, RODNEY G	HATCHELL, RODNEY G TRUSTEE OF RODNEY G HA	\$0	08-GRANTOR/GRANTEE ARE THE SAME	2003-21172
03/21/2003	TANNER, EARL C JR TRUSTEE OF TANNER FAMILY REVOCABL	HATCHELL, RODNEY G	\$405,000	35-MULTIPLE ACCOUNTS INVOLVED IN SALE	2003-19941
02/11/1997	TANNER, EARL C JR	TANNER, EARL C JR TRUSTEE OF TANNER FAMIL	\$0	08-GRANTOR/GRANTEE ARE THE SAME	1997-4390109
10/14/1991	TANNER EARL C	TANNER, EARL C JR	\$50,000	06-GRANTEE IS RELATED/FRIENDS /BUSINESS ASSOCIATES	1991-2471977

THE INFORMATION AND MAPS ACCESSED THROUGH THIS WEB SITE PROVIDE A VISUAL DISPLAY FOR YOUR CONVENIENCE. EVERY REASONABLE EFFORT HAS BEEN MADE TO ASSURE THE ACCURACY OF THE MAPS AND ASSOCIATED DATA. DESCHUTES COUNTY MAKES NO WARRANTY, REPRESENTATION OR GUARANTEE AS TO THE CONTENT, SEQUENCE, ACCURACY, TIMELINESS OR COMPLETENESS OF ANY OF THE DATA PROVIDED HEREIN. DESCHUTES COUNTY EXPLICITLY DISCLAIMS ANY REPRESENTATIONS AND WARRANTIES, INCLUDING, WITHOUT LIMITATION, THE IMPLIED WARRANTIES OF MERCHANTABILITY AND FITNESS FOR A PARTICULAR PURPOSE. DESCHUTES COUNTY SHALL ASSUME NO LIABILITY FOR ANY ERRORS, OMISSIONS, OR INACCURACIES IN THE INFORMATION PROVIDED REGARDLESS OF HOW CAUSED. DESCHUTES COUNTY ASSUMES NO LIABILITY FOR ANY DECISIONS MADE OR ACTIONS TAKEN OR NOT TAKEN BY THE USER OF THIS INFORMATION OR DATA FURNISHED HEREUNDER.

© 2016 - Deschutes County. All rights reserved.

RECEIVED BY OWRD

SEP 12 2016

SALEM, OR

FINAL PROOF SITE REPORT

Claim of Beneficial Use

Property Owner (Applicant): JUDSON, JOEL + TABREE
~~Seronce, Karl & Brenda~~
 Current Owner: SERONCE, KARL + BRENDA
 Property Address: 21800 Paloma Dr, Bend

Petition #: P-2013-001
 OWRD#: T-11660
 Notice #: T-2013-006

POD	USE	HG	TWP	RNG	SEC	QQ	TAX LOT	ACRES
1	IRRIG	A-24-9-3	17	12	25	NWNE	202	3.6

- Person interviewed (if any): _____
- Method of irrigation (pump, flood, etc): Pump / Sprinkle
- Use (crops produced): pasture / garden / oats
- Method used to calculate area irrigated: GPS
- Is beneficial use achieved: Yes
- Are there any mapping changes: NO
- Dated photos of beneficial use: 7/22/15

IF NO:

- Failure to Prove up _____ acres of transferred water right
- Extension Filed: _____

NOTES:

RECEIVED BY OWRD
 SEP 12 2015
 SALEM, OR

Final Inspection by: *Jenny Hartzell* Date: 7/22/15



RECEIVED BY OWRD



2013 AERIAL PHOTO
TAKEN: JULY 9, 2013



WATER RIGHTS MAP

TAX MAP: 171225 NWNE 202
 TOTAL WATER RIGHTS: 3.6 ac.
 SCRONCE, KARL & BRENDA

SEP 12 2016
 SALEM, OR

1 inch = 200 feet

Legend

- | | |
|-----------------|--------------------|
| TAXLOTS | PETITIONED_ON |
| IL | PETITIONED_ON POND |
| INSTREAM | QC |
| PENDING_OFF | QC-INSTREAM |
| PENDING_ON | TP-OFF |
| PENDING_ON POND | TP-ON |

Deschutes County Property Information

Sales for account # 161217

The Deschutes County Assessor's Office is responsible for the appraisal and assessment of all taxable property within the County. Contact this department if you need additional information or if you have questions.

Account Information

Mailing Name: SCRONCE, BRENDA & KARL
Map and Taxlot: 1712250000202
Account: 161217
Situs Address: 21800 PALOMA DR, BEND, OR 97701
Tax Status: Assessable

Sales History

View more recently recorded transactions - Clerks Office Web Query

Sale Date	Seller	Buyer	Sale Amount	Sale Type	Recording Instrument
04/24/2013	JUDSON,JOEL & TABREE	SCRONCE, BRENDA & KARL	\$680,000	33-CONFIRMED SALE	2013-17642
08/30/1999	LOONEY,WILLIAM R	JUDSON,JOEL	\$108,000	26-NEW CONSTRUCTION OR NEW PROPERTY	1999-42769
03/24/1997	LOONEY,WILLIAM R	LOONEY,WILLIAM R	\$0	08-GRANTOR/GRANTEE ARE THE SAME	1997-4420954
01/27/1995	EADY,THEODORE LOWELL	LOONEY,WILLIAM R	\$50,000	26-NEW CONSTRUCTION OR NEW PROPERTY	1995-3641309
02/10/1994	DEBERNARDI,GARY L	EADY,THEODORE LOWELL	\$102,000	33-CONFIRMED SALE	1994-3290589
05/08/1992	BEND METRO PARK & REC	DEBERNARDI,GARY L	\$0	09-TRADE OR EXCHANGE OF PROPERTIES	1992-2652396

RECEIVED BY OWRD

SEP 12 2016

SALEM, OR

THE INFORMATION AND MAPS ACCESSED THROUGH THIS WEB SITE PROVIDE A VISUAL DISPLAY FOR YOUR CONVENIENCE. EVERY REASONABLE EFFORT HAS BEEN MADE TO ASSURE THE ACCURACY OF THE MAPS AND ASSOCIATED DATA. DESCHUTES COUNTY MAKES NO WARRANTY, REPRESENTATION OR GUARANTEE AS TO THE CONTENT, SEQUENCE, ACCURACY, TIMELINESS OR COMPLETENESS OF ANY OF THE DATA PROVIDED HEREIN. DESCHUTES COUNTY EXPLICITLY DISCLAIMS ANY REPRESENTATIONS AND WARRANTIES, INCLUDING, WITHOUT LIMITATION, THE IMPLIED WARRANTIES OF MERCHANTABILITY AND FITNESS FOR A PARTICULAR PURPOSE. DESCHUTES COUNTY SHALL ASSUME NO LIABILITY FOR ANY ERRORS, OMISSIONS, OR INACCURACIES IN THE INFORMATION PROVIDED REGARDLESS OF HOW CAUSED. DESCHUTES COUNTY ASSUMES NO LIABILITY FOR ANY DECISIONS MADE OR ACTIONS TAKEN OR NOT TAKEN BY THE USER OF THIS INFORMATION OR DATA FURNISHED HEREUNDER.

© 2016 - Deschutes County. All rights reserved.

FINAL PROOF SITE REPORT

Claim of Beneficial Use

Property Owner (Applicant): Nelsen, Jean

Petition #: P-2013-001

Current Owner:

OWRD#: T-11660

Property Address: 62939 Johnson Ranch Rd, Bend

Notice #: T-2013-001

POD	USE	HG	TWP	RNG	SEC	QQ	TAX LOT	ACRES
1	IRRIG	I-3-8-3	17	14	22	SENE	801	1.48
1	IRRIG	I-3-8-3	17	14	22	NESE	801	0.61

- Person interviewed (if any): Jean Nelsen
- Method of irrigation (pump, flood, etc): sprinkle
- Use (crops produced): pasture & yard
- Method used to calculate area irrigated: GIS
- Is beneficial use achieved: Yes
- Are there any mapping changes: No
- Dated photos of beneficial use: _____

IF NO:

- Failure to Prove up _____ acres of transferred water right
- Extension Filed: _____

NOTES:

RECEIVED BY OWRD
 SEP 12 2016
 SALEM, OR

Final Inspection by: Jenny Hartzell-Hill Date: 9/3/15



2013 AERIAL PHOTO
TAKEN: JULY 9, 2013



WATER RIGHTS MAP

TAX MAP: 171422 SENE/NESE 801
TOTAL WATER RIGHTS: 2.09 ac.
NELSEN, JEAN

1 inch = 100 feet

Legend

- | | |
|-----------------|--------------------|
| TAXLOTS | PETITIONED_ON |
| IL | PETITIONED_ON POND |
| INSTREAM | QC |
| PENDING_OFF | QC-INSTREAM |
| PENDING_ON | TP-OFF |
| PENDING_ON POND | TP-ON |

FINAL PROOF SITE REPORT

Claim of Beneficial Use

Property Owner (Applicant): Leisz, Bruce Kimball Trust

Petition #: P-2013-001

Current Owner:

OWRD#: T-11660

Property Address: 61735 Gosney Rd, Bend

Notice #: T-2013-007

POD	USE	HG	TWP	RNG	SEC	QQ	TAX LOT	ACRES
1	IRRIG	COC-18	18	13	05	NESW	700	4.42

Person interviewed (if any): _____

Method of irrigation (pump, flood, etc): Pump / Sprinkle

Use (crops produced): pasture

Method used to calculate area irrigated: GPS

Is beneficial use achieved: Yes

Are there any mapping changes: NO

Dated photos of beneficial use: 7/22/15

IF NO:

Failure to Prove up _____ acres of transferred water right

Extension Filed: _____

NOTES:

RECEIVED BY OWRD

SEP 12 2016

SALEM, OR

Final Inspection by: Jerry Harrell-BW

Date: 7/22/15



2013 AERIAL PHOTO
TAKEN: JULY 9, 2013



WATER RIGHTS MAP RECEIVED BY OWRD

TAX MAP: 181305 NESW 700
TOTAL WATER RIGHTS: 4.42 ac
LEISZ, BRUCE KIMBALL TRUST

1 inch = 200 feet

SEP 12 2016
SALEM, OR

Legend

- | | |
|-----------------|--------------------|
| TAXLOTS | PETITIONED_ON |
| IL | PETITIONED_ON POND |
| INSTREAM | QC |
| PENDING_OFF | QC-INSTREAM |
| PENDING_ON | TP-OFF |
| PENDING_ON POND | TP-ON |

FINAL PROOF SITE REPORT

Claim of Beneficial Use

Property Owner (Applicant): Roy, James & Nannette
 Current Owner: Lupi, Peter/Riley, Kelley
 Property Address: 24175 Dodds Rd, Bend OR

Petition #: P-2013-001
 OWRD#: T-11660
 Notice #: T-2013-005

POD	USE	HG	TWP	RNG	SEC	QQ	TAX LOT	ACRES
1	IRRIG	F-2-2-1	18	13	12	NESW	603	0.51

- Person interviewed (if any): Kelley Riley
- Method of irrigation (pump, flood, etc): Pump
- Use (crops produced): PASTURE
- Method used to calculate area irrigated: GIS & VIS. INSP.
- Is beneficial use achieved: Yes
 - Dated photos of beneficial use: 8/29/16 - IN COLLECTOR
 - Are there any mapping changes: NO
 - Submit map changes to mapping for updates to ARC. Date submitted: _____
 - Enter use into WWIN: _____

IF NO:

RECEIVED BY OWRD

- Failure to Prove up _____ acres of transferred water right
- Extension Filed: _____

SEP 12 2016

NOTES:

SALEM, OR

NEW OWNERS - WILL ATTEND TO IN 2016.

8/4/16 - STILL SOME DRY AREAS ON NORTH FENCE LINE AND SW CORNER OF PEN.

8/29/16 - ALL AREAS SEEDED, WATERED, AND GROWING.

Final Inspection by:

Kelley Riley

Date:

8/29/16.

Deschutes County Property Information

Sales for account # 170566

The Deschutes County Assessor's Office is responsible for the appraisal and assessment of all taxable property within the County. Contact this department if you need additional information or if you have questions.

Account Information

Mailing Name: LUPI, PETER N & RILEY, KELLY L
 Map and Taxlot: 1813120000603
 Account: 170566
 Situs Address: 24175 DODDS RD, BEND, OR 97701
 Tax Status: Assessable

Sales History

View more recently recorded transactions - Clerks Office Web Query

Sale Date	Seller	Buyer	Sale Amount	Sale Type	Recording Instrument
10/06/2015	ROY, JAMES M & NANNETTE L	LUPI, PETER N & RILEY, KELLY L	\$350,000	06-GRANTEE IS RELATED/FRIENDS/BUSINESS ASSOCIATES	2015-41392
07/08/2011	FEDERAL NATIONAL MORTGAGE ASSOC	ROY, JAMES M & NANNETTE L	\$265,000	31-LENDER/DISTRESS/SHORT SALE CONFIRMED/UNCONFIRMED	2011-24034
01/27/2011	LEE, FRANK W	FEDERAL NATIONAL MORTGAGE ASSOC	\$308,161	10-FORECLOSURE/BANKRUPTCY/TRANSFER TO AVOID LIEN	2011-3797
10/14/2005	LEE,FRANK W & TERRA L	LEE, FRANK W	\$0	06-GRANTEE IS RELATED/FRIENDS/BUSINESS ASSOCIATES	2005-70570
10/14/1998	FINCK,STEVEN J	LEE,FRANK W	\$61,250	26-NEW CONSTRUCTION OR NEW PROPERTY	1998-5162482
12/15/1995	CENTRAL OREGON IRR DIST	FINCK,STEVEN J	\$32,284	15-OLD SALE OR DATE MISSING	1995-3940198

THE INFORMATION AND MAPS ACCESSED THROUGH THIS WEB SITE PROVIDE A VISUAL DISPLAY FOR YOUR CONVENIENCE. EVERY REASONABLE EFFORT HAS BEEN MADE TO ASSURE THE ACCURACY OF THE MAPS AND ASSOCIATED DATA. DESCHUTES COUNTY MAKES NO WARRANTY, REPRESENTATION OR GUARANTEE AS TO THE CONTENT, SEQUENCE, ACCURACY, TIMELINESS OR COMPLETENESS OF ANY OF THE DATA PROVIDED HEREIN. DESCHUTES COUNTY EXPLICITLY DISCLAIMS ANY REPRESENTATIONS AND WARRANTIES, INCLUDING WITHOUT LIMITATION, THE IMPLIED WARRANTIES OF MERCHANTABILITY AND FITNESS FOR A PARTICULAR PURPOSE. DESCHUTES COUNTY SHALL ASSUME NO LIABILITY FOR ANY ERRORS, OMISSIONS, OR INACCURACIES IN THE INFORMATION PROVIDED REGARDLESS OF HOW CAUSED. DESCHUTES COUNTY ASSUMES NO LIABILITY FOR ANY DECISIONS MADE OR ACTIONS TAKEN OR NOT TAKEN BY THE USER OF THIS INFORMATION OR DATA FURNISHED HEREUNDER.

© 2016 - Deschutes County. All rights reserved.

RECEIVED BY OWRD

SEP 12 2016

SALEM, OR


DESCHUTES COUNTY SEC.20 T14S R13E

SCALE - 1" = 400'



SW 1/4 OF THE NE 1/4



OWRD #: 11660

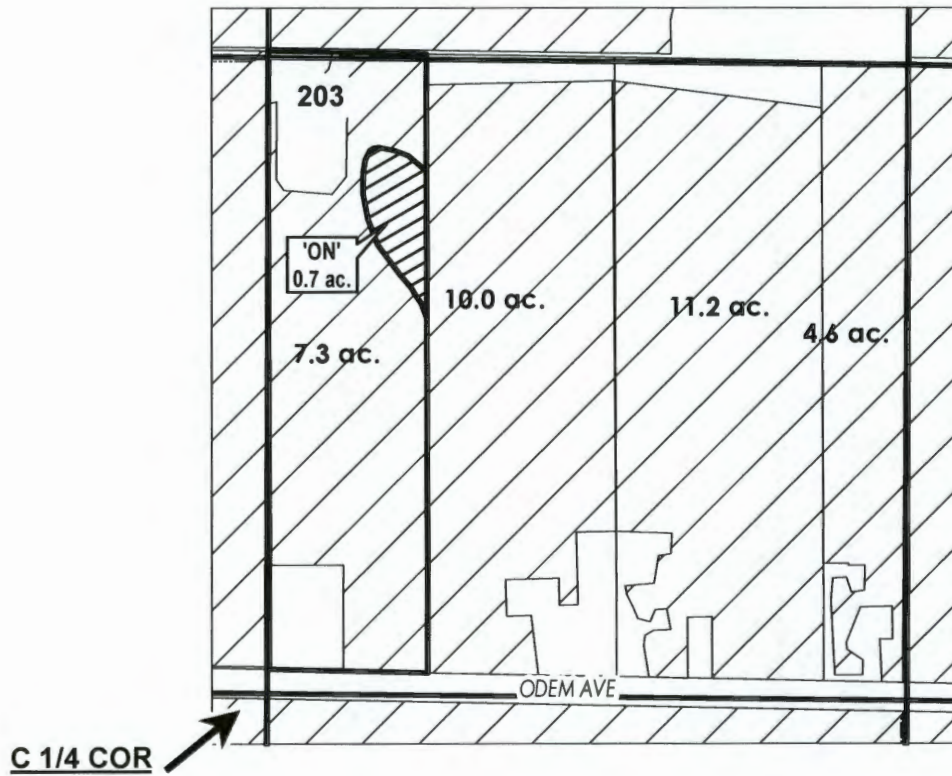

RECEIVED BY OWRD

SEP 12 2016

SALEM, OR

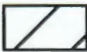	EXISTING WATER RIGHTS
	'ON' LANDS



FINAL PROOF MAP

NAME: JEFF R. & KRISTY L. EVERY

TAXLOT #: 203

0.7 ACRES

Date: 8/3/2016

FILE: I:\TRANSFER\FINALPRFIP-2013-001\141320_SWNE


DESCHUTES COUNTY SEC.32 T14S R13E

SCALE - 1" = 400'



NE 1/4 OF THE NW 1/4


OWRD #: 11660

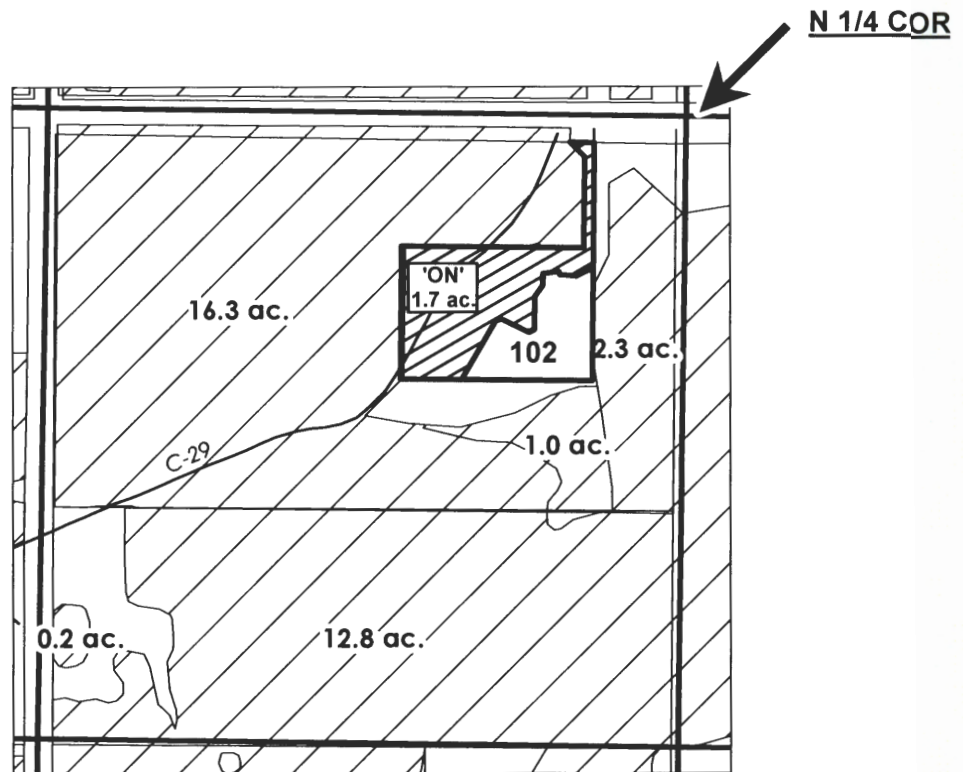

RECEIVED BY OWRD

SEP 12 2016

SALEM, OR

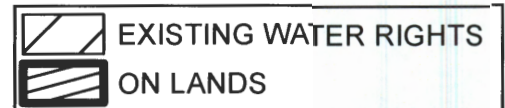

FINAL PROOF MAPS

NAME: JOHN & DIANE KIESLER

TAXLOT #: 102

1.7 ACRES

Date: 8/3/2016

FILE: I:\TRANSFER\FINALPRFIP-2013-001\141332_NE:NW

DESCHUTES COUNTY SEC.32 T14S R13E


SCALE - 1" = 400'



NW 1/4 OF THE NE 1/4

OWRD #: 11660


N 1/4 COR

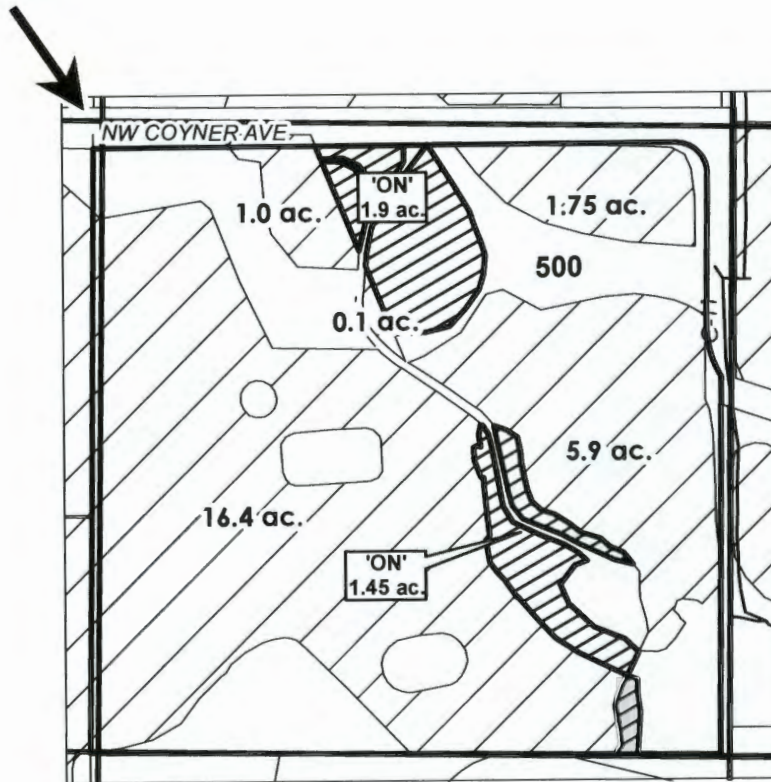

RECEIVED BY OWRD

SEP 12 2016

SALEM, OR

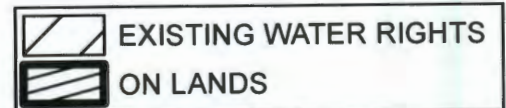

FINAL PROOF MAP

NAME: STEVEN & TERRI AHLBERG

TAXLOT #: 500

3.35 ACRES



Date: 8/3/2016

FILE: I:\TRANSFER\FINALPRFIP-2013-001141332_NENW

DESCHUTES COUNTY SEC.25 T17S R12E


SCALE - 1" = 400'



NW 1/4 OF THE NE 1/4

OWRD #: 11660


N 1/4 COR

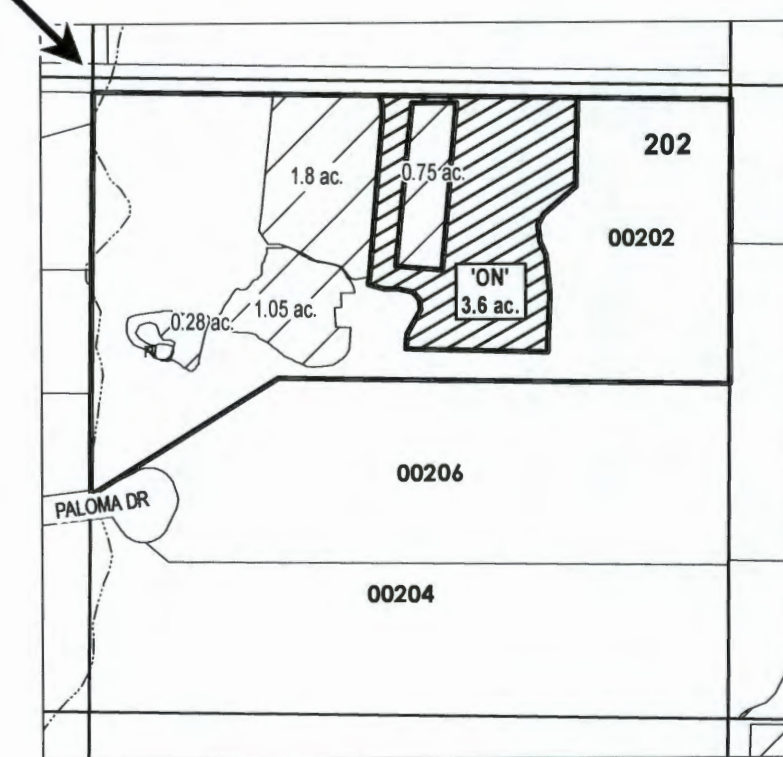

RECEIVED BY OWRD

SEP 12 2016

SALEM, OR

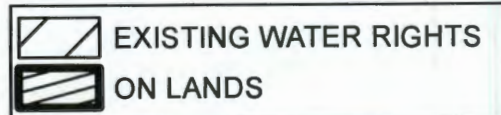

FINAL PROOF MAP

NAME: BRENDA & KARL SCRONCE

TAXLOT #: 202

3.6 ACRES

Date: 8/3/2016

FILE: I:\TRANSFER\FINALPRFIP-2013-001\171225_NWNE


DESCHUTES COUNTY SEC.22 T17S R14E

SCALE - 1" = 400'



SE 1/4 OF THE NE 1/4; NE 1/4 OF THE SE 1/4


OWRD #: 11660

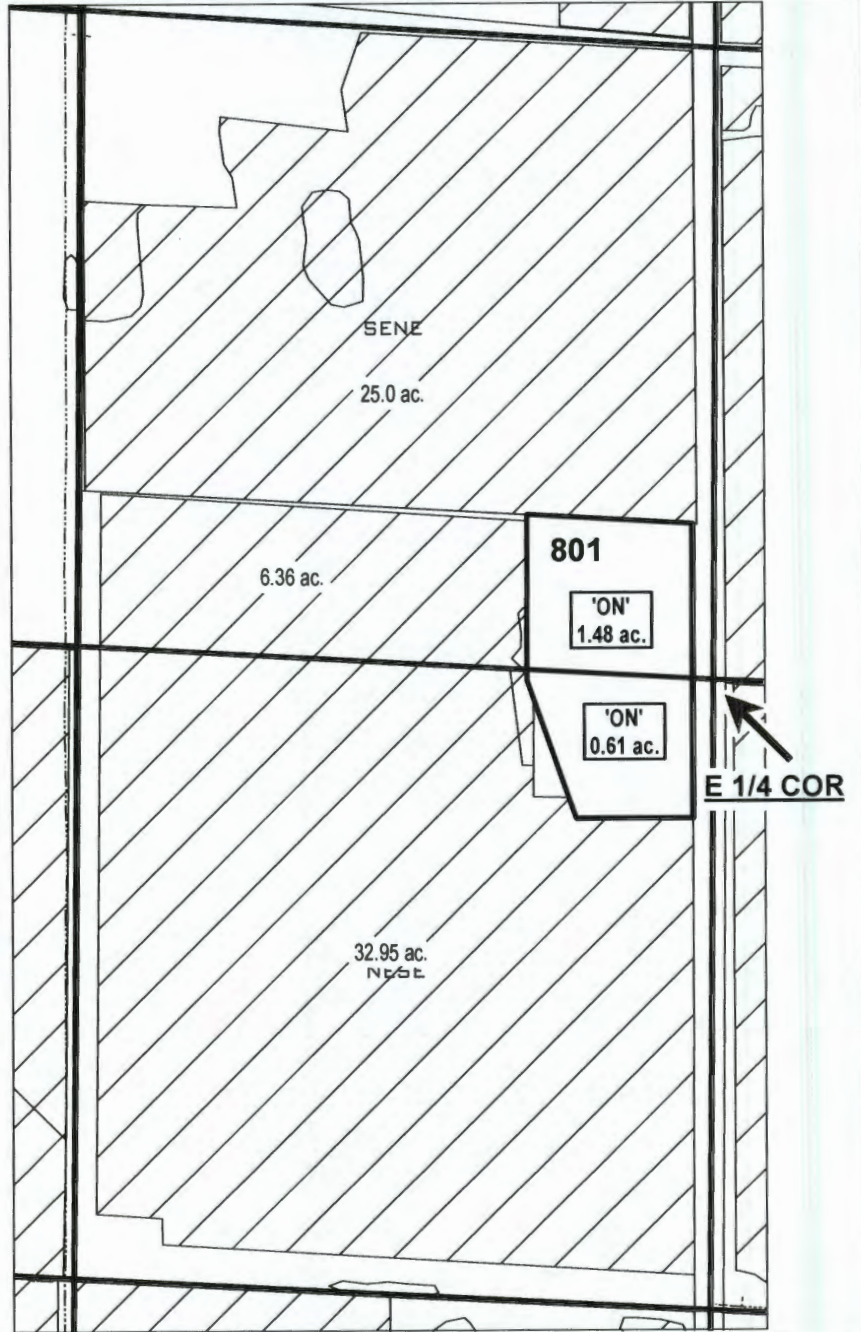

RECEIVED BY OWRD

SEP 12 2016

SALEM, OR

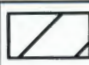-  EXISTING WATER RIGHTS
-  'ON' LANDS



FINAL PROOF MAP

NAME: JEAN NELSON

TAXLOT #: 801

2.09 ACRES

Date: 8/3/2016

FILE: I:\TRANSFER\FINALPRFIP-2013-001\171422_SENE_NENE


DESCHUTES COUNTY SEC.05 T18S R13E

SCALE - 1" = 400'



NE 1/4 OF THE SW 1/4

OWRD #: 11660

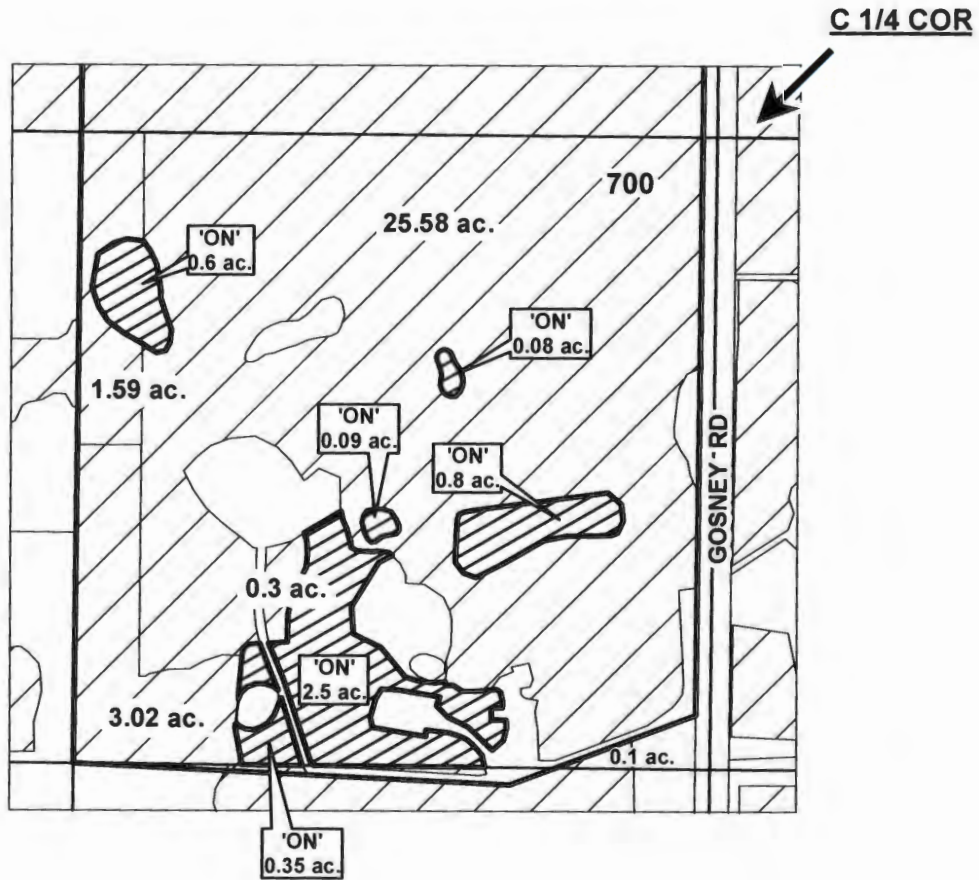

RECEIVED BY OWRD

SEP 12 2016

SALEM, OR

	EXISTING WATER RIGHTS
	ON LANDS

FINAL PROOF MAP

NAME: BRUCE KIMBALL LEISZ FAMILY TRUST

TAXLOT #: 700

4.42 ACRES



8/3/2016

FILE: I:\TRANSFER\FINALPRFP-2013-001181305_NESW


DESCHUTES COUNTY SEC.12 T18S R13E

SCALE - 1" = 400'



NE 1/4 OF THE SW 1/4

OWRD #: 11660

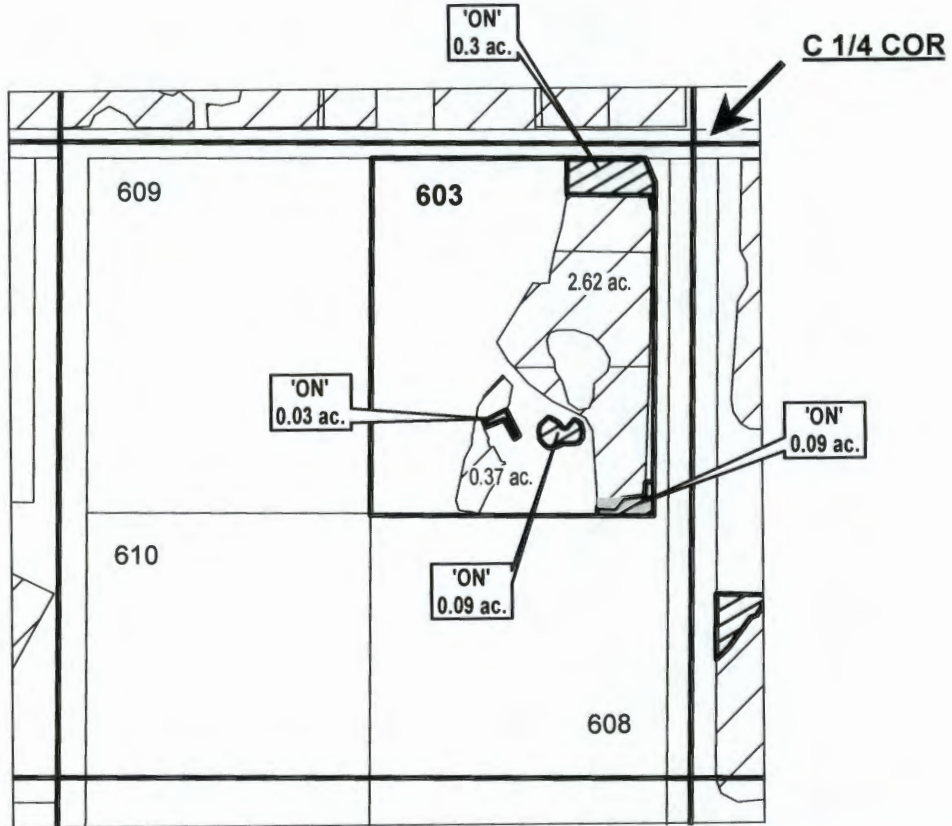

RECEIVED BY OWRD

RECEIVED BY OWRD

SEP 12 2016

SEP 12 2016

SALEM, OR

SALEM, OR

	EXISTING WATER RIGHTS
	ON LANDS



FINAL PROOF MAP

NAME: PETER LUPI & KELLY RILEY

TAXLOT #: 603

0.51 ACRES

Date: 9/6/2016

FILE: I:\TRANSFER\FINALPRFIP-2013-001\181312_NESW