



Oregon Water Resources Department
 721 Summer Street NE, Suite A
 Salem, OR 97301-1271

RECEIVED BY OWRD

SEP 26 2012

SALEM, OR

**OAR Chapter 690, Division 385
 CLAIM OF BENEFICIAL USE
 District Permanent Water Right Transfer**

District: Medford Irrigation District

Contact Person: Manager Carol Bradford Phone: (541)899-9913

Mailing Address: P.O. Box 70, Jacksonville, Oregon 97530

Transfer Number: T - 10757

I. Pursuant to OAR Chapter 690, Division 385, the district is submitting to the Water Resources Department this claim of beneficial use for the following water right(s):

WATER RIGHTS			
PERMIT NUMBER	CERTIFICATE NUMBER	DECREE (name, volume, and page)	PRIMARY (P) or SUPP (S)
	83381		P
	83383		S
	80578		S
	83728		S
S-4951			S

II. The authorized point(s) of diversion for the water rights modified by the transfer are as follows:

AUTHORIZED POINT(S) OF DIVERSION / APPROPRIATION				
PERMIT	DECREE or CERTIFICATE	POD#	SOURCE	LOCATION - LEGAL DESCRIPTION
	83381	1	N & S Forks of Little Butte Creek	NF: 40' N, 620' W of E 1/4 corner Sec 20, (SE1/4NE1/4 Sec 20) of T36, R2E, WM SF: 780' S, 400' W of E1/4 corner sec 29, (NE1/4SE1/4 of sec 29) T36S, R1E, Bradshaw: SW1/4SW1/4, Sec 8, T36S, R1E, all of WM
	83383	2	Fourmile Lake Reservoir & Fish Lake Reservoir	Fourmile: 3600' N, 4200' E from SW corner, T36S, R5E, Sec 9, SW1/4 of NW1/4 Sec 9 Fish: 4000' S & 600' E from NE corner T37S, R4E, Sec 4 SE1/4 of SE1/4 NF: 40' N, 620' W from E 1/4 corner T36S, R2E Sec 20, SE 1/4NE1/4 Bradshaw: /4SW1/4, Sec 8, T36S, R1E, all of WM
	80578	3	Bear Creek tributary to the Rogue River	Bear Creek, tributary of Rogue River Phoenix Canal – 1500 Feet North and 100 feet East from the SE Corner of DLC 59, being within the SW1/4 NE1/4 of Section 23, Township 38 South, Range 1 West, W.M.

	83728 perfected under (P-25915)	4	Emigrant, Howard Prairie & Hyatt Reservoirs	SF: 1240' 1100' E of SE ¼ corner Sec 16, (SE ¼ SE ¼)Sec 16; Conde Cr: 1320' N, 600' E from SW corner Sec 9, (SWSW Sec 9, T38S, R3E WM); Dead Indian Cr: 1310' N, 1100" W from S ¼ corner of Sec 15 (SE ¼ SW ¼, Sec 15 T38S, R3E); Daley Cr: 750" N, 480' E from S ¼ corner Sec 34, (SW ¼ SE ¼ Sec 34, T37S, R4E, WM); Beaver Dam Cr: 2000' N, 1800' E if SW corner of Sec 4, NESW of Sec 4, NESW OF Sec 4, T38S, R4E, WM.
S-4951		5	Waste, ret. & natural flows, seepage, springs, etc. from lands lying above District canals, Bear Creek & sources referred to in permits above	At points crossing the Hopkins Canal

- III.** The summary of the perfected change in place of use authorized by the final order approving the water right transfer is listed in Table 1.
- IV.** Attached is a map and site report for each water right listed in Table 1 that satisfies the requirements of OAR 690-385-7400.

The district certifies that it has inspected the place of use listed in Table 1, and confirms the change in place of use has been completed consistent with the terms and conditions of the final order approving the transfer.


Signature of District Manager

9-24-12
Date

Carol Bradford
Typed Name of District Manager

RECEIVED BY OWRD

SEP 26 2012

SALEM, OR

District Permanent Transfer T-10757
Claim of Beneficial Use

TABLE 2. – PROPOSED PLACE OF USE

WATER RIGHT		Primary PRIORITY DATE	USE	POD #	LEGAL DESCRIPTION							ACRES	USER NAME	NOTICE NUMBER
Cert/Decree PRIMAR Y	Cert/Perm SUPP				TWP	RNG	SEC	QQ	DL C	GOV'T LOT	TAX LOT			
C83381		7/23/1909	Irrigation	1	36	1E	18	SENE			900	1.4	TRIPLE SPRINGS RANCH, LLC	08-01
	C83383	3/31/1910	Irrigation	2	36	1E	18	SENE			900	1.4	TRIPLE SPRINGS RANCH, LLC	08-01
	P-4951	6/18/1920	Irrigation	5	36	1E	18	SENE			900	1.4	TRIPLE SPRINGS RANCH, LLC	08-01
C83381		7/23/1909	Irrigation	1	36	1E	18	NESE			900	19.8	TRIPLE SPRINGS RANCH, LLC	08-01
	C83383	3/31/1910	Irrigation	2	36	1E	18	NESE			900	19.8	TRIPLE SPRINGS RANCH, LLC	08-01
	P-4951	6/18/1920	Irrigation	5	36	1E	18	NESE			900	19.8	TRIPLE SPRINGS RANCH, LLC	08-01
C83381		7/23/1909	Irrigation	1	36S	1W	36	SWSE			1500	7.00	LAMBERT	08-02
	C83383	3/31/1910	Irrigation	2	36S	1W	36	SWSE			1500	7.00	LAMBERT	08-02
	P-4951	6/18/1920	Irrigation	5	36S	1W	36	SWSE			1500	7.00	LAMBERT	08-02
C83381		7/23/1909	Irrigation	1	37	2W	20	NENE			300	2.54	RIBAL	08-03
	C83383	3/31/1910	Irrigation	2	37	2W	20	NENE			300	2.54	RIBAL	08-03
	C80578	3/1/1915	Irrigation	3	37	2W	20	NENE			300	2.54	RIBAL	08-03
	P-4951	6/18/1920	Irrigation	5	37	2W	20	NENE			300	2.54	RIBAL	08-03
C83381		7/23/1909	Irrigation	1	36	1E	31	NWNE			12900	15.00	ELLIOTT	08-04

RECEIVED BY OWRD
 SEP 26 2012
 SALEM, OR

District Permanent Transfer T-10757
Claim of Beneficial Use

	C83383	3/31/1910	Irrigation	2	36	1E	31	NWNE			12900	15.00	ELLIOTT	08-04
	P-4951	6/18/1920	Irrigation	5	36	1E	31	NWNE			12900	15.00	ELLIOTT	08-04
C83381		7/23/1909	Irrigation	1	36	1E	31	SWNE			12900	31.28	ELLIOTT	08-04
	C83383	3/31/1910	Irrigation	2	36	1E	31	SWNE			12900	31.28	ELLIOTT	08-04
	P-4951	6/18/1920	Irrigation	5	36	1E	31	SWNE			12900	31.28	ELLIOTT	08-04
C83381		7/23/1909	Irrigation	1	36	1E	31	SENE			12900	2.00	ELLIOTT	08-04
	C83383	3/31/1910	Irrigation	2	36	1E	31	SENE			12900	2.00	ELLIOTT	08-04
	P-4951	6/18/1920	Irrigation	5	36	1E	31	SENE			12900	2.00	ELLIOTT	08-04
C83381		7/23/1909	Irrigation	1	37	2W	33	NWSE			800	1.03	ANDERBERG	08-05
	C83383	3/31/1910	Irrigation	2	37	2W	33	NWSE			800	1.03	ANDERBERG	08-05
	C80578	3/1/1915	Irrigation	3	37	2W	33	NWSE			800	1.03	ANDERBERG	08-05
	P-4951	6/18/1920	Irrigation	5	37	2W	33	NWSE			800	1.03	ANDERBERG	08-05
C83381		7/23/1909	Irrigation	1	37	2W	17	NESE			3603	4.05	TURNER	08-06
	C83383	3/31/1910	Irrigation	2	37	2W	17	NESE			3603	4.05	TURNER	08-06
	C80578	3/1/1915	Irrigation	3	37	2W	17	NESE			3603	4.05	TURNER	08-06
	P-4951	6/18/1920	Irrigation	5	37	2W	17	NESE			3603	4.05	TURNER	08-06
C83381		7/23/1909	Irrigation	1	37	2W	17	NESE			3602	4.50	MALOT	08-07
	C83383	3/31/1910	Irrigation	2	37	2W	17	NESE			3602	4.50	MALOT	08-07
	C80578	3/1/1915	Irrigation	3	37	2W	17	NESE			3602	4.50	MALOT	08-07
	P-4951	6/18/1920	Irrigation	5	37	2W	17	NESE			3602	4.50	MALOT	08-07
C83381		7/23/1909	Irrigation	1	37	2W	17	NESE			3600	4.47	STEIGERWALD	08-08
	C83383	3/31/1910	Irrigation	2	37	2W	17	NESE			3600	4.47	STEIGERWALD	08-08
	C80578	3/1/1915	Irrigation	3	37	2W	17	NESE			3600	4.47	STEIGERWALD	08-08
	P-4951	6/18/1920	Irrigation	5	37	2W	17	NESE			3600	4.47	STEIGERWALD	08-08
C83381		7/23/1909	Irrigation	1	37	2W	33	NESE			700	5.82	BROWN	08-09
	C83383	3/31/1910	Irrigation	2	37	2W	33	NESE			700	5.82	BROWN	08-09

SALEM, OR

SEP 26 2012

RECEIVED BY OWRD

**District Permanent Transfer T-10757
Claim of Beneficial Use**

	C80578	3/1/1915	Irrigation	3	37	2W	33	NESE			700	5.82	BROWN	08-09
	C83728	6/8/1953	Irrigation	4	37	2W	33	NESE			700	5.82	BROWN	08-09
	P-4951	6/18/1920	Irrigation	5	37	2W	33	NESE			700	5.82	BROWN	08-09
C83381		7/23/1909	Irrigation	1	37	2W	33	SESE			700	3.70	BROWN	
	C83383	3/31/1910	Irrigation	2	37	2W	33	SESE			700	3.70	BROWN	
	C80578	3/1/1915	Irrigation	3	37	2W	33	SESE			700	3.70	BROWN	
	C83728	6/8/1953	Irrigation	4	37	2W	33	SESE			700	3.70	BROWN	
	P-4951	6/18/1920	Irrigation	5	37	2W	33	SESE			700	3.70	BROWN	
											2403	20.8	MARTHA BROOKS FAMILY LLC	08-10
C83381		7/23/1909	Irrigation	1	36	1E	05	SESW,						
											2403	20.8	MARTHA BROOKS FAMILY LLC	08-10
	C83383	3/31/1910	Irrigation	2	36	1E	05	SESW						
	P-4951	6/18/1920	Irrigation	5	36	1E	05	SESW						
											2403	20.8	MARTHA BROOKS FAMILY LLC	08-10
C83381		7/23/1909	Irrigation	1	36	1E	05	SWSW						
											2403	.20	MARTHA BROOKS FAMILY LLC	08-10
	C83383	3/31/1910	Irrigation	2	36	1E	05	SWSW						
	P-4951	6/18/1920	Irrigation	5	36	1E	05	SWSW						
			Irrigation											
C83381		7/23/1909	Irrigation	1	36	1W	36	SWSE						
	C83383	3/31/1910	Irrigation	2	36	1W	36	SWSE						
	P-4951	6/18/1920	Irrigation	5	36	1W	36	SWSE						
											414	5.00	LUEHRS	08-11
											414	5.00	LUEHRS	08-11
											414	5.00	LUEHRS	08-11

SALEM, OR

SEP 26 2012

RECEIVED BY OWRD

**CLAIM OF BENEFICIAL USE
Site Report**

Transfer Number: T - 10757

District Internal Notice #: 08-01

User Name: Triple Springs Ranch LLC

Place of Use: **5972 Highway 140, Eagle Point, Oregon**

USE	POD #	TWP	RNG	SEC	QQ	DLC	GOV'T LOT	TAX LOT	ACRES
IR	1,2,,4	36S	1E	18	SENE			900	1.40
IR	1,2,4	36S	1E	18	NESE			900	19.8

District Conveyance System:

Description of Delivery System: Pump to pressurized sprinklers and gravity pressure

Headgate: _____ Canal: MID's main canal

Beneficial Use:

Description of Beneficial Use: Pasture/Hay

Method Used to Apply Water: Sprinklers under pressure

Method Used to Calculate Beneficial Use: Observation and spoke with Paula Morgan (owner)

User Interviewed: (X) Yes () No

Beneficial Use Made as Authorized: (X) Yes () No

Description of Beneficial Use if Less than

Authorized: _____

Inspected By: Carol Bradford, District Manager

Date: August 20, 2012


Instructions: Attach and label the corresponding final proof map.

RECEIVED BY OWRD






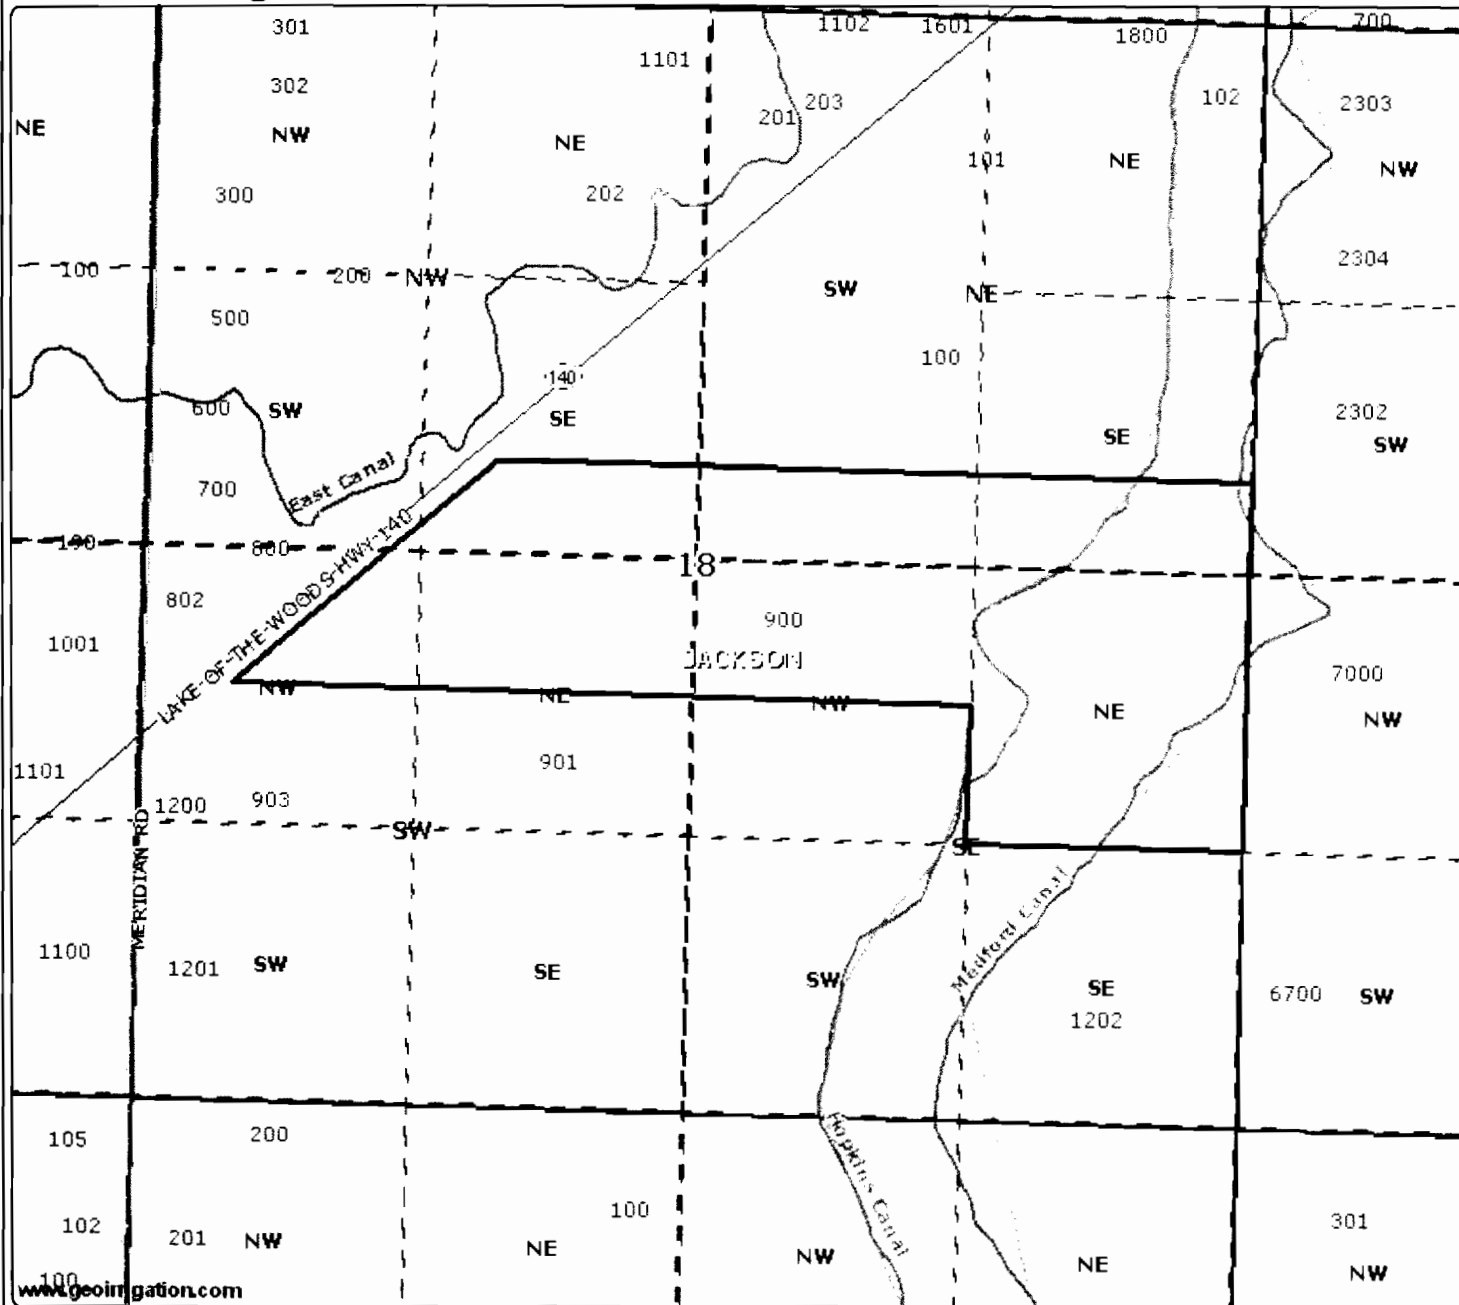


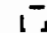

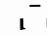






 



SEP 26 2012

SALEM, OR

Medford Irrigation District



Authorized Place of Use
361E18 #900
 21.2 ac.

-  District Boundary USBR
-  County Boundary
-  Major Roads
-  Road Labels
-  Roads
-  Township Range
-  Sections
-  Section Labels
-  Quarters
-  Quarter Labels
-  Quarter Quarters
-  Quarter Quarters Labels
-  Lot Labels
-  Taxlots
-  Canal All
-  Canal Piped
-  Canal Open
-  Private Line
-  POU District Primary
-  Irrigation Ditches JACK CO
-  RVC06 Laterals

RECEIVED BY OWRD
 SEP 26 2012
 SALEM, OR




Scale 1" = 882'
 Created: 8/15/2012

www.geoimagination.com

DISCLAIMER: This map is intended for display purposes only and is not intended for any legal representations. There are no warranties, expressed or implied, that accompany this product.

Medford Irrigation District

Authorized Place of Use
361E18 #900
21.2 ac.

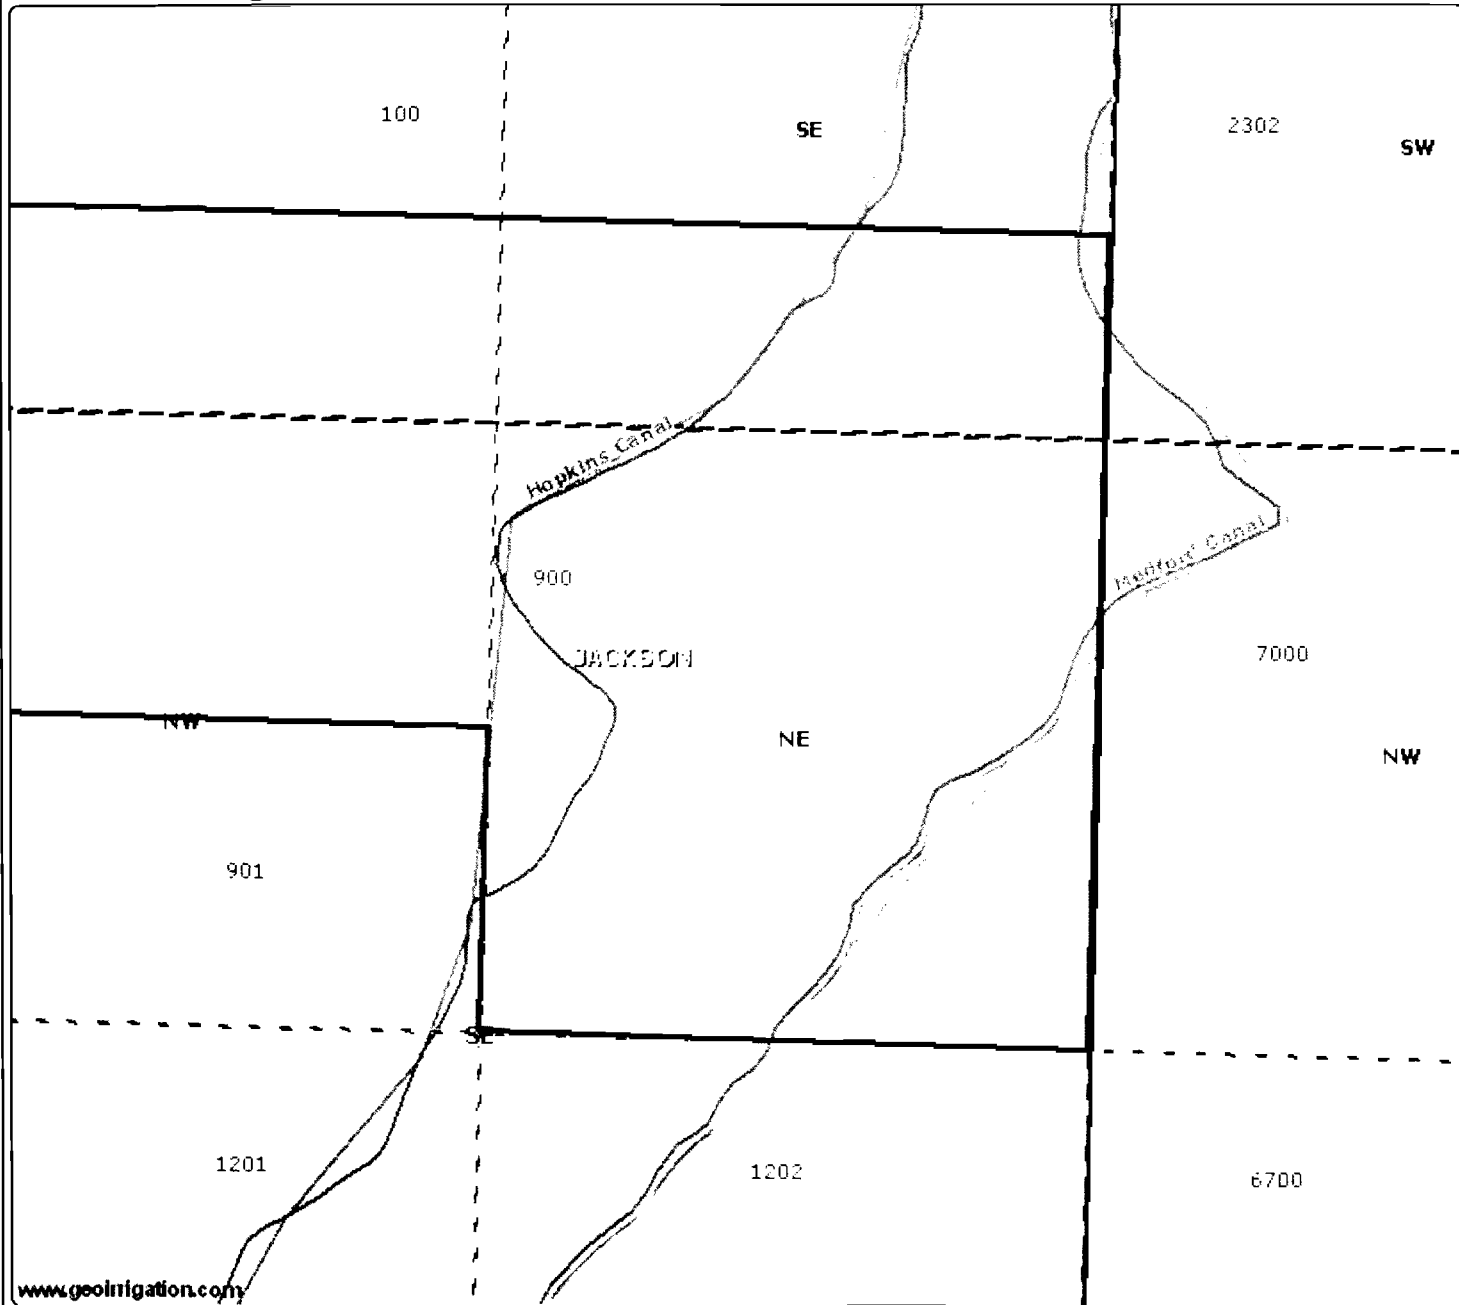

- District Boundary USBR
- County Boundary
- Major Roads
- Road Labels
- Roads
- Township Range
- Sections
- Section Labels
- Quarters
- Quarter Labels
- Quarter Quarters
- Quarter Quarters Labels
- Lot Labels
- Taxlots
- Canal All
- Canal Piped
- Canal Open
- Private Line
- POU District Primary
- Irrigation Ditches JACK CO
- RVC06 Laterals

SEP 26 2012
 SALEM, OR



Scale 1" = 400'
 Created: 8/15/2012

www.geoinformation.com

DISCLAIMER: This map is intended for display purposes only and is not intended for any legal representations. There are no warranties, expressed or implied, that accompany this product.

RECEIVED BY OWRD

CLAIM OF BENEFICIAL USE Site Report

Transfer Number: T - 10757

District Internal Notice #: 08-02

User Name: **Brian & Kelly Lambert**

Place of Use: **1722 Dry Creek Rd., Eagle Point, Oregon**

USE	POD #	TWP	RNG	SEC	QQ	DLC	GOV'T LOT	TAX LOT	ACRES
IR	1,2,4,	36S	1W	36	SWSE			1500	7.00
								TOTAL	7.00

District Conveyance System:

Description of Delivery System: PUMP TO PRESSURIZED SPRINKLER SYSTEM

Headgate: _____ Canal: MID's Main Canal

Beneficial Use:

Description of Beneficial Use: (Pasture) pump from Main Canal (sprinklers)

Method Used to Apply Water: Pressurized Sprinklers

Method Used to Calculate Beneficial Use: Observation and Tom(ditchrider spoke to patron

User Interviewed: (X) Yes () No

Beneficial Use Made as Authorized: (X) Yes () No

Description of Beneficial Use if Less than

Authorized: _____


Inspected By: Tom Lucas(ditchrider) Date: 9/24/2012

Instructions: Attach and label the corresponding final proof map.

RECEIVED BY OWRD

SEP 26 2012

Medford Irrigation District

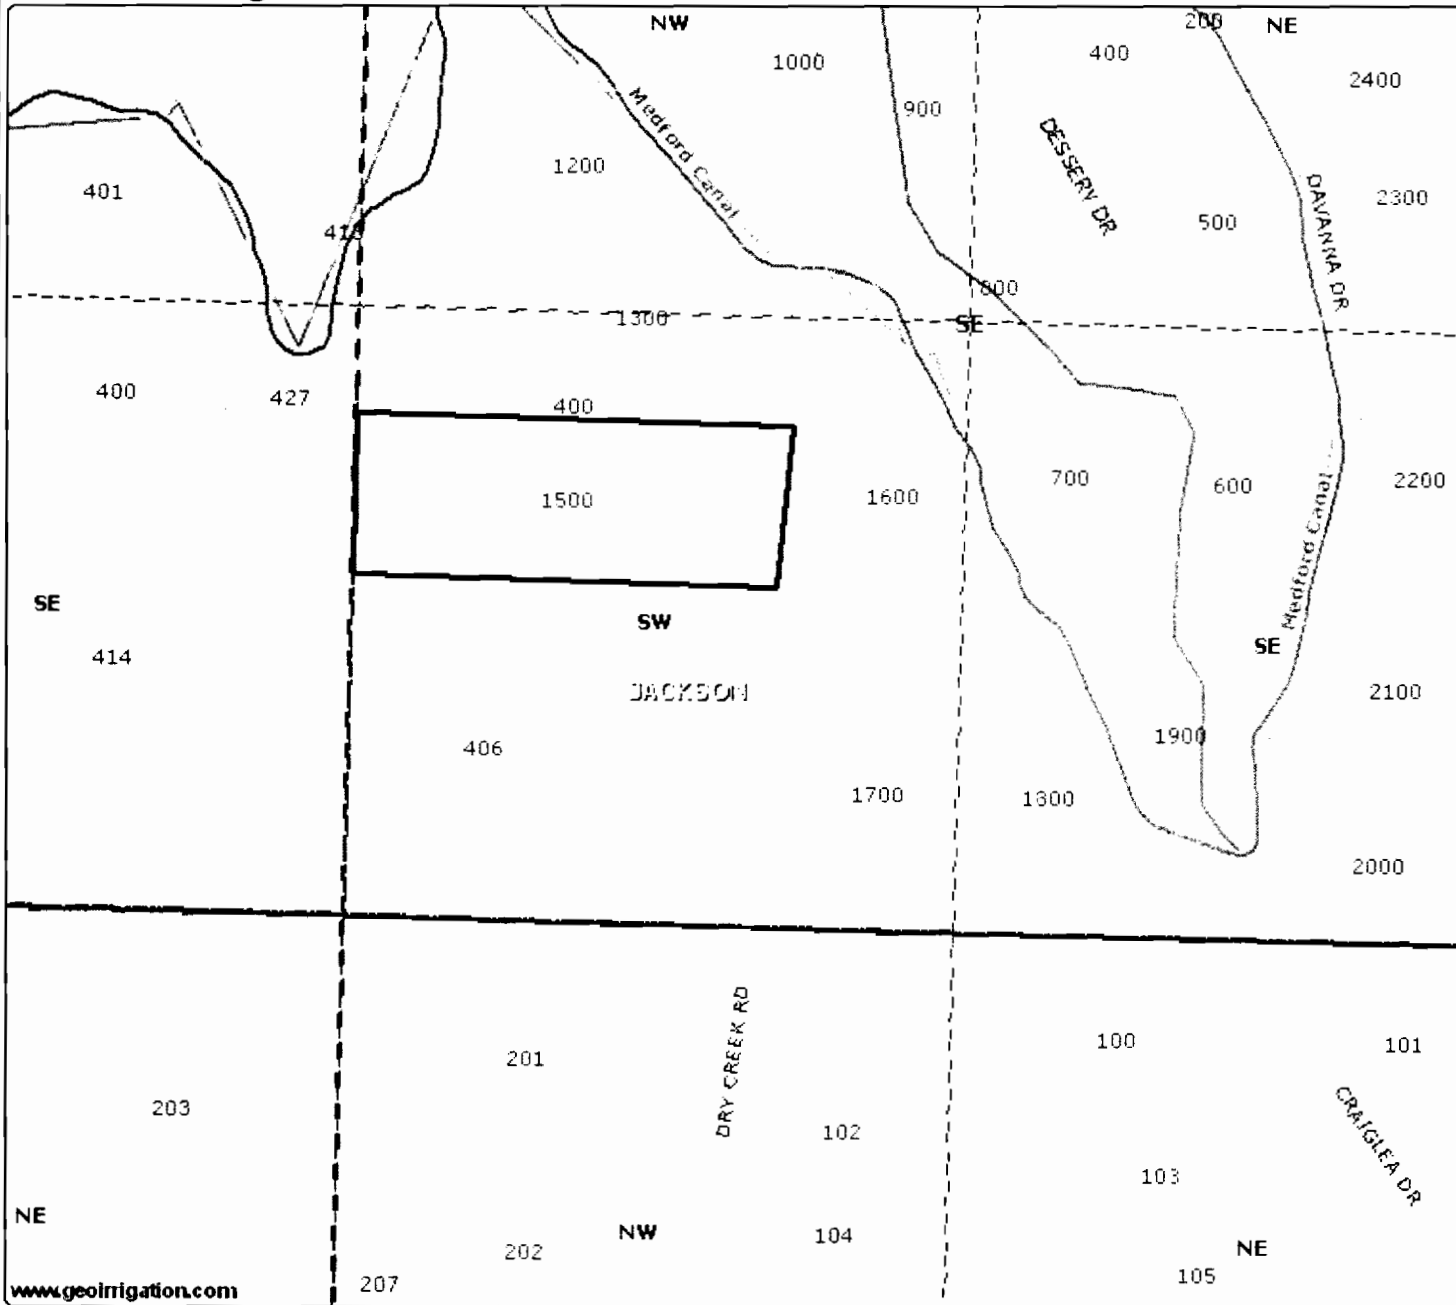

Authorized Place of Use
361W36 #1500
7 ac

- District Boundary USBR
- County Boundary
- Major Roads
- Road Labels
- Roads
- Township Range
- Sections
- Section Labels
- Quarters
- Quarter Labels
- Quarter Quarters
- Quarter Quarters Labels
- Lot Labels
- Taxlots
- Canal All
- Canal Piped
- Canal Open
- Private Line
- POU District Primary
- Irrigation Ditches JACK CO
- RMCOG Laterals

www.geoirrigation.com



Scale 1" = 400'
 Created: 8/15/2012

RECEIVED BY OWRD

SEP 26 2012

SALEM, OR

DISCLAIMER: This map is intended for display purposes only and is not intended for any legal representations. There are no warranties, expressed or implied, that accompany this product.

**CLAIM OF BENEFICIAL USE
Site Report**

Transfer Number: T - 10757

District Internal Notice #: 08-03

User Name: Dolores Ribal

Place of Use: 3757 Ross Lane, Central Point, Oregon

USE	POD #	TWP	RNG	SEC	QQ	DLC	GOV'T LOT	TAX LOT	ACRES
IR	1,2,3,4	37S	2W	20	NENE			300	2.54

District Conveyance System:

Description of Delivery System: Pump with pressurized sprinkler system

Headgate: _____ Canal: Phoenix canal

Beneficial Use:

Description of Beneficial Use: Yard & Garden

Method Used to Apply Water: pump/sprinklers

Method Used to Calculate Beneficial Use: Observation by Curt(Ditchrider)

User Interviewed: (X) Yes () No

Beneficial Use Made as Authorized: (X) Yes () No

Description of Beneficial Use if Less than

Authorized: _____


Inspected By: Curt Vandagriff(Ditchrider) Date: August 20, 2012

Instructions: Attach and label the corresponding final proof map.

RECEIVED BY OWRD

SEP 26 2012

Medford Irrigation District

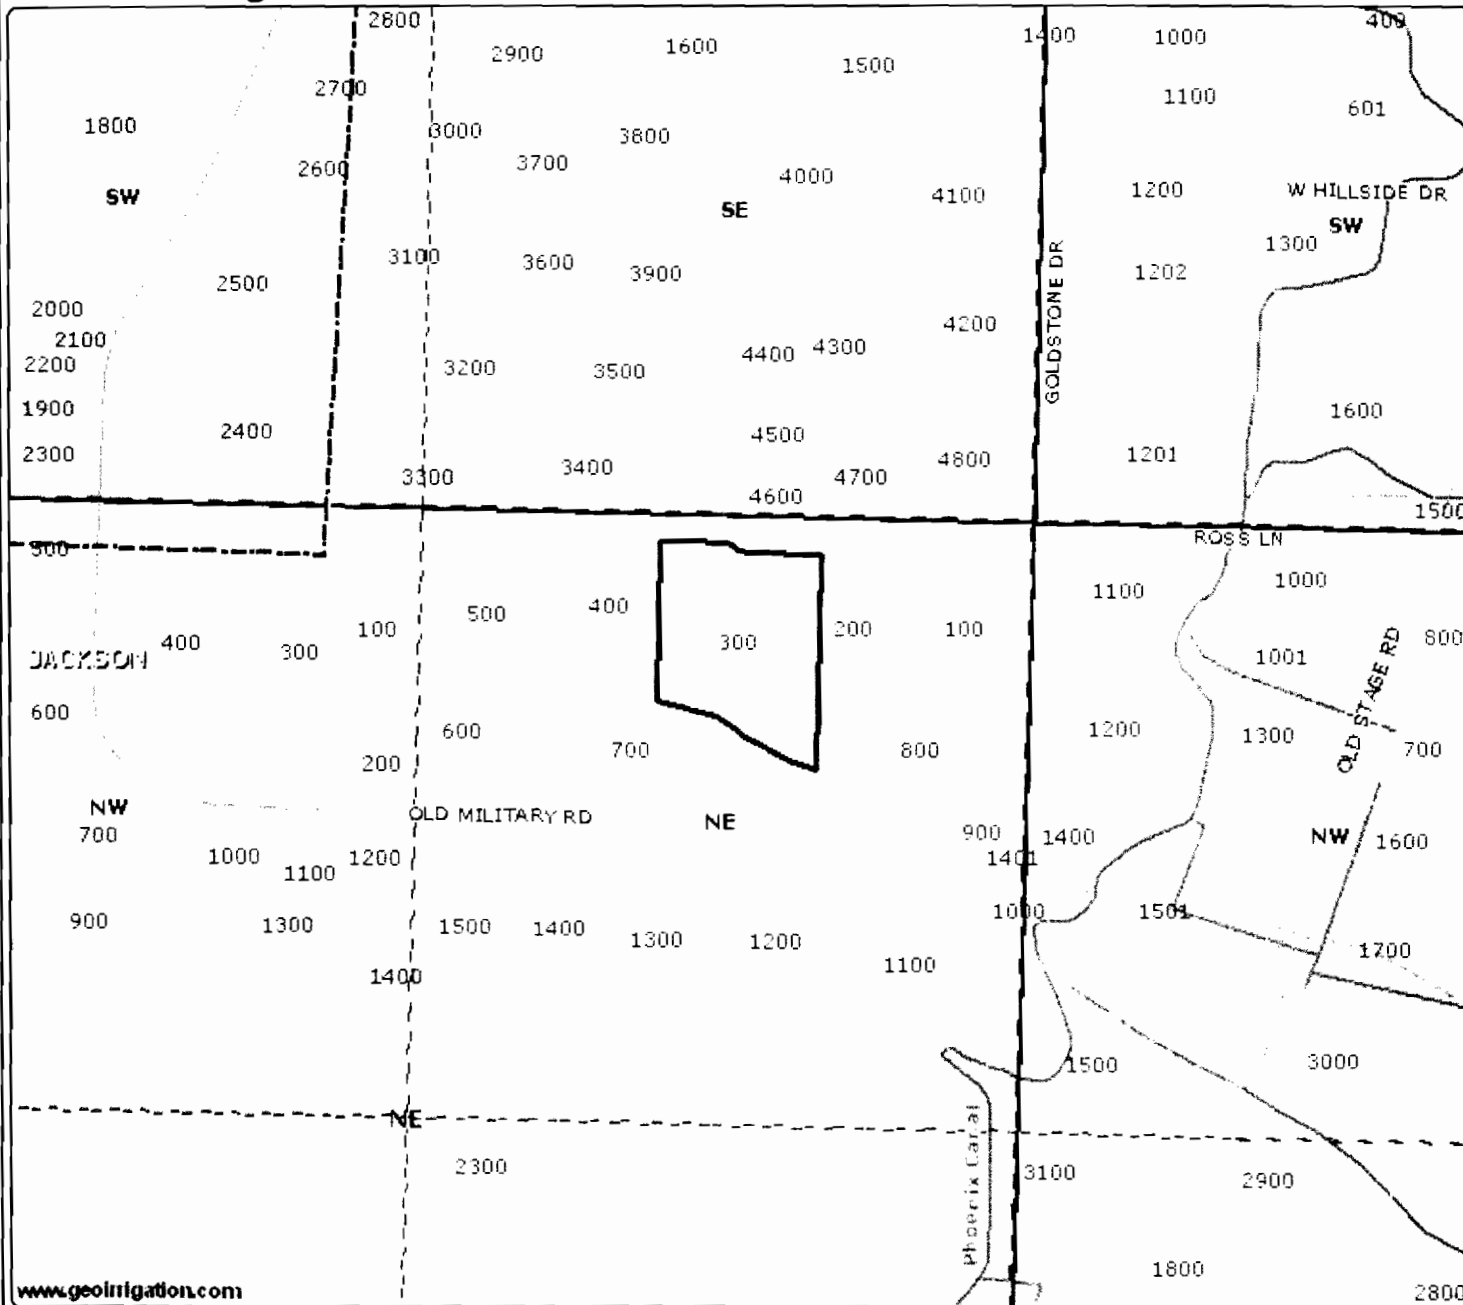

Authorized Place of Use
372W20AA #300
2.54 ac

- District Boundary USBR
- County Boundary
- Major Roads
- Road Labels
- Roads
- Township Range
- Sections
- Section Labels
- Quarters
- Quarter Labels
- Quarter Quarters
- Quarter Quarters Labels
- Lot Labels
- Taxlots
- Canal All
- Canal Piped
- Canal Open
- Private Line
- POU District Primary
- Irrigation Ditches JACK CO
- R/VOG Laterals

www.geolirrigation.com



Scale 1" = 400'
 Created: 8/15/2012

DISCLAIMER: This map is intended for display purposes only and is not intended for any legal representations. There are no warranties, expressed or implied, that accompany this product.

SEP 26 2012

SALEM, OR

RECEIVED BY OWRD

CLAIM OF BENEFICIAL USE Site Report

Transfer Number: T - 10757

District Internal Notice #: 08-04

User Name: Jon & Dorothy Elliott

Place of Use: **4100 South Stage Rd., Medford, Oregon**

USE	POD #	TWP	RNG	SEC	QQ	DLC	GOV'T LOT	TAX LOT	ACRES
TR	1,2,4,	37S	2W	33	NESE			12900	15.00
TR	1,2,4	37S	2W	33	SWNE			12900	31.28
TR	1,2,4	37S	2W	33	SENE			12900	2.00
								TOTAL	48.28

District Conveyance System:

Description of Delivery System: Pump from canal to pressurized sprinkler system; wheel line & big gun sprinklers

Headgate: _____ Canal: MID's Main Canal

Beneficial Use:

Description of Beneficial Use: (Pasture) pump from Main Canal (sprinklers)

Method Used to Apply Water: Sprinklers

Method Used to Calculate Beneficial Use: Observation and Tom(ditchrider spoke to patron

User Interviewed: Yes No

Beneficial Use Made as Authorized: Yes No

Description of Beneficial Use if Less than Authorized: _____


Inspected By: Tom Lucas(ditchrider)

Date: 9/10/2012

RECEIVED BY OWRD

SEP 26 2012

Medford Irrigation District

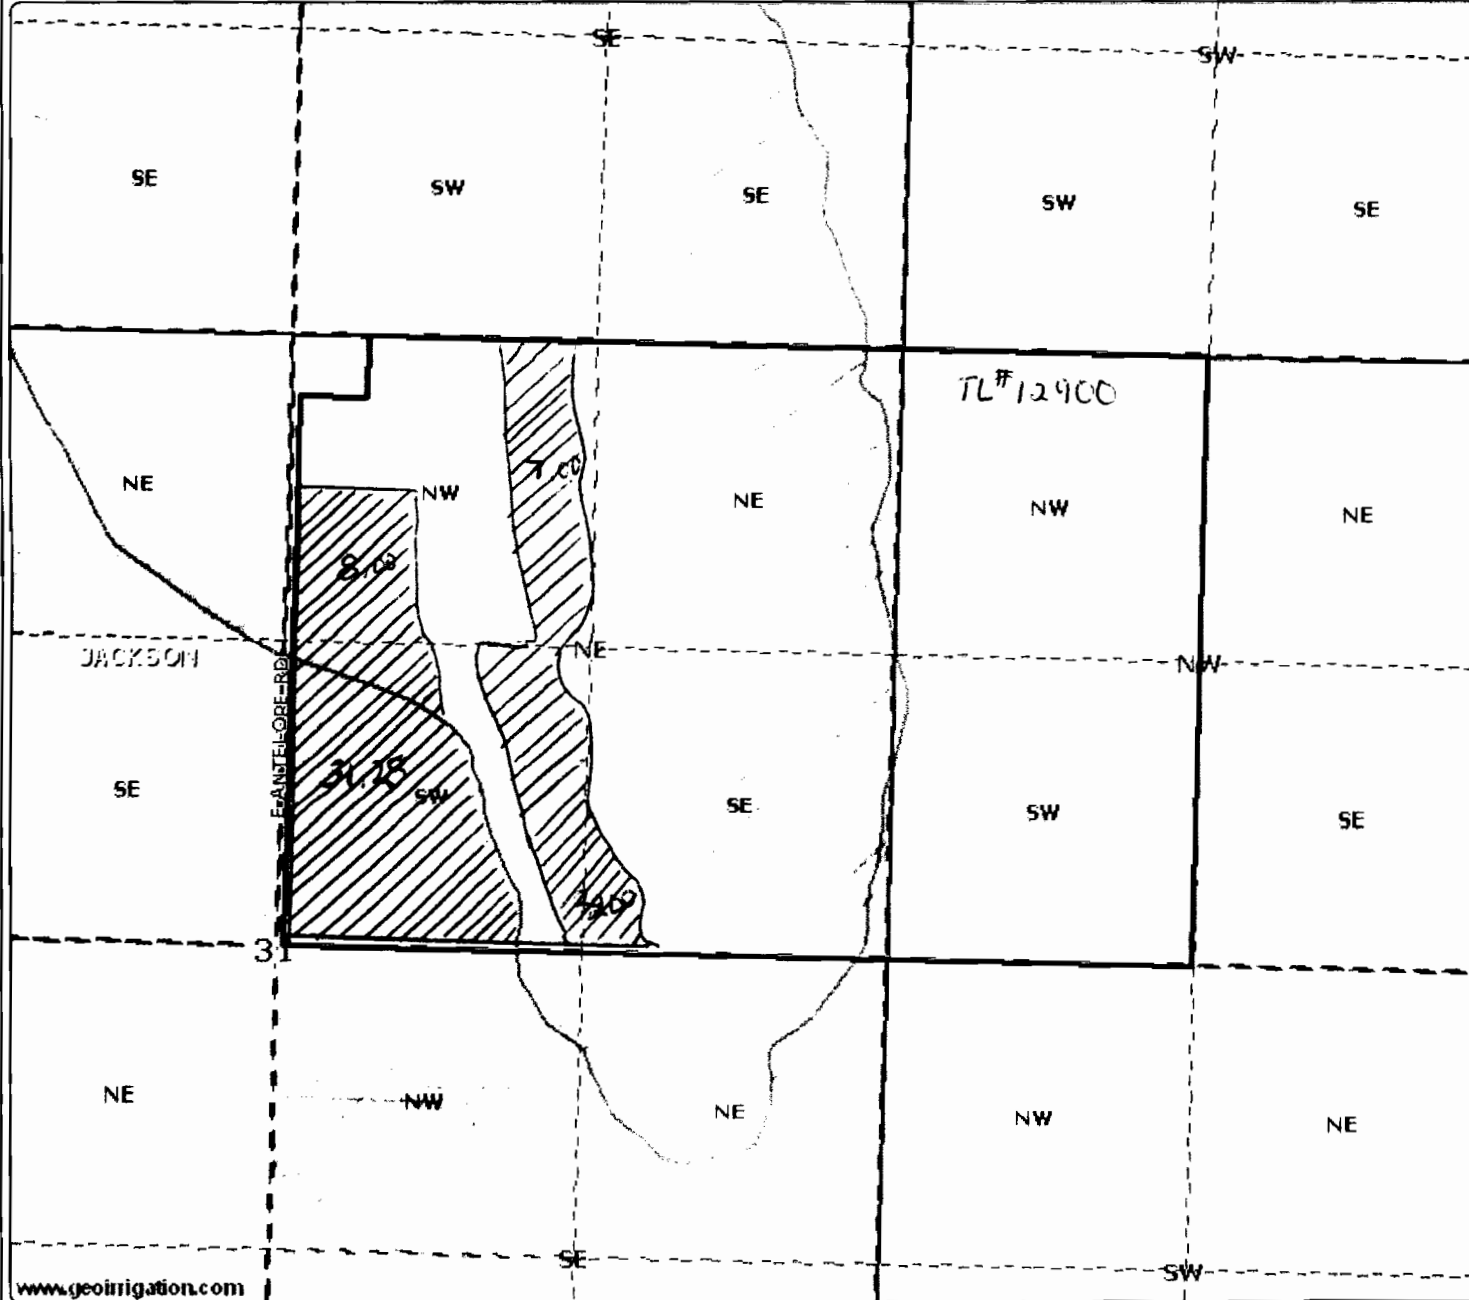

Authorized Place of Use

361E31 #12900

48.28 ac

- District Boundary USBR
- County Boundary
- Major Roads
- Road Labels
- Township Range
- Sections
- Section Labels
- Quarters
- Quarter Labels
- Quarter Quarters
- Quarter Quarters Labels
- Taxlots
- Canal All
- Canal Piped
- Canal Open
- Private Line
- POU District Primary

48.28 ac. BU



Scale 1" = 600'
Created: 8/15/2012

www.geoirrigation.com

DISCLAIMER: This map is intended for display purposes only and is not intended for any legal representations. There are no warranties, expressed or implied, that accompany this product.

RECEIVED BY OWRD

SEP 26 2012

SALEM, OR

CLAIM OF BENEFICIAL USE Site Report

Transfer Number: T - 10757

District Internal Notice #: 08-05

User Name: Theodore & Jackie Anderberg

Place of Use: **4388 South Stage Rd, Medford, Oregon**

USE	POD #	TWP	RNG	SEC	QQ	DLC	GOV'T LOT	TAX LOT	ACRES
IR	1,2,3,4	37S	2W	33	NWSE			800	1.00

District Conveyance System:

Description of Delivery System: Through pipeline to pressurized sprinklers and Drip system

Headgate: _____ Canal: Phoenix canal

Beneficial Use:

Description of Beneficial Use: Yard & Garden

Method Used to Apply Water: pump/sprinklers

Method Used to Calculate Beneficial Use: Observation by Curt(Ditchrider)

User Interviewed: (X) Yes () No

Beneficial Use Made as Authorized: (X) Yes () No

Description of Beneficial Use if Less than

Authorized: _____

Inspected By: Curt Vandagriff(Ditchrider) Date: August 20, 2012


Instructions: Attach and label the corresponding final proof map.

RECEIVED BY OWRD

SEP 26 2012

Medford Irrigation District

Authorized Place of Use
 372W33 #800
 1 ac.

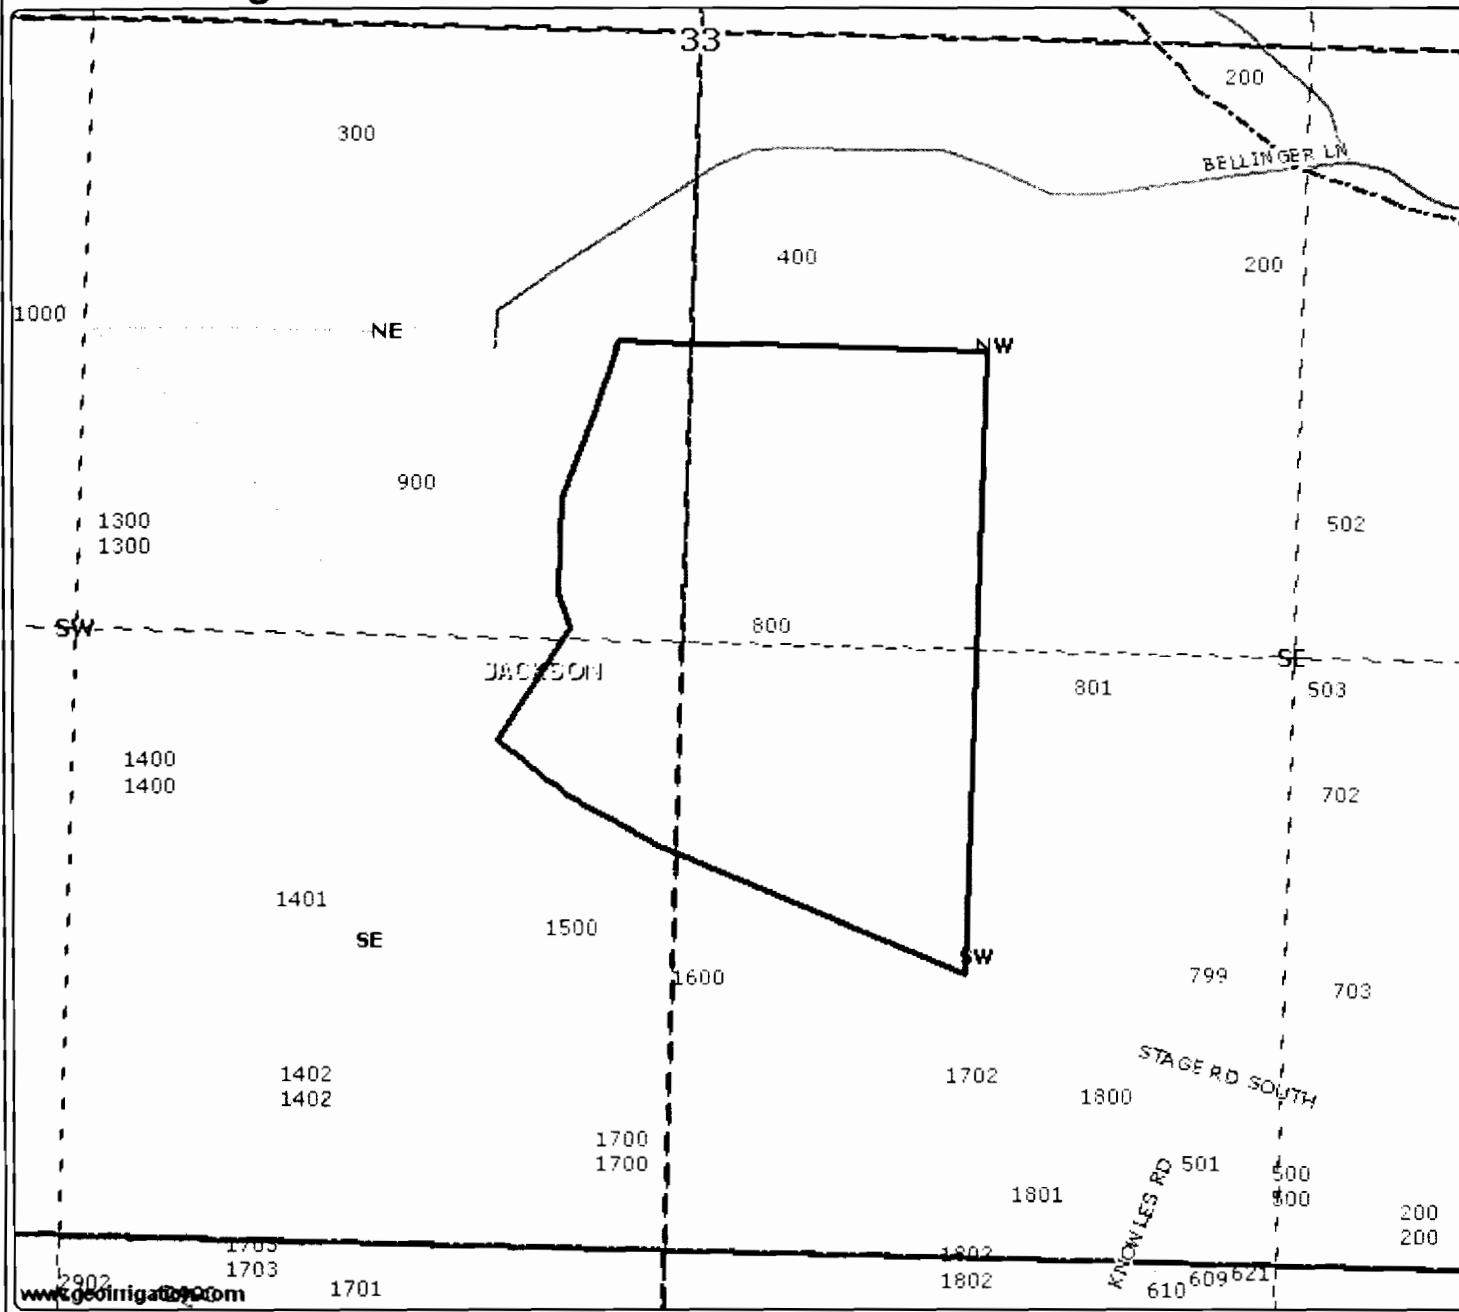

- District Boundary USBR
- County Boundary
- Major Roads
- Road Labels
- Roads
- Township Range
- Sections
- Section Labels
- Quarters
- Quarter Labels
- Quarter Quarters
- Quarter Quarters Labels
- Lot Labels
- Taxlots
- Canal All
- Canal Piped
- Canal Open
- Private Line
- POU District Primary
- Irrigation Ditches JACK CO
- RVCOG Laterals

SALEM, OR



Scale 1" = 400'
 Created: 8/15/2012

www.goinirrigation.com

DISCLAIMER: This map is intended for display purposes only and is not intended for any legal representations. There are no warranties, expressed or implied, that accompany this product.

SEP 26 2012

RECEIVED BY OWRD

CLAIM OF BENEFICIAL USE Site Report

Transfer Number: T - 10757

District Internal Notice #: 08-06

User Name: Robert & Linda Turner

Place of Use: 1600 Goldstone Drive, Central Point, Oregon

USE	POD #	TWP	RNG	SEC	QQ	DLC	GOV'T LOT	TAX LOT	ACRES
IR	1,2,3,4	37S	2W	17	NESE			Old tl#3603/new#100	4.05

District Conveyance System:

Description of Delivery System: Pump with pressurized sprinkler system

Headgate: _____ Canal: Phoenix canal

Beneficial Use:

Description of Beneficial Use: Pasture/Hay

Method Used to Apply Water: pump/sprinkler

Method Used to Calculate Beneficial Use: Observation by Curt(Ditchrider) spoke with owner

User Interviewed: (X) Yes () No

Beneficial Use Made as Authorized: (X) Yes () No

Description of Beneficial Use if Less than

Authorized: _____


Inspected By: Curt Vandagrif(Ditchrider) Date: August 20, 2012

Instructions: Attach and label the corresponding final proof map.

RECEIVED BY OWRD

SEP 26 2012

Medford Irrigation District

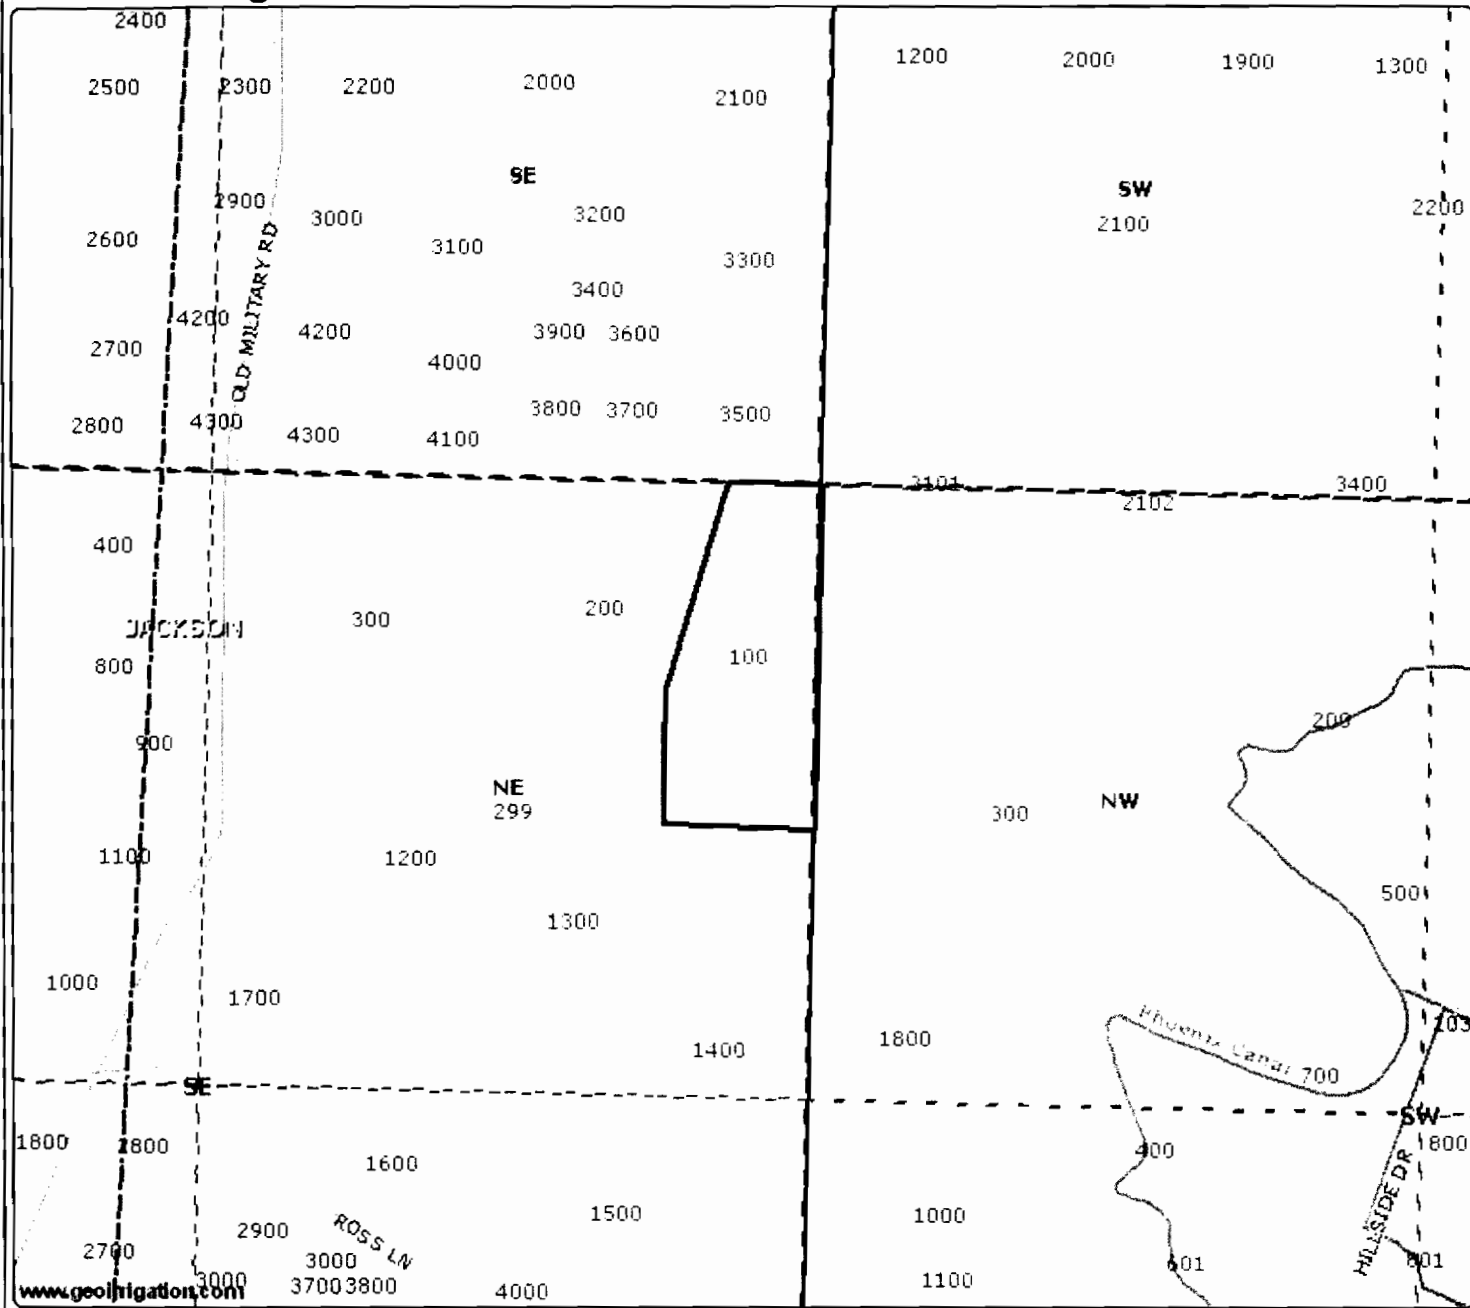

Authorized Place of Use
 372W17D new tax lot 100/old
 tax lot 3603

- District Boundary USBR
- County Boundary
- Major Roads
- Road Labels
- Roads
- Township Range
- Sections
- Section Labels
- Quarters
- Quarter Labels
- Quarter Quarters
- Quarter Quarters Labels
- Lot Labels
- Taxlots
- Canal All
- Canal Piped
- Canal Open
- Private Line
- POU District Primary
- Irrigation Ditches JACK CO
- RVCOG Laterals



Scale 1" = 400'
 Created: 8/15/2012

SEP 26 2012

SALEM, OR

RECEIVED BY OWRD

www.geolirrigation.com

DISCLAIMER: This map is intended for display purposes only and is not intended for any legal representations. There are no warranties, expressed or implied, that accompany this product.

**CLAIM OF BENEFICIAL USE
Site Report**

Transfer Number: T - 10757

District Internal Notice #: 08-07

User Name: Thomas & Tiffany Malot

Place of Use: 1609 Goldstone Drive, Central Point, Oregon

USE	POD #	TWP	RNG	SEC	QQ	DLC	GOVT LOT	TAX LOT	ACRES
IR	1,2,3,4	37S	2W	17	NESE			Old tl#3602/new#200	4.50

District Conveyance System:

Description of Delivery System: Pump with pressurized sprinkler system

Headgate: _____ Canal: Phoenix canal

Beneficial Use:

Description of Beneficial Use: Pasture/Hay

Method Used to Apply Water: pump/sprinkler

Method Used to Calculate Beneficial Use: Observation by Curt(Ditchrider) spoke with owner

User Interviewed: (X) Yes () No

Beneficial Use Made as Authorized: (X) Yes () No

Description of Beneficial Use if Less than

Authorized: _____

Inspected By: Curt Vandagriff(Ditchrider) Date: August 20, 2012


Instructions: Attach and label the corresponding final proof map.

RECEIVED BY OWRD

SEP 26 2012

Medford Irrigation District

Authorized Place of Use
 372W17D new tax lot 200/old
 3602

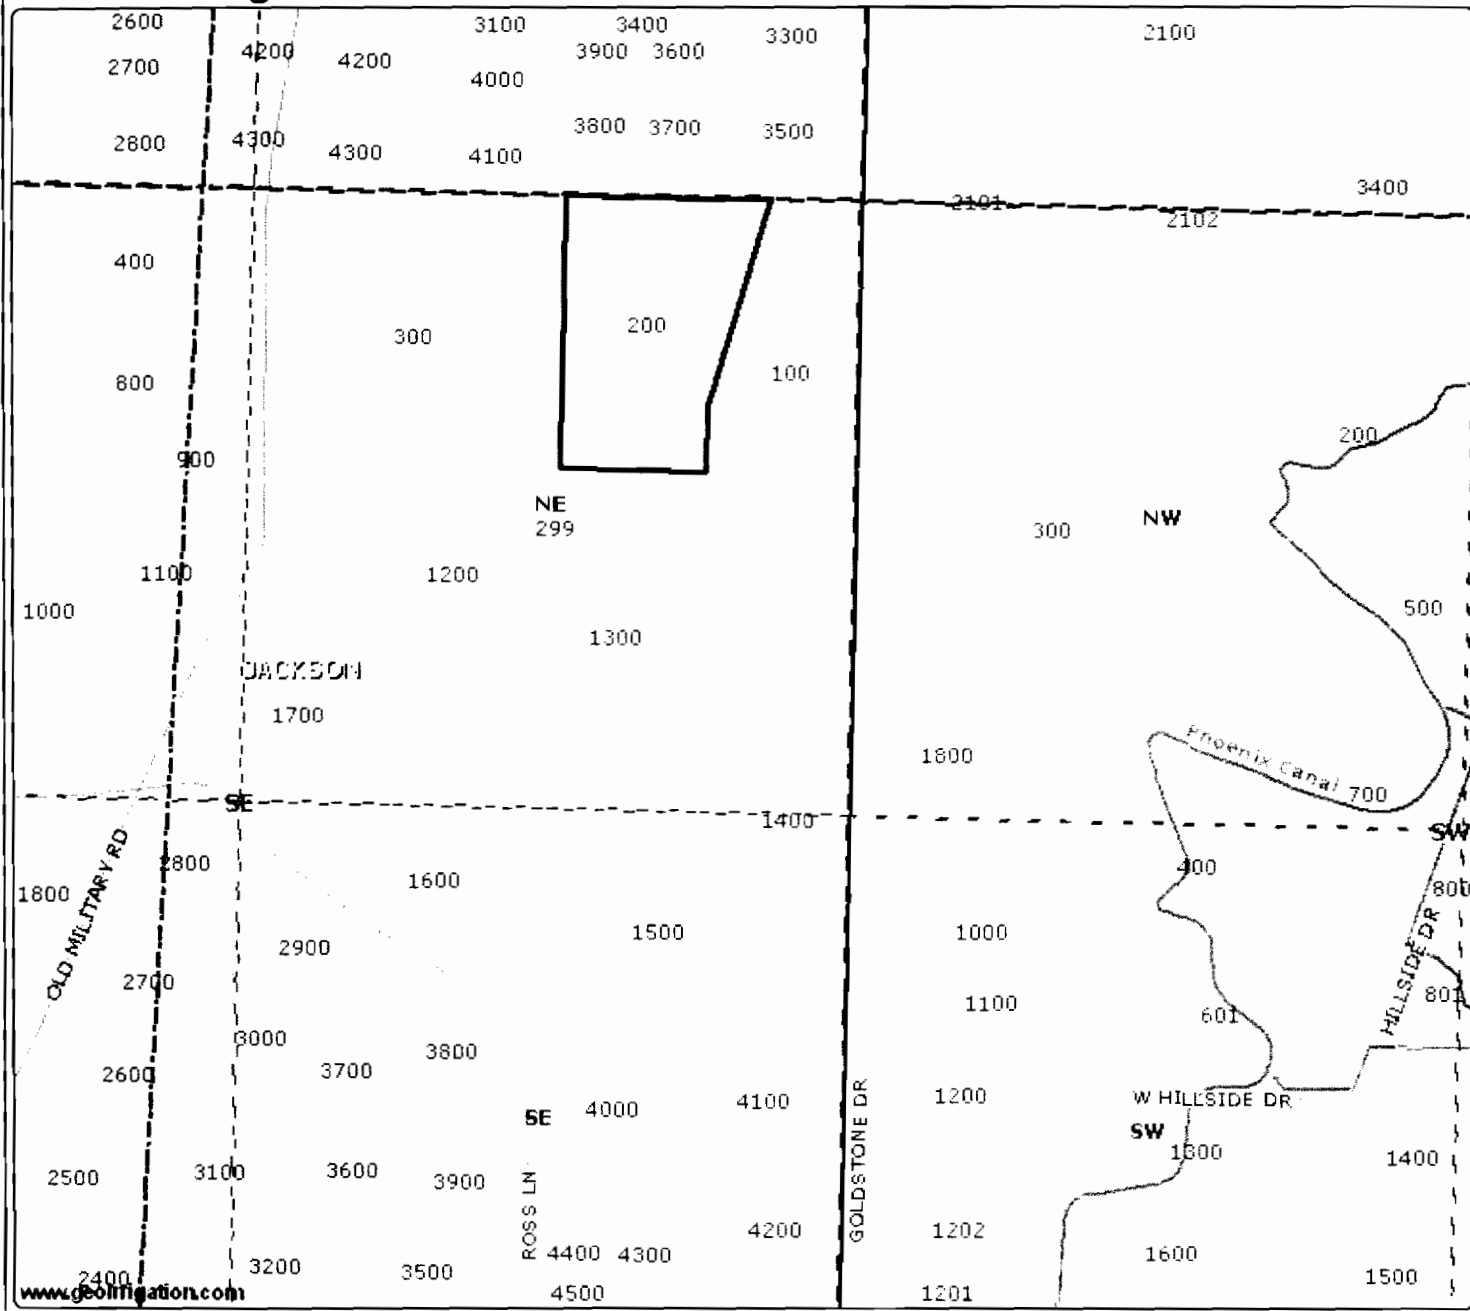

- District Boundary USBR
- County Boundary
- Major Roads
- Road Labels
- Roads
- Township Range
- Sections
- Section Labels
- Quarters
- Quarter Labels
- Quarter Quarters
- Quarter Quarters Labels
- Lot Labels
- Taxlots
- Canal All
- Canal Piped
- Canal Open
- Private Line
- POU District Primary
- Irrigation Ditches JACK CO
- RVCOG Laterals



Scale 1" = 400'
 Created: 8/15/2012

www.geointegration.com

DISCLAIMER: This map is intended for display purposes only and is not intended for any legal representations. There are no warranties, expressed or implied, that accompany this product.

SEP 26 2012

SALEM, OR

RECEIVED BY OWRD

**CLAIM OF BENEFICIAL USE
Site Report**

Transfer Number: T - 10757

District Internal Notice #: 08-08

User Name: Herman & Catherine Steigerwald

Place of Use: **1469 Goldstone Drive, Central Point, Oregon**

USE	POD #	TWP	RNG	SEC	QQ	DLC	GOV'T LOT	TAX LOT	ACRES
IR	1,2,3,4	37S	2W	17	NESE			Old tl#3600/new#1300	4.47

District Conveyance System:

Description of Delivery System: Pump with pressurized sprinkler system

Headgate: _____ Canal: Phoenix canal

Beneficial Use:

Description of Beneficial Use: Pasture/Hay

Method Used to Apply Water: pump/sprinkler

Method Used to Calculate Beneficial Use: Observation by Curt(Ditchrider) spoke with owner

User Interviewed: (X) Yes () No

Beneficial Use Made as Authorized: (X) Yes () No

Description of Beneficial Use if Less than

Authorized: _____

Inspected By: Curt Vandagriff(Ditchrider) Date: August 20, 2012


Instructions: Attach and label the corresponding final proof map.

RECEIVED BY OWRD

SEP 26 2012

SALEM, OR

Medford Irrigation District

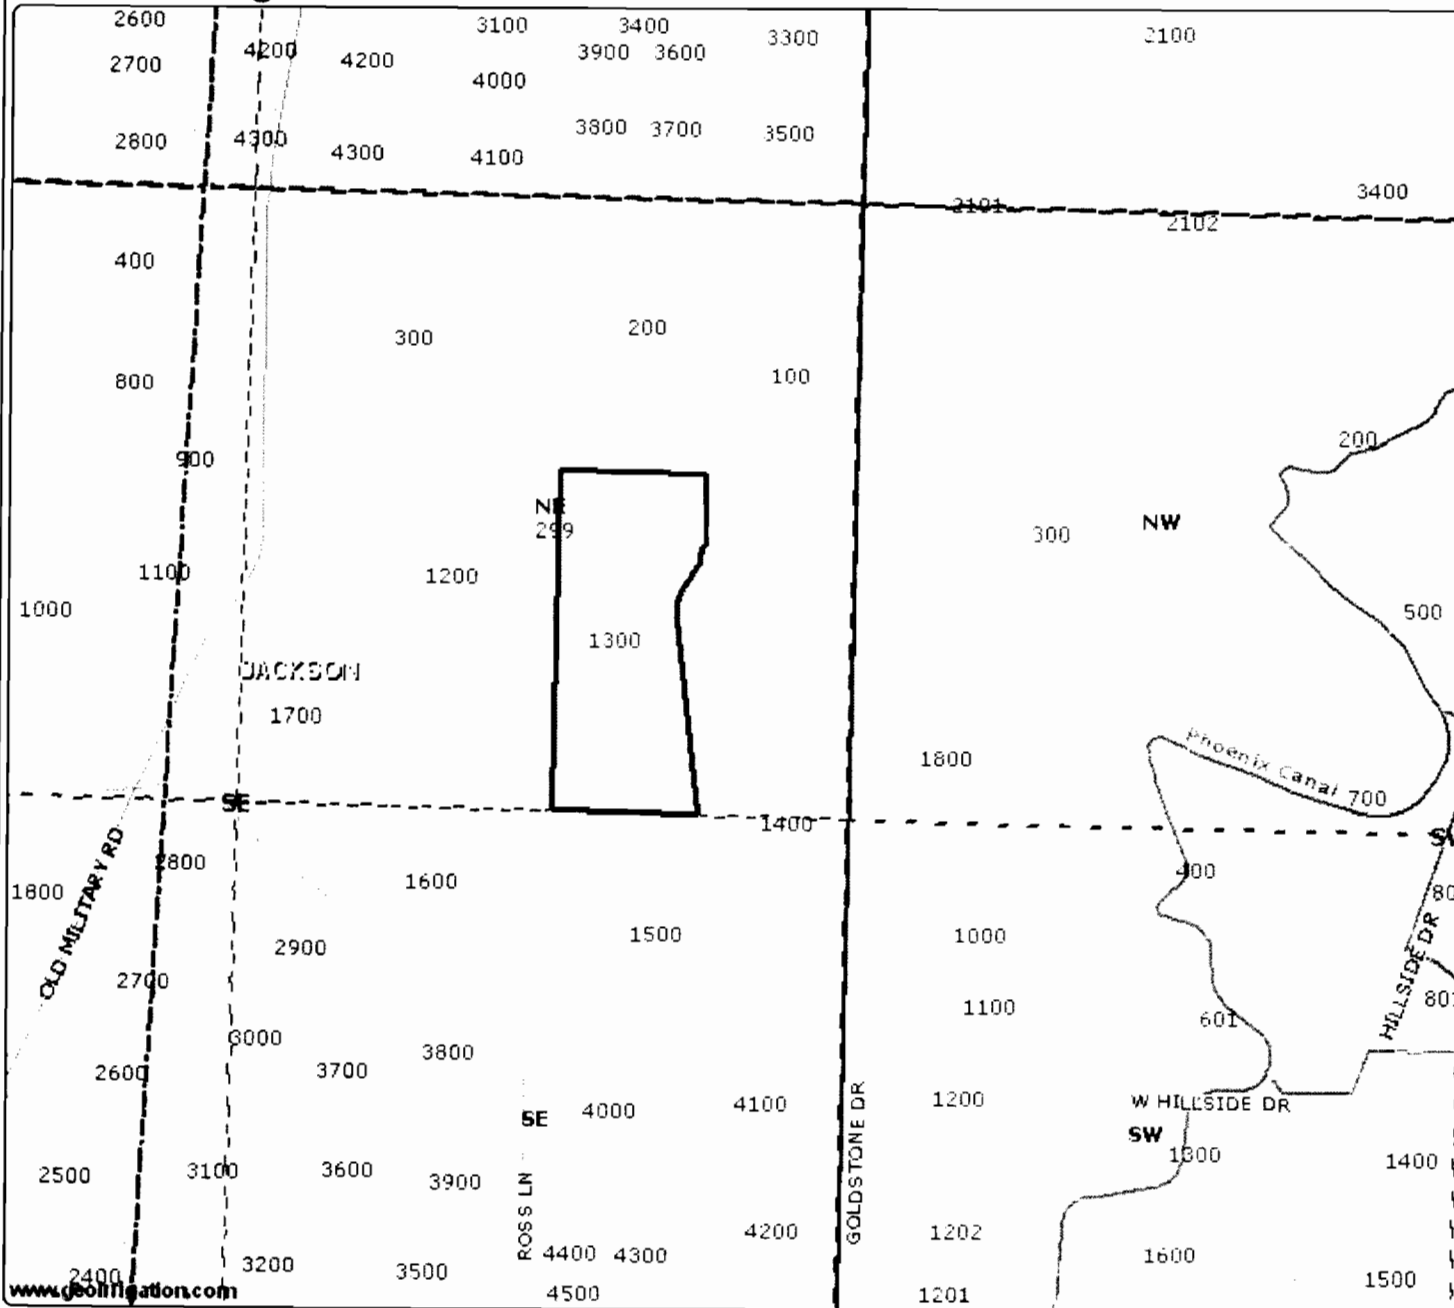

Authorized Place of Use
 372W17D new tax lot 1300/old
 3600

- District Boundary USBR
- County Boundary
- Major Roads
- Road Labels
- Roads
- Township Range
- Sections
- Section Labels
- Quarters
- Quarter Labels
- Quarter Quarters
- Quarter Quarters Labels
- Lot Labels
- Taxlots
- Canal All
- Canal Piped
- Canal Open
- Private Line
- POI District Primary
- Irrigation Ditches JACK CO
- R/COG Laterals

www.geonavigation.com



Scale 1" = 400'
 Created: 8/15/2012

DISCLAIMER: This map is intended for display purposes only and is not intended for any legal representations. There are no warranties, expressed or implied, that accompany this product

RECEIVED BY OWRD

SEP 26 2012

SALEM, OR

CLAIM OF BENEFICIAL USE Site Report

Transfer Number: T - 10757

District Internal Notice #: 08-09

User Name: Gere E. Brown

Place of Use: **4100 South Stage Rd., Medford, Oregon**

USE	POD #	TWP	RNG	SEC	QQ	DLC	GOV'T LOT	TAX LOT	ACRES
TR	1,2,3, 4,5	37S	2W	33	NESE			700	5.82

District Conveyance System:

Description of Delivery System: Pump from canal to pressurized sprinkler system

Headgate: _____ Canal: West Main Canal

Beneficial Use:

Description of Beneficial Use: Yard, Garden, Pasture

Method Used to Apply Water: Pump

Method Used to Calculate Beneficial Use: Observation and Curt(ditchrider spoke to patron

User Interviewed: (X) Yes () No

Beneficial Use Made as Authorized: (X) Yes () No

Description of Beneficial Use if Less than Authorized: _____

Inspected By: Curt Vandagriff(ditchrider) Date: 9/7/2012












RECEIVED BY OWRD


Instructions: Attach and label the corresponding final proof map.

SEP 26 2012

Medford Irrigation District

Authorized Place of Use
 372W33 #700
 5.82 ac

-  District Boundary USBR
-  County Boundary
-  Major Roads
-  Road Labels
-  Township Range
-  Sections
-  Section Labels
-  Quarters
-  Quarter Labels
-  Quarter Quarters
-  Quarter Quarters Labels
-  Lot Labels
-  Taxlots
-  Canal All
-  Canal Piped
-  Canal Open
-  Private Line
-  POU District Primary

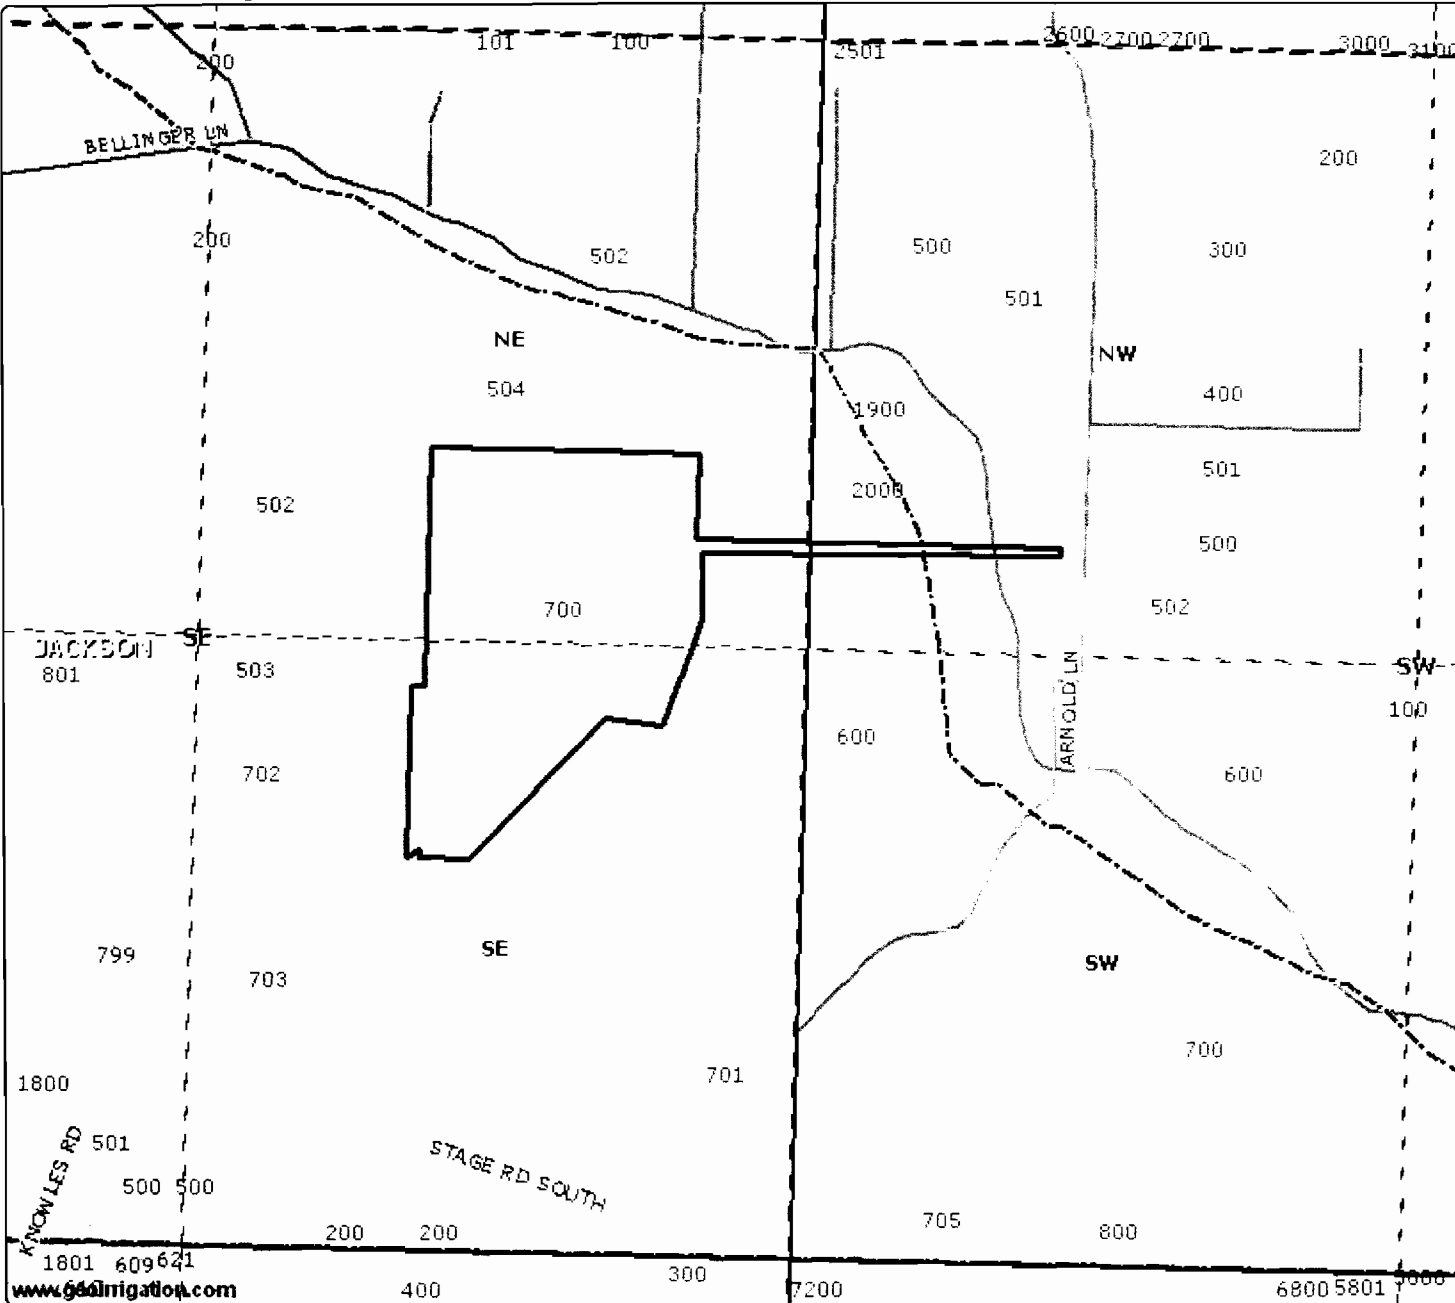

SEP 26 2012
 SALEM, OR



Scale 1" = 400'
 Created: 8/15/2012

www.medi.com

DISCLAIMER: This map is intended for display purposes only and is not intended for any legal representations. There are no warranties, expressed or implied, that accompany this product.

RECEIVED BY OWRD

**CLAIM OF BENEFICIAL USE
Site Report**

Transfer Number: T - 10757

District Internal Notice #: 08-10

User Name: Martha Brooks Family LLC

Place of Use: 1767 Brownsboro Meridian Rd., Eagle Point, Oregon

USE	POD #	TWP	RNG	SEC	QQ	DLC	GOV'T LOT	TAX LOT	ACRES
IR	1,2,,4	36S	1E	5	SESW			2403	20.80
IR	1,2,4	36S	1E	5	SWSE			2403	.20

District Conveyance System:

Description of Delivery System: Pump to pond to pressurized sprinklers system

Headgate: _____ Canal: MID's main canal

Beneficial Use:

Description of Beneficial Use: Pasture

Method Used to Apply Water: Pump

Method Used to Calculate Beneficial Use: Observation and spoke with Martha Brooks (owner)

User Interviewed: (X) Yes () No

Beneficial Use Made as Authorized: (X) Yes () No

Description of Beneficial Use if Less than

Authorized: _____

Inspected By: Carol Bradford, District Manager


Date: August 20, 2012

Instructions: Attach and label the corresponding final proof map.

RECEIVED BY OWRD

SEP 26 2012

Medford Irrigation District

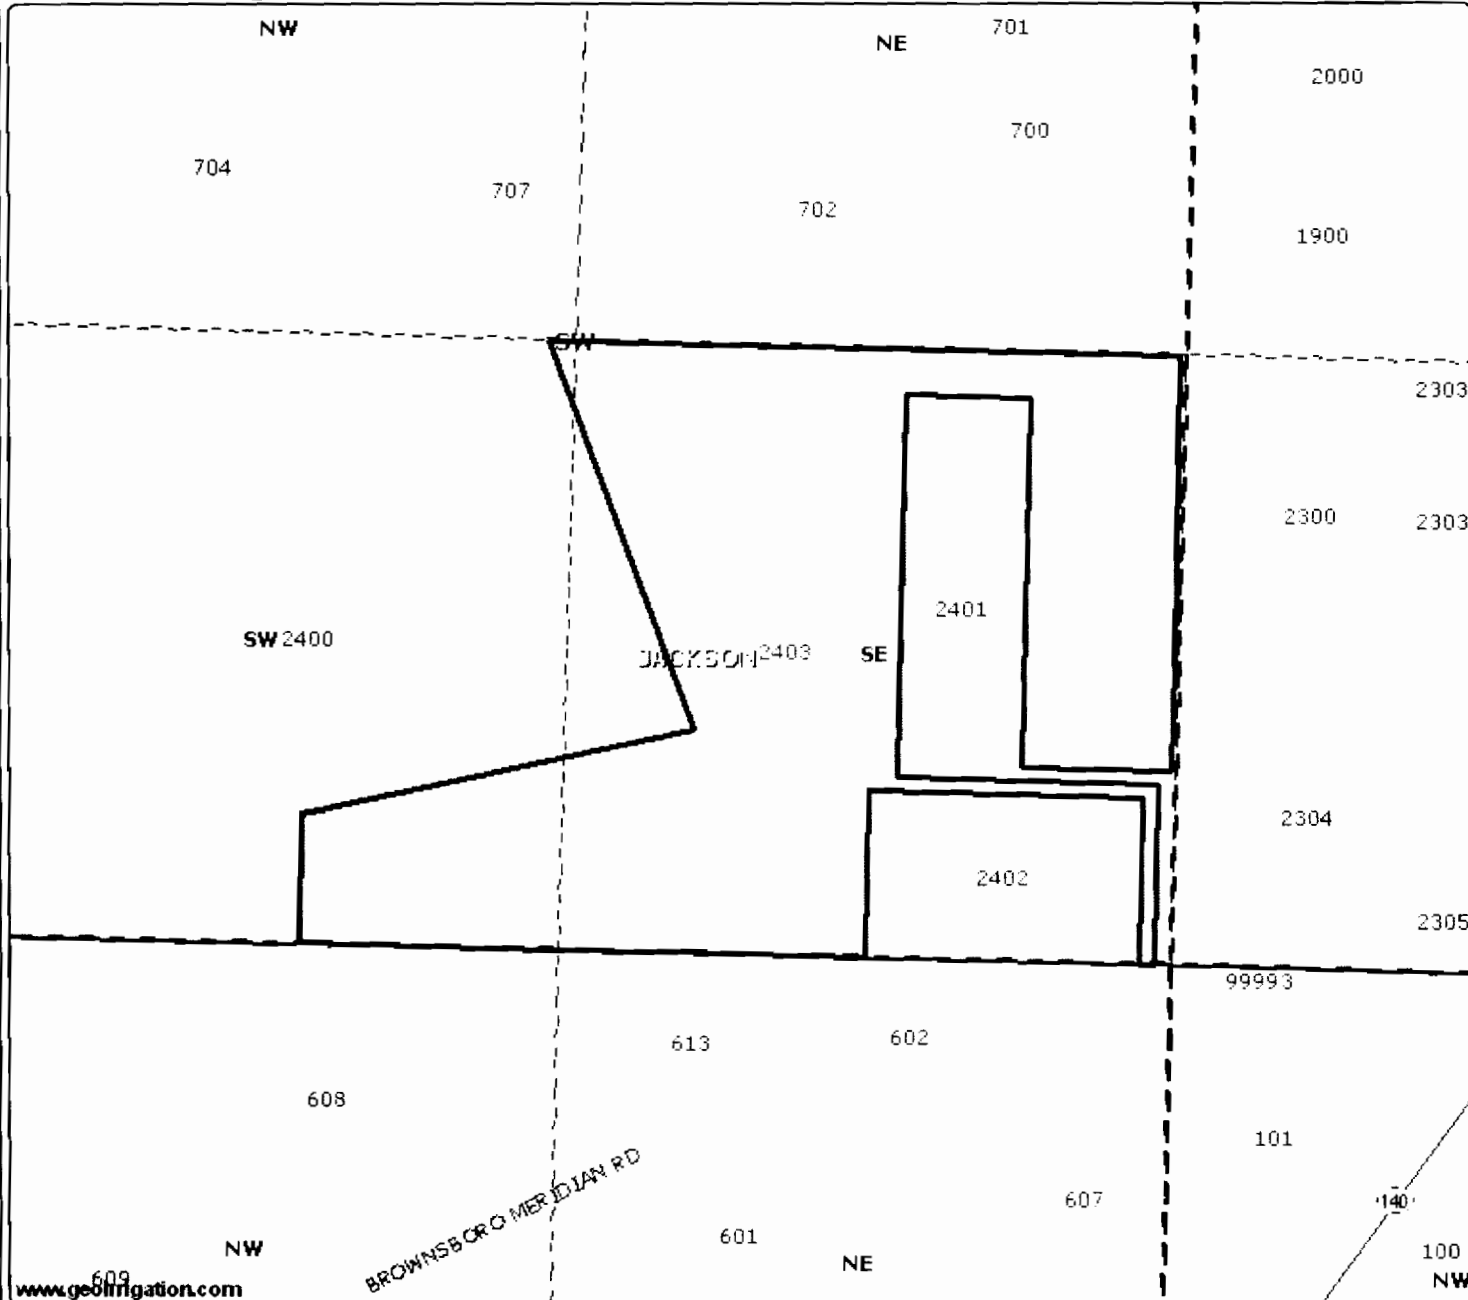

Authorized Place of Use
361E5 #2403
21.00 ac

- District Boundary USBR
- County Boundary
- Major Roads
- Road Labels
- Township Range
- Sections
- Section Labels
- Quarters
- Quarter Labels
- Quarter Quarters
- Quarter Quarters Labels
- Lot Labels
- Taxlots
- Canal All
- Canal Piped
- Canal Open
- Private Line
- POU District Primary

RECEIVED BY OWRD

SEP 26 2012

SALEM, OR



Scale 1" = 400'
 Created: 8/15/2012

**CLAIM OF BENEFICIAL USE
Site Report**

Transfer Number: T - 10757

District Internal Notice #: 08-11

User Name: **Debbie Luehrs**

Place of Use: 1800 Dry Creek Rd., Eagle Point, Oregon

USE	POD #	TWP	RNG	SEC	QQ	DLC	GOV'T LOT	TAX LOT	ACRES
IR	1,2,4,	36S	1W	36	SWSE			414	5.00
								TOTAL	5.00

District Conveyance System:

Description of Delivery System: PUMP TO PRESSURIZED RAIN BIRDS SPRINKLER SYSTEM

Headgate: _____ Canal: MID's Main Canal

Beneficial Use:

Description of Beneficial Use: (Pasture) pump from Main Canal (sprinklers)

Method Used to Apply Water: Rain Bird Sprinklers

Method Used to Calculate Beneficial Use: Observation and Tom(ditchrider spoke to patron

User Interviewed: Yes No

Beneficial Use Made as Authorized: Yes No

Description of Beneficial Use if Less than

Authorized: _____


Inspected By: Tom Lucas(ditchrider) Date: 9/24/2012

RECEIVED BY OWRD

Instructions: Attach and label the corresponding final proof map.

SEP 26 2012

Medford Irrigation District

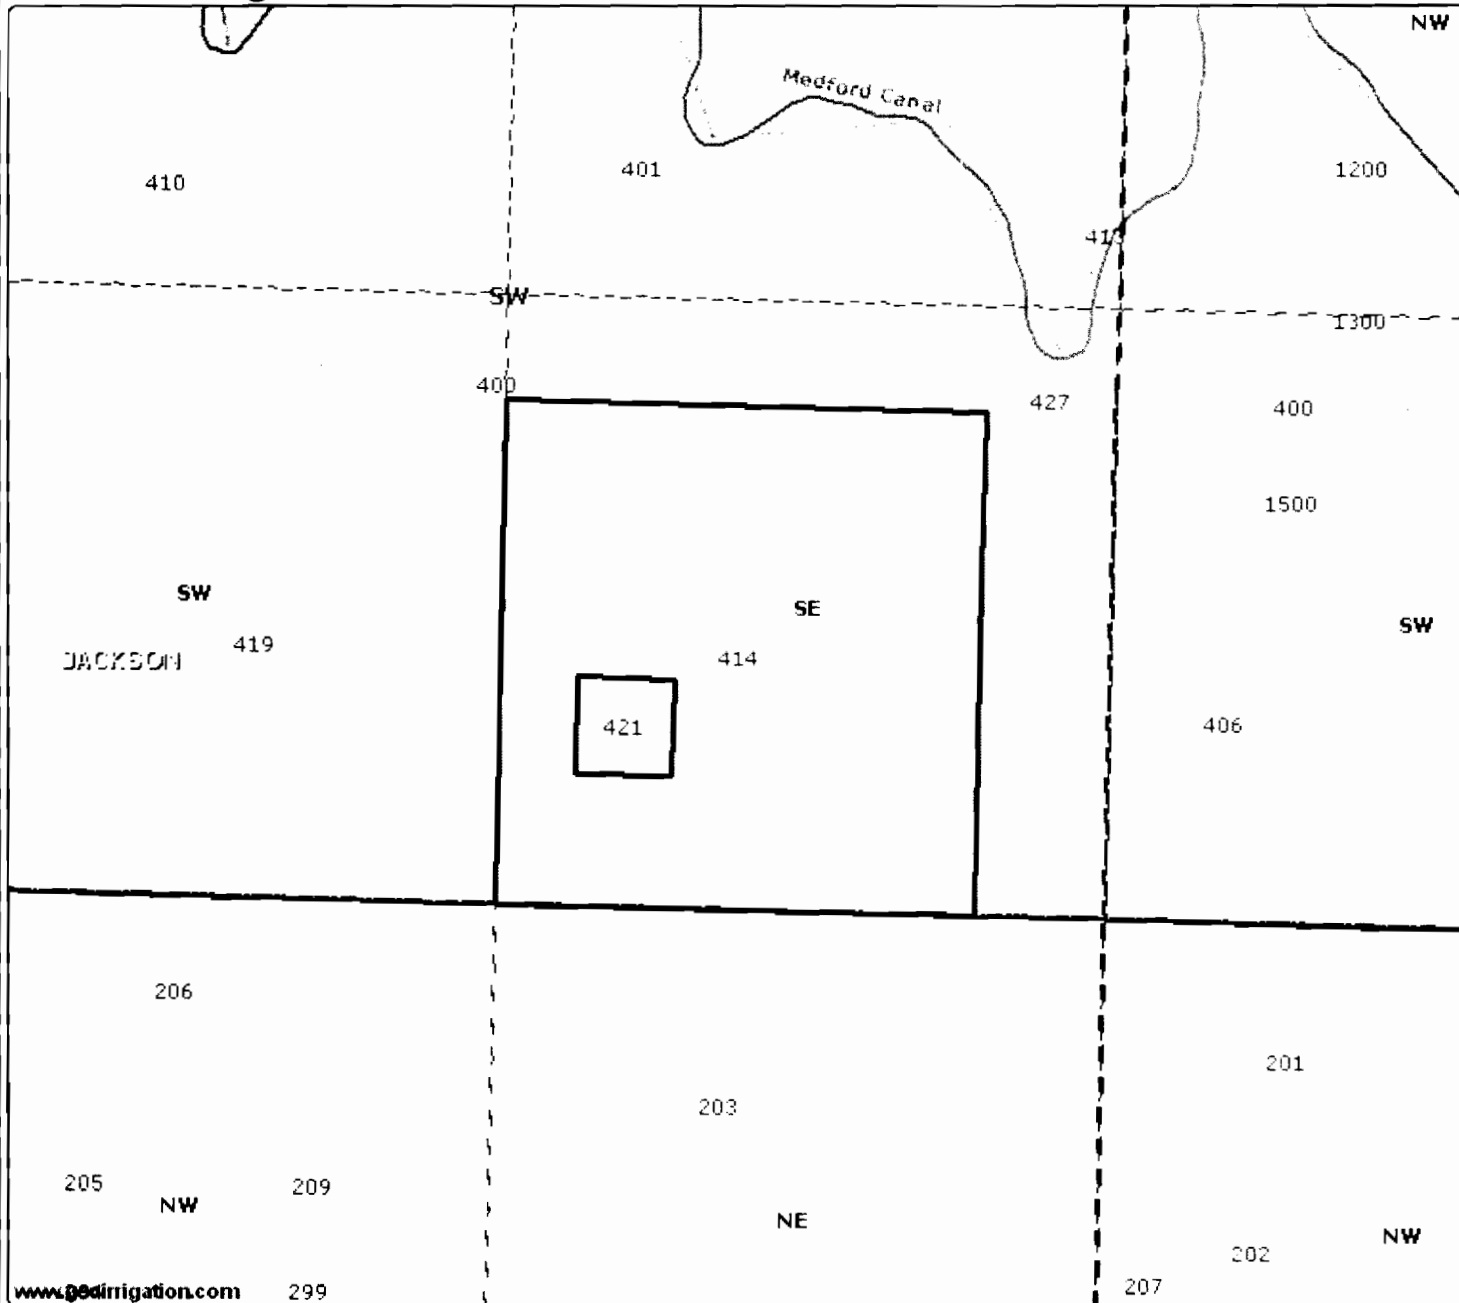

Authorized Place of Use

361W36 #414

5 ac

- District Boundary USBR
- County Boundary
- Major Roads
- Road Labels
- Roads
- Township Range
- Sections
- Section Labels
- Quarters
- Quarter Labels
- Quarter Quarters
- Quarter Quarters Labels
- Lot Labels
- Taxlots
- Canal All
- Canal Piped
- Canal Open
- Private Line
- POU District Primary
- Irrigation Ditches JACO
- RVC OG Laterals

RECEIVED BY OWRD

SEP 26 2012

SALEM, OR



Scale 1" = 400'
Created: 8/15/2012

DISCLAIMER: This map is intended for display purposes only and is not intended for any legal representations. There are no warranties, expressed or implied, that accompany this product.