

TALENT IRRIGATION DISTRICT

P.O. Box 467

104 W. Valley View Rd.

Talent OR 97540-0467

Website:

www.talentid.org

Phone: 541-535-1529

Fax: 541-535-4108

Email: tid@talentid.org

CLAIM OF BENEFICIAL USE

Priority Mail

RECEIVED BY OWRD

September 15, 2014

SEP 17 2014

SALEM, OR

Susan Douthit, District Advisor
Oregon Water Resources Department
725 Summer Street NE Suite A
Salem, OR 97301-1271

RE: Claim of Beneficial Use for T-11705

District Transfer Year: 2013

Dear Susan:

Enclosed is Talent Irrigation District's form entitled "District Permanent Water Right Transfer Claim of Beneficial Use" for your Transfer Number T-11705 submitted to OWRD by the District on December 26, 2013. Also enclosed are the "Claim of Beneficial Use Site Reports" and copies of the "To" land maps showing the new location of the water rights on each property. The following is a summary of the transfers listed with our internal file number and landowner name:

<u>TID FILE NO.</u>	<u>NAME</u>
11-4	State of Oregon - ODOT (Exit 14 only)
12-2	Tucker
12-3	Nickell
13-1	Naumes
13-2	Nickell

The Site Reports are attached to each map and are signed by the District representative inspecting each property. Specific details about the properties are contained in each site report.

The District has inspected all of the above parcels to confirm that the changes have been made as mapped and contained in the final proof report.

Susan Douthit
Page 2
September 15, 2014

I hereby certify the changes are completed as authorized and that each property has met their Claim of Beneficial Use as mapped.

I am authorized to sign on behalf of Talent Irrigation District.



Jim Pendleton, Secretary-Manager
Talent Irrigation District

Date: September 15, 2014

JP/wd

Enclosures

RECEIVED BY OWRD

SEP 17 2014

SALEM, OR



Oregon Water Resources Department
 725 Summer Street NE, Suite A
 Salem, Oregon 97301-1266
 (503) 986-0900
 www.wrd.state.or.us

District Permanent Water Right Transfer Claim of Beneficial Use

1. APPLICANT INFORMATION

District: Talent Irrigation District

District Transfer Year: 2013

Contact Person: Jim Pendleton, Manager

Phone: 541-535-1529

Mailing Address: PO Box 467

City: Talent State: OR

Zip: 97540

RECEIVED BY OWRD

E-Mail address:

tid@talentid.org

SEP 17 2014

Transfer Number: T - 11705

SALEM, OR

2. WATER RIGHT(S)

Pursuant to OAR Chapter 690, Division 385, the district is submitting to the Water Resources Department this claim of beneficial use for the following water right(s):

PERMIT NUMBER	CERTIFICATE NUMBER	DECREE (name, volume, and page)	PRIMARY (P) OR SUPP (S)
-	83727		<input checked="" type="checkbox"/> P <input checked="" type="checkbox"/> S
-	79212		<input checked="" type="checkbox"/> P <input type="checkbox"/> S
-			<input type="checkbox"/> P <input type="checkbox"/> S
-			<input type="checkbox"/> P <input type="checkbox"/> S

3. AUTHORIZED POINT(S) OF DIVERSION (POD) / APPROPRIATION (POA)

The authorized point(s) of diversion / appropriation for the water right modified by the transfer are as follows:

PERMIT NUMBER	DECREE or CERTIFICATE	POD / POA #	SOURCE	LOCATION - MEASURED DISTANCES
-	N/A			
-				
-				
-				

4. AUTHORIZED PLACE OF USE


The summary of the perfected change in place of use authorized by the final order approving the water right transfer is listed in Table 1.

TABLE 1 - AUTHORIZED PLACE OF USE (POU)												
CERTIFICATE DECREE or PERMIT	POD / POA #	PRIORITY DATE	USE	LEGAL DESCRIPTION							ACRES	USER NAME
				TWP	RNG	SEC	QQ	DLC	GOV'T LOT	TAX LOT		
79212	11-4	8-20-1915	IR	39S	1E	11	SW NE			N/A	2.31	STATE OF OREGON DOT
79212	11-4	8-20-1915	IR	39S	1E	14	NW NE			N/A	1.87	STATE OF OREGON DOT
83727	12-2	9-06-1915	IR	39S	1E	25	NE SE			416	2.00	TUCKER, JOHN/LOUISE
79212	12-3	8-20-1915	IR	38S	2W	01D	NW SE			1500	.28	NICKELL, NANCY
79212	12-3	8-20-1915	IR	38S	2W	01D	SW SE			1500	0.22	NICKELL, NANCY
79212	13-1	8-20-1915	IR	38S	2W	12	NW SE			101	.28	NAUMES, MICHAEL/LAURA
79212	13-1	8-20-1915	IR	38S	2W	12	SE SE			101	1.58	NAUMES, MICHAEL/LAURA
79212	13-1	8-20-1915	IR	38S	2W	12	SW SE			101	6.56	NAUMES, MICHAEL/LAURA
83727	13-2	9-06-1915	IR	38S	2W	01D	SW SE			1500	0.90	NICKELL, NANCY
83727	13-2	9-06-1915	IR	38S	2W	01D	NW SE			1500	0.90	NICKELL, NANCY
83727	13-2	9-06-1915	IR	38S	2W	01D	SW SE			1500	0.90	NICKELL, NANCY
79212	13-2	8-20-1915	IR	38S	2W	01D	SW SE			1500	.20	NICKELL, NANCY
TOTAL:											18.00	

RECEIVED BY OWRD
SEP 17 2014
SALEM, OR

6. SIGNATURES

The district certifies that it has inspected the place of use listed in Table I, and confirms the change in place of use has been completed consistent with the terms and conditions of the final order approving the transfer.

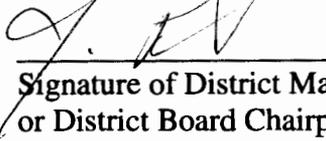

Signature of District Manager
or District Board Chairperson

September 9, 2014
Date

Jim Pendleton
Type or Print Name of District Manager
or District Board Chairperson

RECEIVED BY OWRD
SEP 17 2014
SALEM, OR

**CLAIM OF BENEFICIAL USE
Site Report**

SEP 17 2014

Transfer Number: T-11705District Internal Notice #: 11-4

SALEM, OR

User Name: State of Oregon Department of TransportationPhone: 541-957-3556Exit 14 Ashland, OR 97520**Place of Use:**

USE	POD #	TWP	RNG	SEC	QQ	DLC	GOVT LOT	TAX LOT	ACRES
IR	11-4	39S	1E	11D	SW SE			N/A (TID 9999)	2.31
IR	11-4	39S	1E	14	NW NE			N/A	1.87

TOTAL ACRES = 4.18

District Conveyance System:

Description of Delivery System: A-2/A-3 District Lateral off of the Ashland Canal. The Water will then go into a private pipeline owned by ODOT for distribution to Exit 14 landscaping.

Headgate: NoneCanal: Ashland Main Canal**Beneficial Use:**Description of Beneficial Use: Lawn and LandscapingMethod Used to Apply Water: Sprinkler irrigated. The water use is meteredMethod Used to Calculate Beneficial Use: Did on-site visit of the property comparing transfer map to the actual place of use.

User Interviewed: (X) Yes () No

Beneficial Use Made as Authorized: (X) Yes () No

Description of Beneficial Use if Less than Authorized:

NoneInspected By: Mark StittDate: 9-3-2014


Mark Stitt, Ditch Rider

Instructions: Attach and label the corresponding final proof map.

MAP OF WATER RIGHT TRANSFER
 PLACE OF USE
 SW1/4SE1/4, SECTION 11, T.39S., R.1E., W.M.
 NW1/4NE1/4, SECTION 14, T.39S., R.1E., W.M.
 JACKSON COUNTY, OREGON
 INTERSTATE HIGHWAY NO. 5,
 EXIT NO. 14, M.P. 14.03 TO M.P. 14.31
 FOR
 OREGON DEPARTMENT OF TRANSPORTATION
 100 ANTELOPE ROAD
 WHITE CITY, OR 97503

11-4
 39.1E-11414
 4.18 AC.
 "To Land"
 Exit 14

SW1/4SE1/4 Sec. 11 2.31 Ac.
 NW1/4NE1/4 Sec. 14 1.87 Ac.
 Total 4.18 Ac.

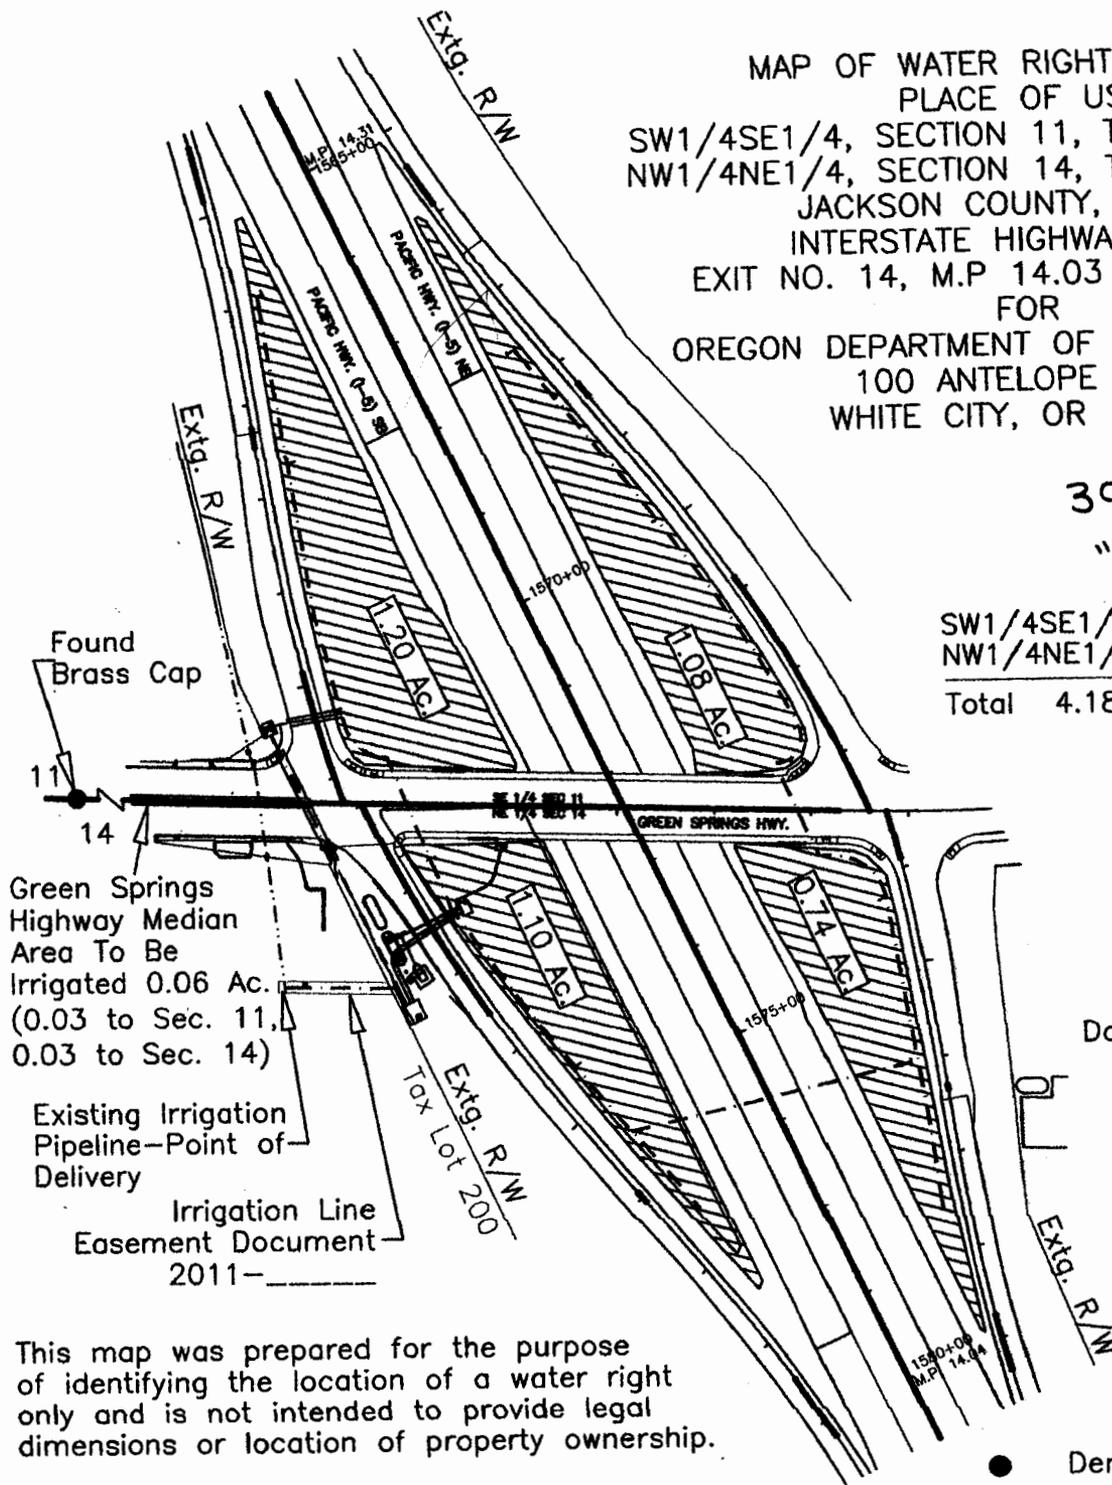


Scale: 1"=200'
 Date: May 16, 2011

RECEIVED BY OWRD
 SEP 17 2014
 SALEM, OR

LEGEND

- Denotes Found Corner
- - - Irrigation Pipeline
- ▨ Area To Be Irrigated
- Denotes Transfer From Tax Lot 1600, 38 1W 03 and Tax Lot 100, 38 1W 10 To Interstate Highway 5 M.P. 14.04 to 14.30


This map was prepared for the purpose of identifying the location of a water right only and is not intended to provide legal dimensions or location of property ownership.

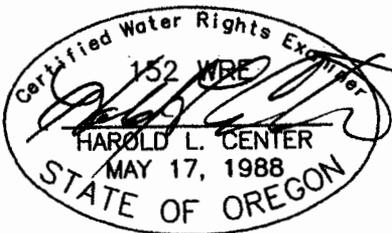


HAROLD L. CENTER
 2604 David Lane
 Medford, OR 97504
 Phone 541-535-6108
 Oregon Certificate No. 152
 Cert. Renewal Date: 12/31/11

12-2
39-1E-25 416
2.00 Ac.
"To Land"

MAP OF WATER RIGHT TRANSFER
PLACE OF USE
NE1/4SE1/4, SECTION 25, T.39S., R.1E., W.M. TAX LOT 416
LOT 10, THOMPSON PARK SUBDIVISION, JACKSON COUNTY, OR
FOR
TUCKER LOVING TRUST, DATED 2/21/1996
JOHN R. AND LOUISE F. TUCKER, TRUSTEES
203 WINDEMAR PLACE
ASHLAND, OR 97520

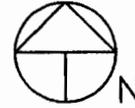

Scale: 1"=400'
Date: August 29, 2012

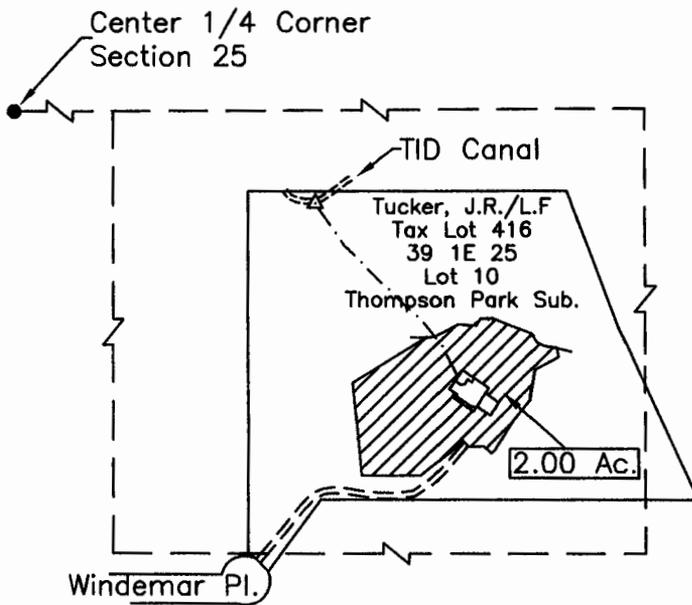

LEGEND

- Found Survey Monument
- Denotes Residence
- == Denotes Gravel Driveway
- - - Denotes Buried Pipeline
- △ Denotes Point of Delivery
- ▨ Denotes Transfer "To" Tax Lot 416, T.39S.; R.1E., Sec. 25

Point of Delivery, Talent Irrigation District Canal situated South 595' and East 1945' from the Center 1/4 Corner, Section 25.

RECEIVED BY OWRD

SEP 17 2014

SALEM, OR



This map was prepared for the purpose of identifying the location of a water right only and is not intended to provide legal dimensions or location of property ownership.

RECEIVED

SEP 19 2012

**TALENT
IRRIGATION DISTRICT**

HAROLD L. CENTER
2604 David Lane
Medford, OR. 97504
Phone 541-535-6108
Oregon Certificate No. 152
Cert. Renewal Date: 12/31/2013

RECEIVED BY OWRD

SEP 17 2014

SALEM, OR

**CLAIM OF BENEFICIAL USE
Site Report**

Transfer Number: T - 11705

District Internal Notice #: 12-3

User Name: Nancy Nickell

Phone: 541-608-2736

837 South Stage Rd

Medford, OR 97501

Place of Use:

USE	POD #	TWP	RNG	SEC	QQ	DLC	GOV'T LOT	TAX LOT	ACRES
IR	12-3	38S	2W	01D	NW SE			1500	0.28
IR	12-3	38S	2W	01D	SW SE			1500	0.22

TOTAL ACRES = 0.50

District Conveyance System:

Description of Delivery System: Private Pump Station on the Talent Canal

Headgate: None

Canal: Talent Main Canal

Beneficial Use:

Description of Beneficial Use: Lawn and Garden

Method Used to Apply Water: Sprinkler Irrigated. The water use is metered.

Method Used to Calculate Beneficial Use: Did on-site visit of the property comparing transfer map to the actual place of use.

User Interviewed: Yes No

Beneficial Use Made as Authorized: Yes No

Description of Beneficial Use if Less than Authorized:

None

Inspected By:  Date: 8-26-14

Bob Wilson, Ditch Rider

Instructions: Attach and label the corresponding final proof map.

MAP OF WATER RIGHT TRANSFER
PLACE OF USE

RECEIVED BY OWRD


SEP 17 2014

FOR
NANCY NICKELL
837 SOUTH STAGE ROAD
MEDFORD, OR 97501
LOCATED IN
SALEM, OR NW1/4SE1/4, SW1/4SE1/4, SECTION 1
T.38S., R.2W., W.M. - TAX LOT 1500
JACKSON COUNTY, OREGON

12-3

38-2W-01D 1500
.50Ac.

"To Land"

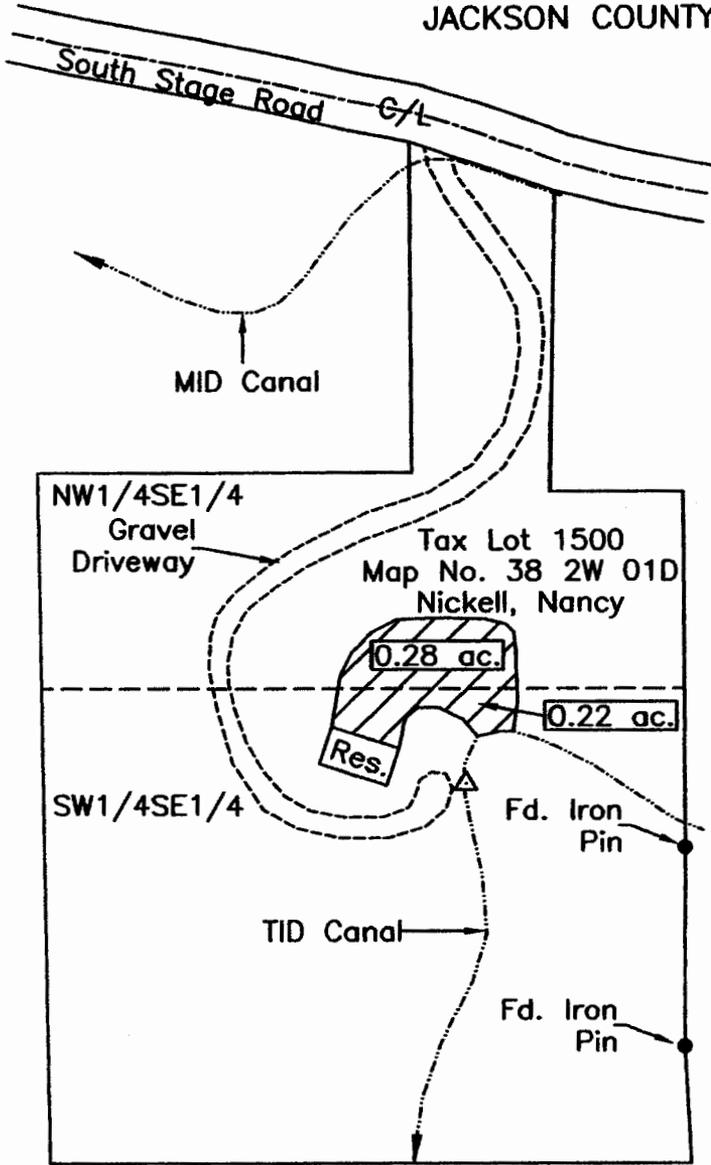

Scale: 1"=200'

Date: September 27, 2012

LEGEND

- Found Survey Monument
- Denotes Building
- Denotes Driveway
- ▨ Denotes Transfer "To" Tax Lot 1500, T.38S., R.2W., Section 1 From Tax Lot 100 T.38S., R.2W., Section 2

Note: Talent Irrigation District Point of Delivery is the Talent Main Canal, South 365' and West 915' from the SE Corner Donation Land Claim No. 38, T.38S., R.2W.



This map was prepared for the purpose of identifying the location of a water right only and is not intended to provide legal dimensions or location of property ownership.

Project: 12-16 Backen-Nickell

HAROLD L. CENTER
2604 David Lane
Medford, OR. 97504
Phone 541-535-6108
Oregon Certificate No. 152
Cert. Renewal Date: 12/31/2013

CLAIM OF BENEFICIAL USE Site Report

Transfer Number: T-11705

District Internal Notice #: 13-1

User Name: Michael D./Laura E. Naumes

Phone: 541-608-1718

1899 Carpenter Hill Rd Medford, OR 97501

Place of Use:

USE	POD #	TWP	RNG	SEC	QQ	DLC	GOVT LOT	TAX LOT	ACRES
IR	13-1	38S	2W	12	NW SE			101	0.28
IR	13-1	38S	2W	12	SE SE			101	1.58
IR	13-1	38S	2W	12	SW SE			101	6.56
TOTAL ACRES =									8.42

District Conveyance System:

Description of Delivery System: Private Pump Station on the Talent Canal

Headgate: None

Canal: Talent Main Canal

RECEIVED BY OWRD

Beneficial Use:

SEP 17 2014

Description of Beneficial Use: Vineyard

SALEM, OR

Method Used to Apply Water: Drip irrigated. The water use is metered.

Method Used to Calculate Beneficial Use: Did on-site visit of the property comparing transfer map to the actual place of use.

User Interviewed: Yes No

Beneficial Use Made as Authorized: Yes No

Description of Beneficial Use if Less than Authorized:

None

Inspected By: Bob Wilson

Date: 8-26-14

Bob Wilson, Ditch Rider

Instructions: Attach and label the corresponding final proof map.

RECEIVED BY OWRD

SEP 17 2014

SALEM, OR


MAP OF WATER RIGHT TRANSFER
PLACE OF USE

SECTION 12, T.38S., R.2W., W.M., TAX LOT 101
JACKSON COUNTY, OREGON

FOR
MICHAEL D. NAUMES AND LAURA E. NAUMES
P.O. BOX 996
2 BARNETT ROAD
MEDFORD, OR 97501

13-1
38-2w-12 101
8.42 Ac.
"To Land"
Naumes

East 1/4 Cor.
Sec. 12

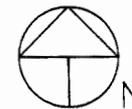


Scale: 1"=400'

Date: January 29, 2013

LEGEND

- Found Survey Monument
- Denotes Structure
- Denotes Driveway
- - - Denotes Mainline Pipe
-  Denotes No Change In Place Of Use, Certificate 79212 Primary, Certificate 83727 Supplemental
-  Denotes No Change In Place Of Use, Certificate 83727
-  Denotes 'To' Tax Lot 101 38 2W 12A From Tax Lot 100 38 1W 24, Certificate 79212 Primary, Certificate 83727 Supplemental

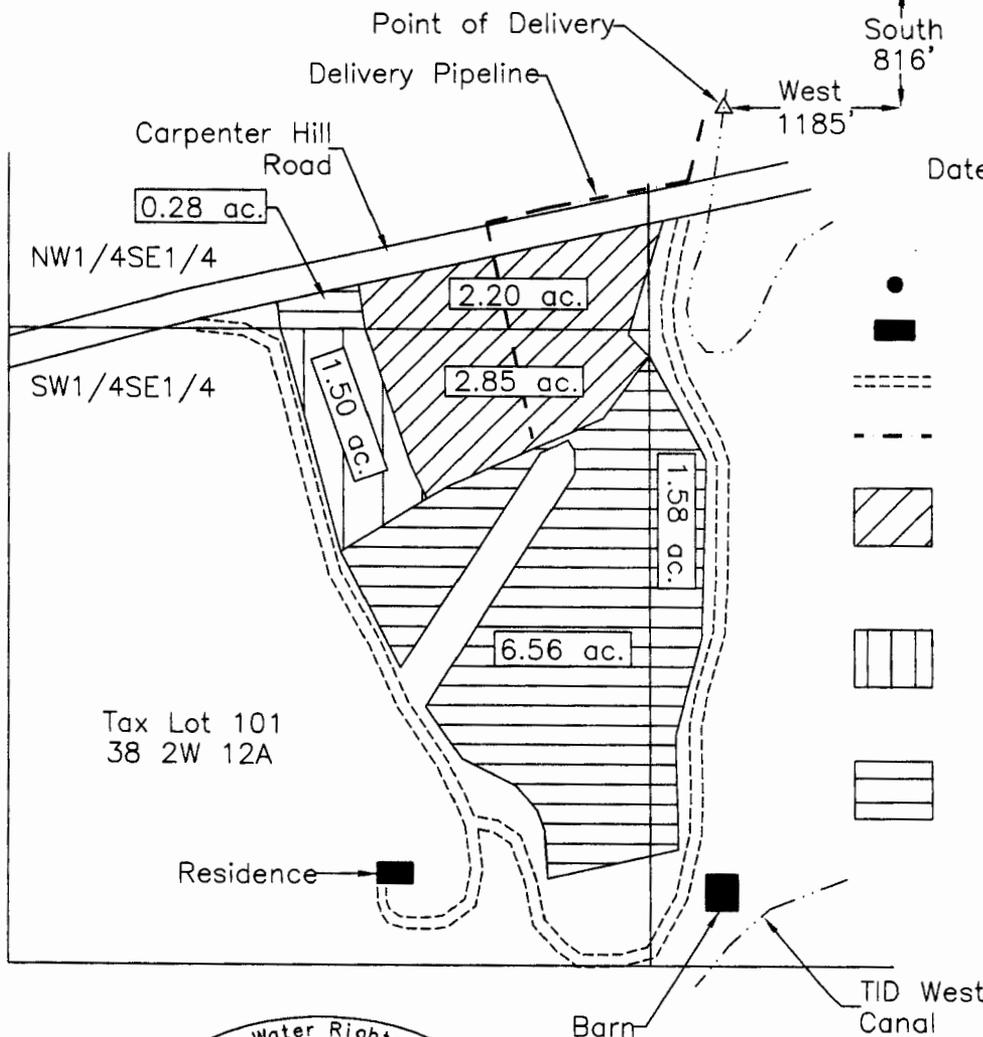

Tax Lot 101
38 2W 12A



Point of Delivery, Talent Irrigation District, Canal situated south 816' and west 1185' from the east 1/4 corner, Section 12, T.38S., R.2W., W.M.

HAROLD L. CENTER
2604 David Lane
Medford, OR. 97504
Phone 541-535-6108
Oregon Certificate No. 152
Certificate Renewal Date: 12/31/2013

This map was prepared for the purpose of identifying the location of a water right only and is not intended to provide legal dimensions or location of property ownership.

RECEIVED

FEB 27 2013

CLAIM OF BENEFICIAL USE Site Report

SEP 17 2014

SALEM, OR

Transfer Number: T - 11705District Internal Notice #: 13-2User Name: Nancy NickellPhone: 541-608-2736837 South Stage Rd Medford, OR 97501**Place of Use:**

USE	POD #	TWP	RNG	SEC	QQ	DLC	GOVT LOT	TAX LOT	ACRES
IR	13-2	38S	2W	01D	SW SE			1500	.90
IR	13-2	38S	2W	01D	NW SE			1500	.90
IR	13-2	38S	2W	01D	SW SE			1500	.90
IR	13-2	38S	2W	01D	SW SE			1500	.20

TOTAL ACRES = 2.90

District Conveyance System:Description of Delivery System: Private Pump Station on the Talent CanalHeadgate: NoneCanal: Talent Main Canal**Beneficial Use:**Description of Beneficial Use: Lawn and GardenMethod Used to Apply Water: Sprinkler irrigated. The water use is metered.Method Used to Calculate Beneficial Use: Did on-site visit of the property comparing transfer map to the actual place of use.User Interviewed: Yes NoBeneficial Use Made as Authorized: Yes No

Description of Beneficial Use if Less than Authorized:

NoneInspected By: Bob WilsonDate: 8-26-14

Bob Wilson, Ditch Rider

Instructions: Attach and label the corresponding final proof map.

RECEIVED BY OWRD

SEP 17 2014

SALEM, OR

MAP OF WATER RIGHT TRANSFER
PLACE OF USE
FOR

NANCY NICKELL
837 SOUTH STAGE ROAD
MEDFORD, OR 97501


LOCATED IN
NW1/4SE1/4, SW1/4SE1/4, SECTION 1
T.38S., R.2W., W.M. - TAX LOT 1500
JACKSON COUNTY, OREGON

13-2

382W-01D 1500

.90 Acre

To Land

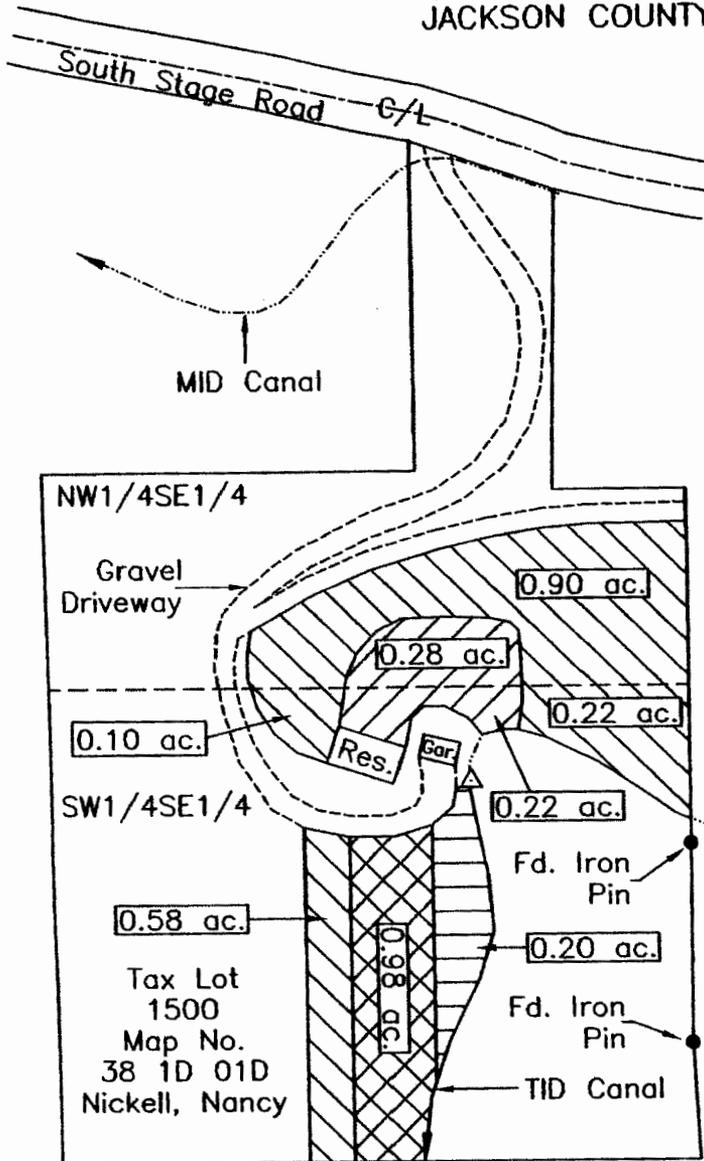

Scale: 1"=200'
Date: April 1, 2013

LEGEND

- Found Survey Monument
- Denotes Structure
- Denotes Gravel Driveway
- ▨ Denotes Existing TID Irrigation Area
- ▧ Denotes Transfer "To" Tax Lot 1500, T38S, R2W, Sec. 1 From Tax Lot 2100, T37S, R1W, Sec. 27
- ▤ Denotes Transfer "To" Tax Lot 1500, T38S, R2W, Sec. 1 From Tax Lot 2200, T38S, R1W, Sec. 35
- ▩ Denotes Transfer "To" Tax Lot 1500, T38S, R2W, Sec. 1 From Tax Lot 1900, T37S, R1W, Sec. 27

Note: Talent Irrigation District Point of Delivery is the Talent Main Canal, South 365' and West 915' from the SE Corner Donation Land Claim No. 38, T.38S., R.2W.

This map was prepared for the purpose of identifying the location of a water right only and is not intended to provide legal dimensions or location of property ownership.

Project: 13-06 Davis/Evans-Nickell



HAROLD L. CENTER
2604 David Lane
Medford, OR. 97504
Phone 541-535-6108
Oregon Certificate No. 152
Cert. Renewal Date: 12/31/2013