



# Revised Coley, Ramey, Osborne 48348 Historic POD Transfer Map

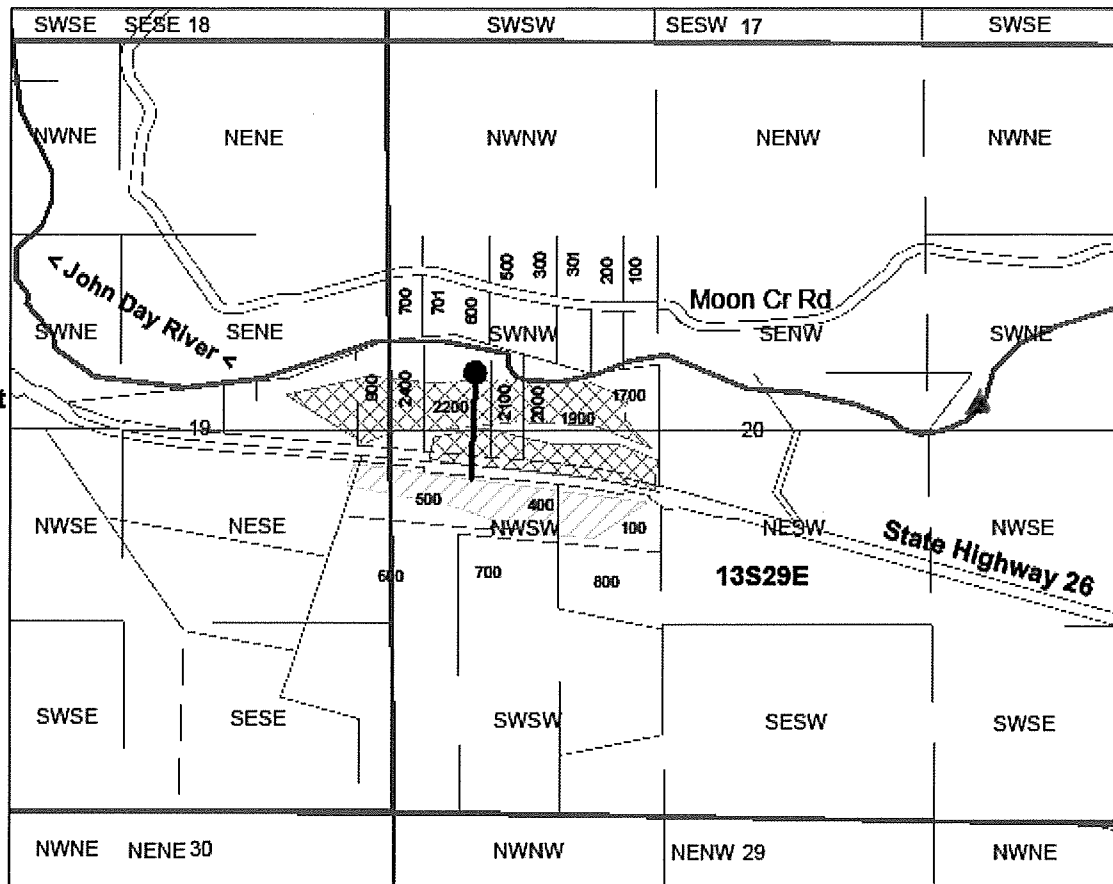

0 660 1,320 Ft  
1" = 1,320'

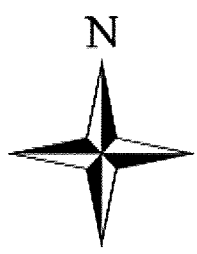

## Legend

- Upper Mainstem John Day River
- Actual POD, 470' East, 3,127' North of SW Corner Section 20
- Existing Underground Pipe Delivery System
- ▨ Remaining POU
- ▨ Remaining POU
- ▲ Historic POD, 2,750' North and 2,480' West from SE Corner, Section 20
- ▨ Transfer POU, 6.95Acres