




39-8-4
47292

T. 39 S., R. 8 W., W. M.

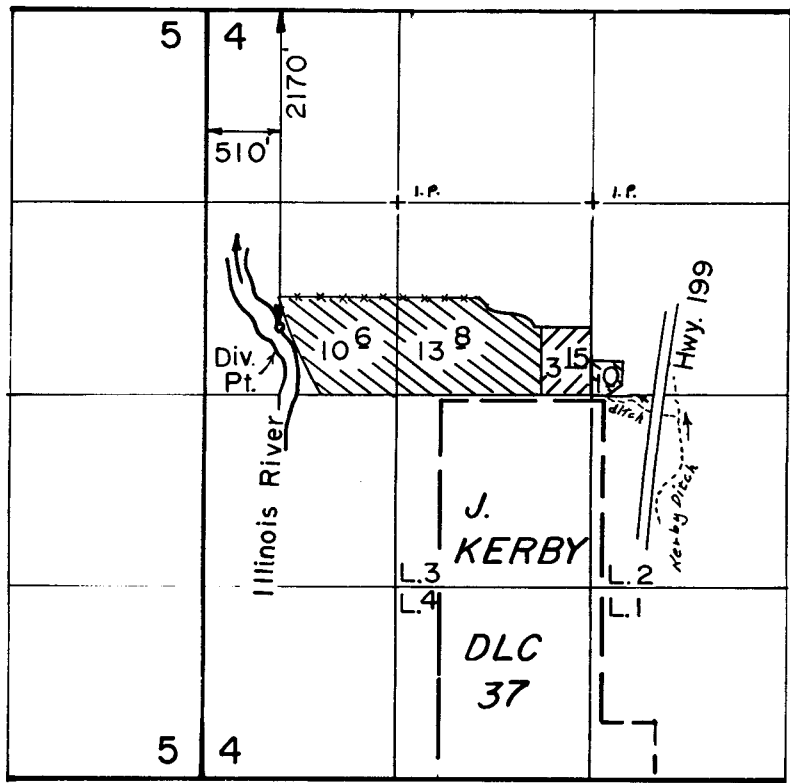

Scale: 1" = 1320'

T. 5168 
P. 47292 

FINAL PROOF SURVEY
UNDER

TRANSFER NO. 5168
Application No. 64562 Permit No. 47292
IN NAME OF

.....WILLIAM A. RORISON.....

Surveyed Sep. 10, 1987, by B. S. JAMES.