


T-5966
V.41 P.GOTW
T-5966 V.43 P284

T.9S.R.27&28E. W.M.

Diversion point #1 is 6120' S. & 2270'E.
from C $\frac{1}{4}$ corner Sec. 1

Diversion point #2 is 2500' N. & 990' W.
from SE corner Sec. 12

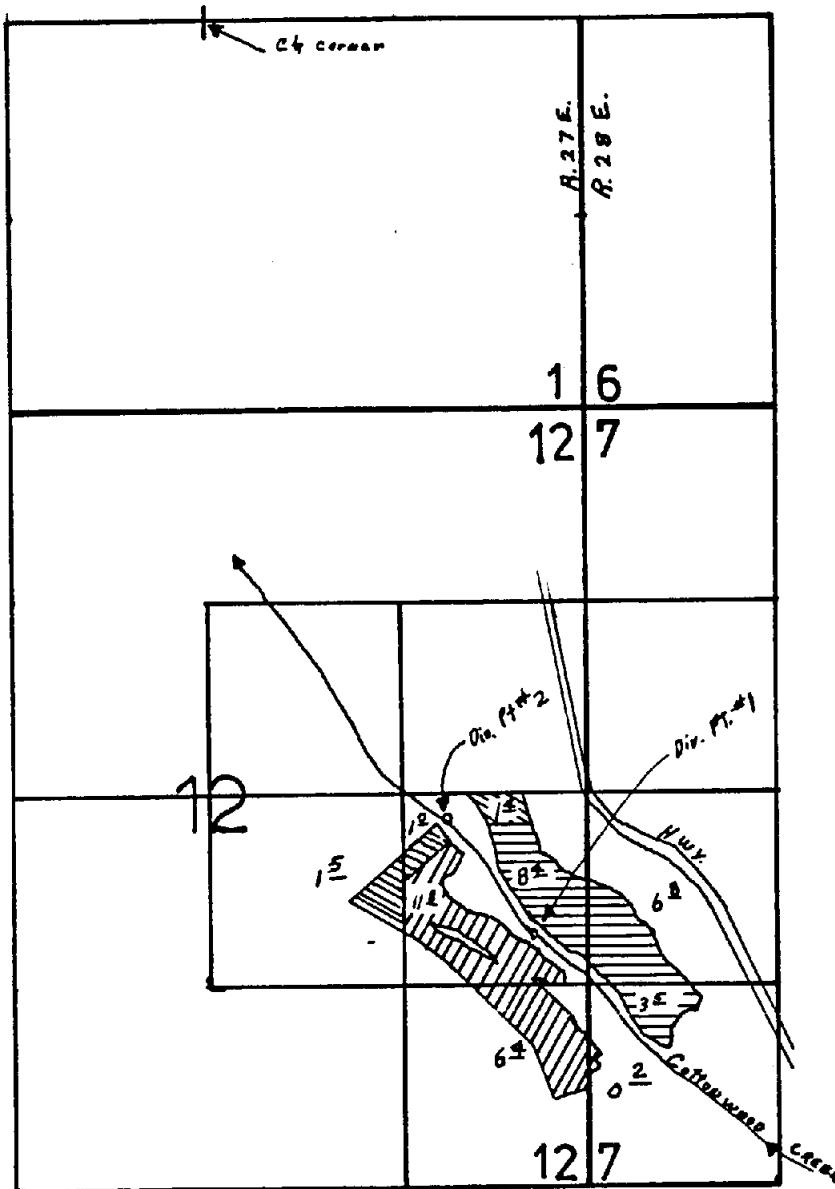

RECEIVED

JUN 29 1987

WATER RESOURCES DEPT.
SALEM, OREGON

C-44181

G-44179

C-44177

suek