



Oregon Water Resources Department  
 725 Summer Street NE, Suite A  
 Salem, Oregon 97301  
 (503) 986-0900  
 www.wrd.state.or.us

RECEIVED BY OWRD

# Request for Assignment

JUN 24 2013

By Proof of Ownership  
 (If Water Right Holder is Not Available)

SALEM, OR

If for multiple rights, a separate form and fee for each right will be required.

I, Marion L. Theurer & Melissa A Theurer  
 (Name of Party Requesting Assignment)

645 Heritage Hills Dr. Philomath OR 97370 541-929-5141  
 (Mailing Address) (City) (State) (Zip) (Phone #)

hereby request assignment of application/permit/transfer/license/GR Certificate of Registration;

hereby request assignment of a portion of application/permit/transfer/license/GR Certificate of Registration; (You must include a map showing the portion of the application/permit/transfer/license/GR Certificate of Registration to be assigned.) designated on map

I have attached proof of ownership that may include but not be limited to: a copy of the deed to the land, a copy of a land sales contract, a court order or decree, documentation of survivorship of property held jointly. The Department cannot accept a copy of a tax statement.

Application # \_\_\_\_\_; Permit # 43042; Transfer# 7864  
 -OR-

License # \_\_\_\_\_ GR Statement # \_\_\_\_\_; GR Certificate of Registration # \_\_\_\_\_

Diane Bell (Larry A Bell, deceased)  
 (Name of Holder of Record)

815 Heritage Hills Dr Philomath OR 97370 541-929-2322  
 (Mailing Address) (City) (State) (Zip) (Phone #)

**Note:** You are required to furnish proof acceptable to the Department that notice of the assignment has been given or attempted for each identified property owner not a party to the assignment. ORS 537.220(2) Failure to submit this proof will result in the return of your request. (Proof may include but not be limited to: a copy of returned certified mailing, copy of a Death Certificate, or a court order.)

- 1) I certify that I am the current owner of the property described in this application, Permit, transfer, license or GR Certificate of Registration.
- 2) I have the legal right to request assignment under OAR 690-310-0280 and 690-320-0060.
- 3) I have not been able to contact the owner(s) of record for the above referenced application or water right.
- 4) I further certify that the information provided herein is true and correct to the best of my knowledge.

Witness my hand this 19 day of June, 2013.

Party Requesting Assignment Marion L Theurer

Party Requesting Assignment Melissa A Theurer

ASSIGNMENT COMPLETE BY RECORDS SECTION 6/24/2013


**DO NOT WRITE IN THIS BOX**  
 This certifies assignment and record change at Oregon Water Resources Department effective 8:00 a.m. on date of receipt at Salem, Oregon.  
 Fee receipt # 109149  
 For Director by Jerry Sauter, Program Analyst in Water Rights Division.

The completed "Request for Assignment" form *must* be submitted to the Department along with the recording fee of \$75.

T11S, R6W, W.M.  
T12S, R6W, W.M.

RECEIVED BY OWRD

JUN 24 2013

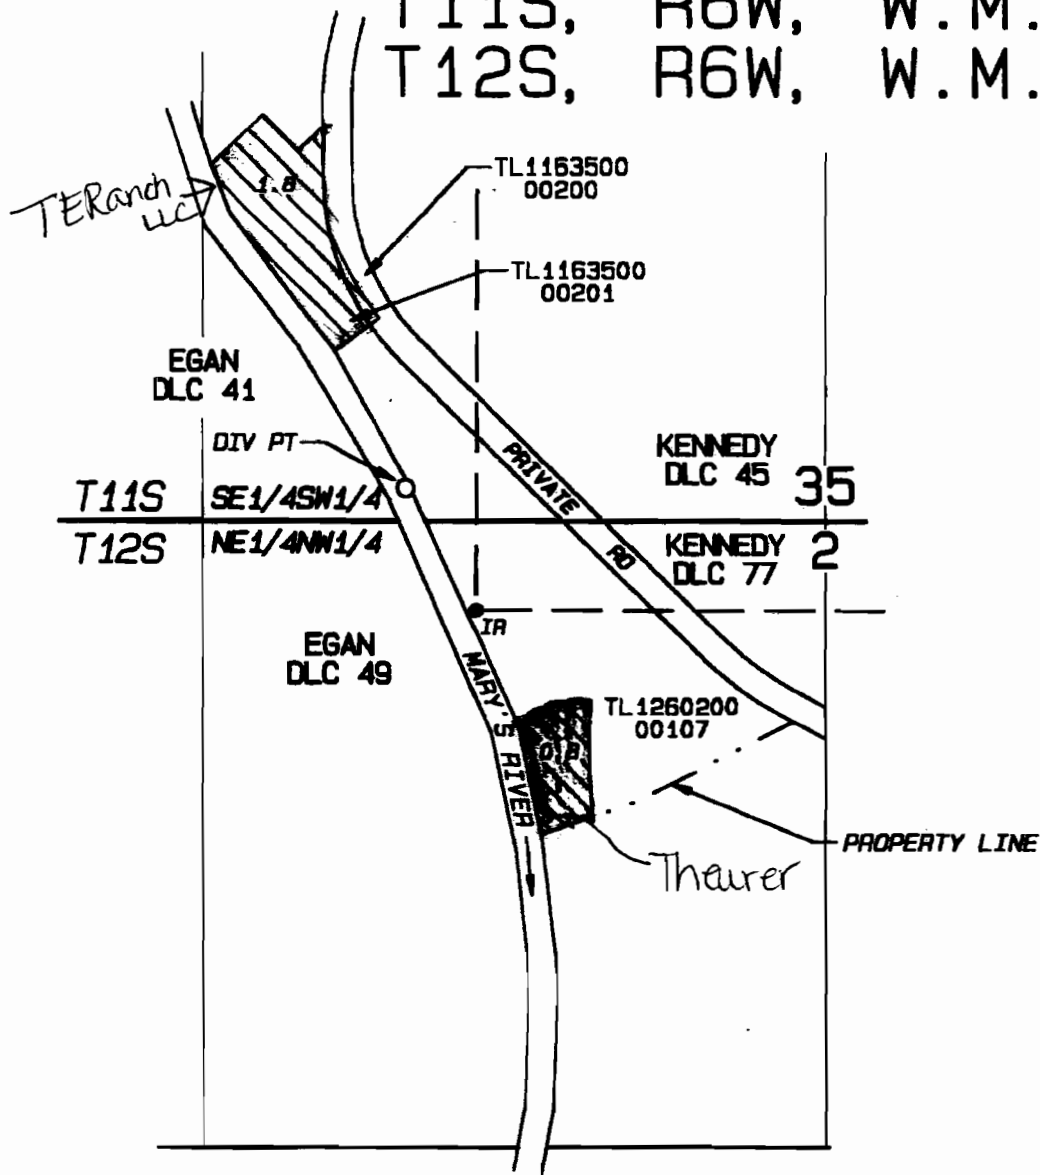

SALEM, OR

1" = 400'

DIV PT: N 250' & W 150' FROM SW COR DLC 77

**FINAL PROOF SURVEY MAP  
UNDER  
TRANSFER T-7884  
IN THE NAME OF  
LARRY A. BELL & S. DIANE BELL**


PARSONS SURVEYING  
1915 SE Stone St  
Corvallis, OR 97333  
(541) 752-7515  
Project 0102  
Surveyed: 6/7/2001  
8/3/2001

NOTE: This map is for the purpose of identifying the location of a water right and does not dimension or locate property ownership lines

RECEIVED

SEP 07 2001

WATER RESOURCES DEPT.  
SALEM, OREGON

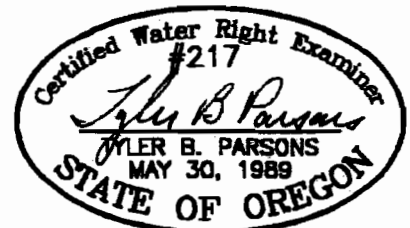

EXP: 12/31/2002