


T. 1 N. R. 13 E. W.M.

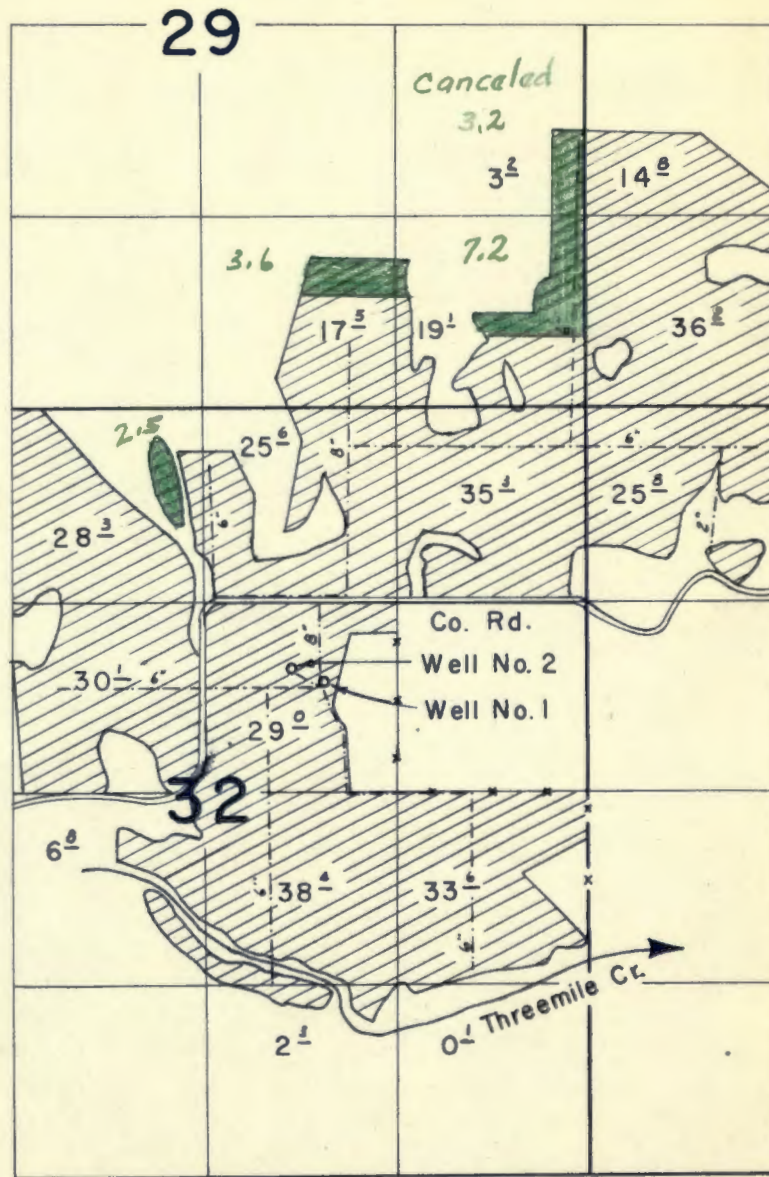

FINAL PROOF SURVEY
UNDER

Application No. G-8 G-66 Permit No. G-482 G-485
IN NAME OF

MILTON F. MARTIN

Surveyed June 6 1962, by *L. W. Jelousek*