


Present Well Location
1060'N & 1040'W of
S1/4 Cor. Sec.29
per GR-1401

Proposed Well Location
1210'N & 220'W of
S1/4 Cor. Sec.29


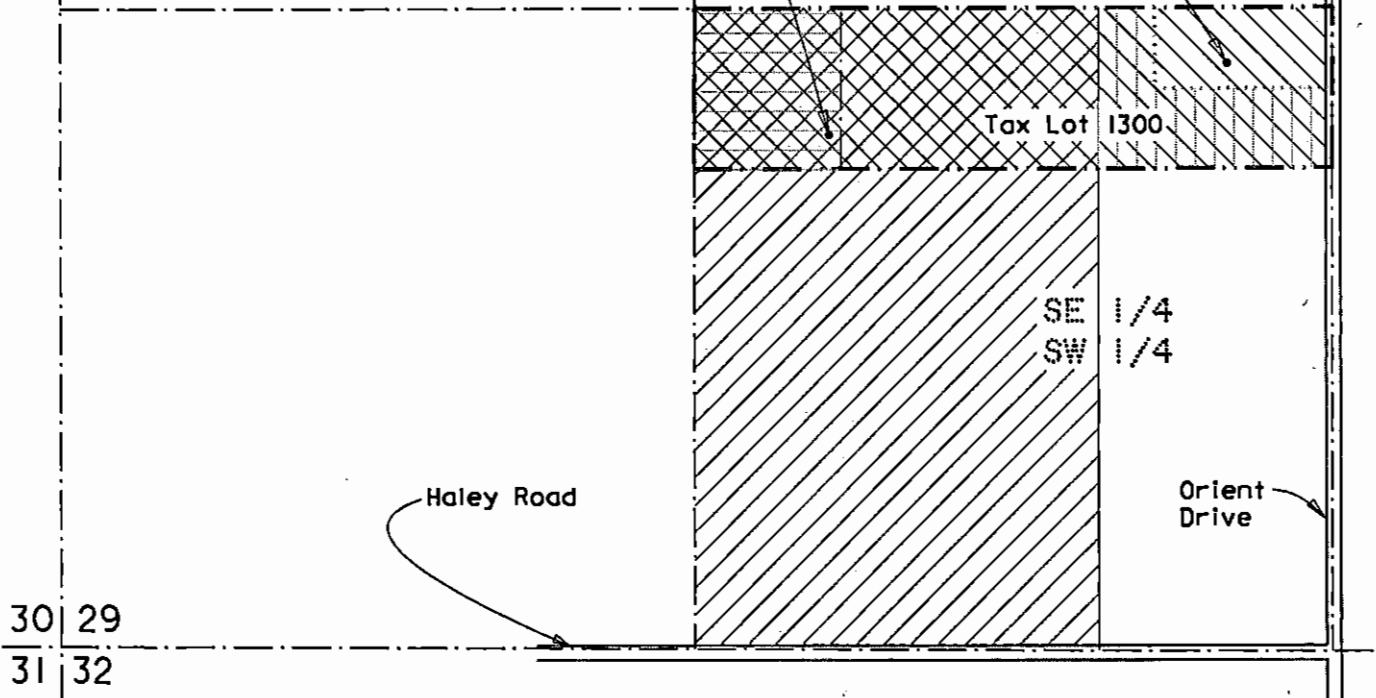


SCALE: 1" = 400'


LEGEND:

-  25 Acres of Certificate GR-1439
-  10.00 Acres of Tax Lot 1300
(Deed Record 2015-030203)
-  6.35 Acres of Tax Lot 1300
within Certificate GR-1439
-  2.12 Acres of Certificate GR-1439
transferred from Tax Lot 1300
-  2.12 Acres of Certificate GR-1439
transferred to Tax Lot 1300

This drawing is an exhibit for a Request for Modification of a Ground Water Registration. It is not a Land Survey. Property lines and/or other lines of occupation shown hereon are not represented by the undersigned to meet accuracy standards of Land Surveys.

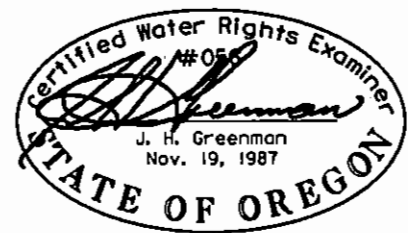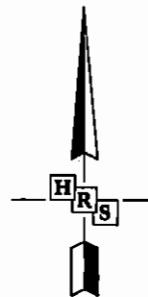

TAX LOT 1300, SECT. 29C,
T.1S., R.4E., W.M.
CLACKAMAS COUNTY, OR
CLAIM No. GR-1401
CERTIFICATE No. GR-1439

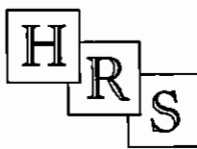

**HANER, ROSS &
SPORSEEN, INC.**
2895 BEAVERCREEK ROAD
OREGON CITY, OREGON 97045

WENDY YU ZHEN
REQUEST FOR MODIFICATION
GROUND WATER REGISTRATION MAP

REV. 6: 2017/04/14

1634