

State of Oregon Water Resources Department 725 Summer Street NE, Suite A Salem, Oregon 97301-1266 (503) 986-0900

Allocation of Conserved Water

60-Day Notice of Use or Disposition for Applicant's Portion of Conserved Water For CW ____

Applicant Information										
APPLICANT/BUSINESS NAME* TOFT-KASER FARM, LLC		503-873-8	106	ADDITIONAL CONTACT NO.						
ADDRESS 828 Sun Valley Ave.						FAX NO.				
CITY SILVERTON	97381		E-MAIL							
* Applicant must be the same per	son(s)/enti	ty as list	ed in the Find	alization Ord	der.					
The Applicant provides this Portion of Conserved Water		days (prior to cha	nges bein	g made to	the utilizat	ion of the A	pplicant's		
List the portion of the conse				Applicant	as listed i	n the Final	ization Ord	er recorded		
at Special Order Volume		#1.00	_ .			R	FCFI	VED		
	ed Water			RECEIVED						
Maximum Rate (CFS)	Maximu (Volum	TO SHARE WITH THE PARTY OF THE				FEB 26 2018				
0.165	25.	99					OWF	PD P		
N/A All or part of the <u>Applicant's</u> portion of the conserved water is to be:										
Leased (If w			rarily leased ; submitted);	instream, a	separate Ins	tream Lease	Application a	1d		
Reserved in	_			eam use (temporary);				
Dedicated in	nstream (perma	nent);							
☐ Used out-of	-stream.			S.						
						Applicant's Conserved Water Remaining				
	Appl	icant's	Conserved W	ater						
Certificate	Prio	rity	Type of Use	Rate (CFS)	Volume (AF)	CFS	Volume	## ***********************************		
26123	7/25/		IR	0.17	25.99	0	-O			
	(0)		Totals	0.17	25.49					
Pursuant to ORS 537.490 and OAR 690-019-0090, the applicant is providing this notice 60 days prior to the following changes being made:										
\square Place of use (must be within the area identified in the Finalization Order (OAR 690-018-0050(4)(h)).										
Point of diversion;										
Type of use	from	to	Th	ne season	of use is to	be:	to;			
Revert from use at place of use previously identified to being managed instream within the reach identified in the Finalization Order.										

Describe the point of diversion that will be used to deliver water to the new place of use:

Twp	Rng	Mer	Sec	Q-Q	Measured Distances
6 S	1 E	WM	15	SWNW	40 FEET NORTH AND 206 FEET FROM THE THE WEST 1/4 CORNER OF SECTION 15, WITHIN WHITLOCK DLC #39

Name and address of the person using the water: TOFT-KASER FARM, LLC

Description of the type of beneficial use of the water: <u>Irrigation</u>

Description of the place of use:

Applicant's Conserved Water Out-of-Stream Use Location											
Priority Date	Т	`wp	R	ng	Sec	1/4	1/4	Tax Lot	Gvt Lot or DLC	Acres	Type of Use
1/1/1865	2	S	9	Е	15	NE .	NW	100	Example	153.0	Irrigation
7/25/52	6	5	1	E	15	NW	NW	500		25,6	Irrigation
7/25/52	6	5)	E	15	SW	NW	500		7,0	Irrigation
7/25/52	6	S	1	E	15	NW	SW	500		7,5	Irrigation
1											Irrigation
											Irrigation
											Irrigation
											Irrigation
											Irrigation
											Irrigation
A= plu	SAMP	min	11+0						Total	40.1	


	N/A		Applicant and the person using the conserved explain the terms of the agreement:
\boxtimes	□ N/A	A map depicting the lands identified abov (required if out-of-stream use table completed).	e that meets the standards in OAR 690-310-0050
	⊠ N/A	Land Use Information Form with approva of the following apply:	l and signature. Land use form not required if any
		☐ Water is to be diverted, conveyed, and	or used only on federal lands.
		All of the following apply: a) a change c) the use of water is for irrigation only an irrigation district or an exclusive fa	
	□ N/A	The water right has been sold. The contact	et information for the new owner is: :
	Dated: _	2/26/18	
		ASER FARM, LLC pplicant Name)	(Applicant's signature)
154	Printed A	pplicant Name)	(Applicant's signature)



Water Rights Mapping Tool **Oregon Water Resources Department**

725 Summer St NE, Sale



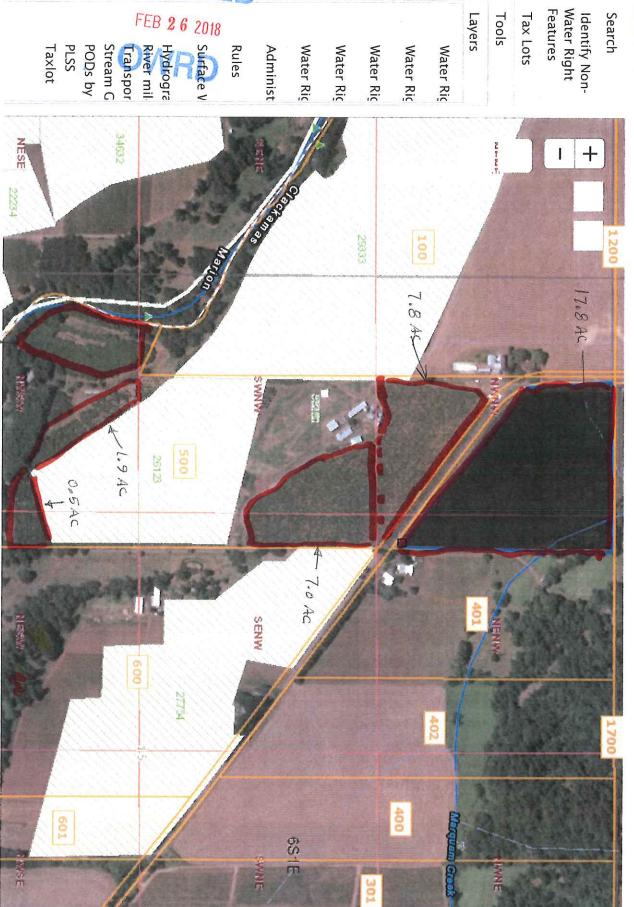

5,1 AC

RECEIVED

FEB 26 2018