T23S, R32.5 E, WM, SECTION 17

HARNEY COUNTY, OREGON

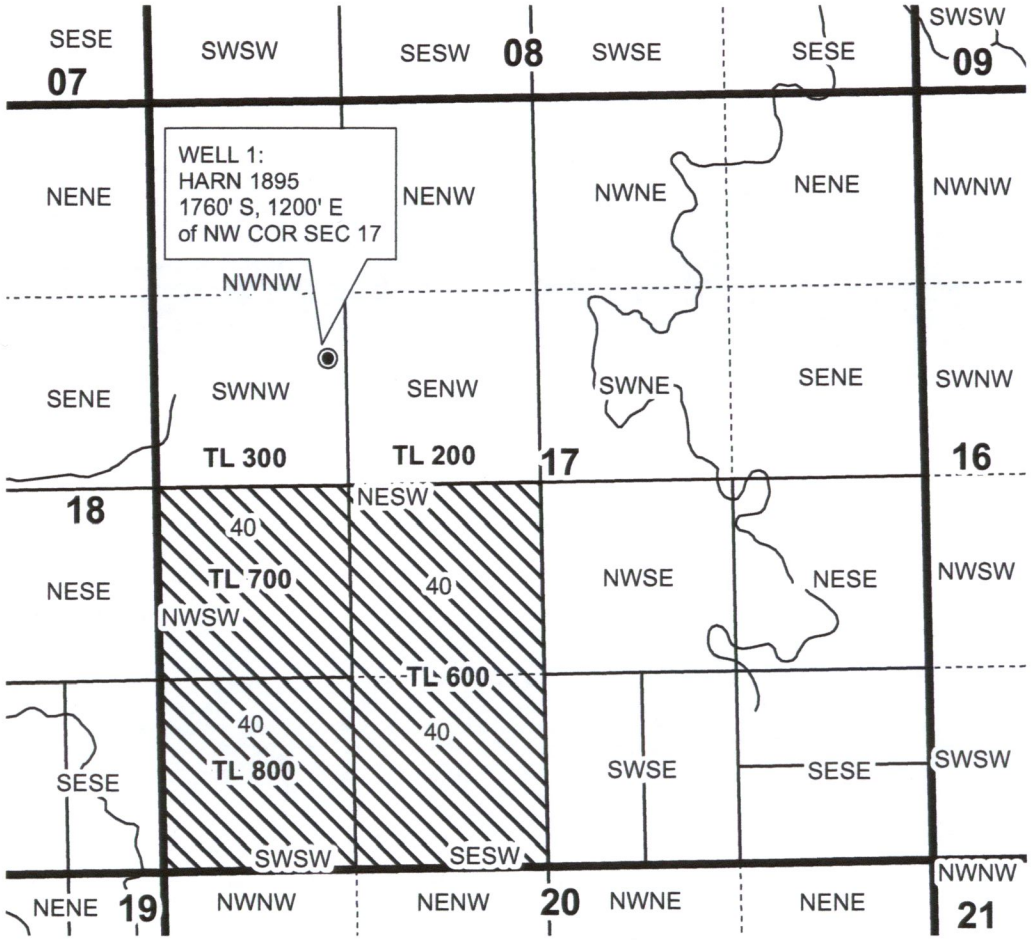

1 inch = 1,320 feet

0 660 1,320 Feet

POU,Transfer Off
Section
Quarter Quarter
Tax Lot
Well

RECEIVED
MAR 09 2018
OWRD

RENEWAL DATE 12/31/2019

Ap G-17704 Permit G-17359
Permit Amendment
OFF Map
Schott

Date: 2/8/18

NOTE: THIS MAP IS NOT INTENDED TO PROVIDE LEGAL DIMENSIONS OR LOCATIONS OF PROPERTY OWNERSHIP LINES.

WATER RIGHT SERVICES, LLC
PO BOX 1830, BEND, OR 97709
CCB# 197121 **www.oregonwater.us**
541-389-2837 JOHNSHORT@USA.COM

T23S, R33 1/2E, WM, SECTION 17

HARNEY COUNTY, OREGON

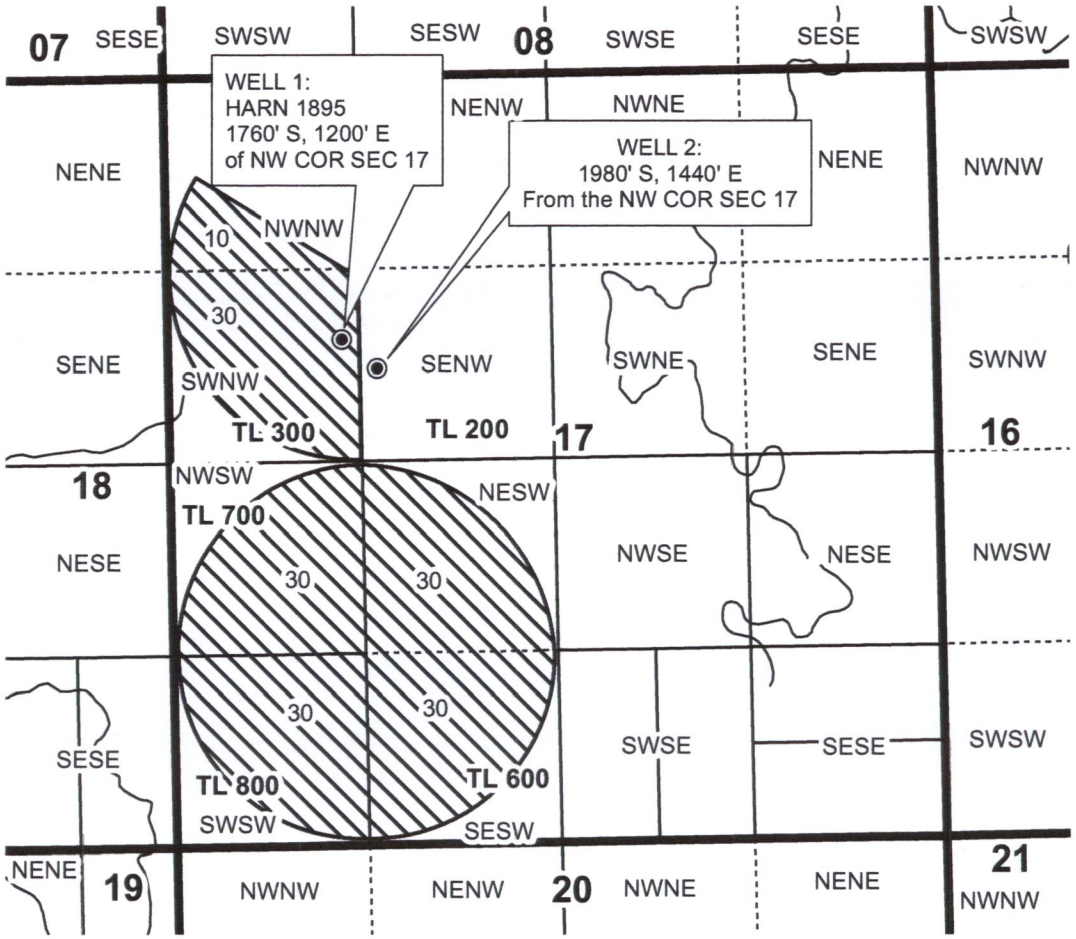

1 inch = 1,320 feet

0 660 1,320 Feet

- POU, Transfer On
- Section
- Quarter Quarter
- Tax Lot
- Well

RECEIVED
MAR 09 2018
OWRD

RENEWAL DATE 12/31/2018

Ap G-17704 Permit G-17359
Permit Amendment
ON Map
Schott

Date: 2/20/18

NOTE: THIS MAP IS NOT INTENDED TO PROVIDE LEGAL DIMENSIONS OR LOCATIONS OF PROPERTY OWNERSHIP LINES.

WATER RIGHT SERVICES, LLC
PO BOX 1830, BEND, OR 97709
CCB# 197121 **www.oregonwater.us**
541-389-2837 JOHNSHORT@USA.COM