



TO POND
SEC. 25

FROM LAND

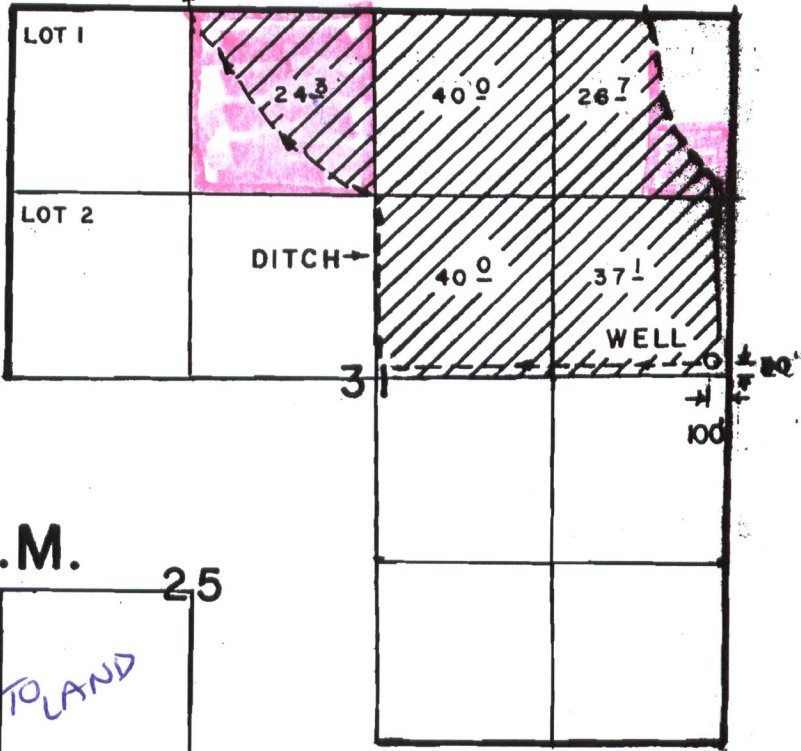

T. 39 S., R. 11 E., W.M.

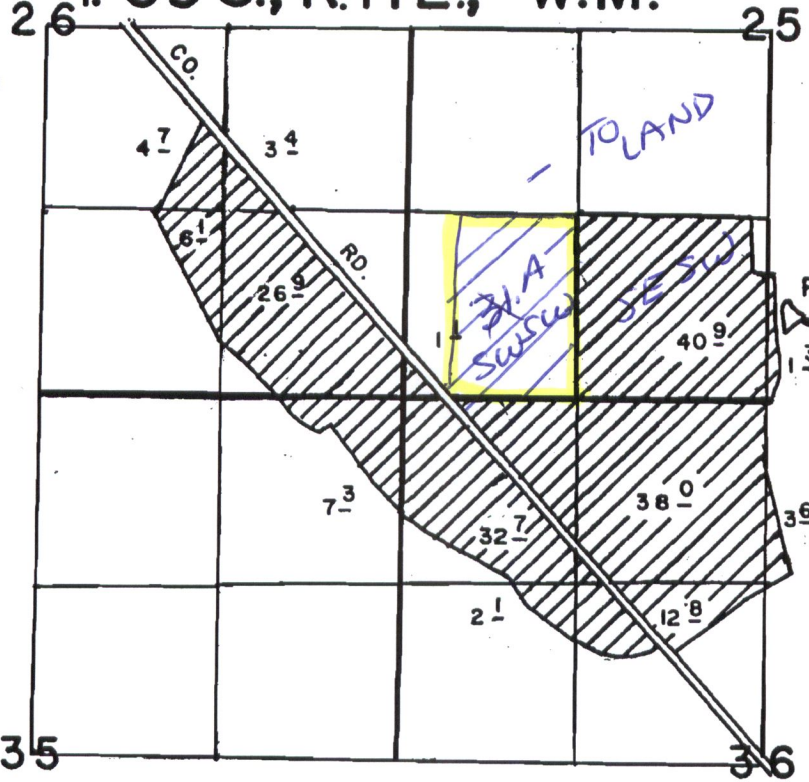

T. 39 S., R. 12 E., W.M.

POND FROM WELL
SEC. 31

RECEIVED
MAR 26 2013
OWRD



FINAL PROOF SURVEY
UNDER

1" = 1320'

Application No. G8200. Permit No. G7654.....
IN NAME OF

INDIAN HILLS RANCH

Surveyed SEPT. 13 1989., by B.W. BISHOP.....

3-16-90 DSM


REVISED 06-22-2017

THIS MAP WAS PREPARED FOR ASSESSMENT PURPOSE ONLY.

T.39S. R.12E. W.M. KLAMATH COUNTY

1"=2000'

39 12 & INDEX

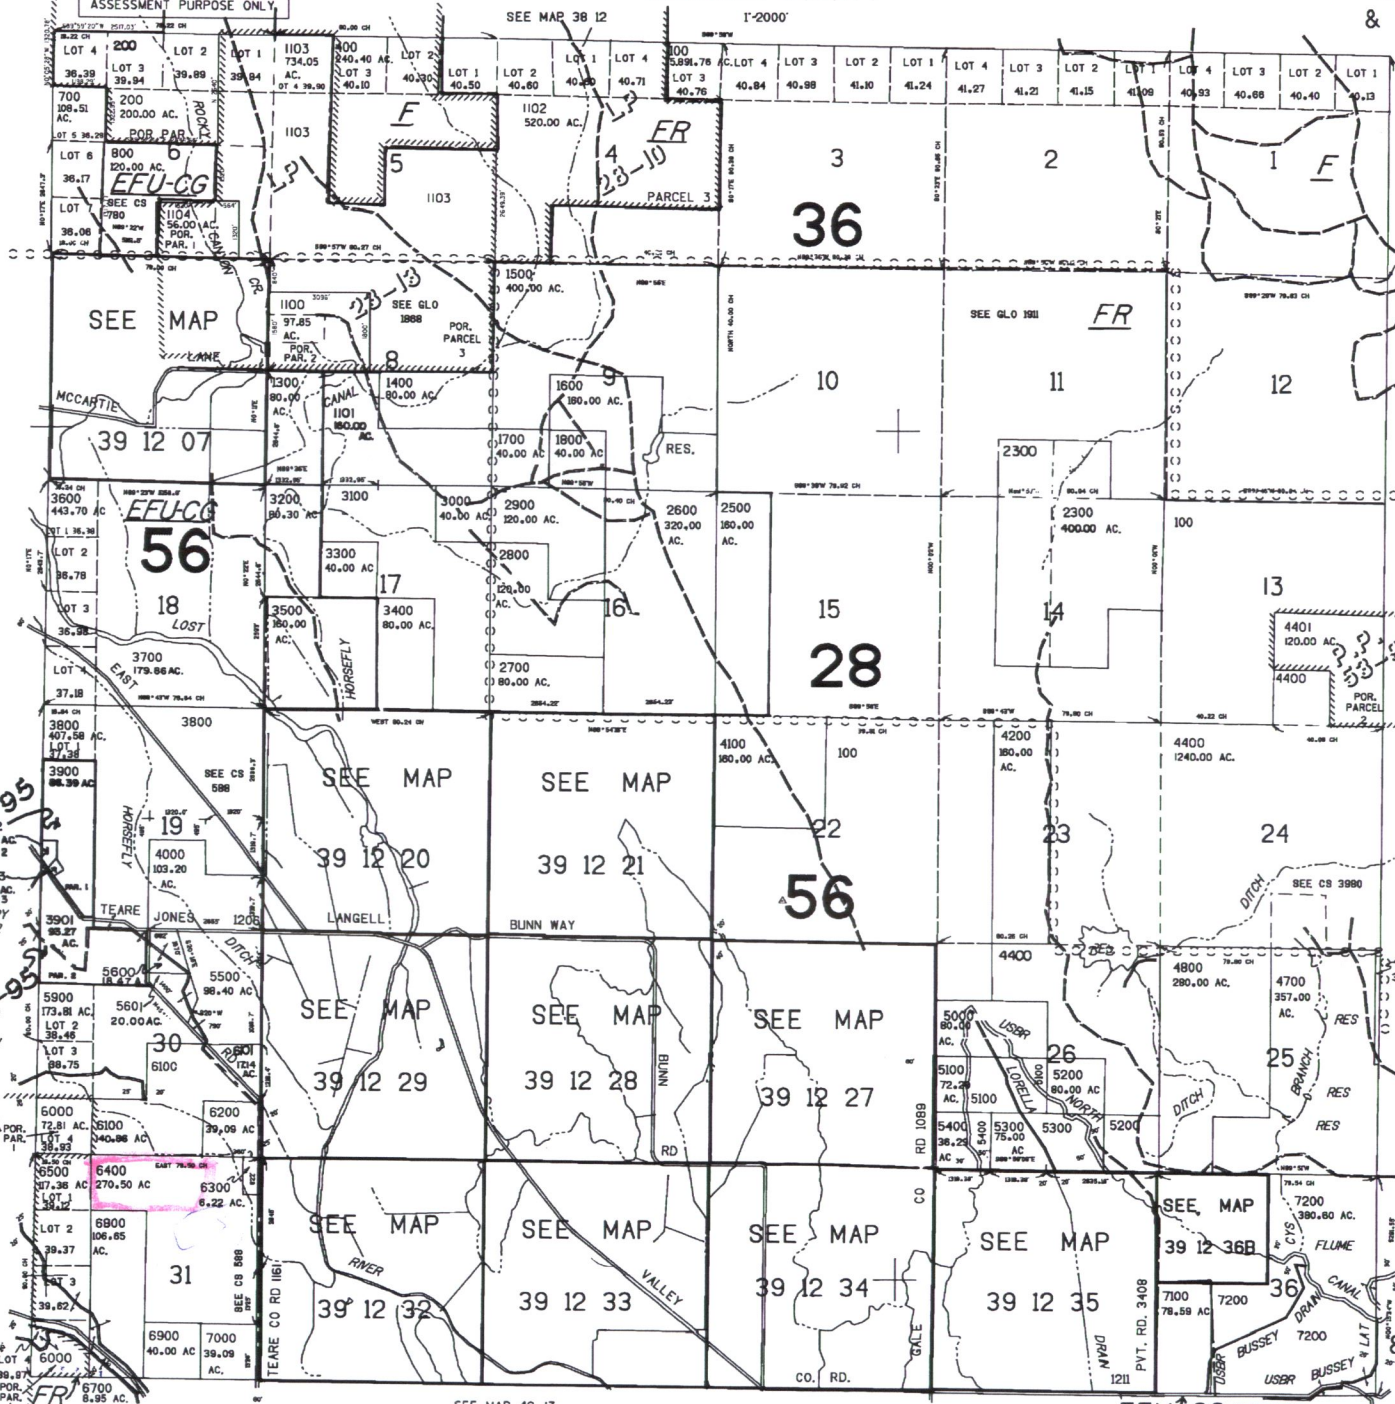

RECEIVED

MAR 26 2018

OWRD

CANCELLED NO.
 5700
 5800
 5900
 6000
 6100
 1000
 1200
 2800MI
 3100MI
 1102
 6600

LP 54-95
 LP 31-95
 LP 3-11
 LP 3-11
 LP 3-11

FROM LAND

SEE MAP 40 13


EFU-CG

175.000
39 12 INDEX

Map 3 of 3

T.39S. R.11E. W.M.
KLAMATH COUNTY
1" = 2000'

REVISED 06-22-2017
THIS MAP WAS PREPARED FOR
ASSESSMENT PURPOSE ONLY

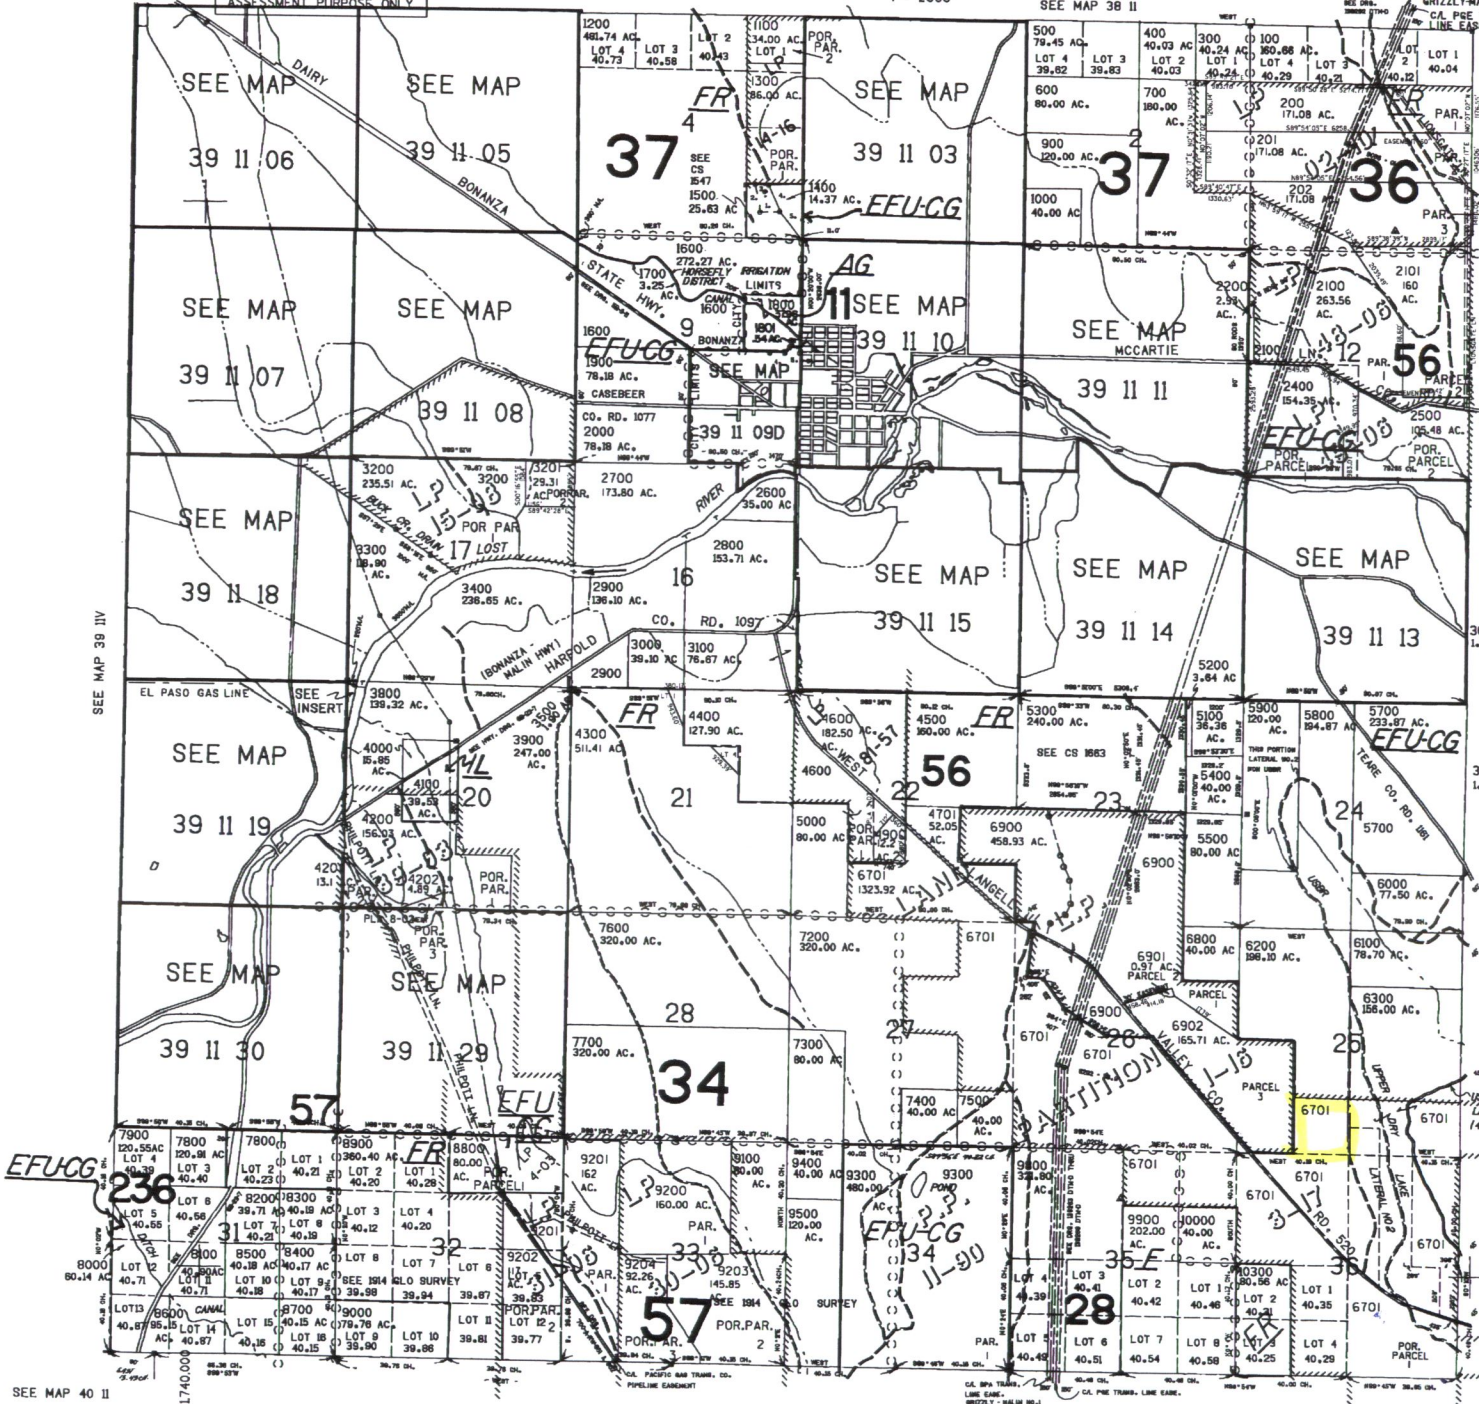

39 II
& INDEX
BONANZA

RECEIVED

MAR 26 2018

OWRD


- CANCELLED NO.
- 4700
 - 4801
 - 5600
 - 5600
 - 6400
 - 800
 - 2300
 - 4800
 - 6500
 - 6700
 - 7000
 - 7100
 - 9600
 - 9700
 - 10100
 - 10200
 - 10201



TO
LAND

39 II
& INDEX
BONANZA

SEE MAP 39 IIV

SEE MAP 40 12

175.000