


T.35 S.R.2W.W.M.

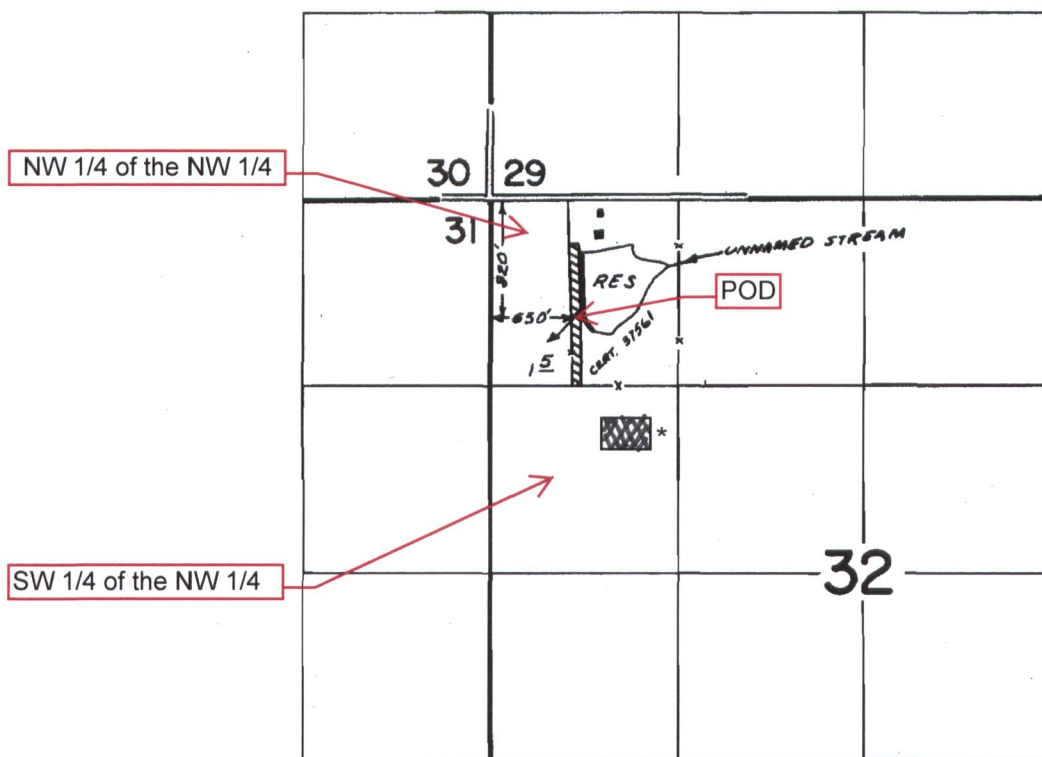

 From

 To

IN NAME OF

MRS. JUANITA F. BUSH

Surveyed OCT 16 1973, by R.G. MUCKEN

RECEIVED

MAR 23 2018


OWRD

**Temp POU Transfer
for 1.5 AC**
Alex Granik
35-2W-32 TL1200




Legend

- Point Of Diversion
- ▨ Current Irrigation Right
- ▤ Proposed Irrigation Right
- ▭ Section Lines
- ▭ Rivers, Lakes & Ponds

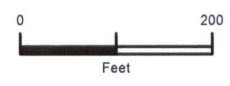

1 inch equals 200 feet

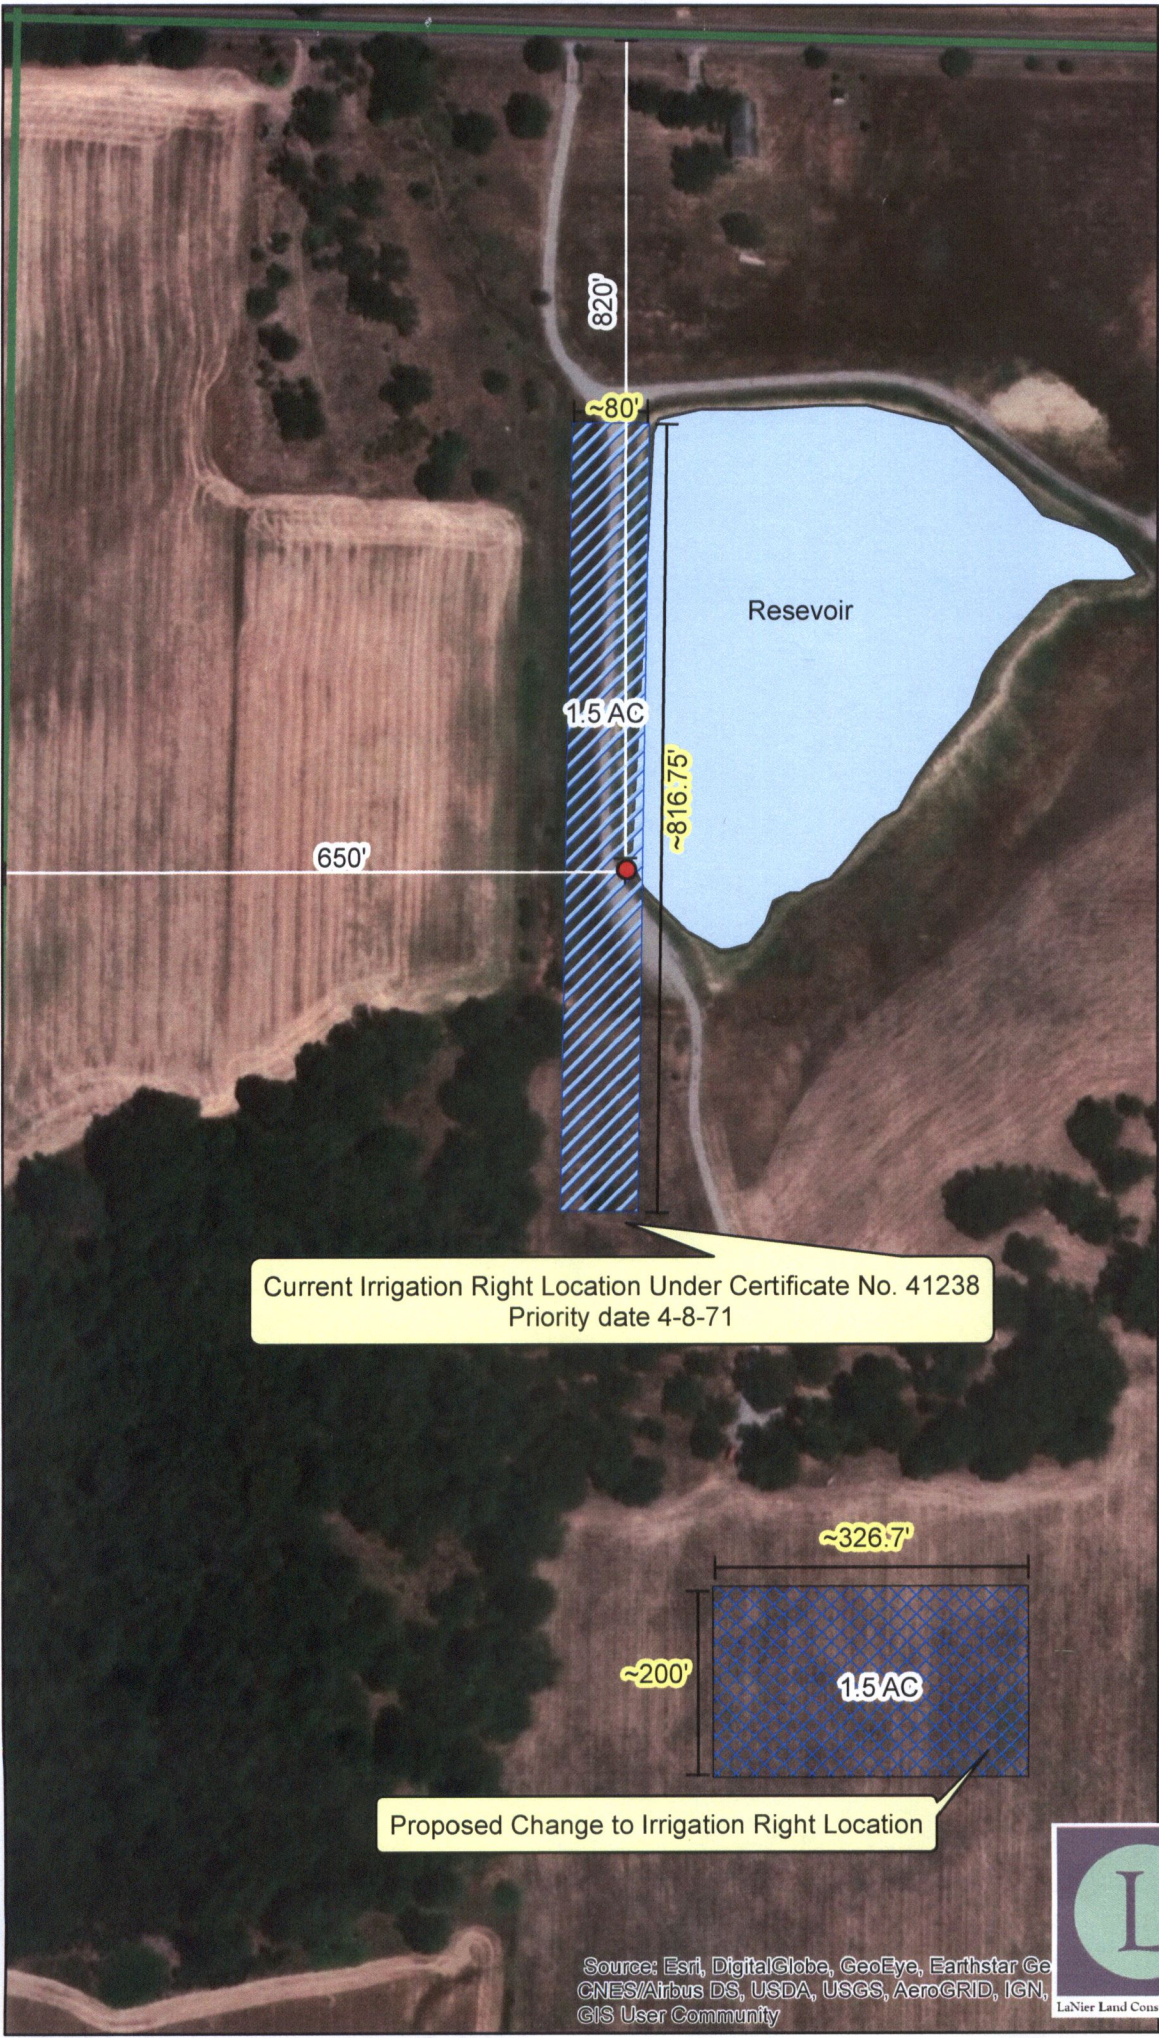

Current Irrigation Right Location Under Certificate No. 41238
Priority date 4-8-71

Proposed Change to Irrigation Right Location

RECEIVED
MAR 23 2018
OWRD



Source: Esri, DigitalGlobe, GeoEye, Earthstar Geographics, CNES/Airbus DS, USDA, USGS, AeroGRID, IGN, and the GIS User Community

This map is based on a digital database compiled by Jackson County GIS from a variety of sources, and may include LaNier Land Consulting, LLC, field data collected using GPS. We cannot accept responsibility for errors, omissions, or positional accuracy. There are no warranties, expressed or implied.