




T. 9 S., R. 4 W., WM

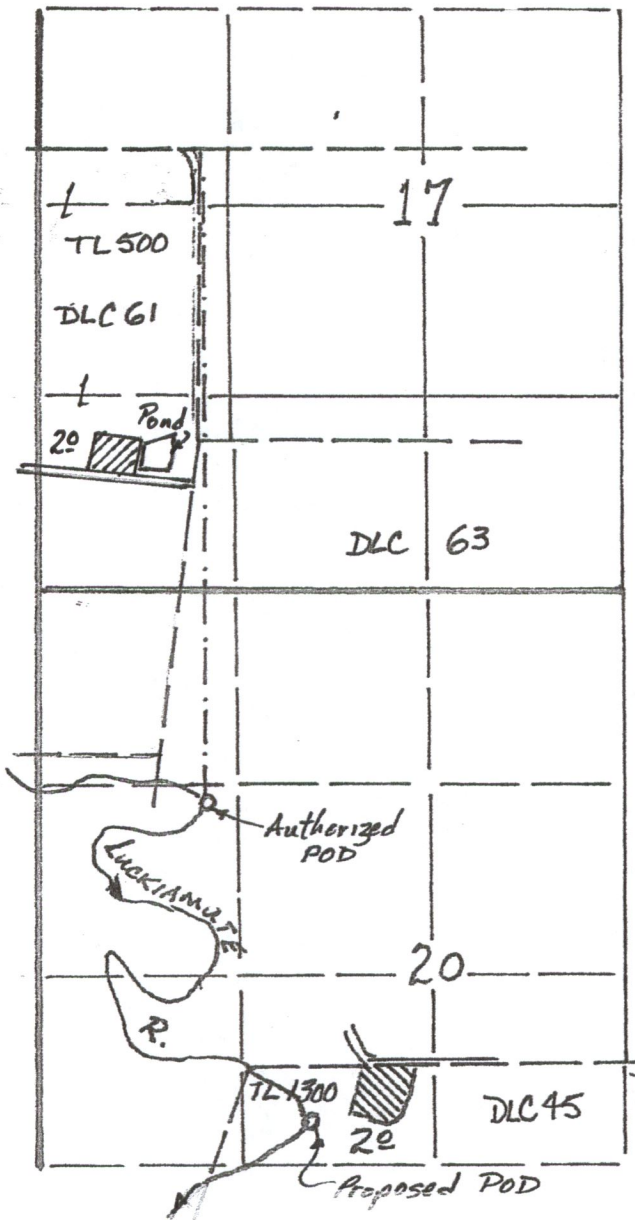

Scale ; 1" = 1320'

Map to Accompany Application for
Temporary Transfer
In the Name of Synergy AG

POD's Located: Authorized- 270' S. & 310' E. from the SE Corner DLC 61;
Proposed - 400' S. & 390' E. from the NW Corner DLC 45.

-  - Temporary Transfer "From"
-  - Temporary Transfer "To"

RECEIVED

MAR 30 2018

OWRD

This map is for the purpose of identifying the location of water rights only, and is not
Intended to provide legal dimensions or locations of property lines.