

Part 4 of 5 – Applicant Information and Signature

Applicant Information

APPLICANT/BUSINESS NAME Roderick J. Sonnen		PHONE NO. (503) 710-7372	ADDITIONAL CONTACT NO. (503) 793-6989
ADDRESS 8644 Broadacres Rd. SE			FAX NO.
CITY Aurora	STATE OR	ZIP 97002	E-MAIL sonnenfarm@yahoo.com
BY PROVIDING AN E-MAIL ADDRESS, CONSENT IS GIVEN TO RECEIVE ALL CORRESPONDENCE FROM THE DEPARTMENT ELECTRONICALLY. COPIES OF THE FINAL ORDER DOCUMENTS WILL ALSO BE MAILED.			

Agent Information – The agent is authorized to represent the applicant in all matters relating to this application.

AGENT/BUSINESS NAME William E. McGill, CWRE		PHONE NO. (503) 510-3026	ADDITIONAL CONTACT NO. (541) 327-2798
ADDRESS 15333 Pletzer Rd. SE			FAX NO. (541) 327-2798
CITY Turner	STATE OR	ZIP 97392	E-MAIL willmcgill.surveying@gmail.com
BY PROVIDING AN E-MAIL ADDRESS, CONSENT IS GIVEN TO RECEIVE ALL CORRESPONDENCE FROM THE DEPARTMENT ELECTRONICALLY. COPIES OF THE FINAL ORDER DOCUMENTS WILL ALSO BE MAILED.			

Explain in your own words what you propose to accomplish with this transfer application, and why:
 The authorized well, POA 1, for Cert. 67645 is on property that was sold, so it is proposed to drill a new well, APOA 2, on Sonnen taxlot 3100 and add that portion of Cert. 67645 on Sonnen taxlot 3100, Miller taxlot 3000, and Baker tax lot 2900 to the new well APOA 2_x in addition to the authorized well POA 1.
 If you need additional space, continue on a separate piece of paper and attach to the application as "Attachment 1".

Check this box if this project is fully or partially funded by the American Recovery and Reinvestment Act. (Federal stimulus dollars)


Check One Box

- By signing this application, I understand that, upon receipt of the draft preliminary determination and prior to Department approval of the transfer, I will be required to provide landownership information and evidence that I am authorized to pursue the transfer as identified in OAR 690-380-4010(5); OR
- I affirm the applicant is a municipality as defined in ORS 540.510(3)(b) and that the right is in the name of the municipality or a predecessor; OR
- I affirm the applicant is an entity with the authority to condemn property and is acquiring by condemnation the property to which the water right proposed for transfer is appurtenant and have supporting documentation.

RECEIVED
 APR 04 2018
 OWRD

I understand that prior to Department approval of the transfer application, I may be required to submit payment to the Department for publication of a notice in a newspaper with general circulation in the area where the water right is located, once per week for two consecutive weeks. If more than one qualifying newspaper is available, I suggest publishing the notice in the following newspaper: Woodburn Independent.

I (we) affirm that the information contained in this application is true and accurate.

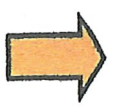

Roderick J. Sonnen
 Applicant signature

Roderick J. Sonnen
 Print Name (and Title if applicable)

2-15-18
 Date

 Applicant signature

 Print Name (and Title if applicable)

 Date

Is the applicant the sole owner of the land on which the water right, or portion thereof, proposed for transfer is located? Yes No *If NO, include signatures of all deeded landowners (and mailing and/or e-mail addresses if different than the applicant's) or attach affidavits of consent (and mailing and/or e-mail addresses) from all landowners or individuals/entities to which the water right(s) were conveyed.*

Please use and attach additional pages of Table 2 as needed.
See page 6 for instructions.

Do you have questions about how to fill-out the tables?
Contact the Department at 503-986-0900 and ask for Transfer Staff.

Table 2. Description of Changes to Water Right Certificate # 67645

Amended 4-4-18 WEN


List the change proposed for the acreage in each 1/4 1/4. If more than one change is proposed, specify the acreage associated with each change.
If there is more than one POD/POA involved in the proposed changes, specify the acreage associated with each POD/POA.

AUTHORIZED (the "from" or "off" lands)										PROPOSED (the "to" or "on" lands)										
The listing that appears on the certificate BEFORE PROPOSED CHANGES										The listing as it would appear AFTER PROPOSED CHANGES										
List only that part or portion of the water right that will be changed.										are made.										
Twp	Rng	Sec	1/4 1/4	Tax Lot	Gvt Lot or DLC	Acreage	Type of USE listed on Certificate	POD(s) or POA(s) (name or number from Table 1)	Priority Date	Twp	Rng	Sec	1/4 1/4	Tax Lot	Gvt Lot or DLC	Acreage	New Type of USE	POD(s)/ POA(s) to be used (from Table 1)	Priority Date	
EXAMPLE																				
2	S	9	E	15	NE	NW	100		1901	POD #1	POD #2	Irrigation	15.0							
4	S	2	W	25	SW	SW	3000 3100	51	13.7	1971	POA 1	Irrigation	13.7	3000 3100	51	13.7	Irrigation	POA 1 APOA 2	1971	
4	S	2	W	25	SE	SW	2900 3000	51	26.9	1971	POA 1	Irrigation	26.9	2900 3000	51	26.9	Irrigation	POA 1 APOA 2	1971	
4	S	2	W	25	SW	SE	2900	51	2.0	1971	POA 1	Irrigation	2.0	2900	51	2.0	Irrigation	POA 1 APOA 2	1971	
TOTAL ACRES:										TOTAL ACRES:										
42.6										42.6										

Additional remarks: _____

RECEIVED

Permanent Water Right Transfer for Sonnen

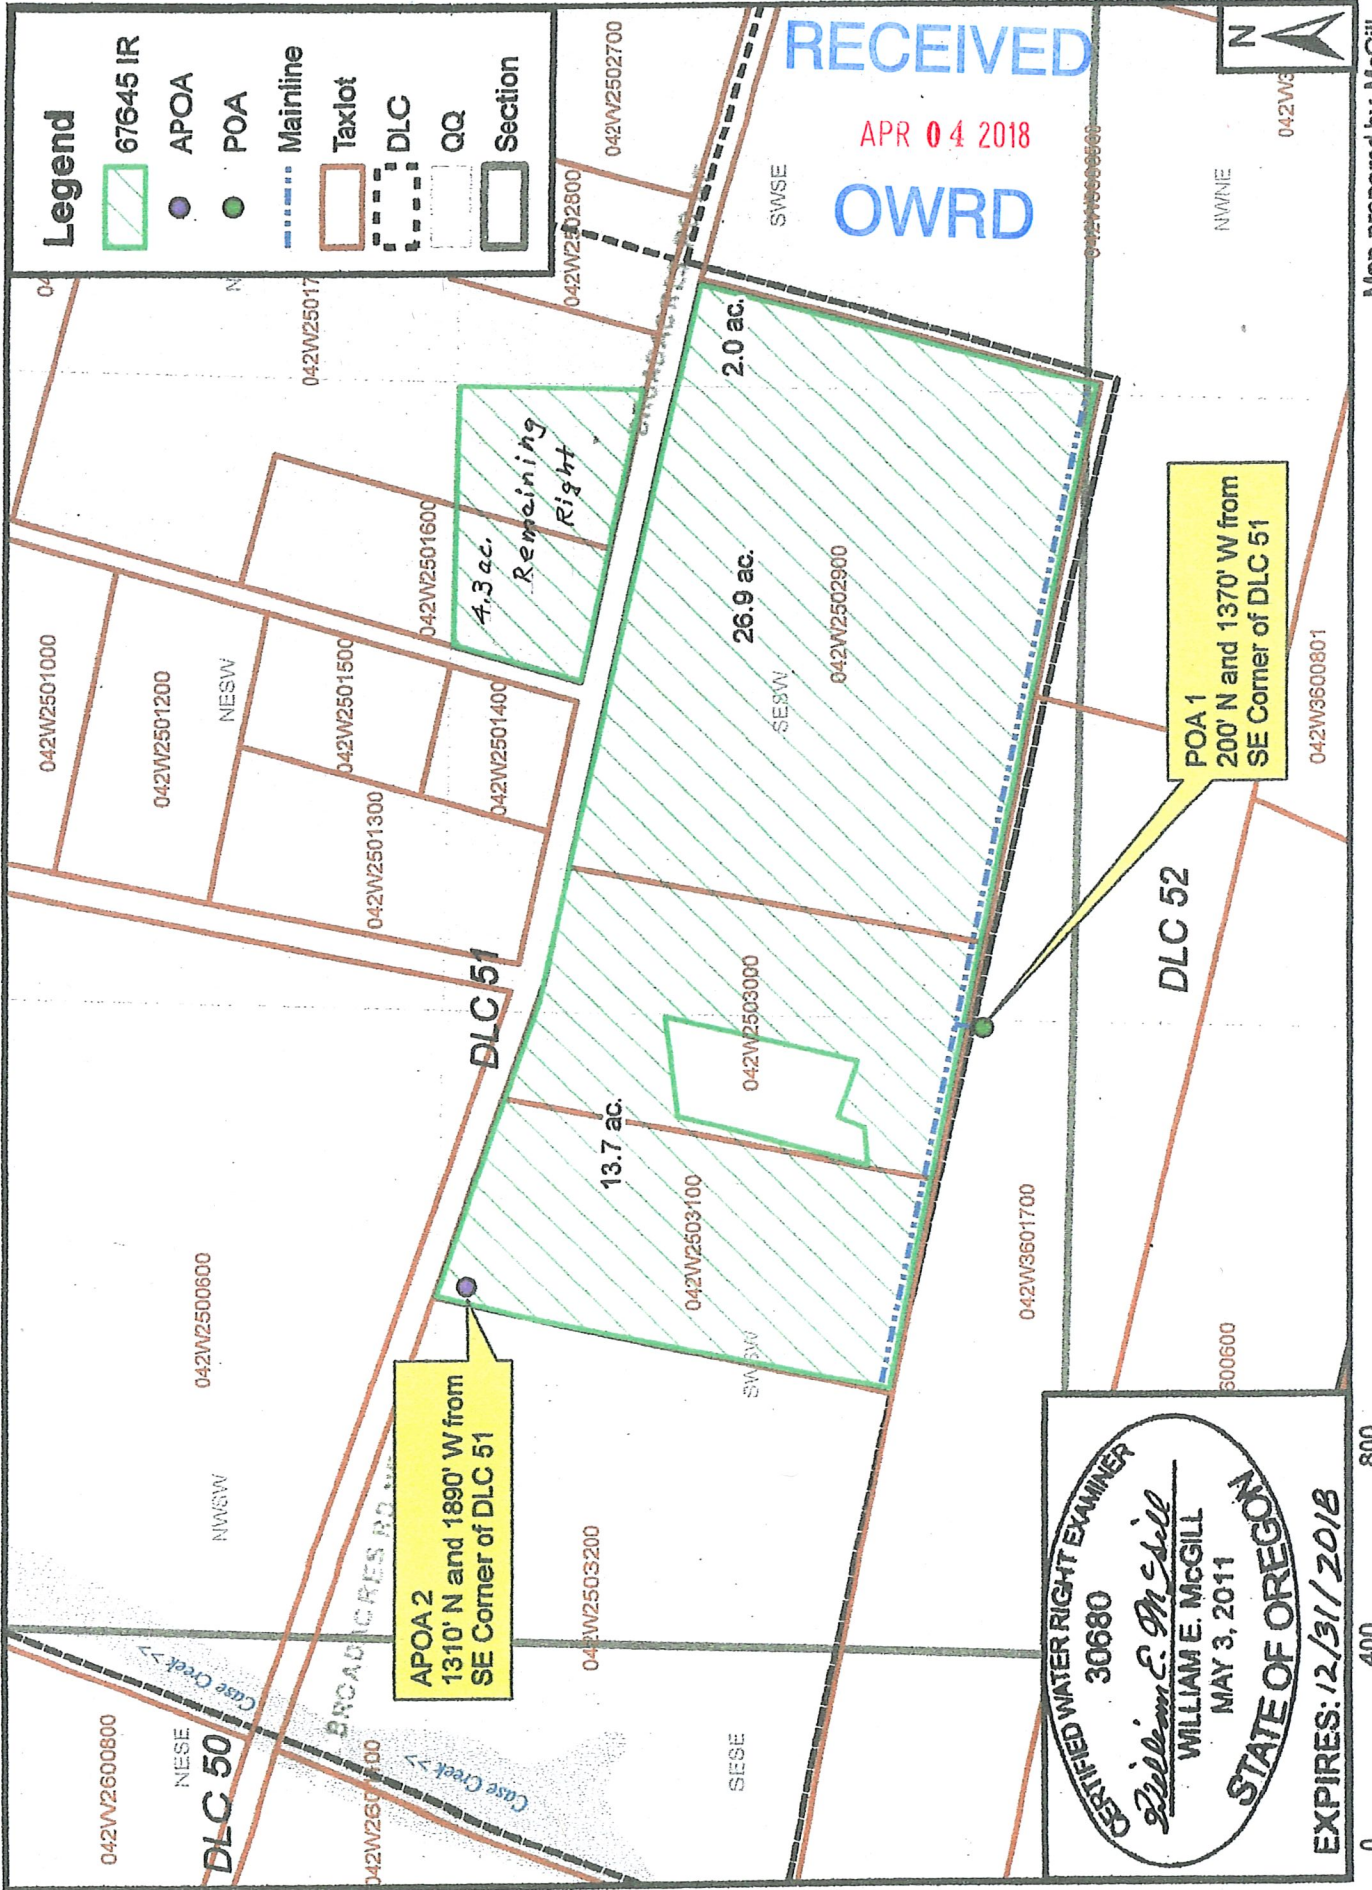

Map prepared by McGill

CERTIFIED WATER RIGHT EXAMINER
 30680
William E. McGill
 WILLIAM E. MCGILL
 MAY 3, 2011
 STATE OF OREGON

EXPIRES: 12/31/2018

