



Water Right Certificate 93383 T.4S.R.1E Sec. 18 & 19

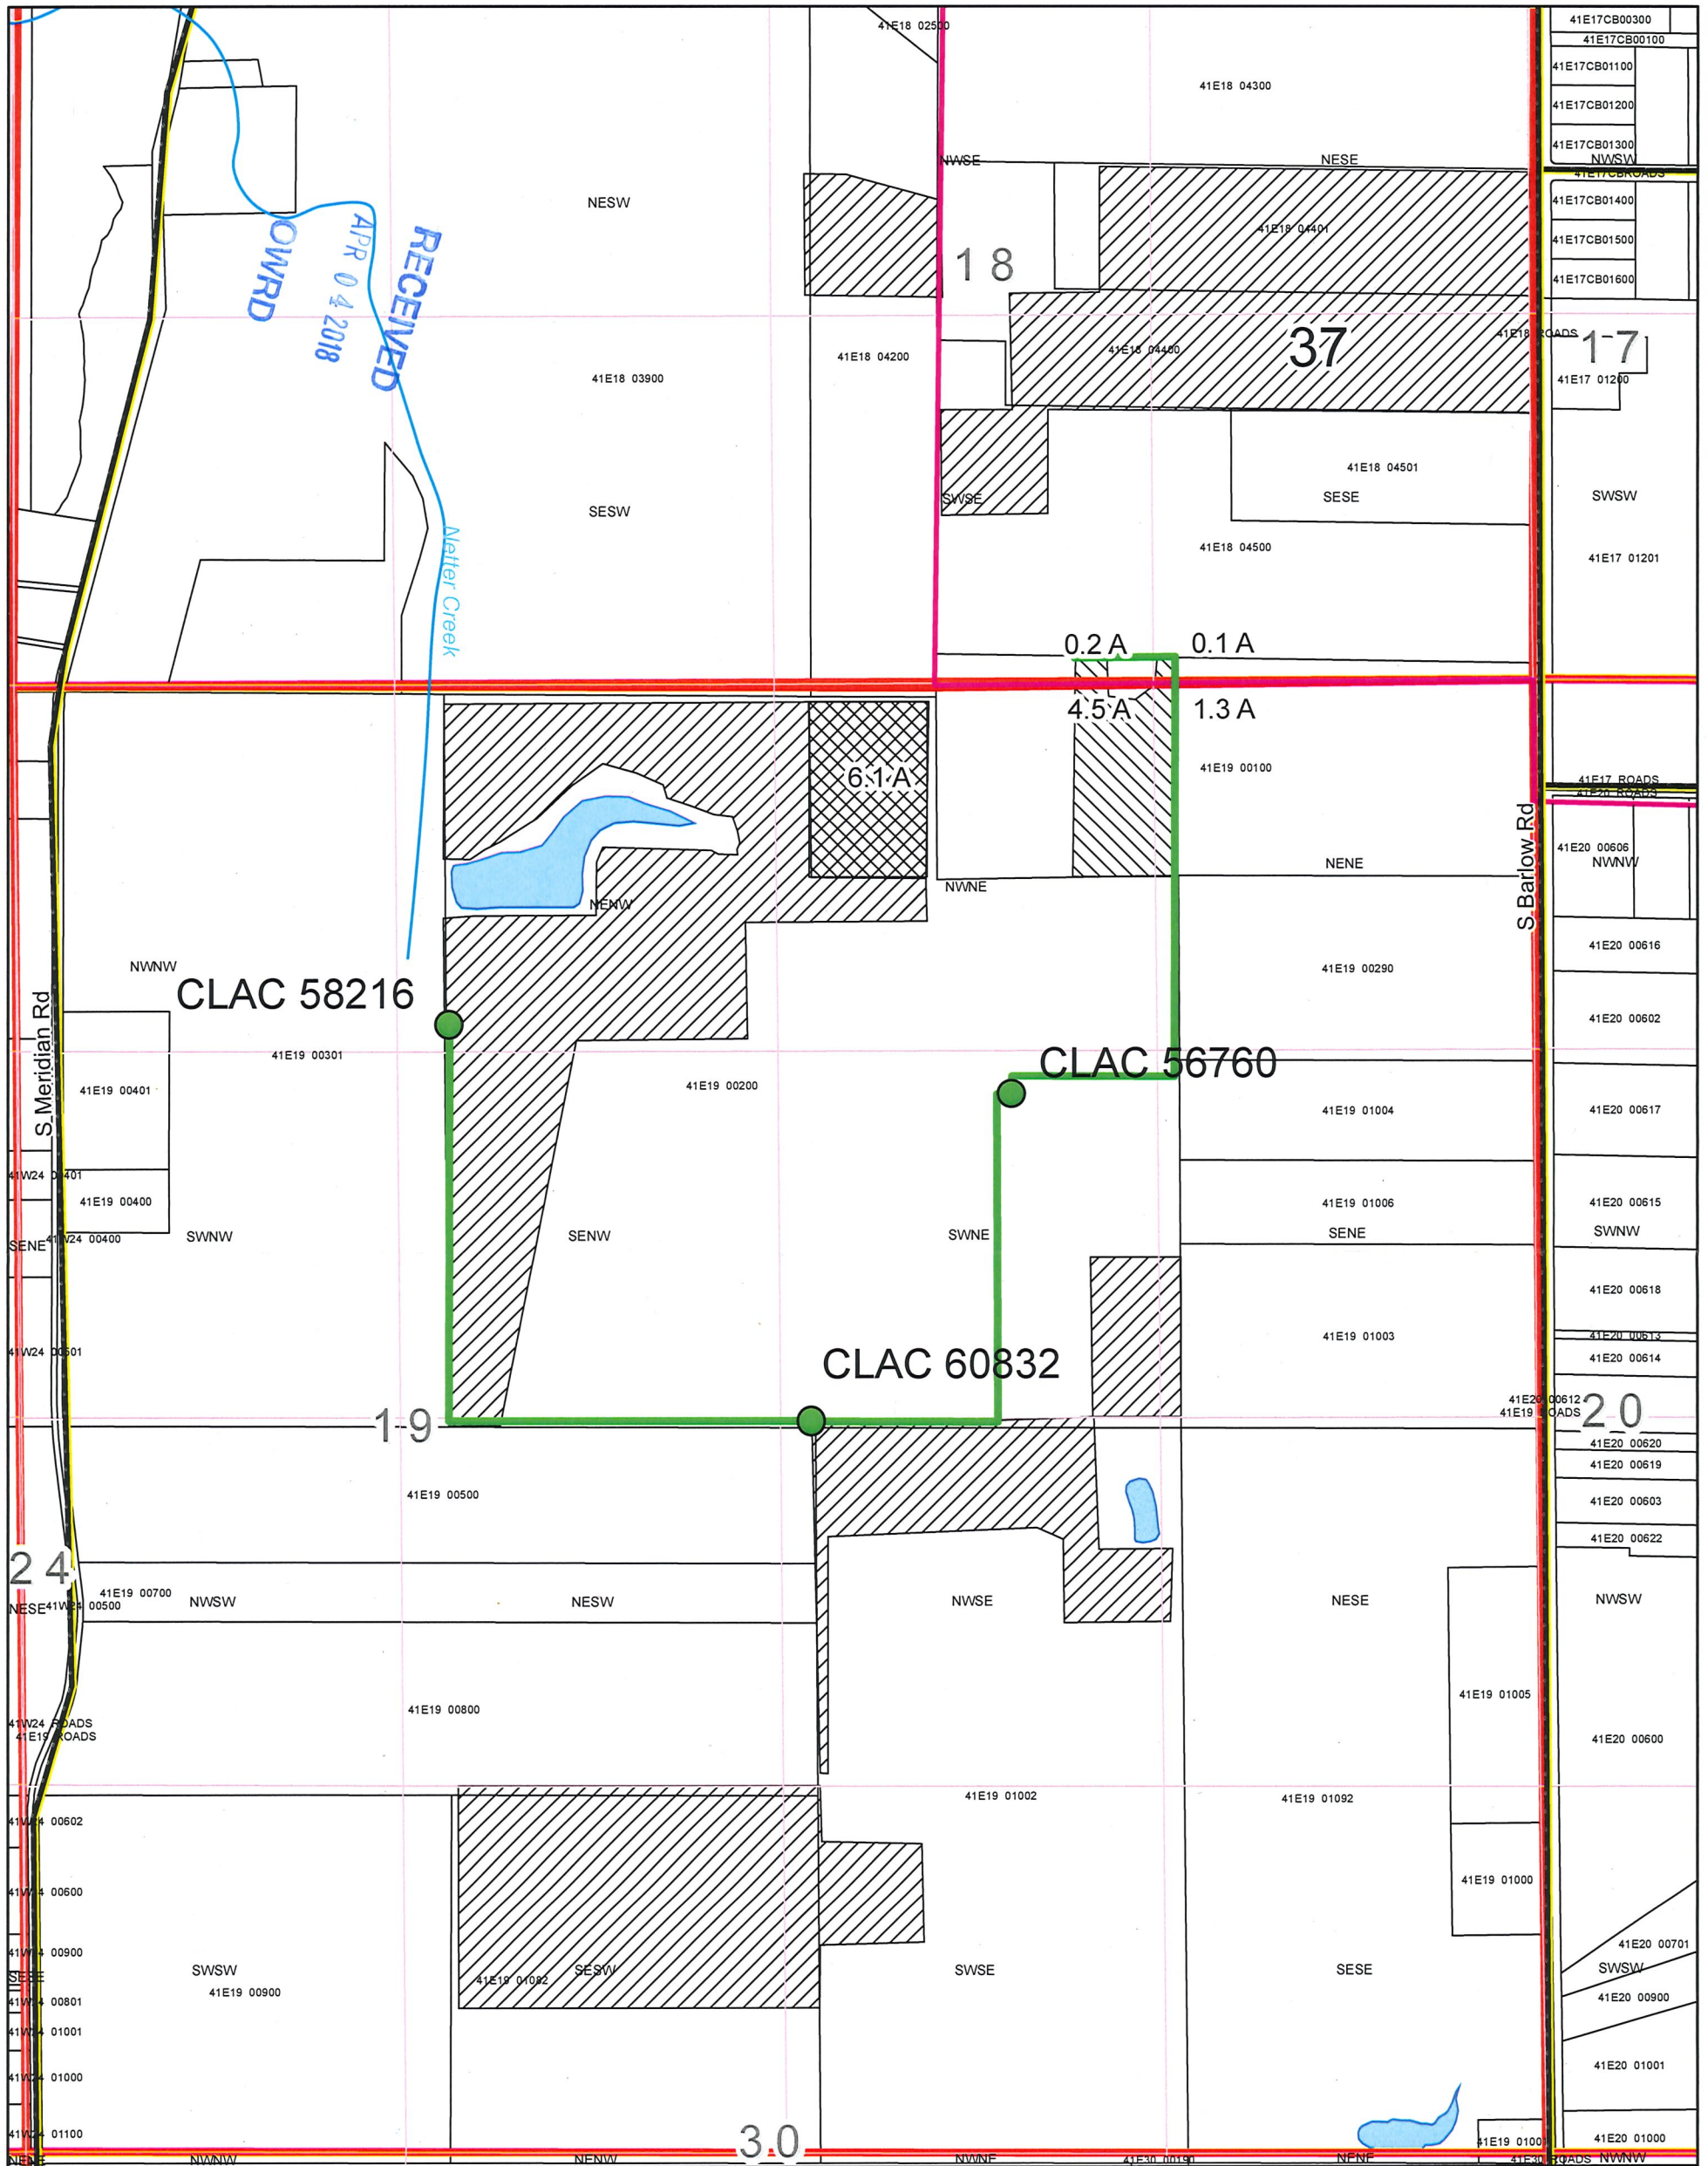

CLAC56760 IS LOCATED 1350 FEET SOUTH AND 1900 FEET WEST FROM NE CORNER, SECTION 19

CLAC58216 IS LOCATED 1200 FEET SOUTH AND 3920 FEET WEST FROM NE CORNER, SECTION 19

CLAC60832 IS LOCATED 2630 FEET SOUTH AND 2650 FEET WEST FROM NE CORNER, SECTION 19

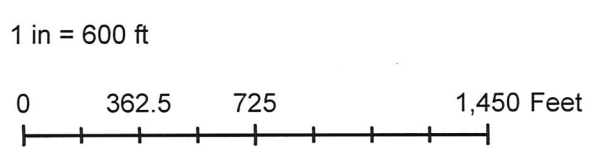

Date: 3/29/2018

	Proposed temporary place of use
	Existing place of use
	Unchanged place of use
	Quarter-Quarter section boundary
	Section boundary
	DLC boundary
	Tax lot boundary
	Road
	Point of Appropriation
	Irrigation mainline

