


**T32S R31E S25
T32S R32E S30, WM**

HARNEY COUNTY, OREGON



0 660 1,320
Feet
1 inch = 1,323 feet

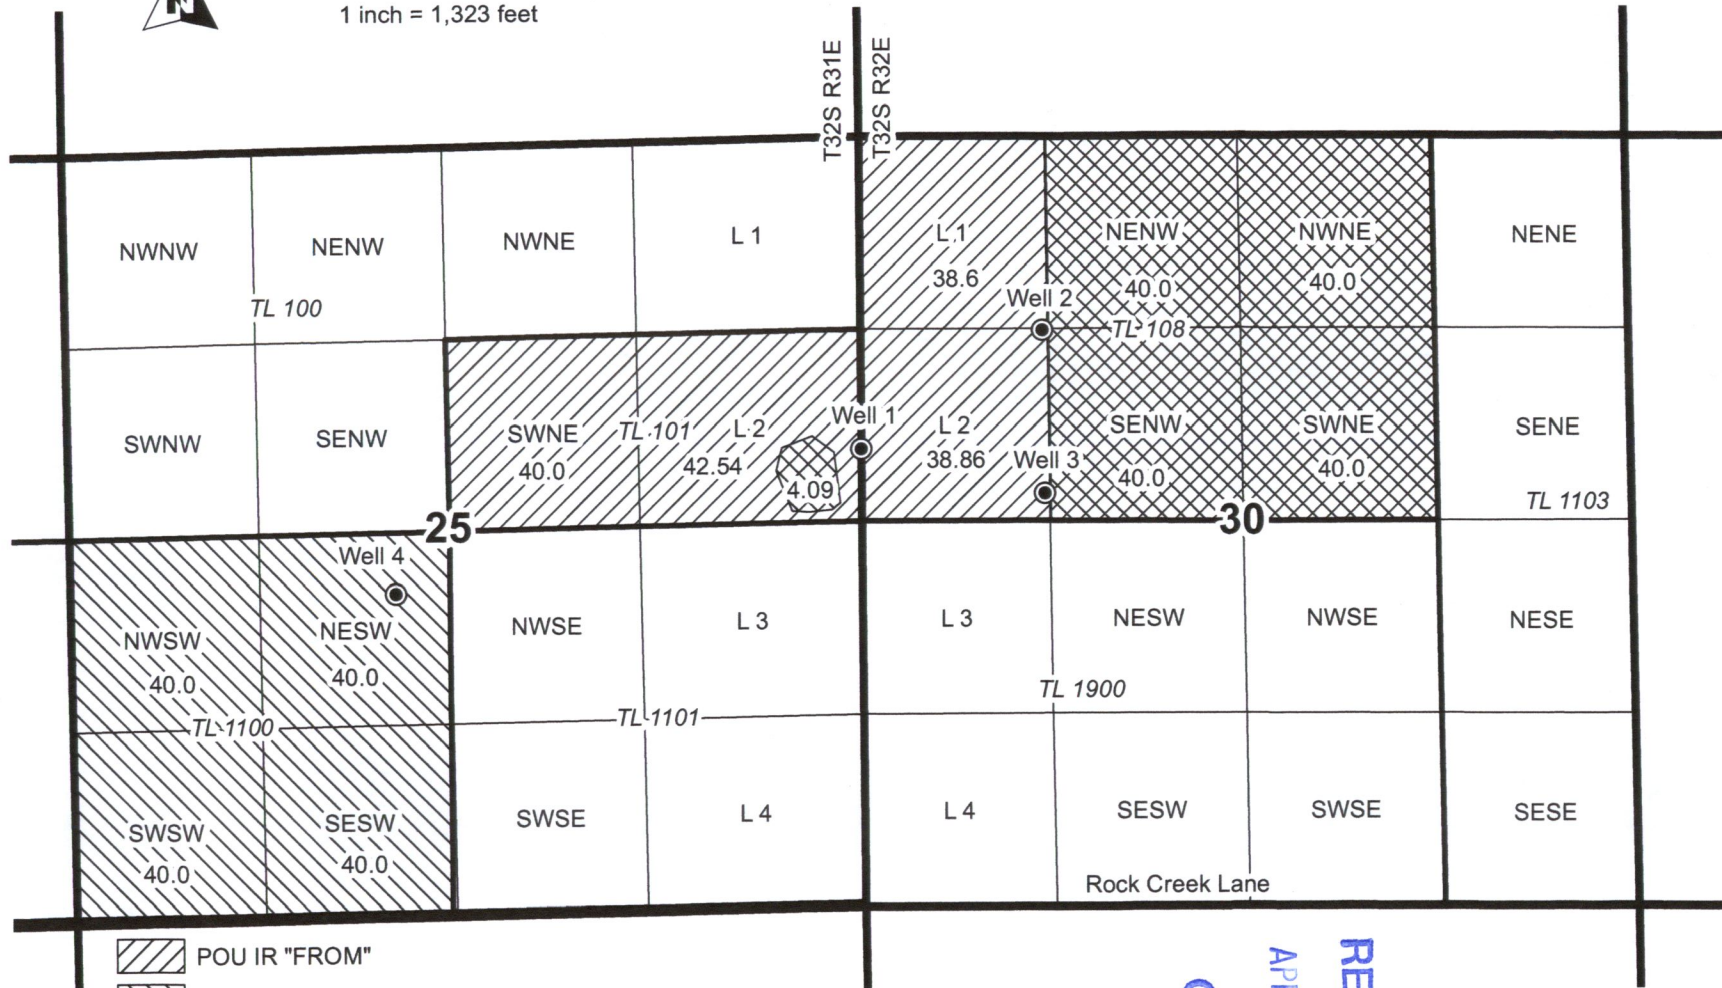

- POU IR "FROM"
- POU IR "TO"
- POU IR Remaining
- Section
- Well

Well Locations:
Well 1 - 2150' S, 15' E of NW Cor S30
Well 2 - 1320' S, 1280' E of NW Cor S 30
Well 3 - 2470' S, 1270' E of NW Cor S 30
Well 4 - 420' S, 370' W of Cen Cor S 25

RECEIVED
APR 30 2018
OWRD



PERMIT AMENDMENT MAP
Rock Creek Ranch, Inc.

NOTE: THIS MAP IS NOT INTENDED TO
PROVIDE LEGAL DIMENSIONS OR LOCATIONS
OF PROPERTY OWNERSHIP LINES.

WATER RIGHT SERVICES, LLC
PO BOX 1830, BEND, OR 97709
CCB# 197121 www.oregonwater.us
541-389-2837 JOHNSHORT@USA.COM