

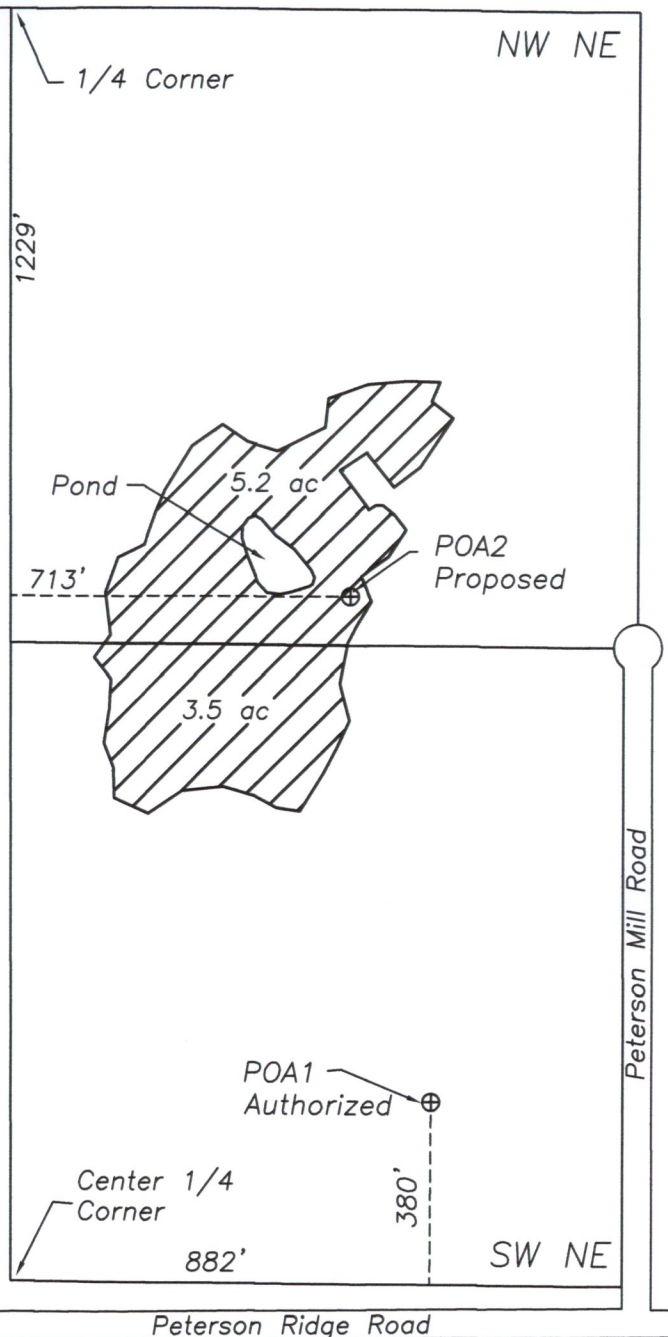


Sec. 21
Sec. 28

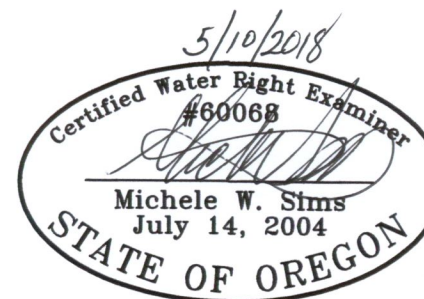

Permit Amendment
Permit G-11837
Application G-13434

Tax Lot 200, Map 15-10-28

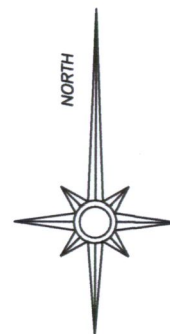

Renewal date: 6/30/2018

RECEIVED

MAY 14 2018

OWRD



Place of use for Permit G-11837

POA 1 (Authorized): 380' N and 882' E from C 1/4 Corner
Sec 28

POA2 (Proposed): 1229' S and 713' E from N 1/4 Corner of
Sec. 28

This map is for the purpose of identifying the location of the water
right. It is not intended to provide legal dimensions or locations of
property ownership lines.

400 0 400 800 1200



Graphic Scale