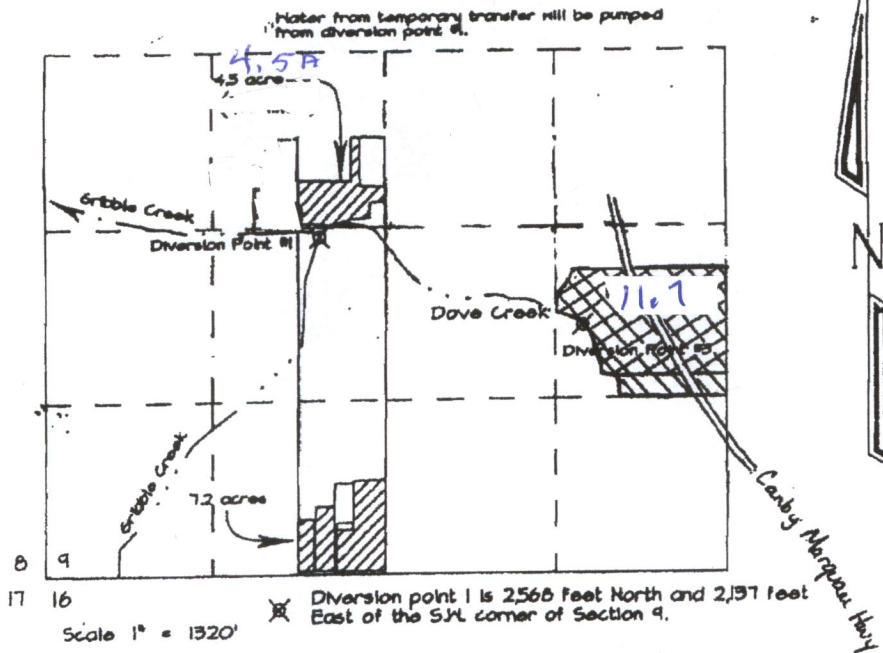

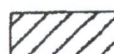



Section 9, T.4S. R.I.E. W.M.

CLACKAMAS COUNTY



-  Portion of Permit 18923 proposed for Transfer 11.7
-  Proposed Area of Use 11.7
-  Portion of Permit 18923 Not Subject to Transfer

APPLICATION MAP FOR TEMPORARY  
WATER RIGHT TRANSFER  
FOR  
Ramon DeMartini

APPLIC. NO. \_\_\_\_\_ PERMIT NO. \_\_\_\_\_

RECEIVED

MAY 22 2018

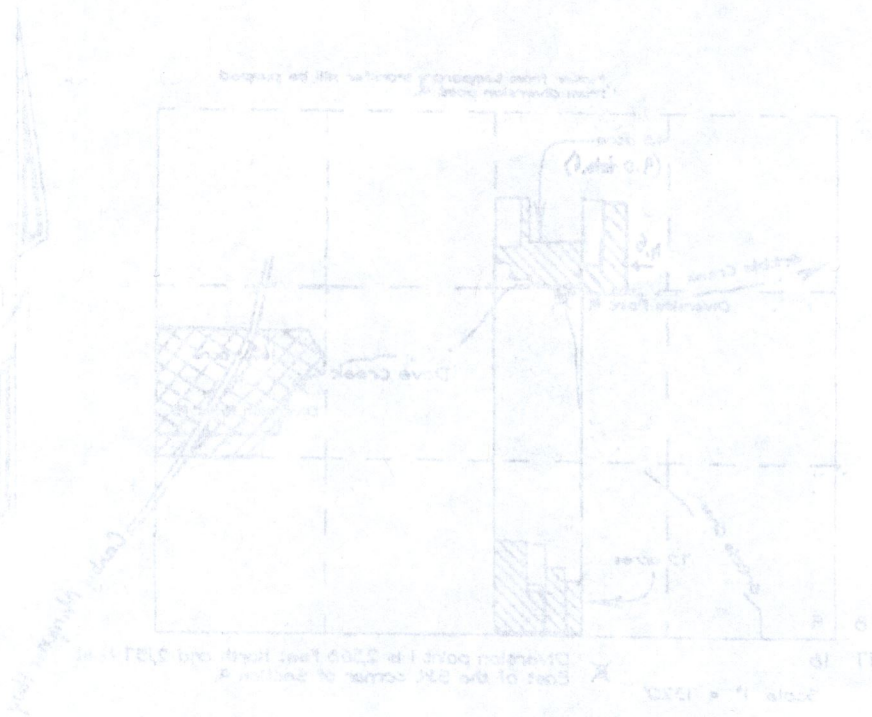
OWRD

RECEIVED

DEC 04 2012




WATER RESOURCES DEPT  
SALEM, OREGON

Section of T45, P1E, N1M  






APPLICATION MAP FOR TEMPORARY  
WATER RIGHT TRANSFER  
FOR  

APPLIC. NO. \_\_\_\_\_ PERMIT NO. \_\_\_\_\_

RECEIVED

DEC 04 2012

WATER RESOURCES DEPT  
BALEM, OREGON

RECEIVED

MAY 23 2018

WARD