


ips


~~49961, 50648, 64516 & 64561~~

.C

To Lands Including Remaining Rights

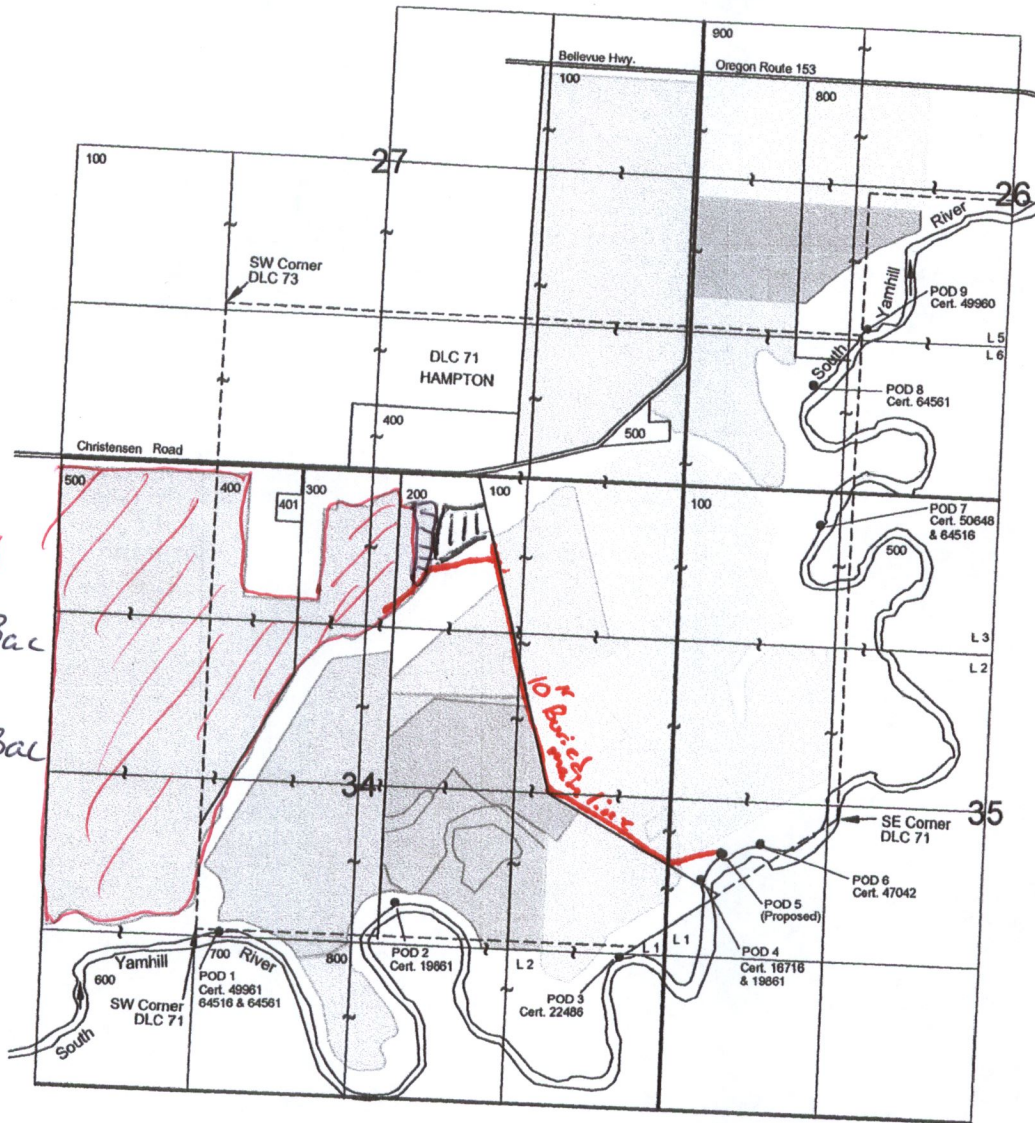

 Remaining
 to Land 3ac
 From Land 3ac

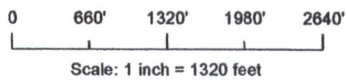

DRAFT - Figure 1

555w34 TL 00200 RECEIVED

MAY 24 2018

OWRD


Sections 34 & 35, T5S, R5W, W.M., Yamhill County

Transfer T-11478
CLAIM OF BENEFICIAL USE MAP
Christensen Farms LLC

RECEIVED

NOV 10 2016

WATER RESOURCES DEPT
SALEM, OREGON

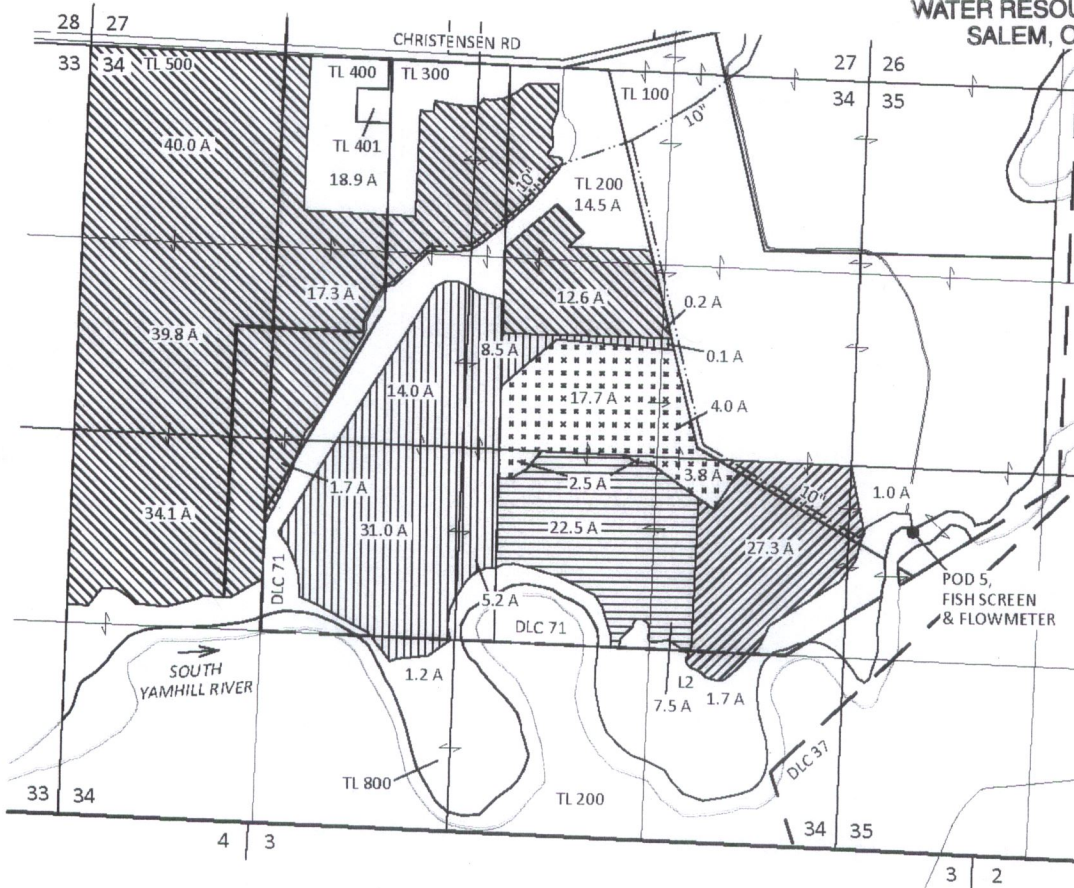
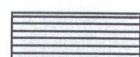







POD 5 LOCATION: 2180 FT N AND 510 FT E
FROM SW CORNER OF SECTION 35, T5S, R5W, W.M.

BLM DATA (SEE EXHIBIT C) INDICATES THE SOUTHERN BOUNDARY OF DLC 71
COINCIDES WITH QQ LINE

SITE INSPECTION CONDUCTED JULY 26, 2016

EXPLANATION

-  CANCELED CERTIFICATE 16716
30.0 ACRES
PRIORITY: 5/4/1944
-  CANCELED CERTIFICATE 19861
30.0 ACRES
PRIORITY: 4/18/1947
-  CANCELED CERTIFICATE 22486
28.0 ACRES
PRIORITY: 3/31/1950
-  CANCELED CERTIFICATE 49961
60.0 ACRES
PRIORITY: 7/6/1976
-  CANCELED CERTIFICATE 64516
179.1 ACRES
PRIORITY: 2/28/1979
-  POINT OF DIVERSION (POD)
-  PIPELINE (APPROX.)

RECEIVED

MAY 24 2018

OWRD

SCALE




1 INCH = 1320 FEET

November 3, 2016

This map is not intended to provide legal
dimensions or locations of property
ownership lines

MAP 1 OF 2

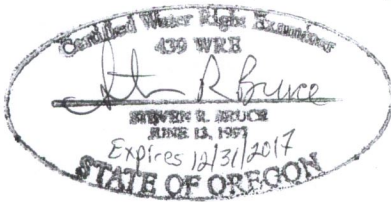

SKOOKUM
WATER ASSOCIATES, INC.

1626 VICTORIAN WAY
EUGENE, OR 97401
(503) 319-8926