


TRANSFER MAP TO ACCOMPANY APPLICATION TO CHANGE PLACE OF USE AND POINT OF DIVERSION FOR BILL DUNBAR

TAX LOTS 400 & 800
IN SECTIONS 6, 7, 8, 9, 16 AND 17,
TOWNSHIP 22 SOUTH, RANGE 30 EAST, W.M.
HARNEY COUNTY, OREGON

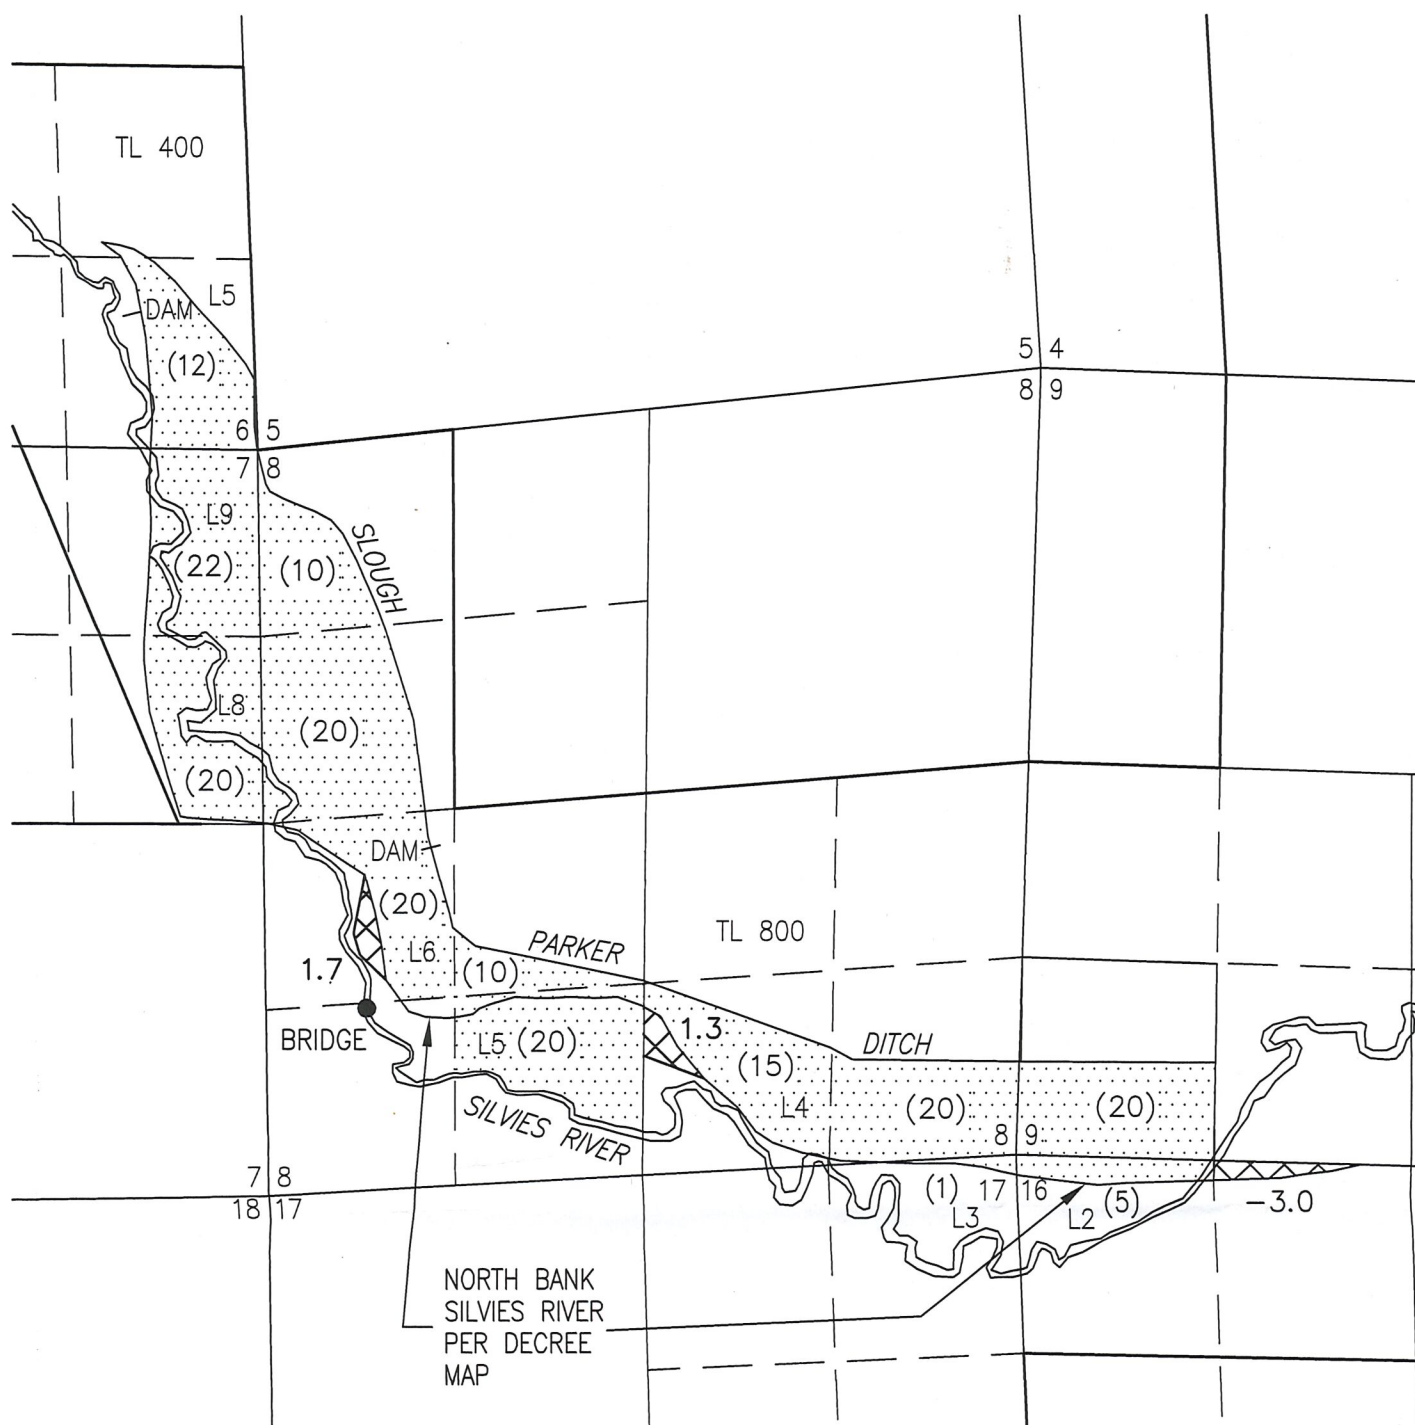


PLACE OF USE, DAMS, SLOUGHS & PARKER DITCH LOCATED AS SHOWN HEREON PER SILVIES RIVER DECREE MAP. THE LOCATION OF SILVIES RIVER WAS DIGITIZED FROM RECENT AERIAL IMAGERY.

- PROPOSED POD "BRIDGE" IN THE SW 1/4 SW 1/4 SECTION 8, T22S R30E, W.M. LOCATED 1250 FEET NORTH AND 700 FEET EAST FROM THE SW CORNER OF SECTION 8.



3.0 ACRES PRIMARY RIGHTS FROM SILVIES RIVER DECREE (V. 9, P. 79) POD CHANGED & POU MOVED, AS SHOWN.

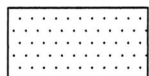

(195) ACRES REMAINING PRIMARY RIGHTS FROM SILVIES RIVER DECREE (V. 9, P. 79), POD CHANGED, AS SHOWN.

RECEIVED

MAY 25 2018

OWRD

THIS MAP IS FOR THE PURPOSE OF LOCATING A WATER RIGHT ONLY AND HAS NO INTENT TO PROVIDE LEGAL DIMENSIONS OR THE LOCATION OF PROPERTY LINES.

PROJECT No. 17-029

PREPARED AT THE REQUEST OF:
BILL DUNBAR
9622 VICTOR ROAD
ANCHORAGE, AK 99515

ALL POINTS ENGINEERING
& SURVEYING, INC.



P.O. BOX 767
TERREBONNE, OREGON 97760
(541) 548-5833 PH
Scott@APEandS.com
www.APEandS.com

