


Transfer - Certificate 40314 IS - From map

RECEIVED

MAY 30 2018


OWRD

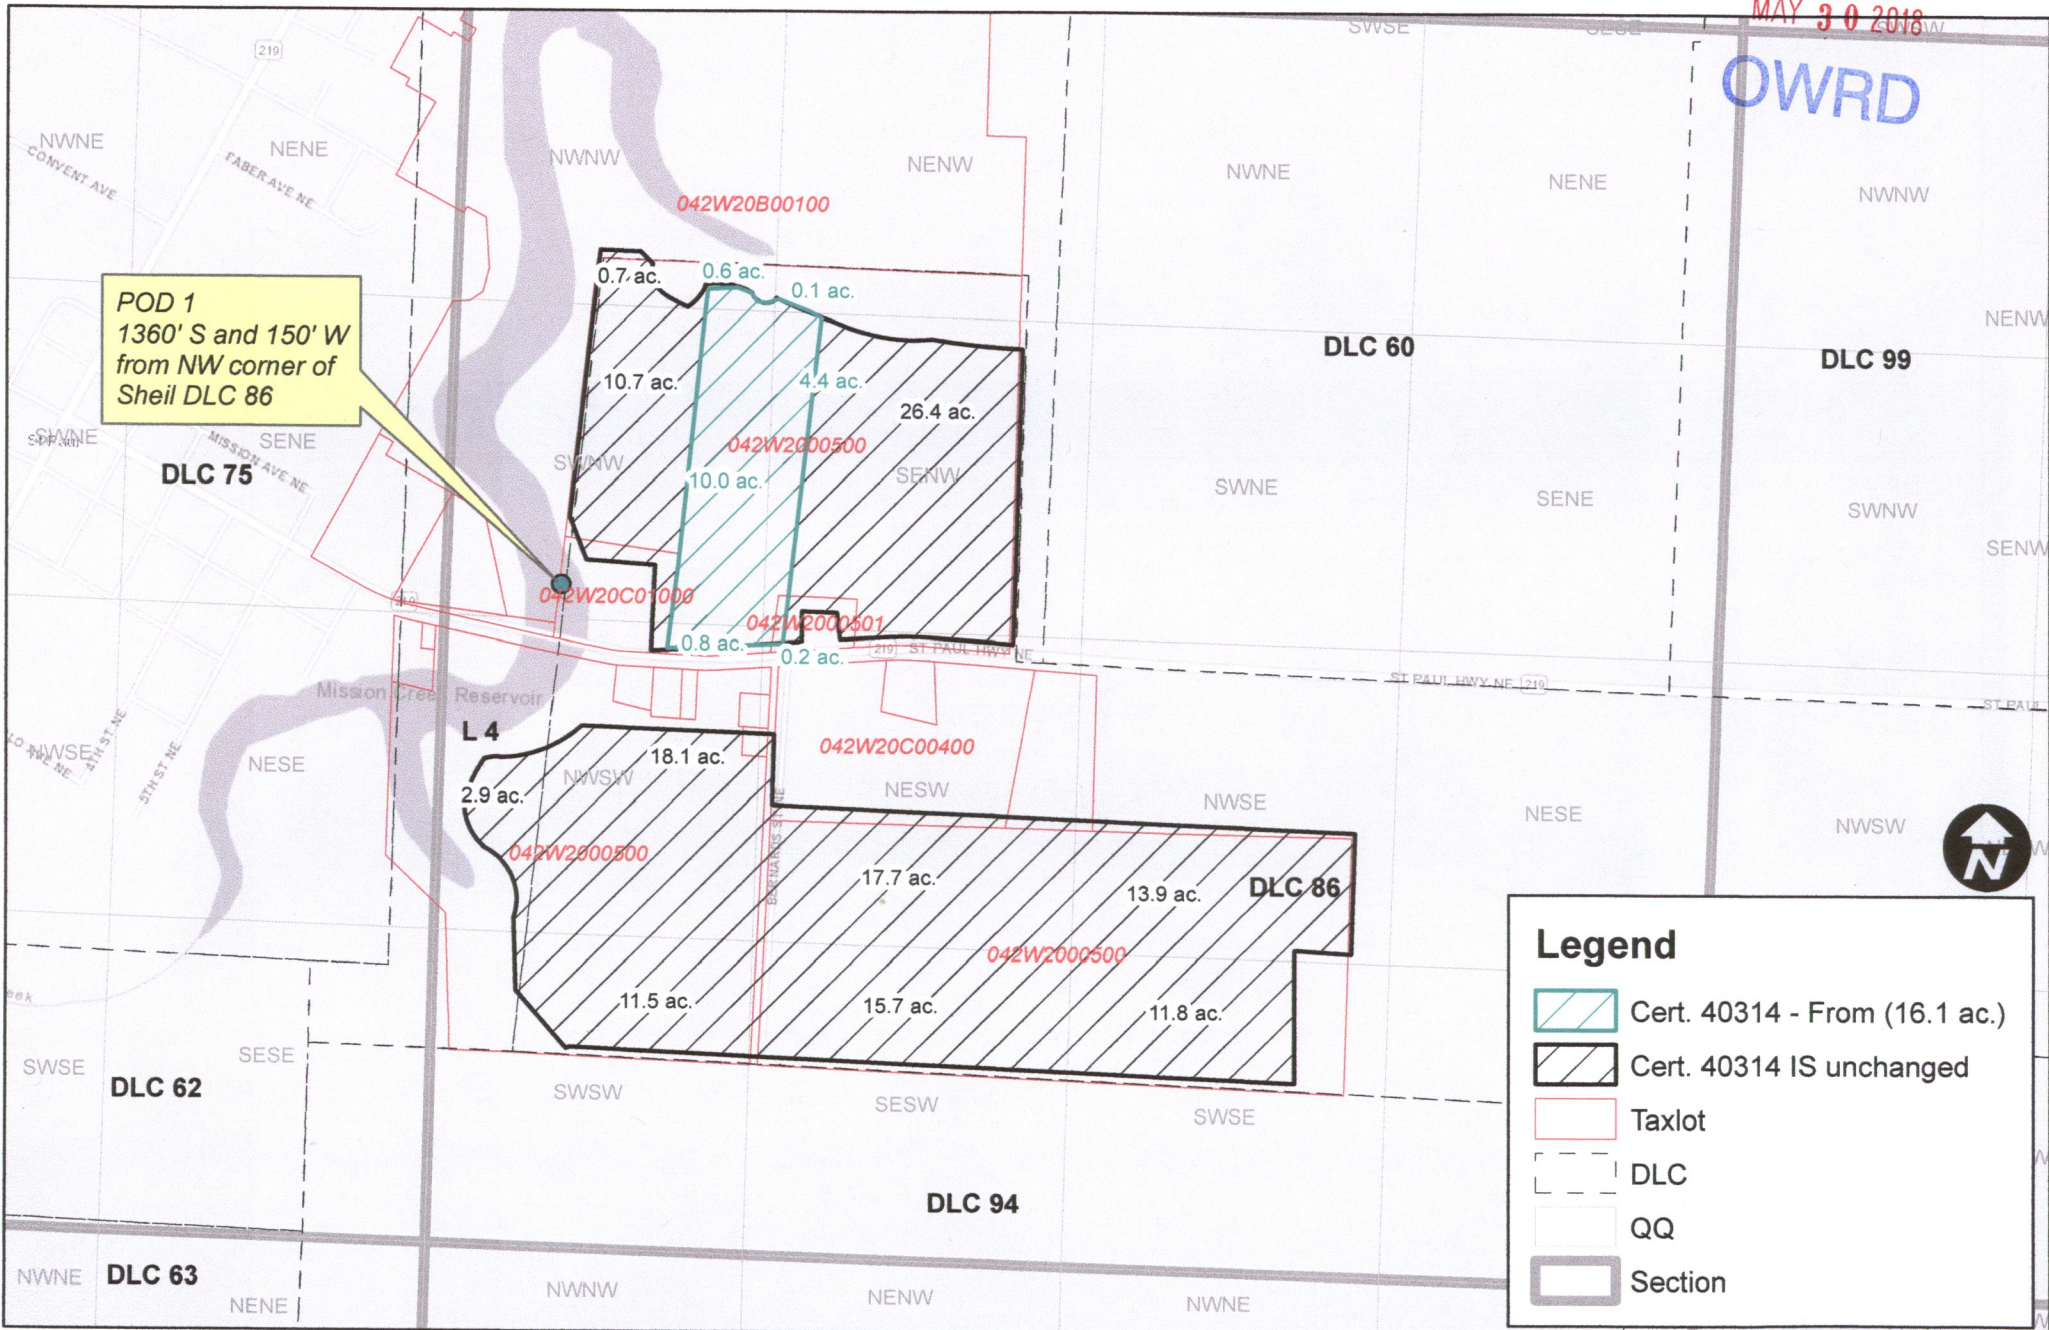

POD 1
1360' S and 150' W
from NW corner of
Sheil DLC 86

Legend

- Cert. 40314 - From (16.1 ac.)
- Cert. 40314 IS unchanged
- Taxlot
- DLC
- QQ
- Section

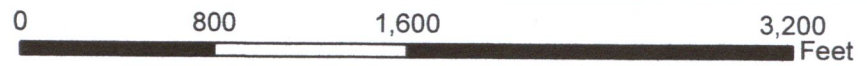


RECEIVED

MAY 30 2018



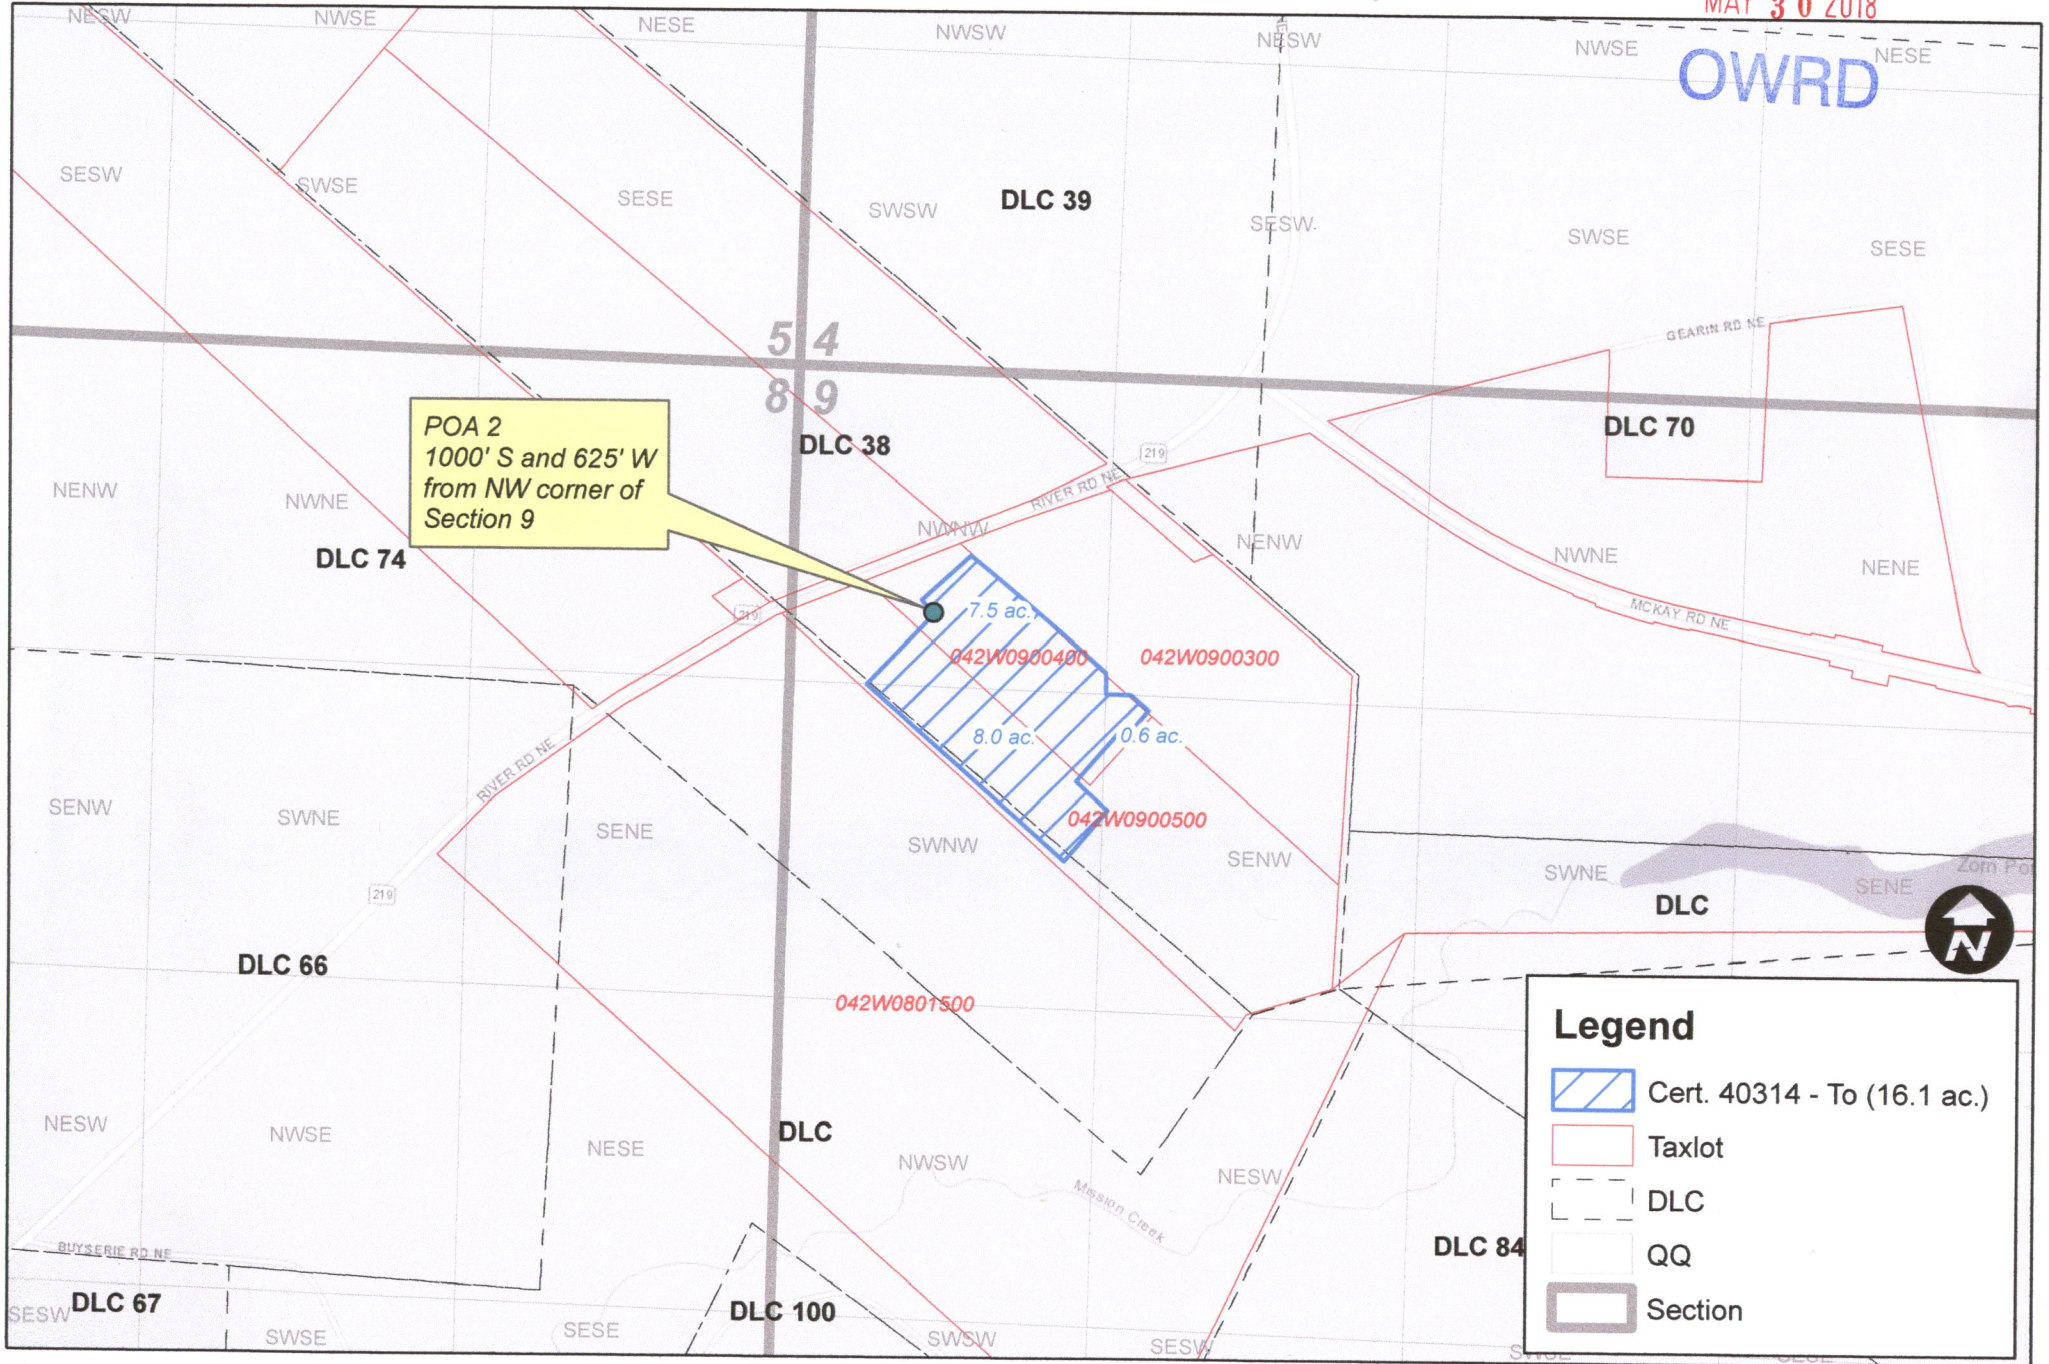


OWRD

Transfer - Certificate 40314 IS - To map



POA 2
1000' S and 625' W
from NW corner of
Section 9

Legend

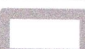-  Cert. 40314 - To (16.1 ac.)
-  Taxlot
-  DLC
-  QQ
-  Section

