



TRANSFER MAP TO ACCOMPANY APPLICATION
TO CHANGE PLACE OF USE FOR
DAVIS RANCHES AND FARMS


TAX LOT 100
IN SECTIONS 10 & 15, TOWNSHIP 36 SOUTH, RANGE 33 EAST, W.M.
HARNEY COUNTY, OREGON

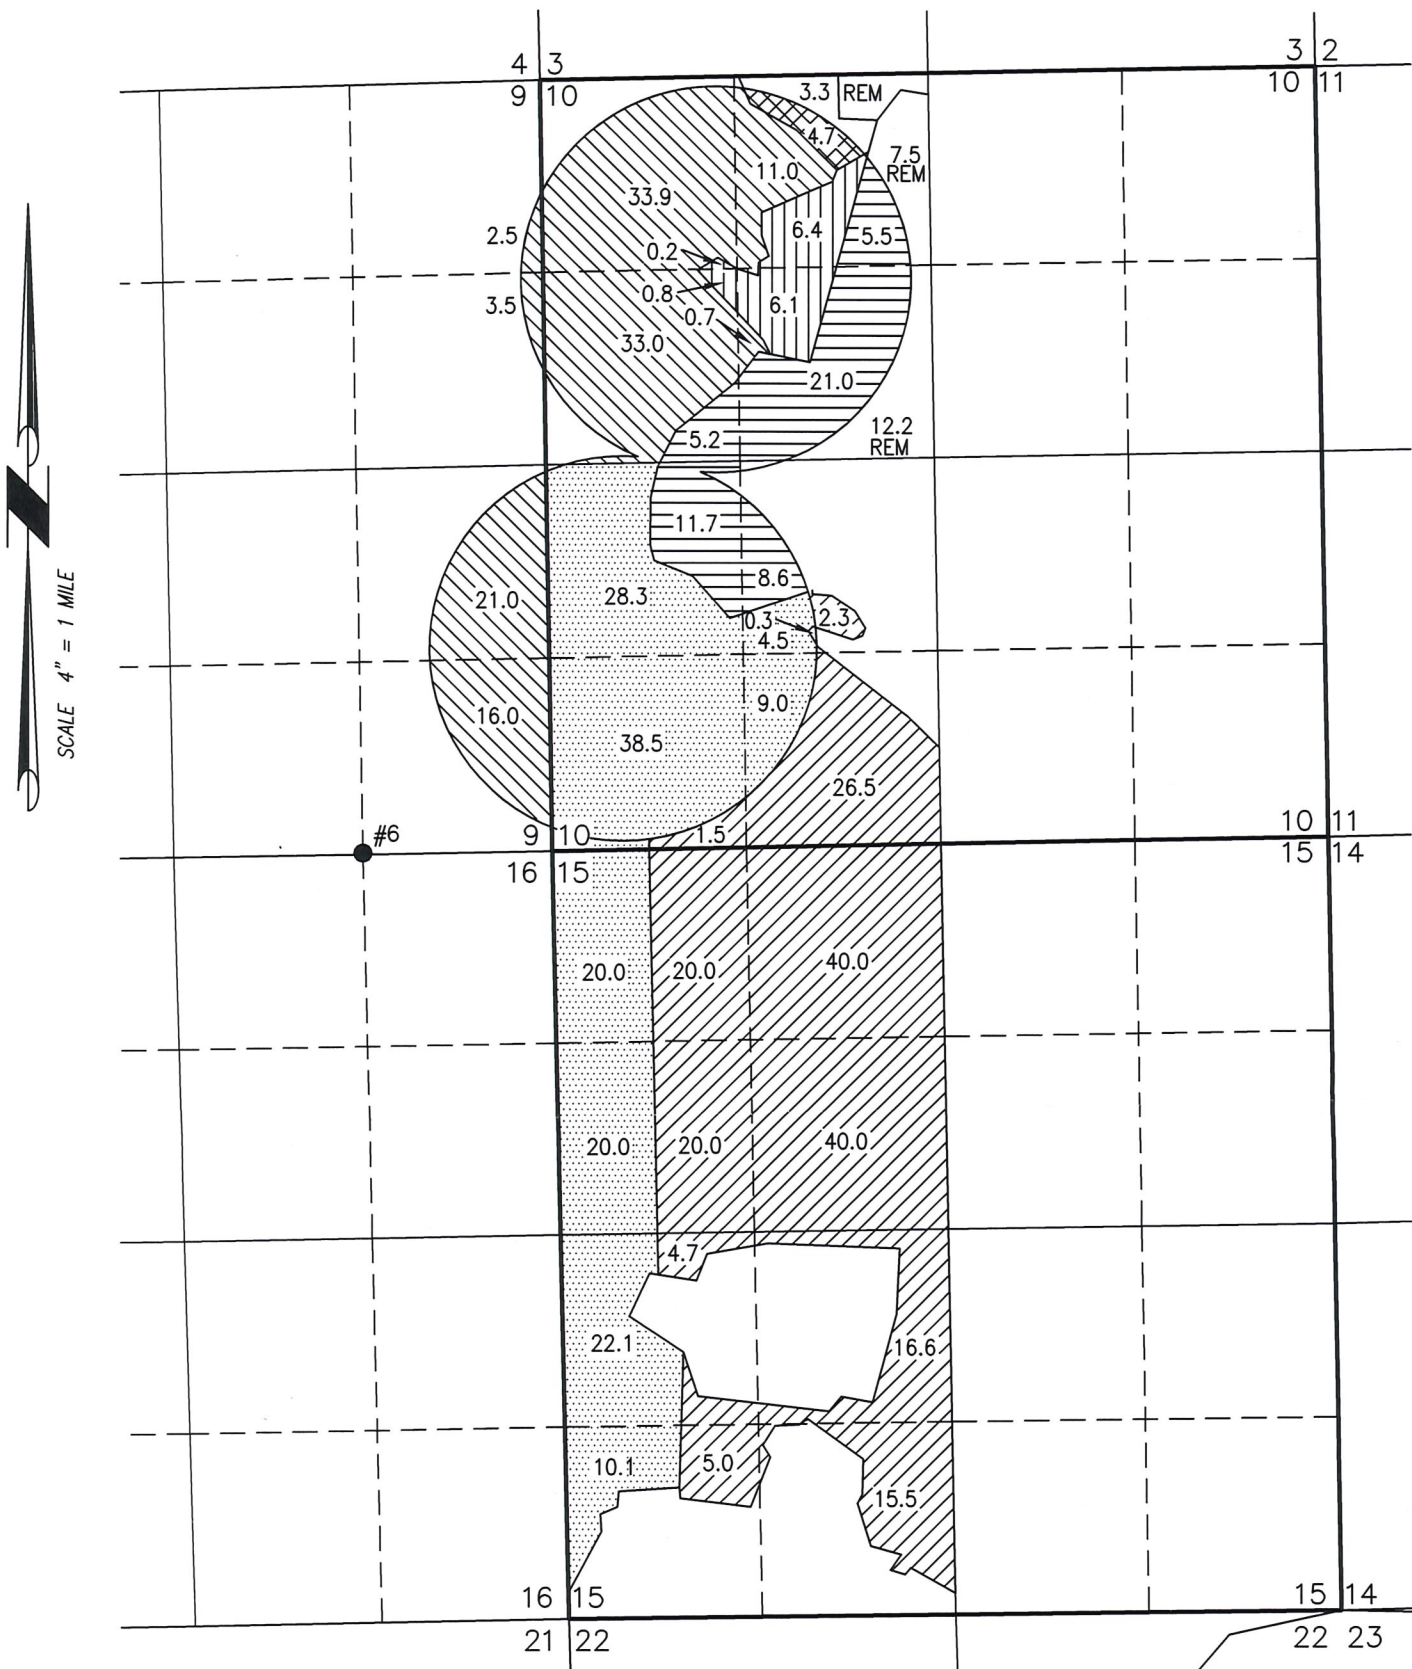


● WELL #6
(HARN 1752) PERMIT: G-9529
10' NORH & 1300' WEST FROM THE SE
CORNER SECTION 9.

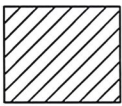


192.1 ACRES 'IR' FROM WELL 6 (C#84245)
PICKED UP, AS SHOWN

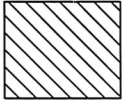


121.9 ACRES 'IR' FROM WELL 6 (C#84245)
PUT DOWN, AS SHOWN

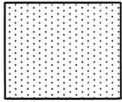


151.2 ACRES 'IR' FROM WELL 6 (C#84245)
REMAIN, AS SHOWN

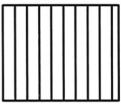

13.5 ACRES 'IR' FROM WELL 6 (C#84245)
PUT DOWN AFFECTING C#49182 'IR' &
C#84245 'IS', AS SHOWN

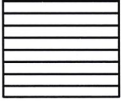

52.0 ACRES 'IR' FROM WELL 6 (C#84245) PUT
DOWN AFFECTING C#20919 'IR', AS SHOWN &
31.7 ACRES C#84245 'IS' IN NW 1/4

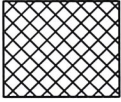

4.7 ACRES 'IR' FROM WELL 6 (C#84245)
PUT DOWN AFFECTING C#84057 'IR' &
C#84245 'IS', AS SHOWN

RECEIVED

JUN 18 2018

OWRD

PROJECT No. 18-007

PREPARED AT THE REQUEST OF:
MIKE DAVIS
42970 KUENY RANCH LANE
PRINCETON, OR 97721



ALL POINTS ENGINEERING
& SURVEYING, INC.

P.O. BOX 767
TERREBONNE, OREGON 97760
(541) 548-5833 PH
(844) 273-9878 FX
www.APEandS.com

THIS MAP IS FOR THE PURPOSE OF
LOCATING A WATER RIGHT ONLY AND
HAS NO INTENT TO PROVIDE LEGAL
DIMENSIONS OR THE LOCATION OF
PROPERTY LINES.