

Please use and attach additional pages of Table 2 as needed.

**Table 2. Description of Changes to Water Right Certificate No. 81585**



List the change proposed for the acreage in each 1/4 1/4. If more than one change is proposed, specify the acreage associated with each change. If there is more than one POD/POA involved in the proposed changes, specify the acreage associated with each POD/POA.

Additional remarks: Revised June 13, 2018 per affidavit of cancellation for 2.4 acres inundated by Blue Skye Reservoir.

AUTHORIZED ("from lands")										PROPOSED ("to lands")												
The listing that appears on the certificate BEFORE PROPOSED CHANGES										The listing as it would appear AFTER PROPOSED CHANGES												
List only that part or portion of the water right that will be changed.										are made.												
Twp	Rng	Sec	1/4	1/4	Tax Lot	Gvt Lot or DLC	Acres	Type of USE listed on Certificate	POD Number from Table 1	Priority Date	Proposed Changes (see "CODES" from previous page)	Twp	Rng	Sec	1/4	1/4	Tax Lot	Gvt Lot or DLC	Acres	New Type of USE	POD Number from Table 1	Priority Date
38 S	5 W	11	SE	SE	503	NA	20.6	PRI IRR	POD 1	1867	USE	38 S	5 W	11	SW	SE	503	NA	0.2	NURSERY	POD 1	1867
38 S	5 W	11	SW	SE	503	NA	12.9	PRI IRR	POD 1	1867	USE	38 S	5 W	11	SE	SE	503	NA	2.0	NURSERY	POD 1	1867
											POU	38 S	5 W	11	SE	SW	500	NA	4.9	PRI IRR	POD 1	1867
											POU	38 S	5 W	14	NW	NW	500	NA	10.6	PRI IRR	POD 1	1867
											POU	38 S	5 W	14	NE	NW	500	NA	6.7	PRI IRR	POD 1	1867
											POU	38 S	5 W	14	NW	NE	500	NA	9.1	PRI IRR	POD 1	1867
TOTAL ACRES: 33.5										TOTAL ACRES: 33.5												

RECEIVED  
JUN 22 2018  
OWRP  
Revised 7/1/2013

POINT OF DIVERSION DETAIL  
Certificate No. 81585

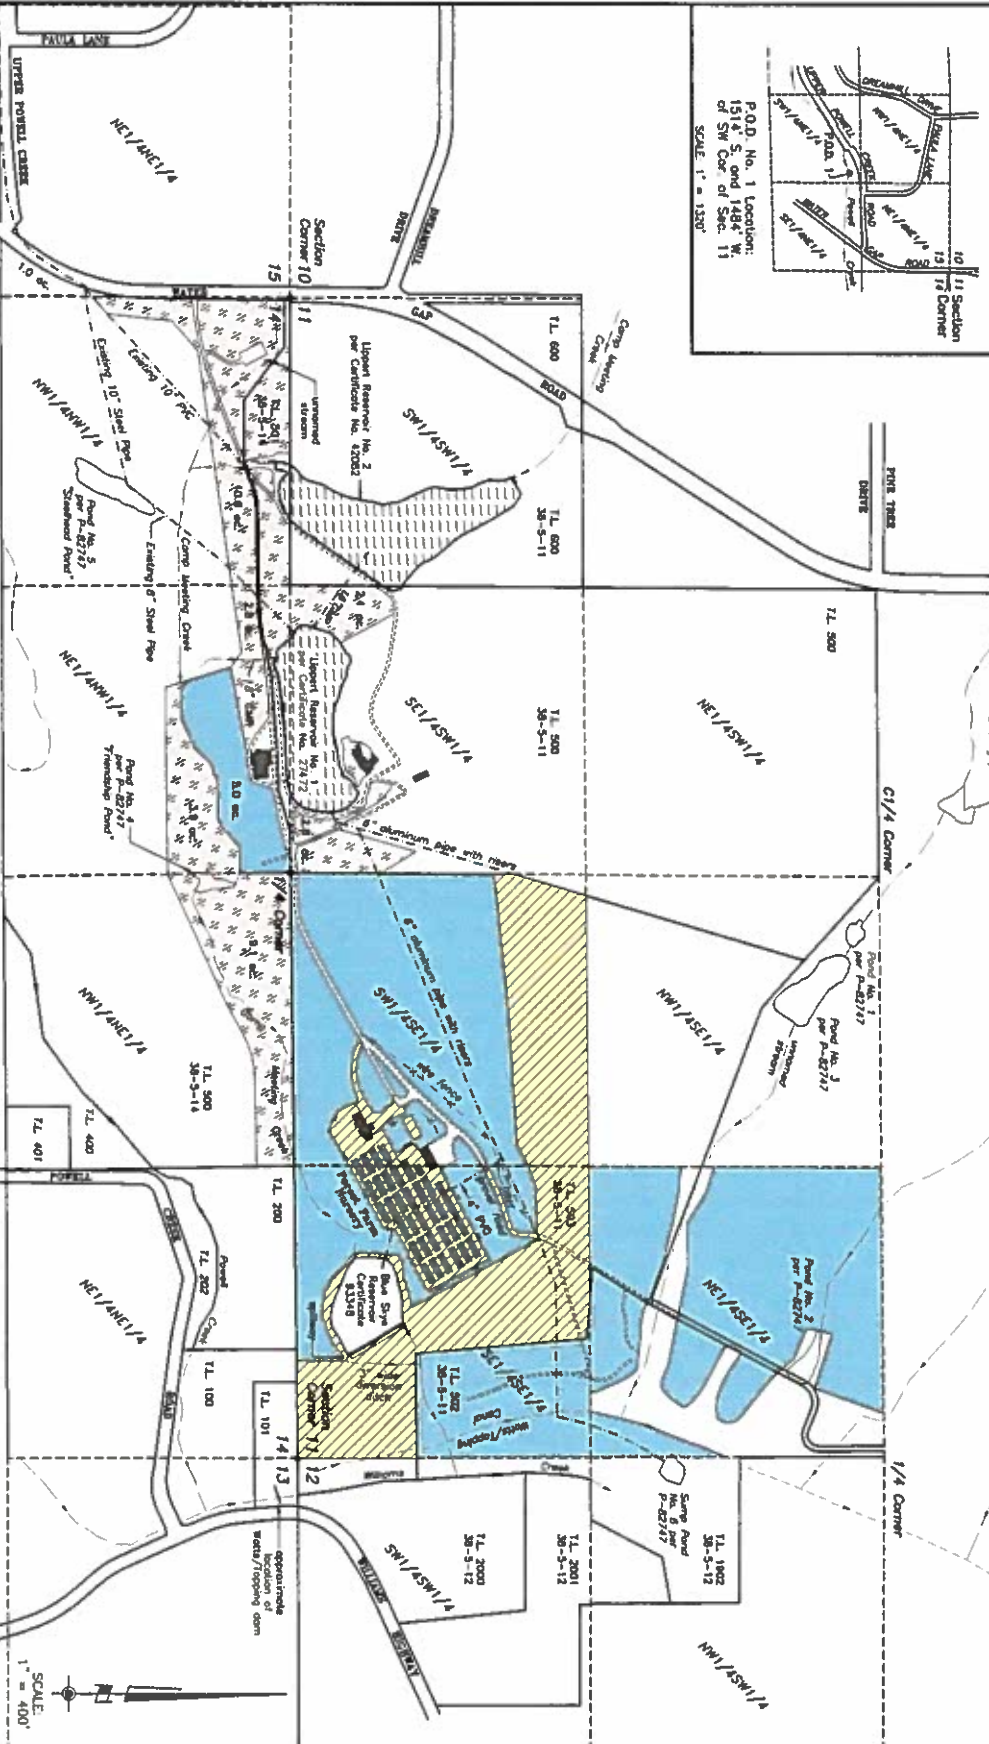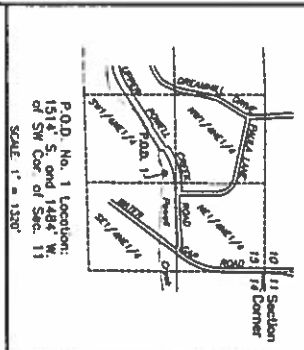

The purpose of this application is to transfer 33.7 acres of water rights within property owned by Pacific - A Garden in the Steadyous. These rights were confirmed by decree per Certificate No. 16317 with a priority date of 1967. This certificate was superseded by Certificate No. 49426, which was in turn superseded by Certificate No. 81585.

Source of water: Porell Creek (Front No. 2)  

NOTE: 5.0 acres in the NW1/4SW1/4, Sec. 12 (foot shown) per C-81585 remain unchopped by this transfer application. An affidavit for the cancellation of 2.4 acres inundated by Blue Skye Reservoir is being submitted concurrently.

This plat was prepared for the purpose of identifying the location of the water right only. There is no intent to provide dimensions or locations of property ownership lines.

**LEGEND:**

[Hatched Box]	Area of the Transfer Front: 31.3 acres SE1/4SE1/4 (Sec. 11) = 16.6 acres SW1/4SE1/4 (Sec. 11) = 12.7 acres
[Blue Box]	Pondage
[Blue Box]	Storage Pondage
[Blue Box]	Approximate location of water/topping dam
[Blue Box]	Existing building

Frontal Area of the Transfer Front: 31.3 acres  
 SE1/4SE1/4 (Sec. 11) = 16.6 acres  
 SW1/4SE1/4 (Sec. 11) = 12.7 acres  
 NE1/4NE1/4 (Sec. 11) = 18.0 ac. (10.6 ac. Pacific property)  
 NW1/4NE1/4 (Sec. 11) = 22.3 acres  
 NE1/4SW1/4 (Sec. 14) = 50.0 ac. (23.1 ac. Pacific property)  
 NW1/4SW1/4 (Sec. 14) = 5.0 acres

RECEIVED  
JUN 22 2018  
OWBD

PROJECT NO. 626-99-414	 194 WRB Gary D. Hicks May 17, 1968 Renewal Date: 6-30-18	PLAT OF WATER RIGHTS TRANSFER APPLICATION PRIMARY RIGHTS PER C-81585		LOCATED IN S1/2SE1/4 & SE1/4SW1/4 of Sec. 11, N1/2NW1/4 & NW1/4NE1/4 of Sec. 14, and NE1/4NE1/4 of Sec. 15 Township 38 South, Range 5 West, W.M. Josephine County, Oregon	SURVEYED BY: WICKS ENGINEERING & SURVEYING 311 N.E. "D" Street Grants Pass, Oregon 97526 Tel: 541-479-3436 Fax: 541-479-1014
DRAWING NO. 735-18.24		SURVEYED FOR: PACIFICA A Garden in the Steadyous 14615 Water Gap Road Williams, Oregon 97544 Tel. (541) 846-1100	DATE 6-13-18 Revision No. 6	SCALE 1" = 400'	SHEET NO. 1 of 2