


ACMPC OREGON I, LLC  
T8S R4W, W.M.



scale 4" = 1 mile

DLC Line	— — — —		Cert. 81572 RR
Section Line	— — — —		Cert. 39081
1/4 1/4 Line	— — — —		Cert. 39081
Property Line Adjustment	- - - - -		Cert. 39081
Buried PVC mainline	- - - - -		On Setniker Land

CERTIFIED WATER RIGHT EXAMINER  
30680  
*William E. McGill*  
WILLIAM E. MCGILL  
MAY 3, 2011  
STATE OF OREGON  
EXPIRES: 12/31/2018

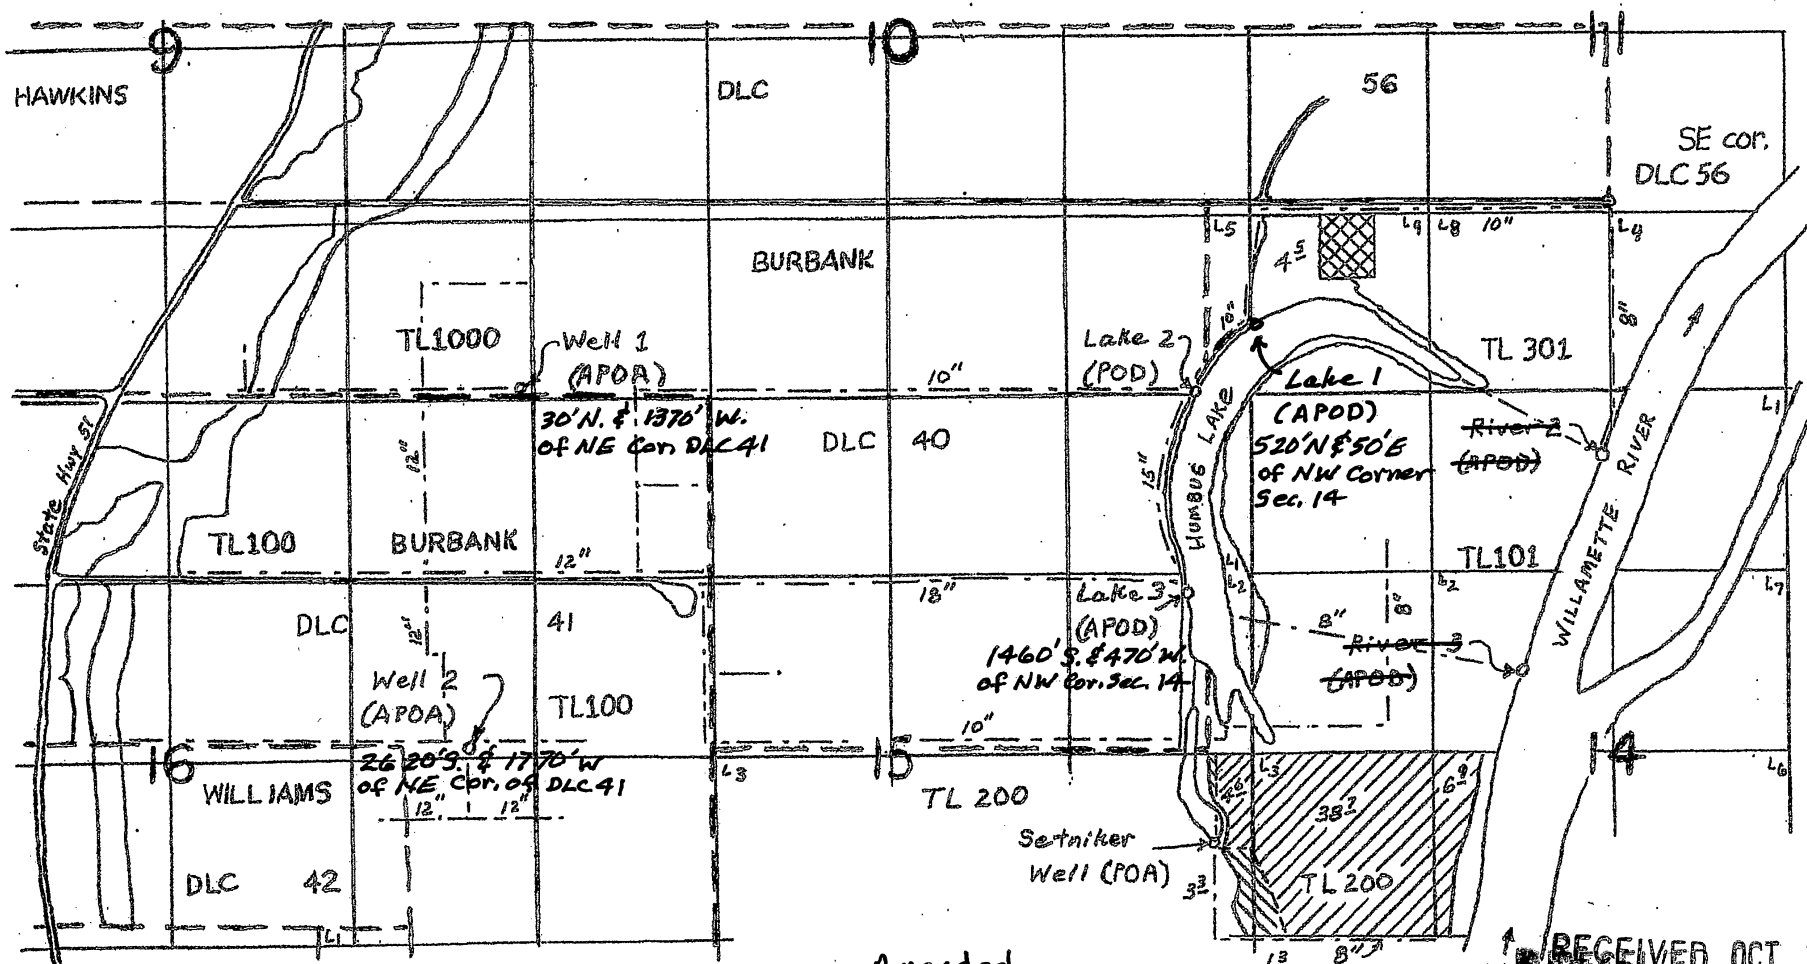

Amended  
10-25-17 WEM

RECEIVED OCT 30 2017