



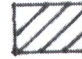

T6S.R.IW.W.M.

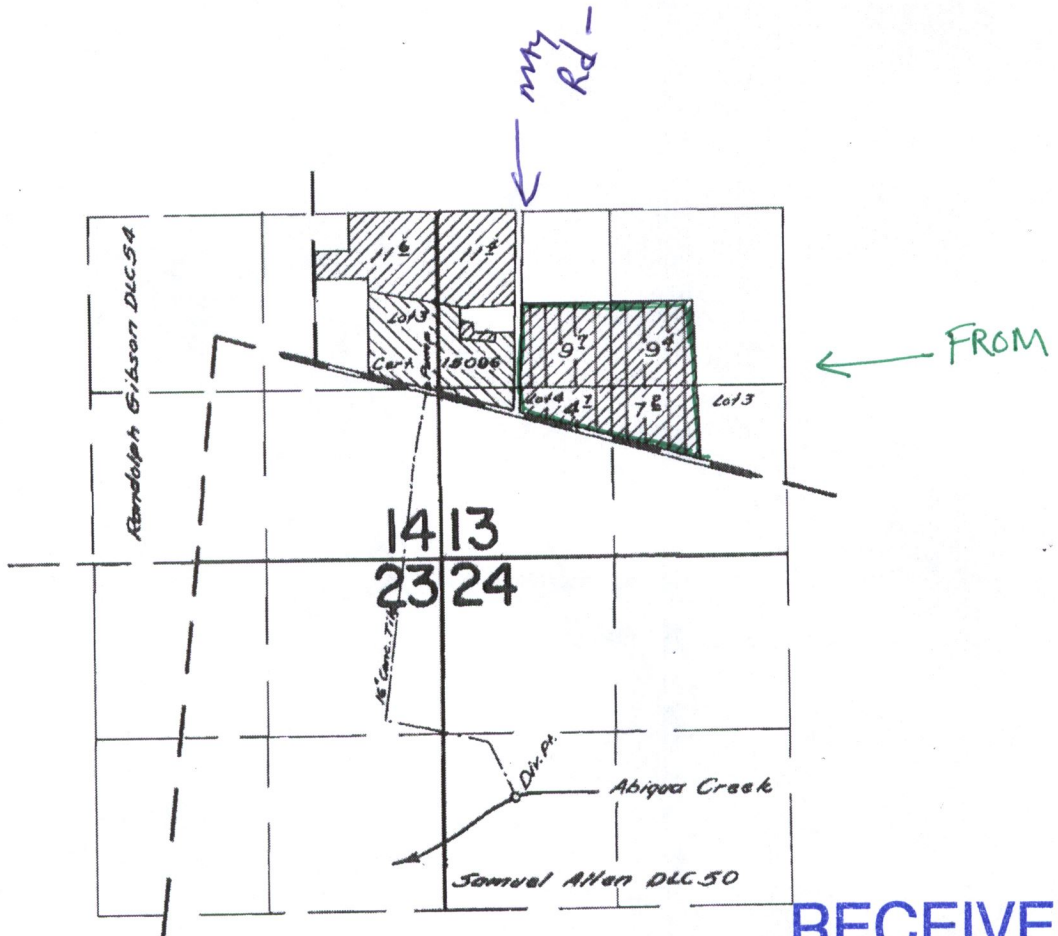

RECEIVED

JUN 26 2018

OWRD

-  From
-  No change
-  No change

FINAL PROOF SURVEY
UNDER

Application No. 33495 Permit No. 26276 Certificate 29425
IN NAME OF

MARIO RAYA

Surveyed March 29 1961, by C. J. Garcia


↑ 1" = 1320'
N


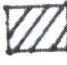
RECEIVED

JUN 26 2018

T.6S.,R.1W.,W.M.

OWRD

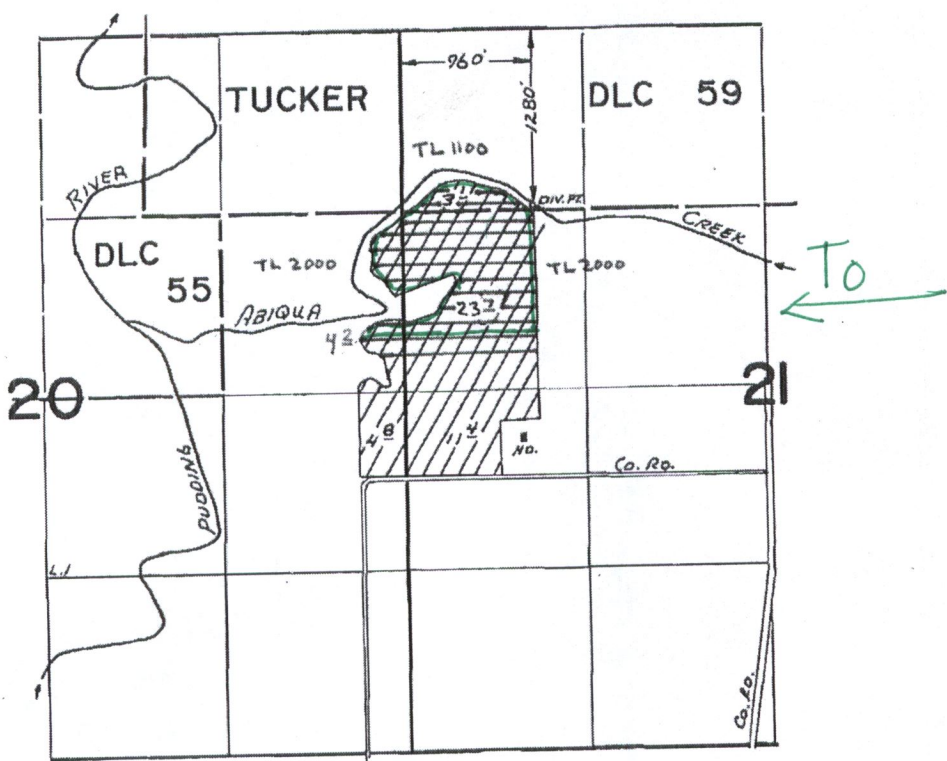

-  To
-  No change

FINAL PROOF SURVEY
UNDER

Application No. 50043 Permit No. 37618 certificate 46909
IN NAME OF

LEROY BEALS

Surveyed Aug. 11 1976, by L. Toll

↑
N 1" = 1320'