


RECEIVED

JUL 11 2018

Permanent Water Right Transfer, Kuenzi
T 6S, R 2W

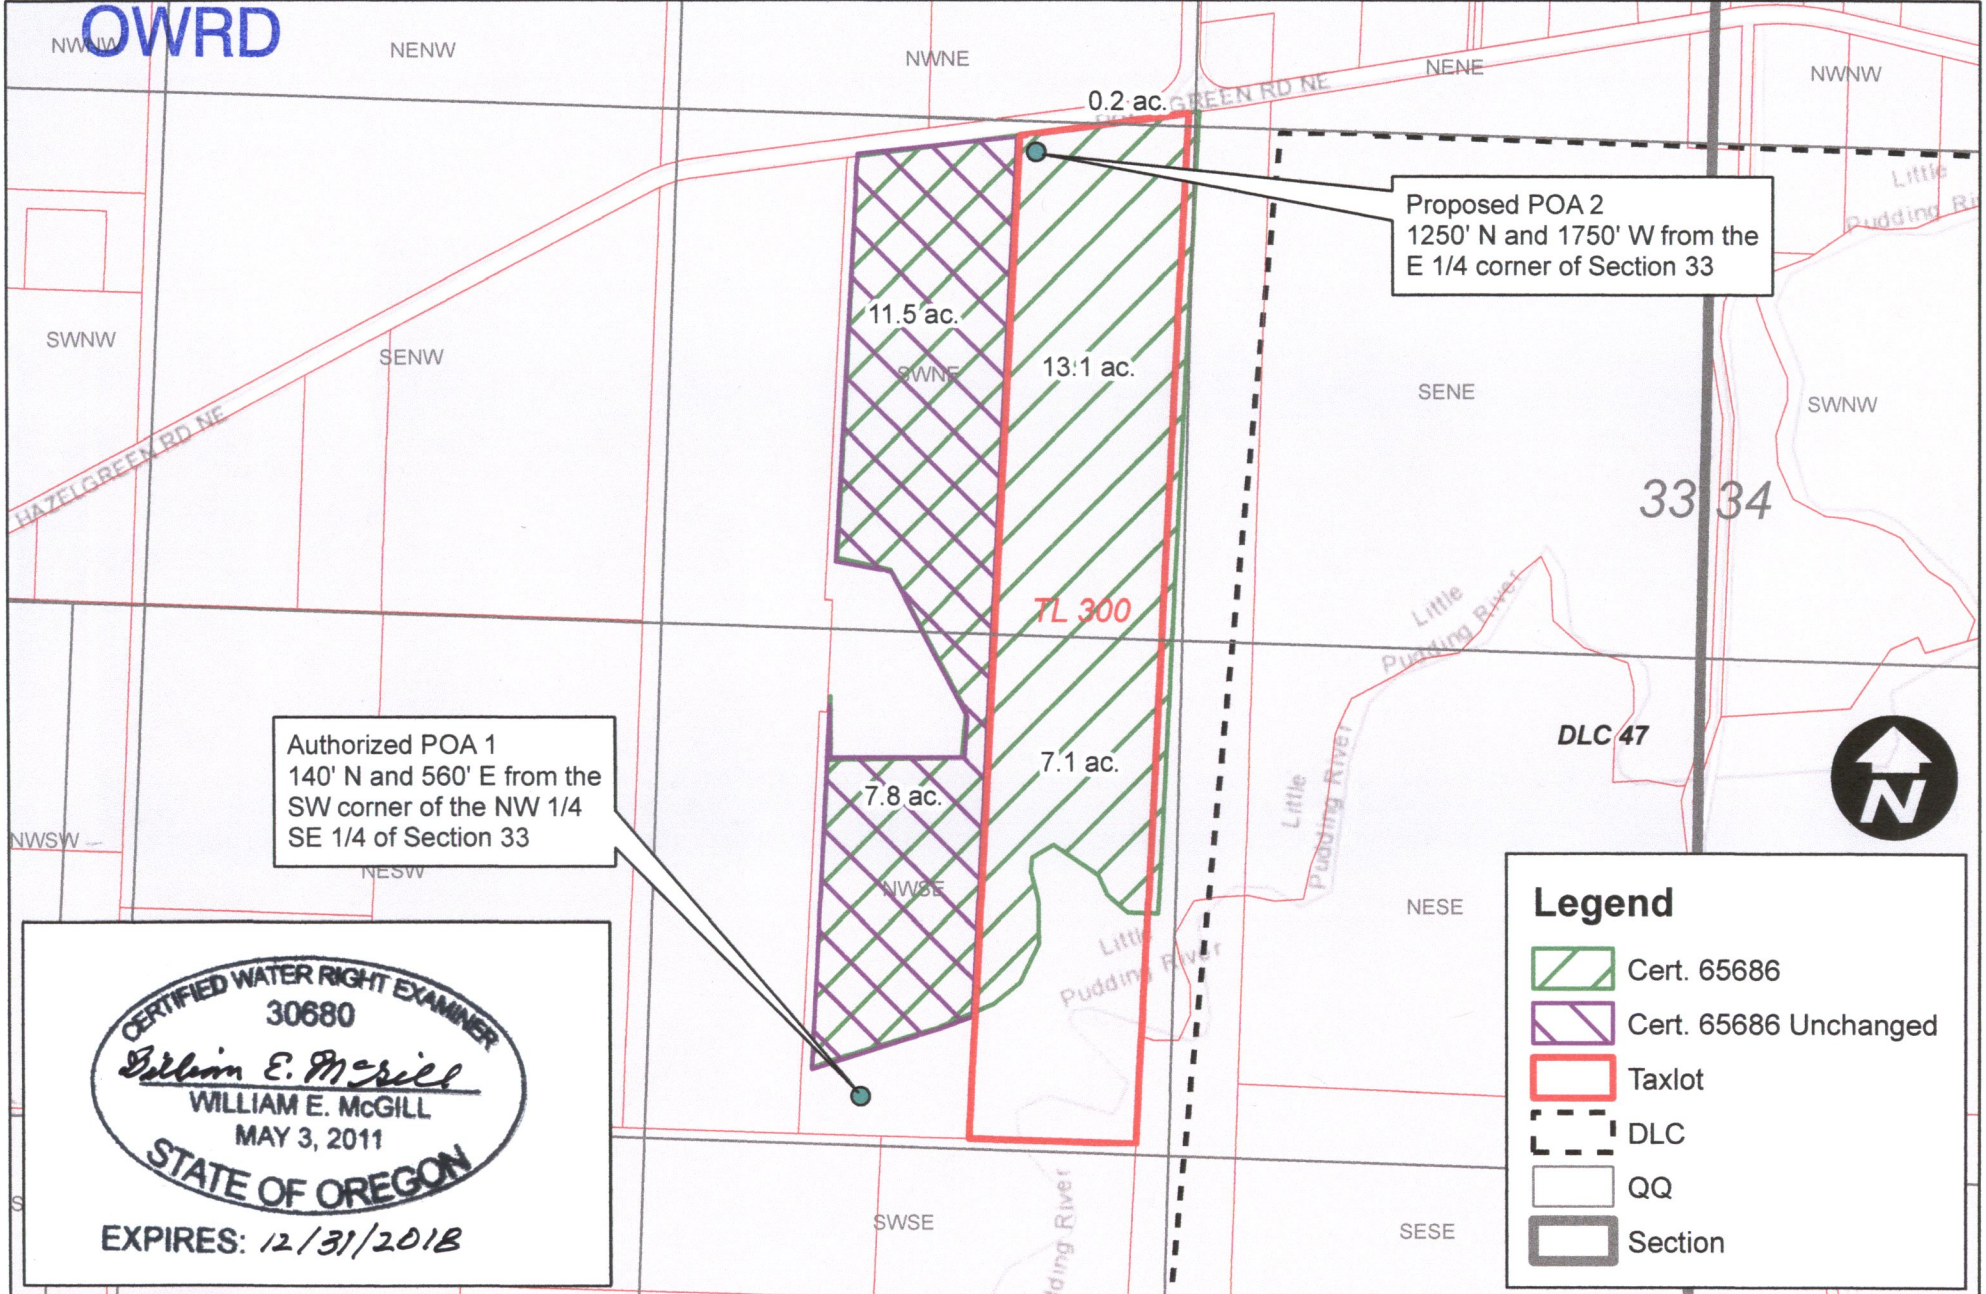

Authorized POA 1
140' N and 560' E from the
SW corner of the NW 1/4
SE 1/4 of Section 33

Proposed POA 2
1250' N and 1750' W from the
E 1/4 corner of Section 33

Legend

- Cert. 65686
- Cert. 65686 Unchanged
- Taxlot
- DLC
- QQ
- Section

CERTIFIED WATER RIGHT EXAMINER
30680
William E. McGill
WILLIAM E. MCGILL
MAY 3, 2011
STATE OF OREGON
EXPIRES: 12/31/2018