

Oregon Water Resources Department  
Water Rights Mapping Tool

T28S R4W SEC 34

463 Slide Creek Rd

TAX ID 01000



Search

Identify Non-Water Right Features

Distance: 1 Feet

General Rules Hydrography

#2 POD Existing to be used as temp. drought transfer of partial rights to Cert # 59100. Cert # 2877 transfer 3acres temp. drought right of its 8acres.

- Tax Lots
- Layers
- Tools

POD

POU

All Fields Search...

Div #1: 50' N. and 460' W } From S 1/4 cor. Sec 34  
 Div #2: 420' N. and 1020' W }

#	ID (select)	WRIS	Zoom	Water Right	Water Type	First Name	Last Name	Company	Use Desc.
1	9620	<a href="#">(Details)</a> <a href="#">Map WR</a>		Cert:2877 OR * IR	SW	MRS MARY	PUCKETT		IRRIGATION

Record ID: 9620

2978

Temp Drought Transfer

RECEIVED

JUL 19 2018


OWRD

RECEIVED

JUL 27 1979

WATER RESOURCES DEPT  
SALEM, OREGON

T. 28 S. R. 4 W.

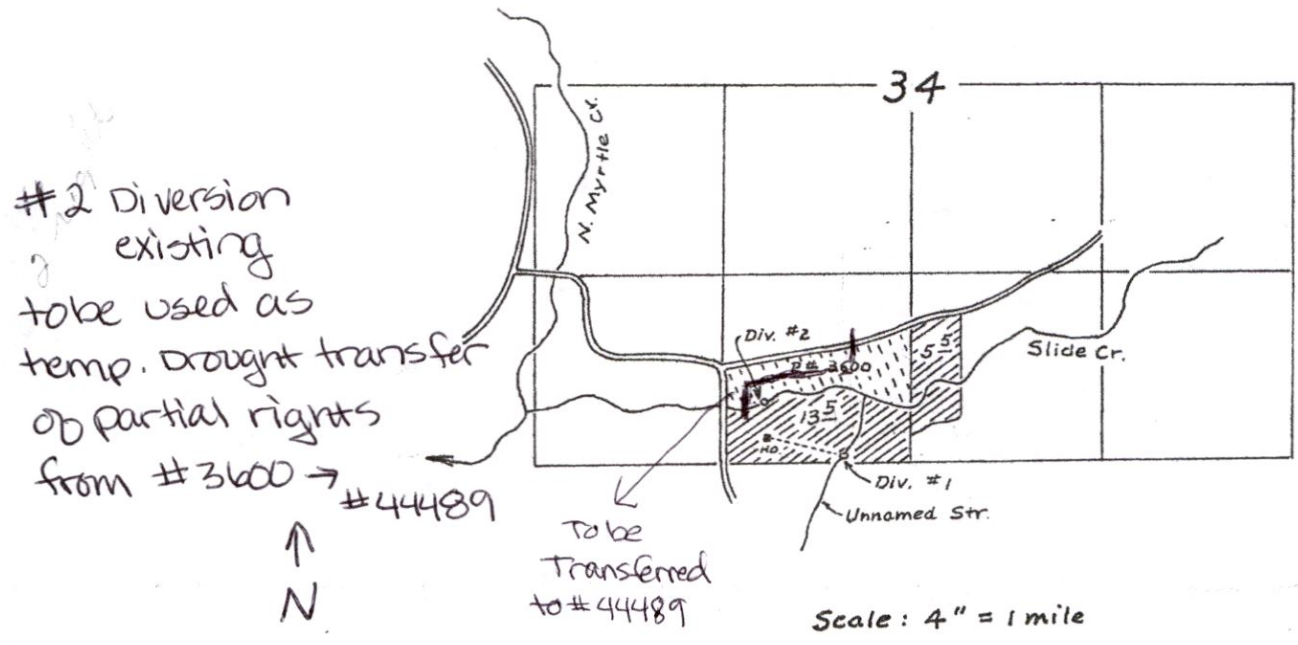

Div. #1 : 50' N. and 460' W. } From  $5\frac{1}{4}$  Cor. Sec 34  
 Div. #2 : 420' N. and 1020' W. }

Application No. 58965  
 Permit No. 44489

T 12978

RECEIVED

JUL 19 2018


OWRD

EX#C

# Temp Transfer Application Map

T.28S.,R.4W.,W.M. SEC 34 X - POD #2

Legend

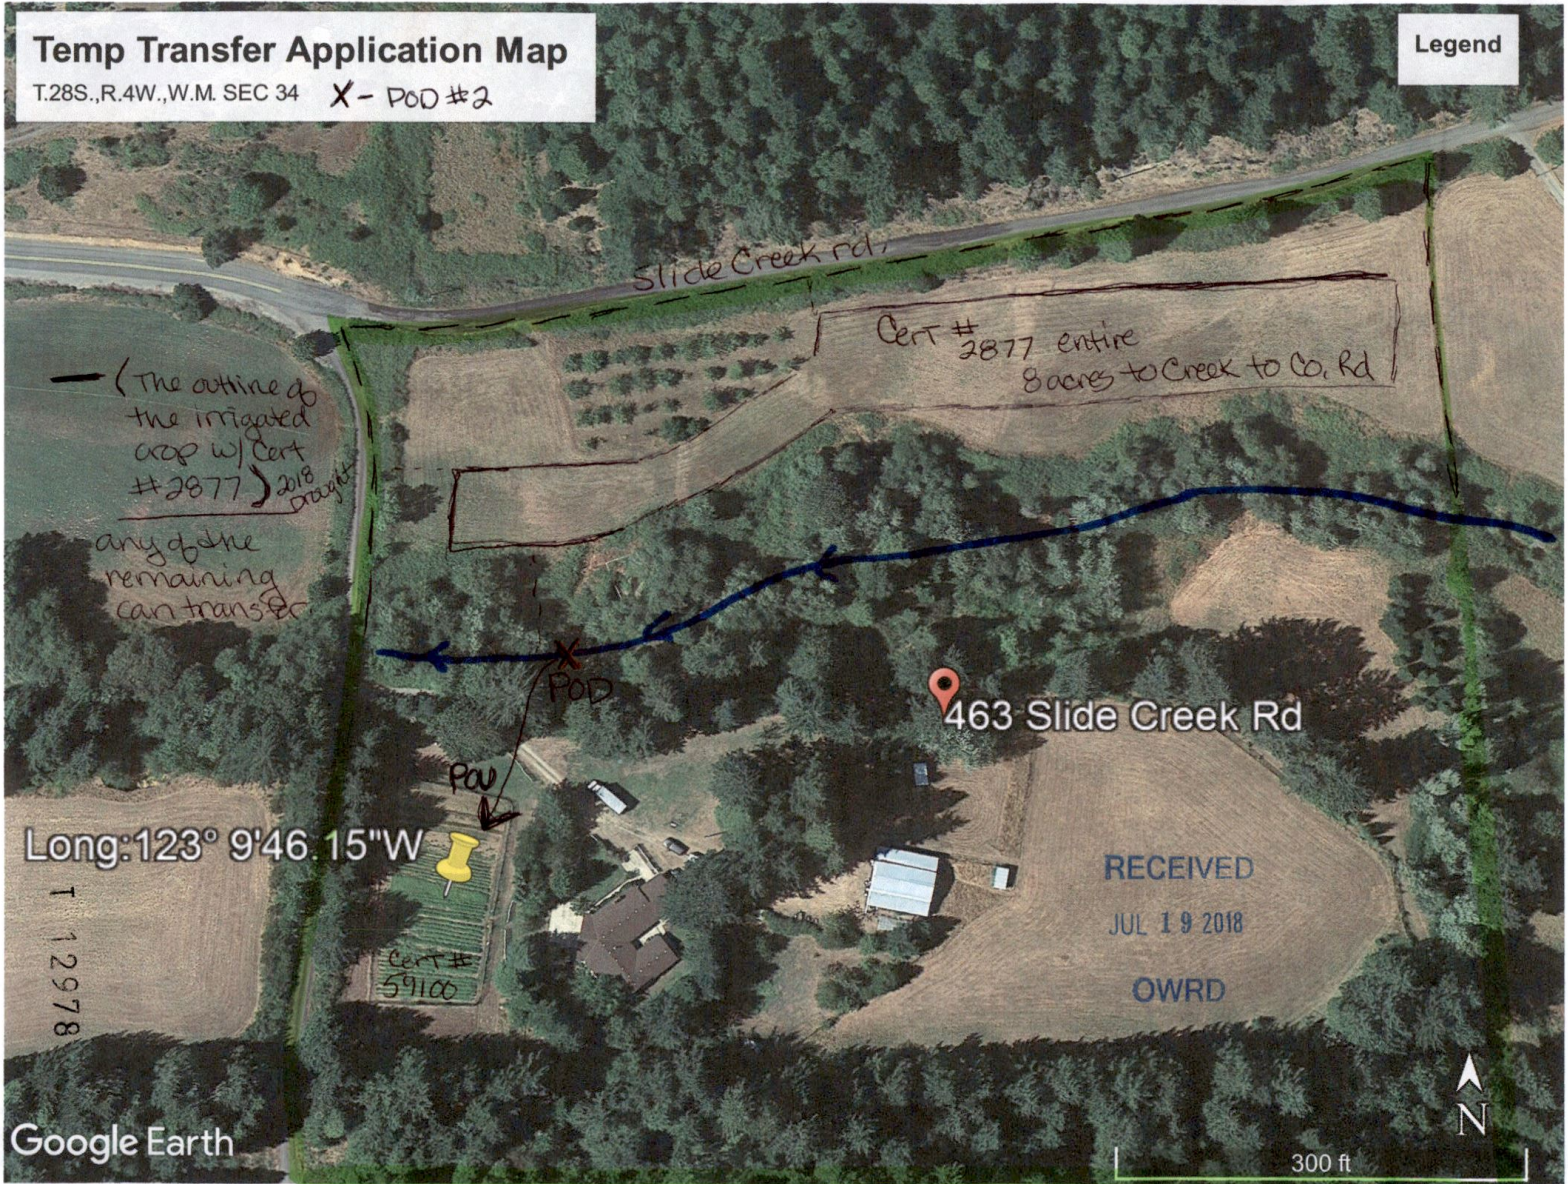

Google Earth

2016