








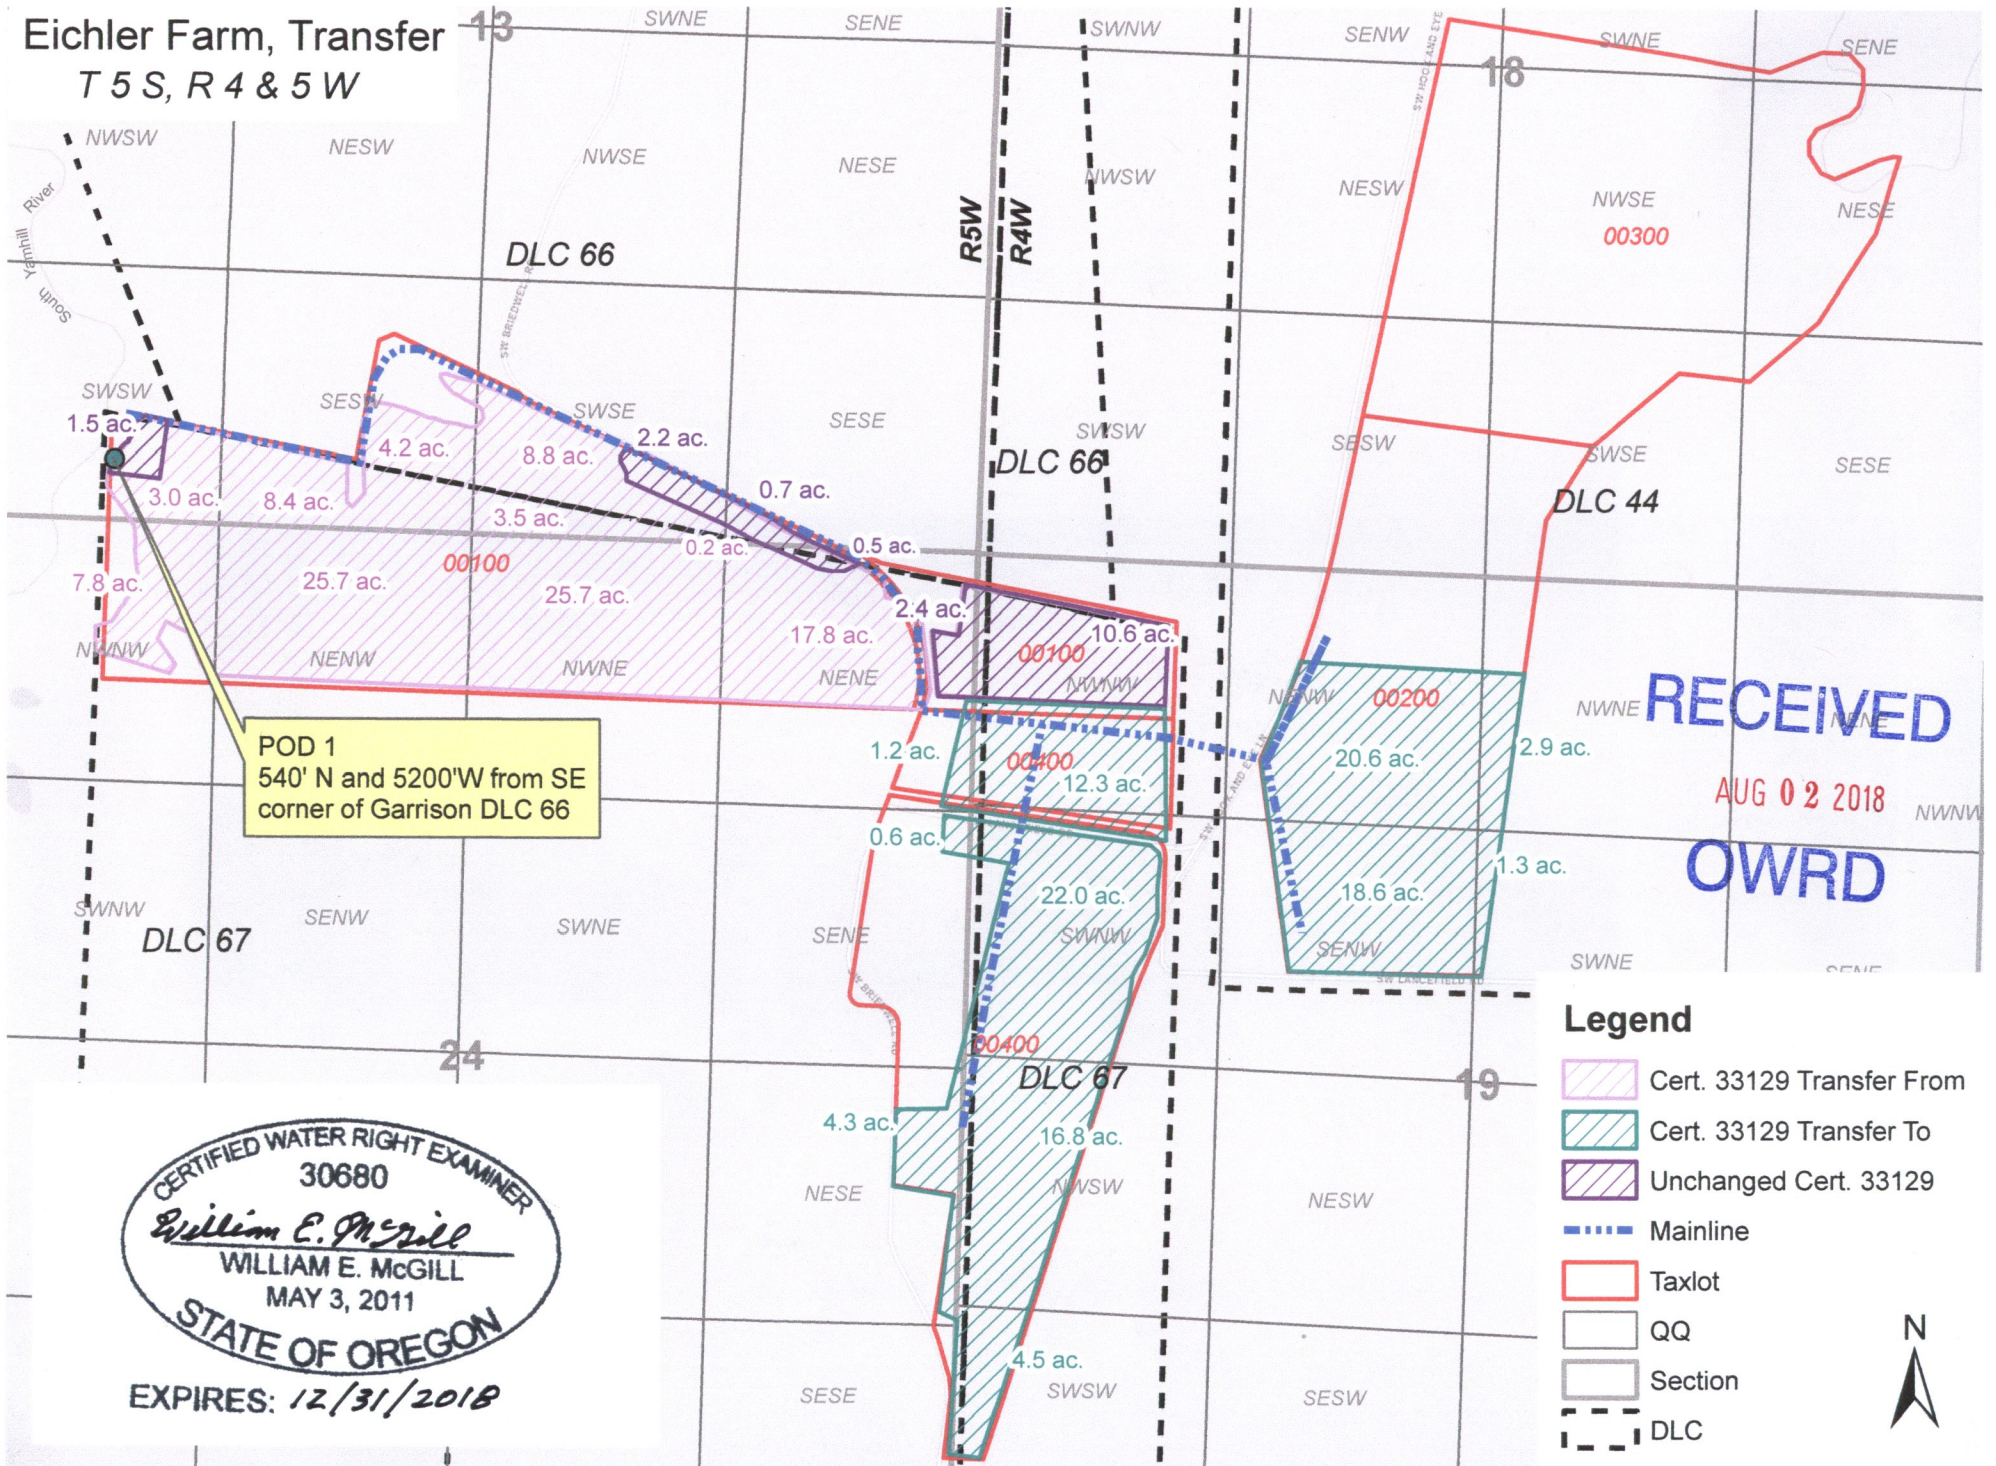

Eichler Farm, Transfer
T 5 S, R 4 & 5 W



Legend

-  Cert. 33129 Transfer From
-  Cert. 33129 Transfer To
-  Unchanged Cert. 33129
-  Mainline
-  Taxlot
-  QQ
-  Section
-  DLC