


# T.1S. R.10W. Sec. 25 & 26, W.M.

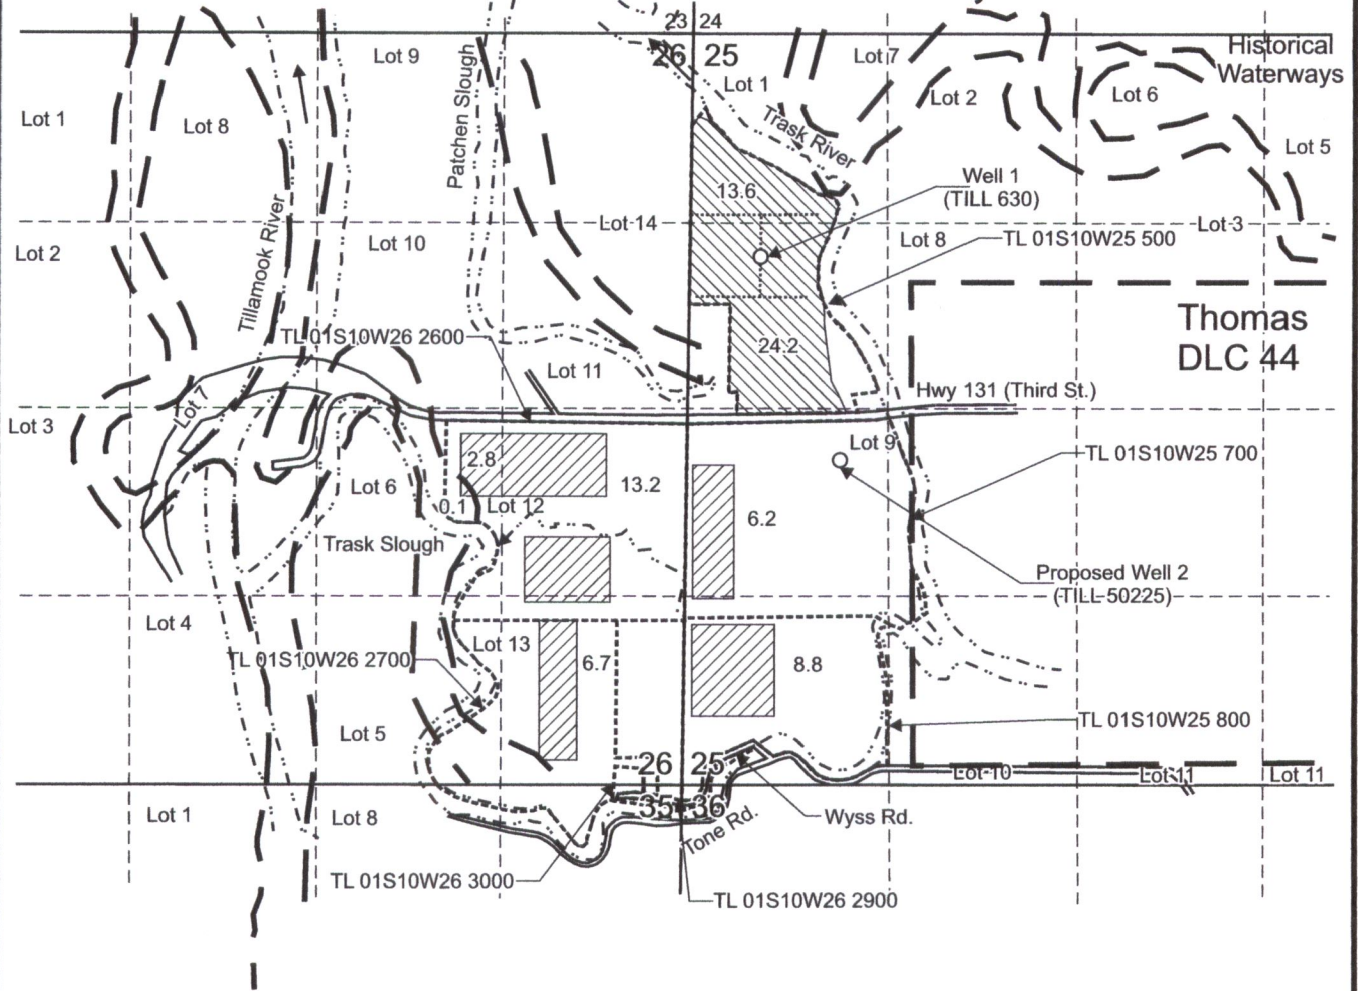

Authorized Well 1 (TILL 630) is located 240 feet south and 490 feet east from the SW corner, NWNW, Section 25.

Proposed Well 2 (TILL 50225) is located 320 feet south and 1,075 feet east from the W1/4 corner, Section 25.

 "From" area (37.8 Acres) irrigated under GR-3593, priority date October 31, 1954.

 "To" area (37.8 Acres) irrigated under GR-3593, priority date October 31, 1954.

----- Tax lot boundary

— . — Donation Land Claim boundary

..... Water main line

Scale: 1" = 1,320'



This map was prepared for the purpose of identifying the location of a water right only and is not intended to provide legal dimensions or location of property ownership lines.

RECEIVED  
JUL 30 2018  
OWRD



Pacific Hydro-Geology Inc.

07/2018

Groundwater Registration  
Modification Map GR-3593

Jenck Farms, LLC c/o Joe Jenck  
T.1S. R.10W. Sec. 25 & 26, W.M.