
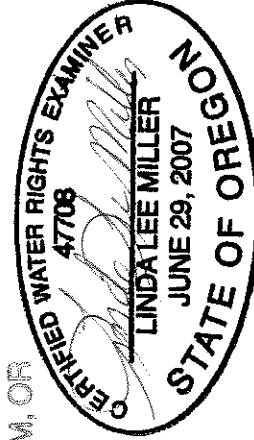



T16S, R12E, SECTION 31
DESCHUTES COUNTY, OREGON

POINT OF DIVERSION

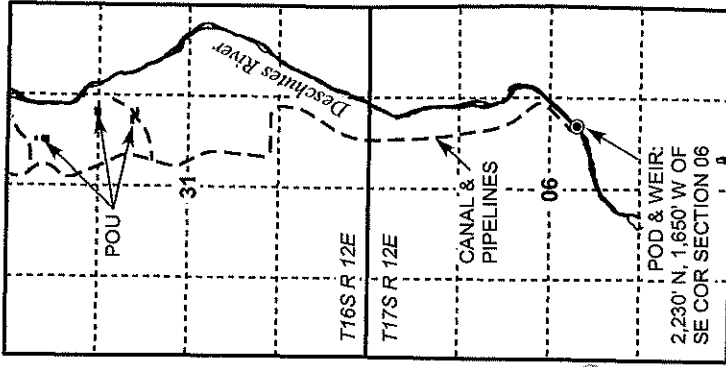

RENEWAL DATE 12/31/2018

WATER RIGHT SERVICES, LLC
 PO BOX 1830, BEND, OR 97709
 CCB# 197121 www.oregonwater.us
 541-389-2837 JOHNSHORT@USA.COM

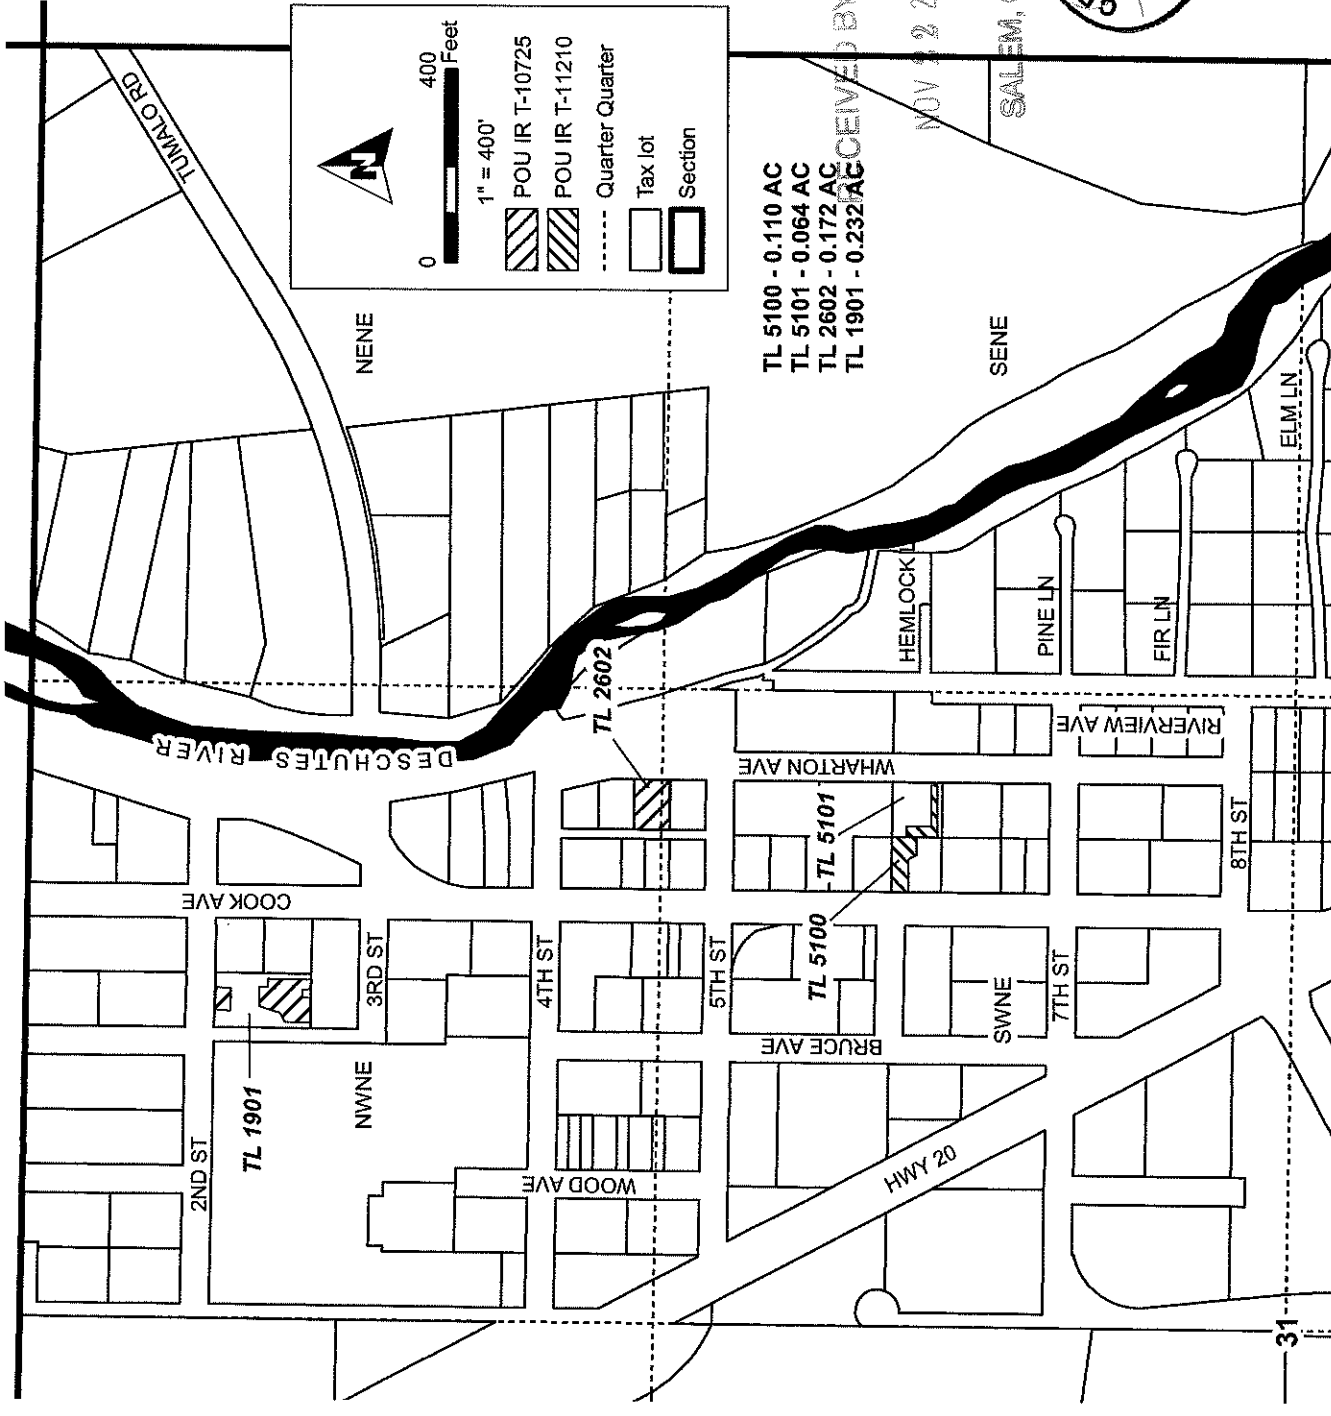

RECEIVED BY OWRD
 NOV 22 2017
 SALEM, OR

NOTE: THIS MAP IS NOT INTENDED TO
 PROVIDE LEGAL DIMENSIONS OR LOCATIONS
 OF PROPERTY OWNERSHIP LINES.

NOVEMBER 16, 2017

CLAIM OF BENEFICIAL USE
 Tumalo Town District Improvement Co.