


T14S R14E, SECTIONS 15 & 22, WM










CROOK COUNTY, OREGON

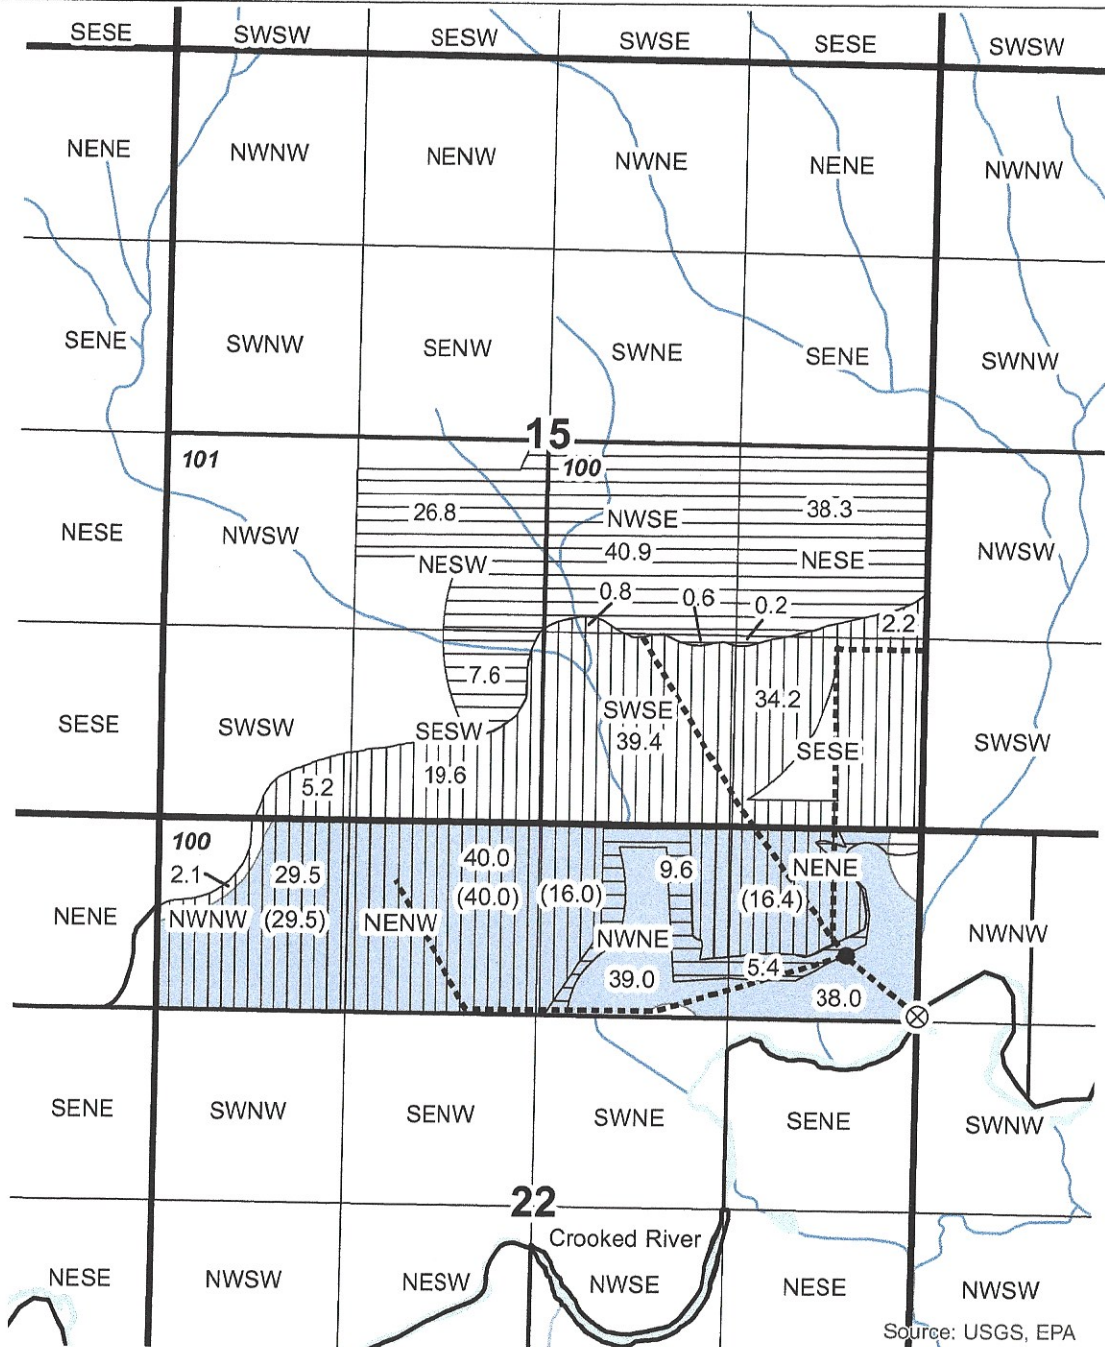

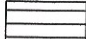0 1,320 Feet

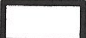1" = 1,320'



-  Cert: 83850 BOR Remaining after T-11023
-  Cert: 87331 RR IR & IS 1946
-  Cert: 2734 OR IR 1911
-  Sections
-  Tax Lots
-  QQ
-  Diversion 47A
-  Pipelines
-  Booster Pumps



RENEWAL DATE 12/31/2018

**TRANSFER "FROM" MAP
Butler Ranch, Inc.**

Transfers T-11347 & T-11373

NOTE: THIS MAP IS NOT INTENDED TO
PROVIDE LEGAL DIMENSIONS OR LOCATIONS
OF PROPERTY OWNERSHIP LINES.

MARCH 31, 2018

WATER RIGHT SERVICES, LLC

PO BOX 1830, BEND, OR 97709

CCB# 197121 www.oregonwater.us

541-389-2837

johnshort@usa.com

Source: USGS, EPA


T14S R14E, SECTIONS 15 & 22, WM








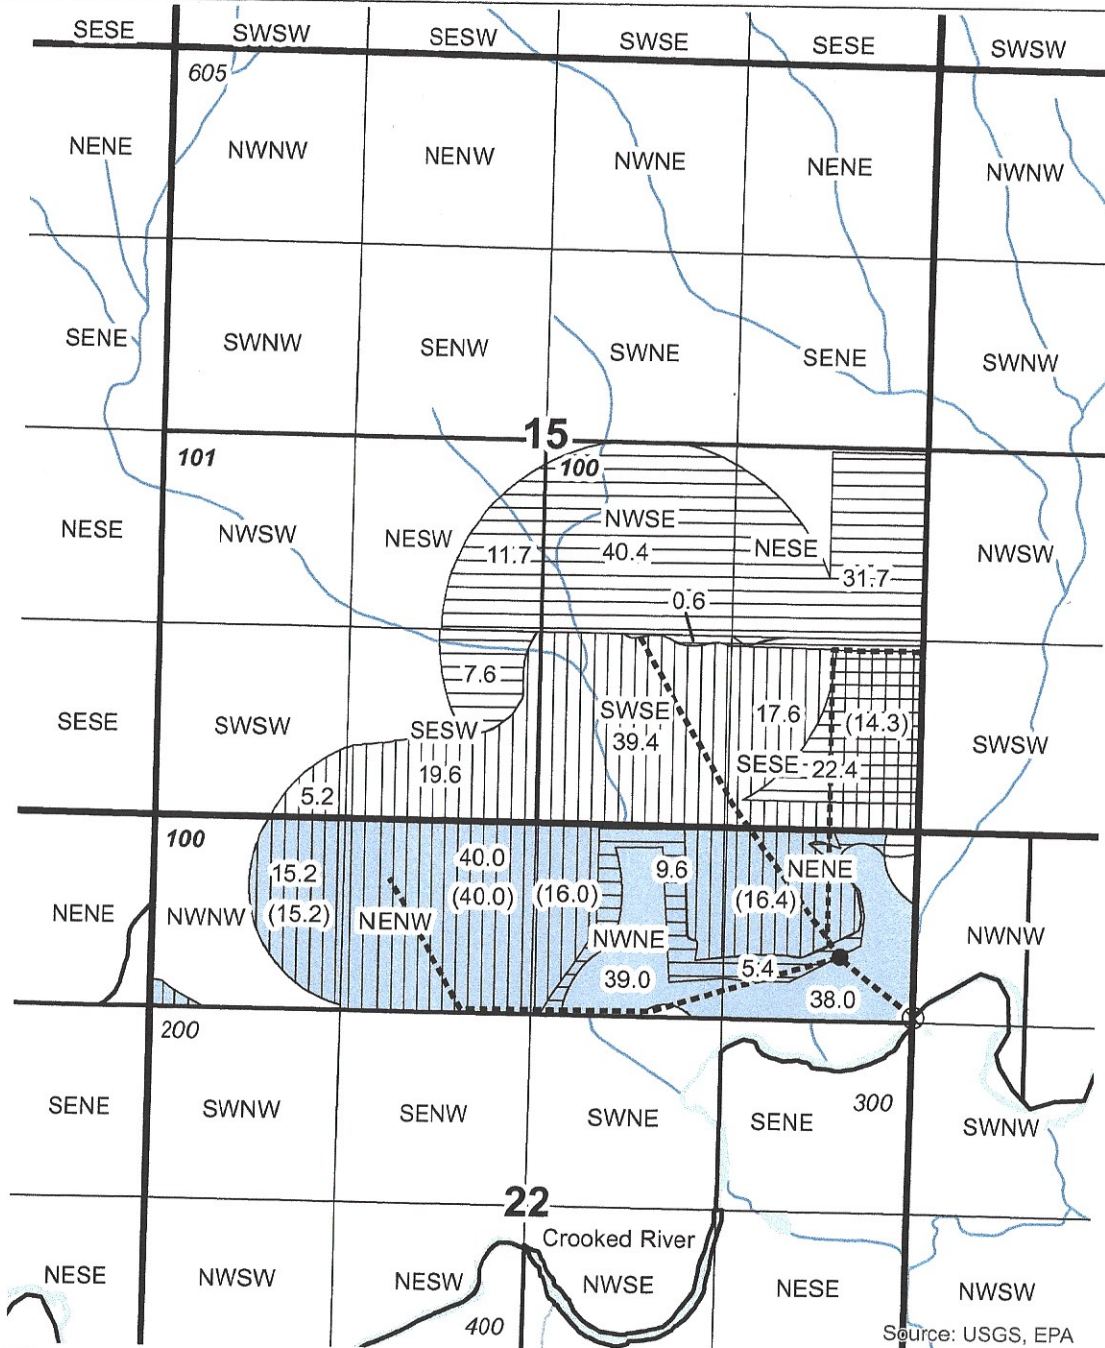

CROOK COUNTY, OREGON

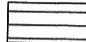

0 1,320 Feet

1" = 1,320'



-  Cert: 83850 BOR IR 1914
-  Cert: 87331 IR & IS 1946
-  Cert: 2734 IR 1911
-  Sections
-  Tax Lots
-  QQ
-  Diversion 47A
-  Pipelines
-  Booster Pumps



RENEWAL DATE 12/31/2018

TRANSFER "TO" MAP
Butler Ranch, Inc.

Transfers T-11347 & T-11373

NOTE: THIS MAP IS NOT INTENDED TO
PROVIDE LEGAL DIMENSIONS OR LOCATIONS
OF PROPERTY OWNERSHIP LINES.

MARCH 31, 2018

WATER RIGHT SERVICES, LLC

PO BOX 1830, BEND, OR 97709

CCB# 197121 www.oregonwater.us


541-389-2837






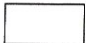



johnshort@usa.com

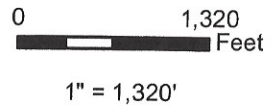
Source: USGS, EPA

**T14S R14E,
SECTIONS 15 & 22, WM**

CROOK COUNTY, OREGON



-  Cert: 87331 IF OFF T-12795 (20.0 ac)
-  Cert: 87331 IR Instream T-11347 1946 (1.7 ac)
-  Cert: 2734 IR Instream 1911 & Cert: 87331 IS OFF (14.3 ac) T-11347
-  Sections
-  Tax Lots
-  QQ
-  Diversion 47A
-  Pipelines
-  Booster Pumps

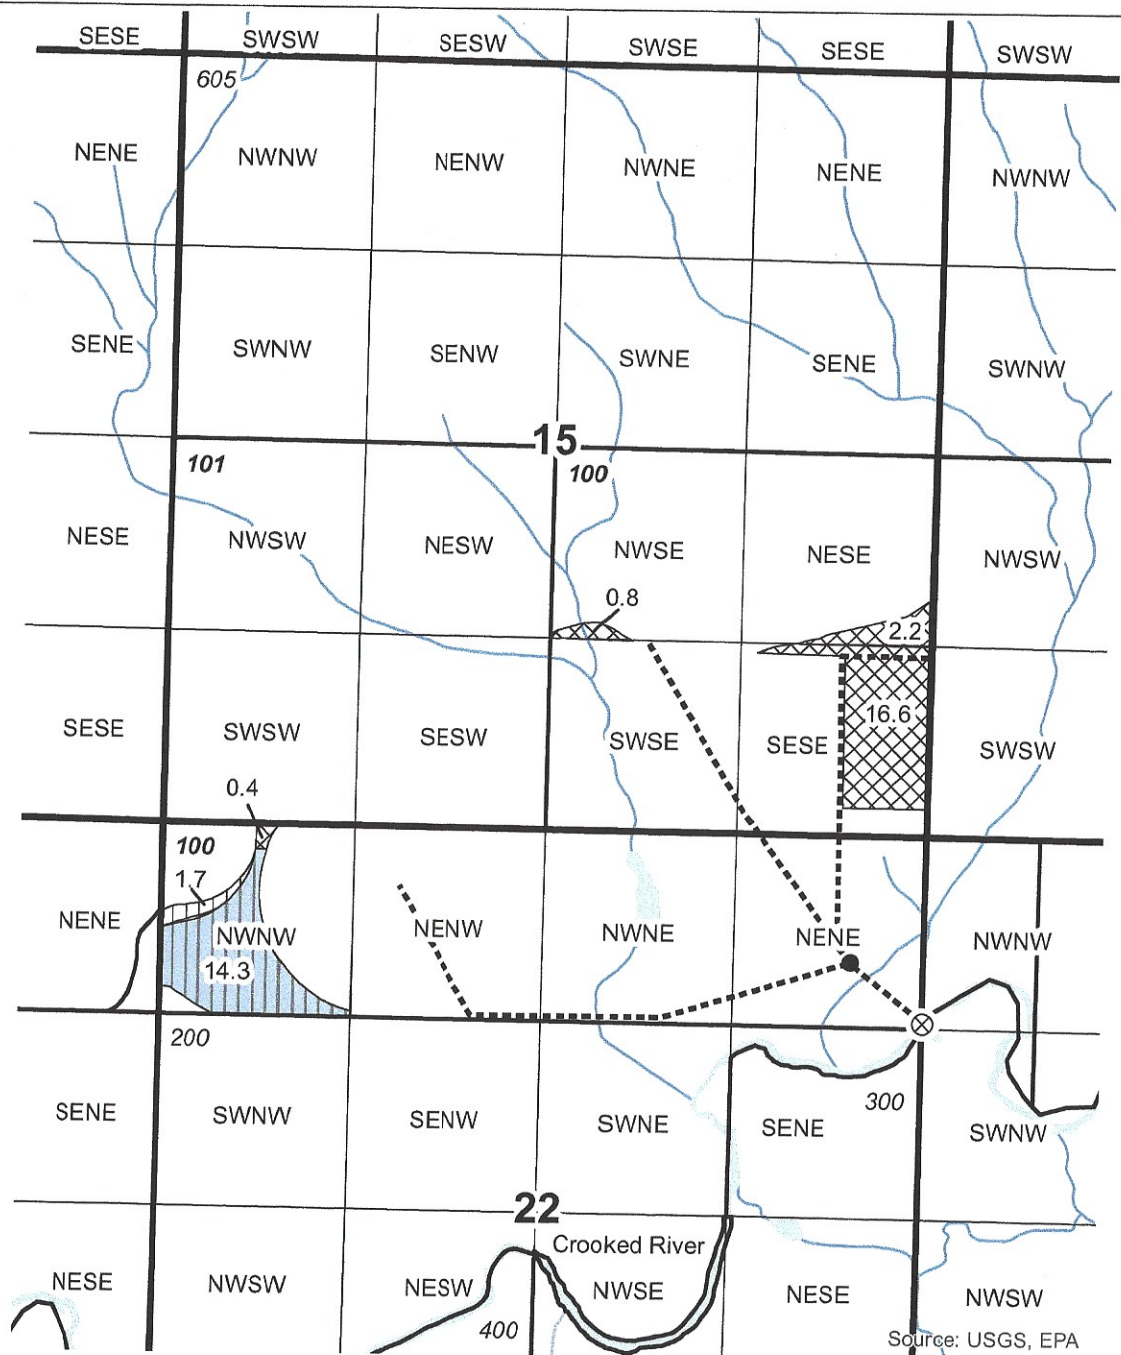

RENEWAL DATE 12/31/2018

**TRANSFER IDENTIFIER MAP
Butler Ranch, Inc.**

Transfers T-11347 & T-11373

NOTE: THIS MAP IS NOT INTENDED TO
PROVIDE LEGAL DIMENSIONS OR LOCATIONS
OF PROPERTY OWNERSHIP LINES.

MARCH 31, 2018

WATER RIGHT SERVICES, LLC

PO BOX 1830, BEND, OR 97709
CCB# 197121 www.oregonwater.us
541-389-2837 johnshort@usa.com