



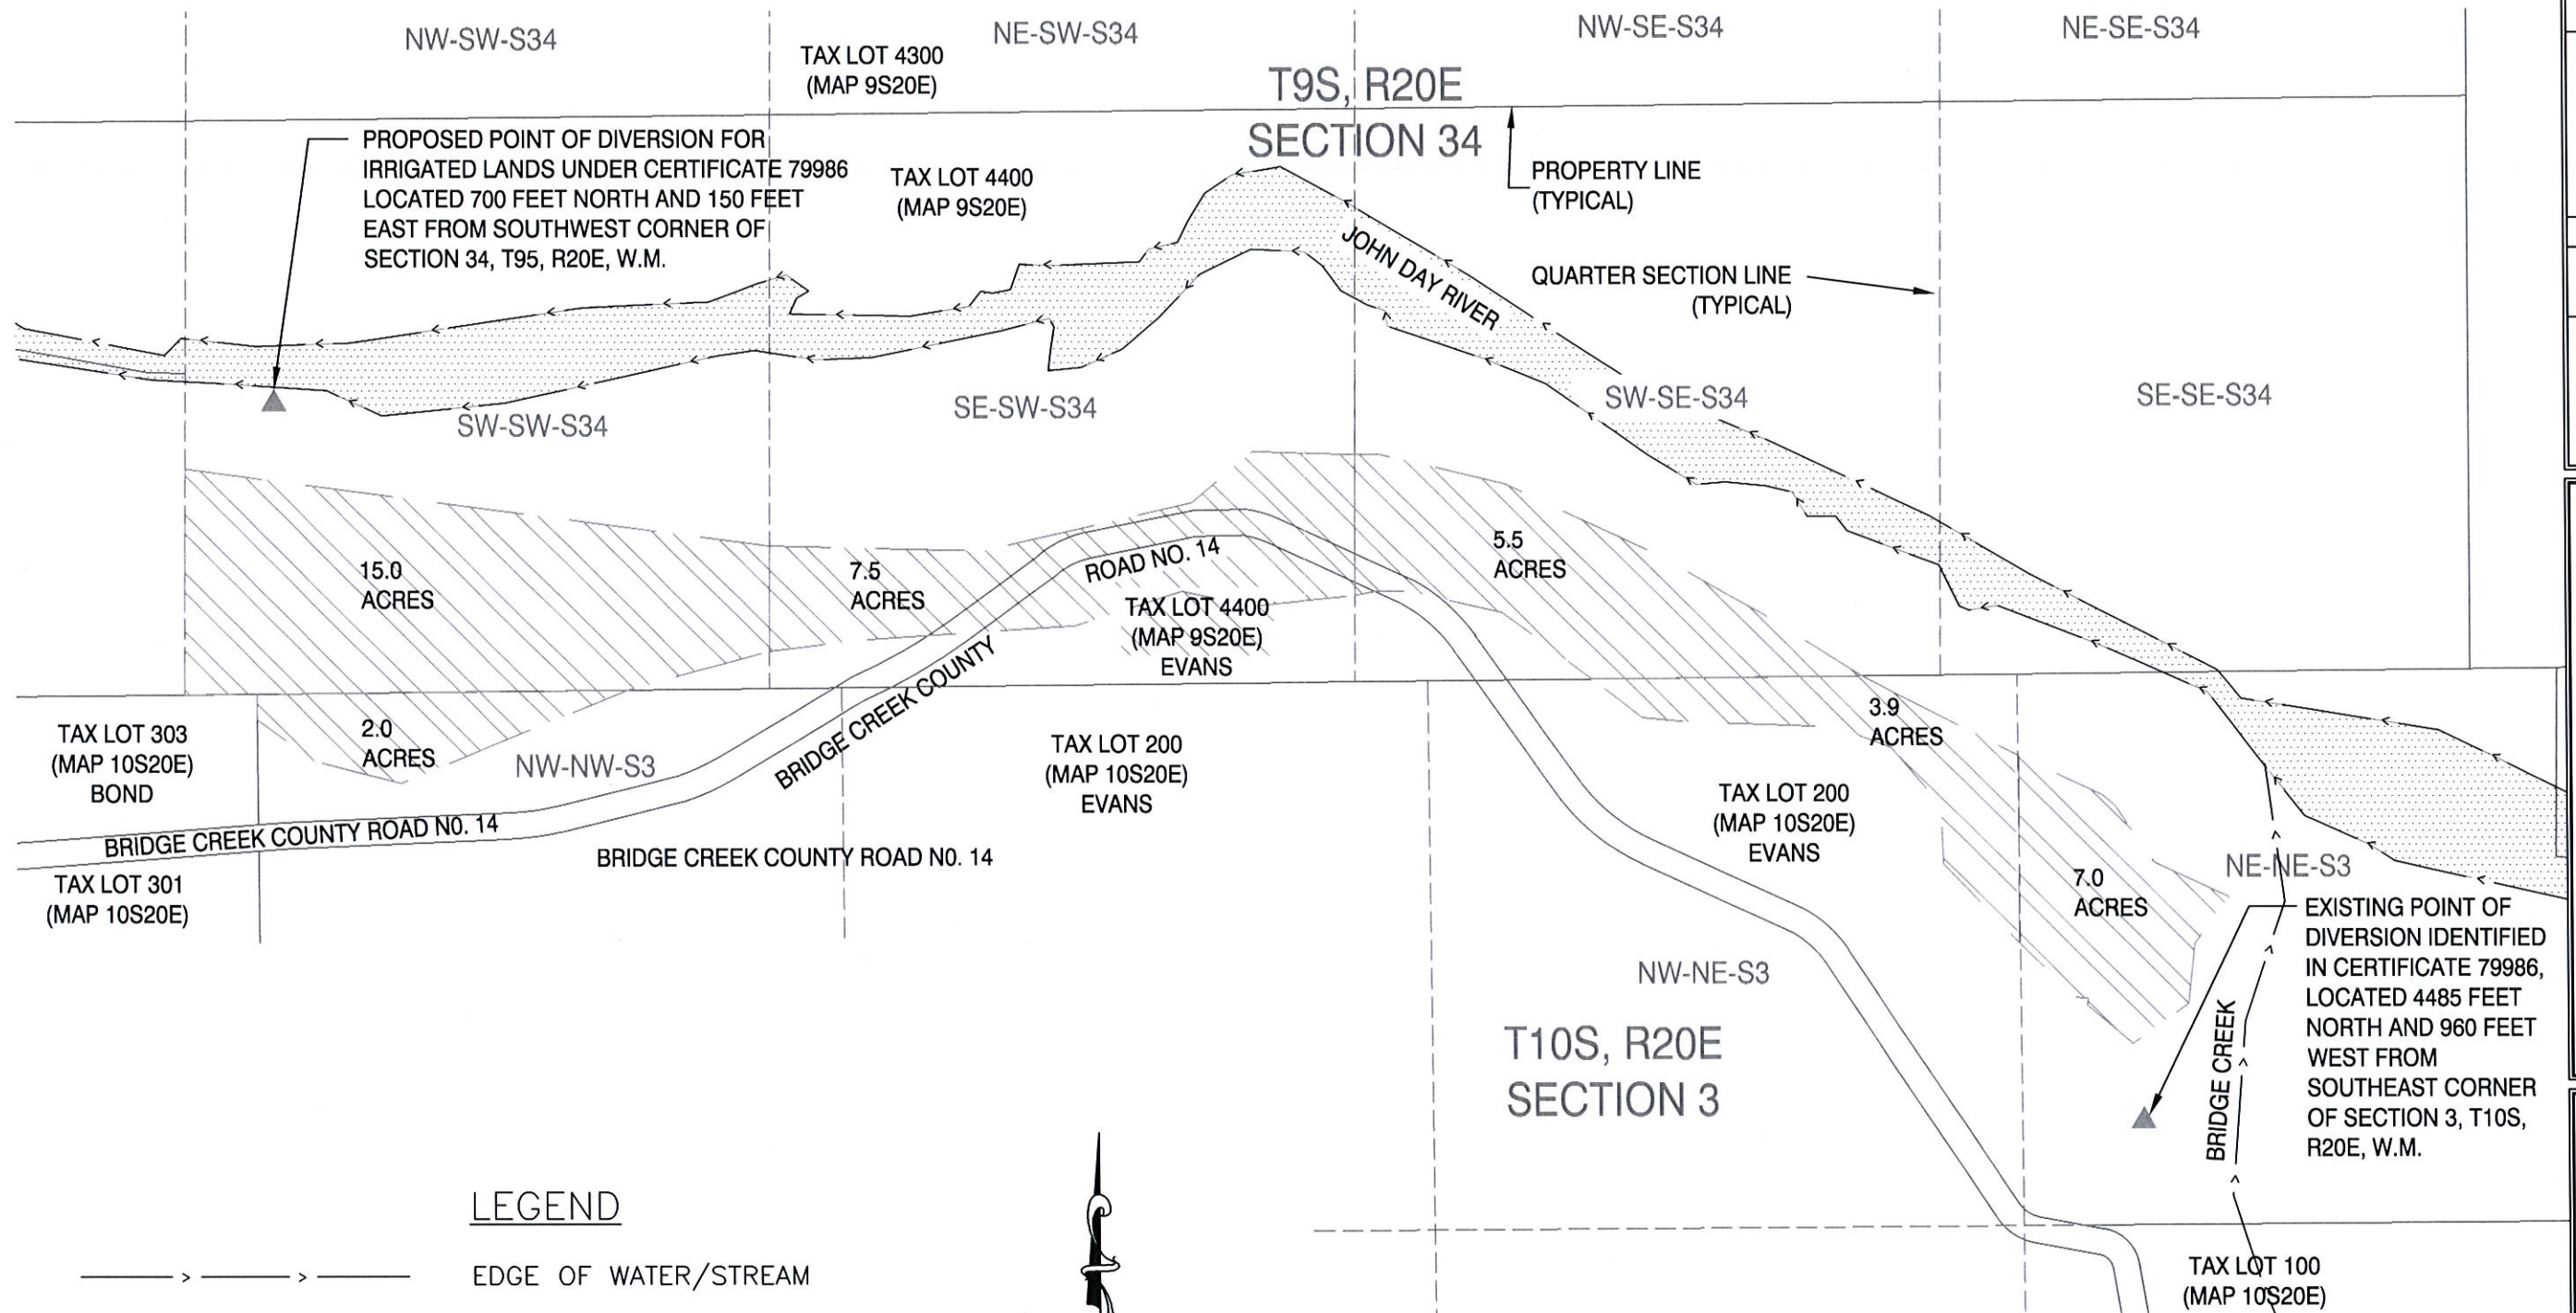

LEGEND

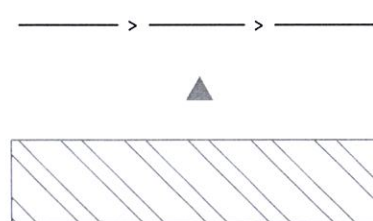

EDGE OF WATER/STREAM

POINT OF DIVERSION

LANDS IRRIGATED UNDER
CERTIFICATE 79986
(PRIORITY DATE 1865)

SCALE: 1" = 400'



DRAWING STATUS:	DATE:	REVISION:	No.
POD TRANSFER	8/18/14		1
POD/POU TRANSFER	12/8/14		2
POD/POU TRANSFER	7/12/17		3
			4
			5
			6
			7
			8
			9
			10

ResourceSpecialists INC.

P.O. BOX 25
BEND, OR 97709
(541) 771-6911
gabe@rsiengr.com

PROJECT: POD TRANSFER


PROJECT LOCATION: WHEELER COUNTY, OREGON

CLIENT: WHEELER SWCD

DRAWN BY: AMS

SHEET TITLE: POD/POU EXISTING

DRAWING: WR1.1

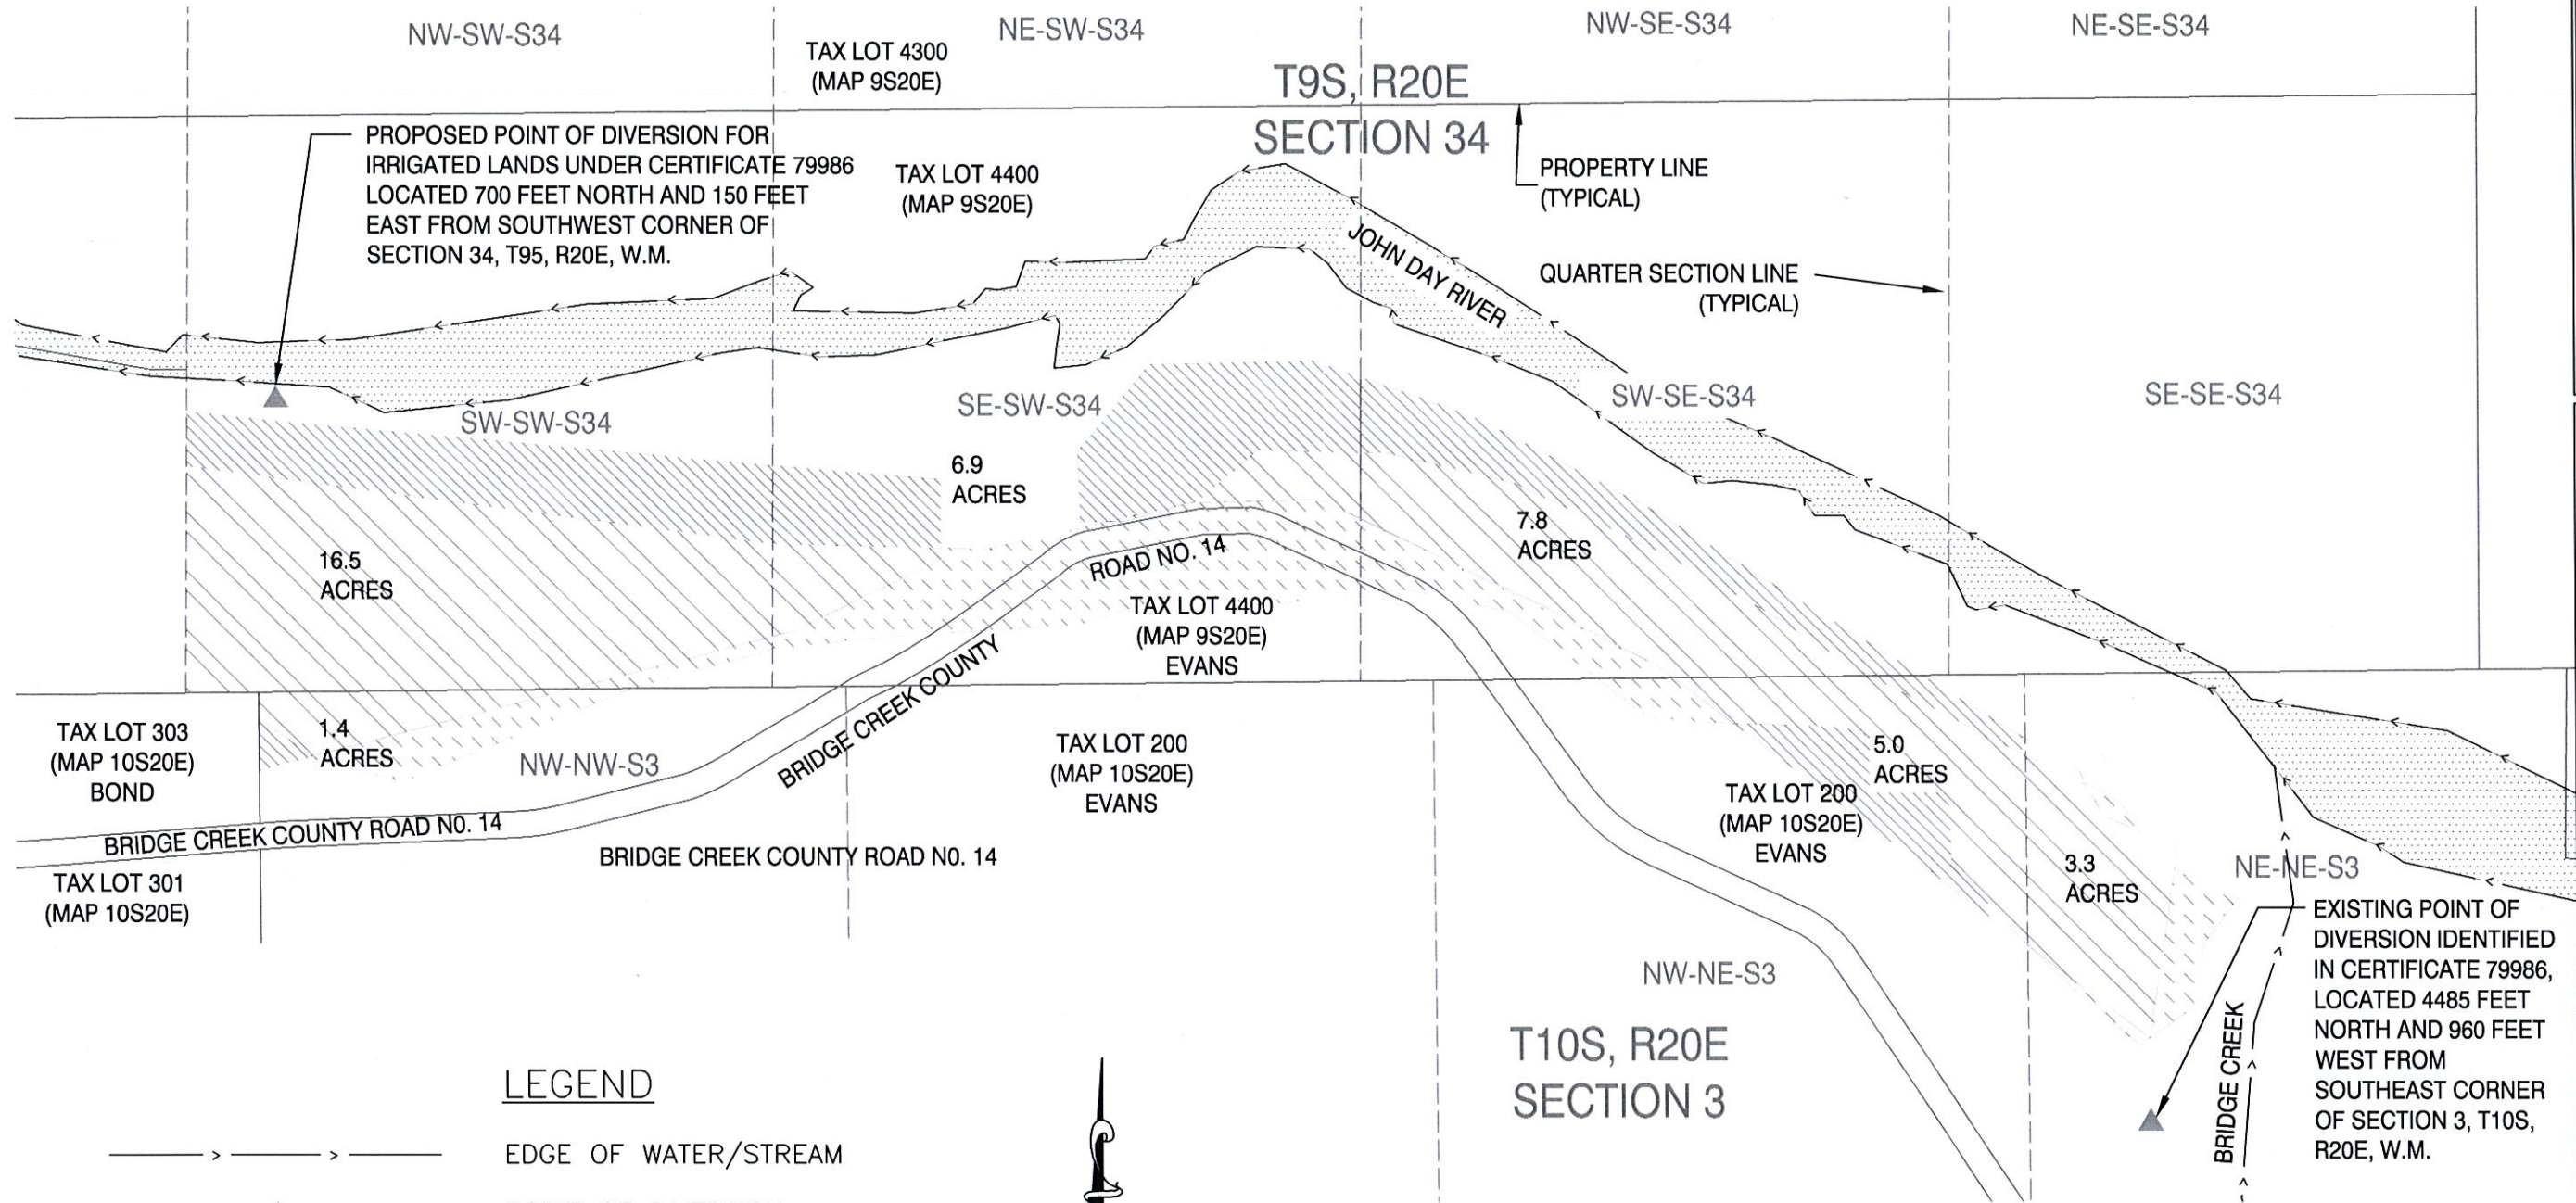

LEGEND

- EDGE OF WATER/STREAM
- POINT OF DIVERSION
- 79986 LANDS LEFT UNCHANGED
- 79986 LANDS PROPOSED
- 79986 LANDS REMOVED

SCALE: 1" = 400'



DRAWING STATUS:	DATE:	REVISION:	DATE:
POD TRANSFER	8/18/14	No. 1	
POD/POU TRANSFER	12/8/14	No. 2	
POD/POU TRANSFER	7/12/17	No. 3	
		No. 4	
		No. 5	
		No. 6	
		No. 7	
		No. 8	

ResourceSpecialists INC.
P.O. BOX 25
BEND, OR 97709
(541) 771-6911
gabe@rsiengr.com

PROJECT: **POD TRANSFER**
PROJECT LOCATION: **WHEELER COUNTY, OREGON**
CLIENT: **WHEELER SWCD**

DRAWN BY: AMS
SHEET TITLE: **POD/POU PROPOSED**
DRAWING: **WR1.2**