



Swalley Irrigation District

2018 District Transfer Application Change of Use Map

Nursery to Irrigation

Certificates: 74145

for Bend Park and Recreation District

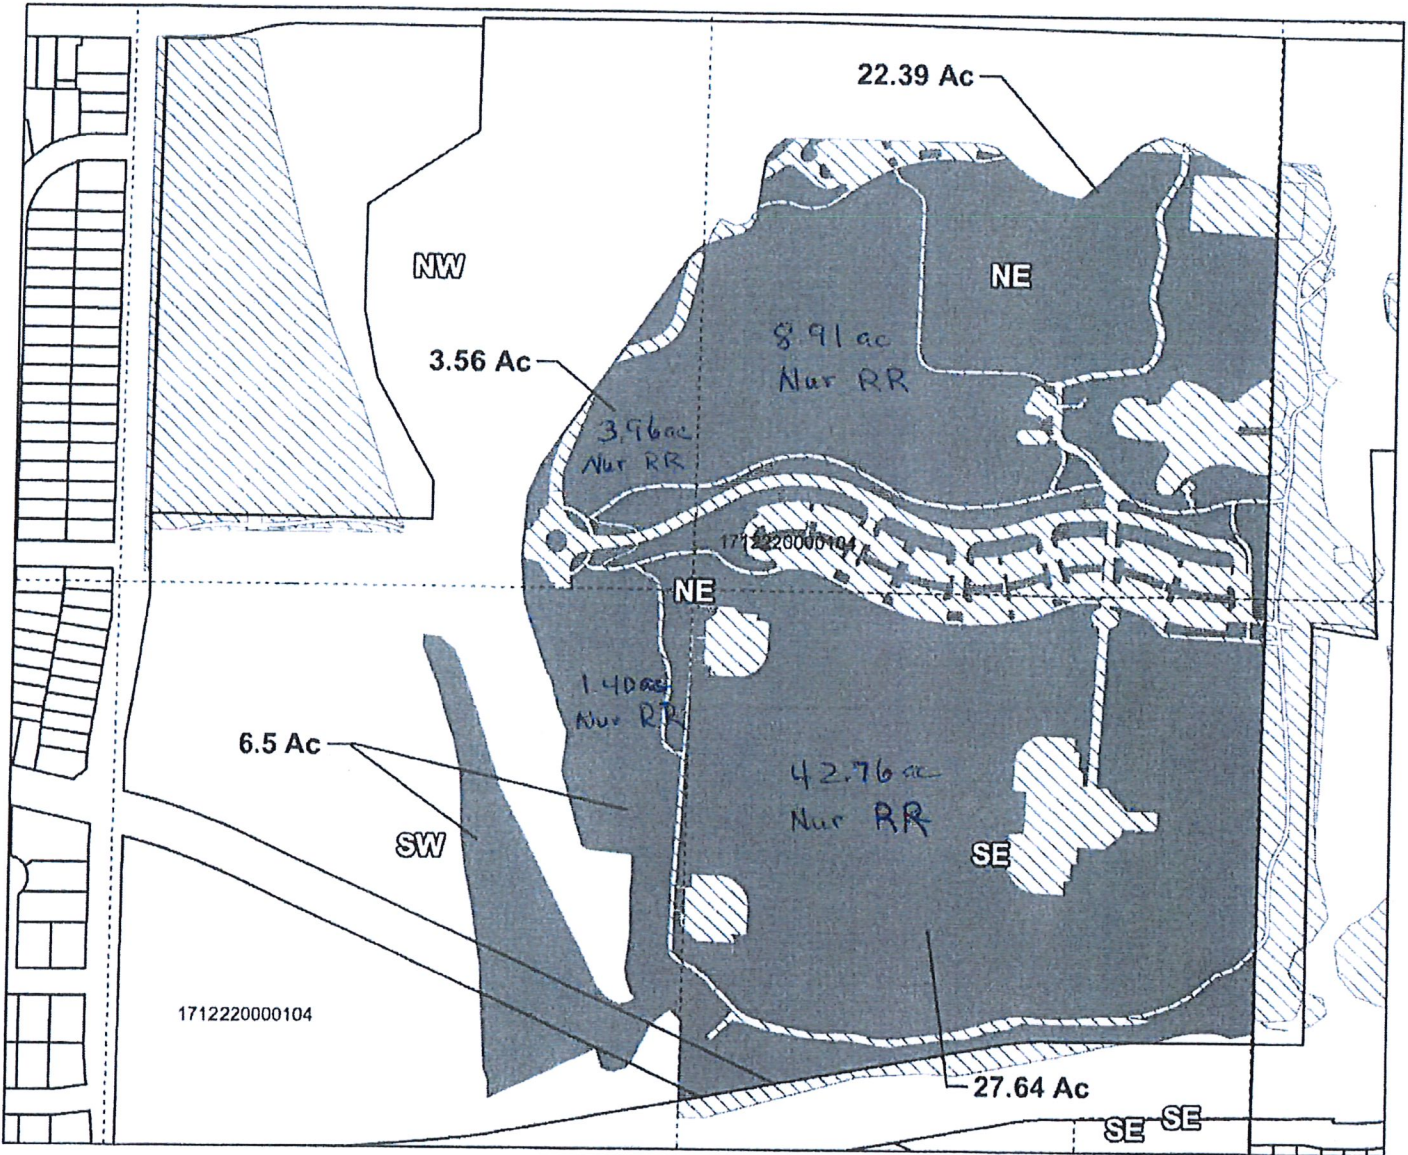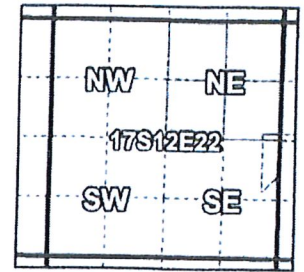


Taxlot 1712220000104, T17S R12E 22 NW/NE: 3.56 Acres changed from Nursery to Irrigation
 Taxlot 1712220000104, T17S R12E 22 NE/NE: 22.39 Acres changed from Nursery to Irrigation
 Taxlot 1712220000104, T17S R12E 22 SW/NE: 6.5 Acres changed from Nursery to Irrigation
 Taxlot 1712220000104, T17S R12E 22 SE/NE: 27.64 Acres changed from Nursery to Irrigation

- Pipelines and Canals
- Transfer
- Taxlots
- Primary Water Right



1 inch = 400 feet

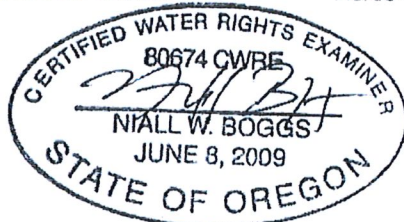

EXPIRES: 12/31/2019

Prepared by Swalley Irrigation District | AUGUST 2018

RECEIVED SEP 07 2018



Swalley Irrigation District

2018 District Transfer Application Change of Use Map

Certificates: 74145

for Bend Parks and Recreation

RECEIVED SEP 07 2018

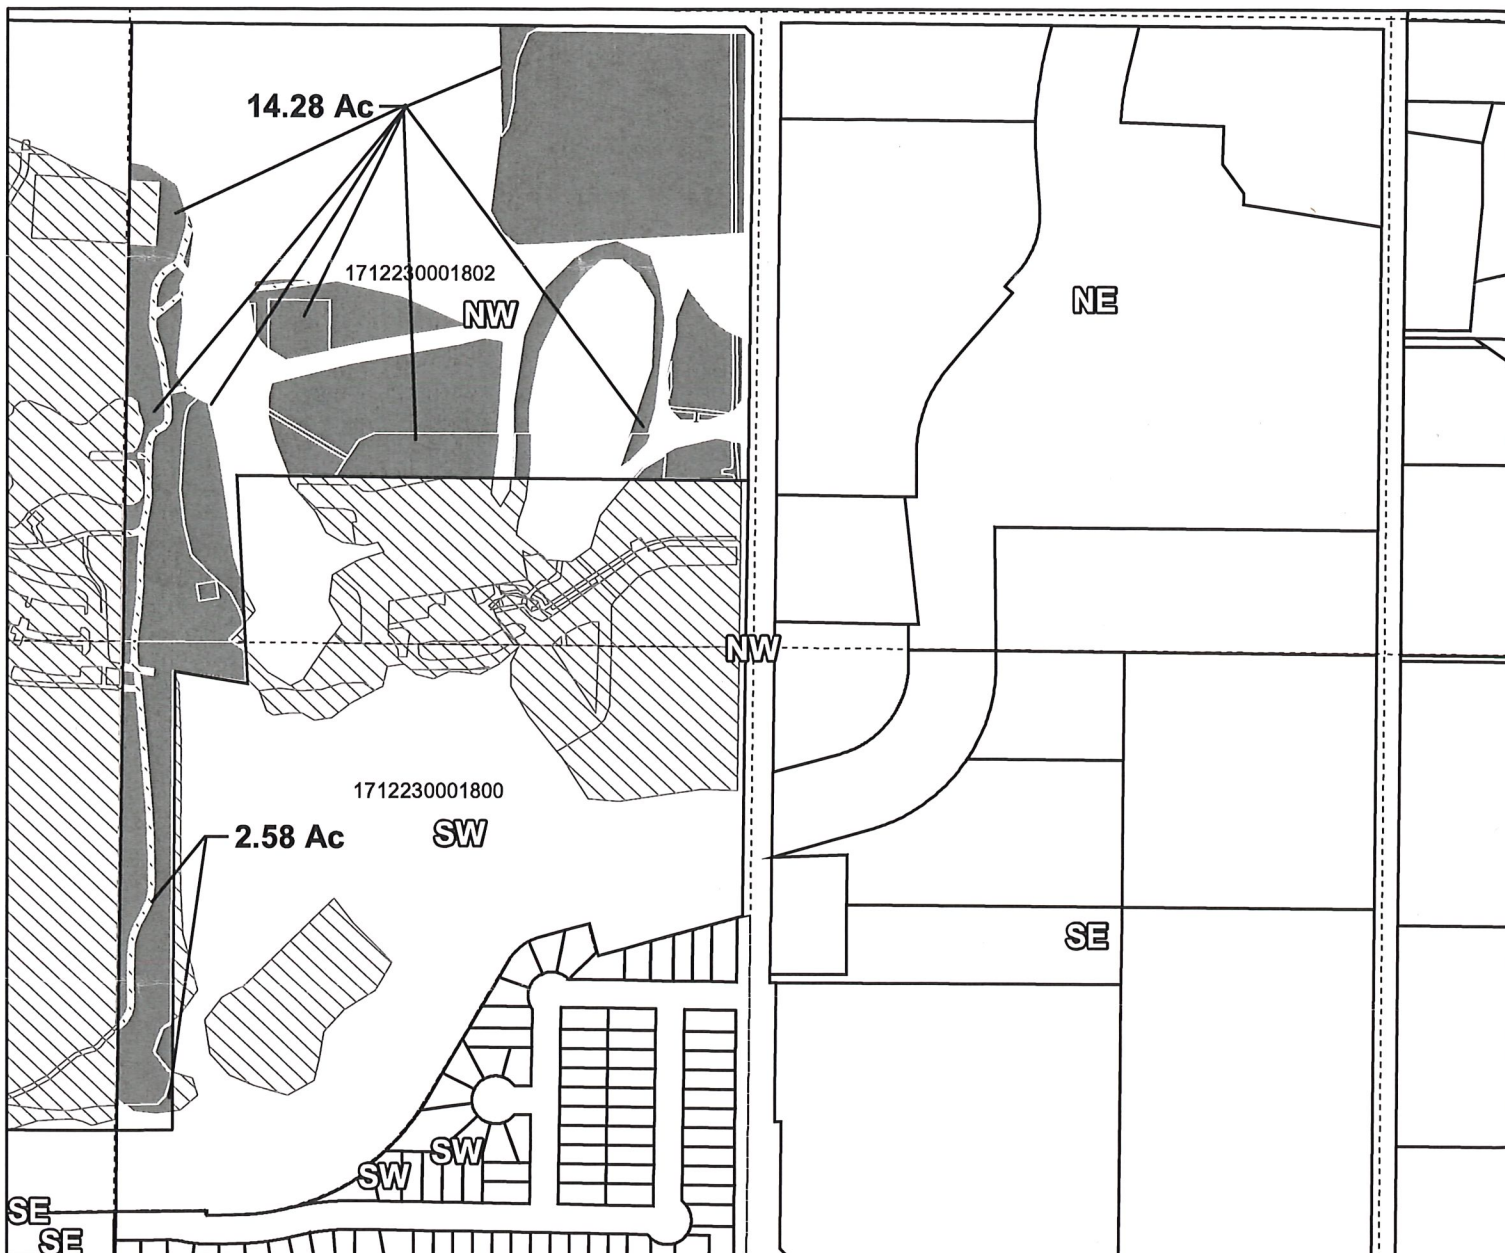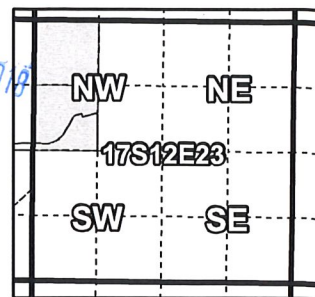

Taxlot 1712230001802, T17S R12E 23 NW/NW: 14.28 Acres changed from Nursery to Irrigation
Taxlot 1712230001802, T17S R12E 23 SW/NW: 2.58 Acres changed from Nursery to Irrigation

- Pipelines and Canals
- Transfer
- Taxlots
- Primary Water Right



1 inch = 400 feet

Prepared by Swalley Irrigation District | AUGUST 2018

EXPIRES: 12/31/2019