


Swalley Irrigation District

2018 District Transfer Application Change of Use Map


Nursery to Irrigation

RECEIVED SEP 07 2018

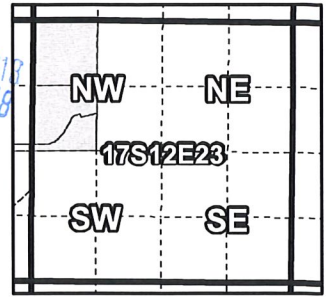

Certificates: 74145

For US Forest Service

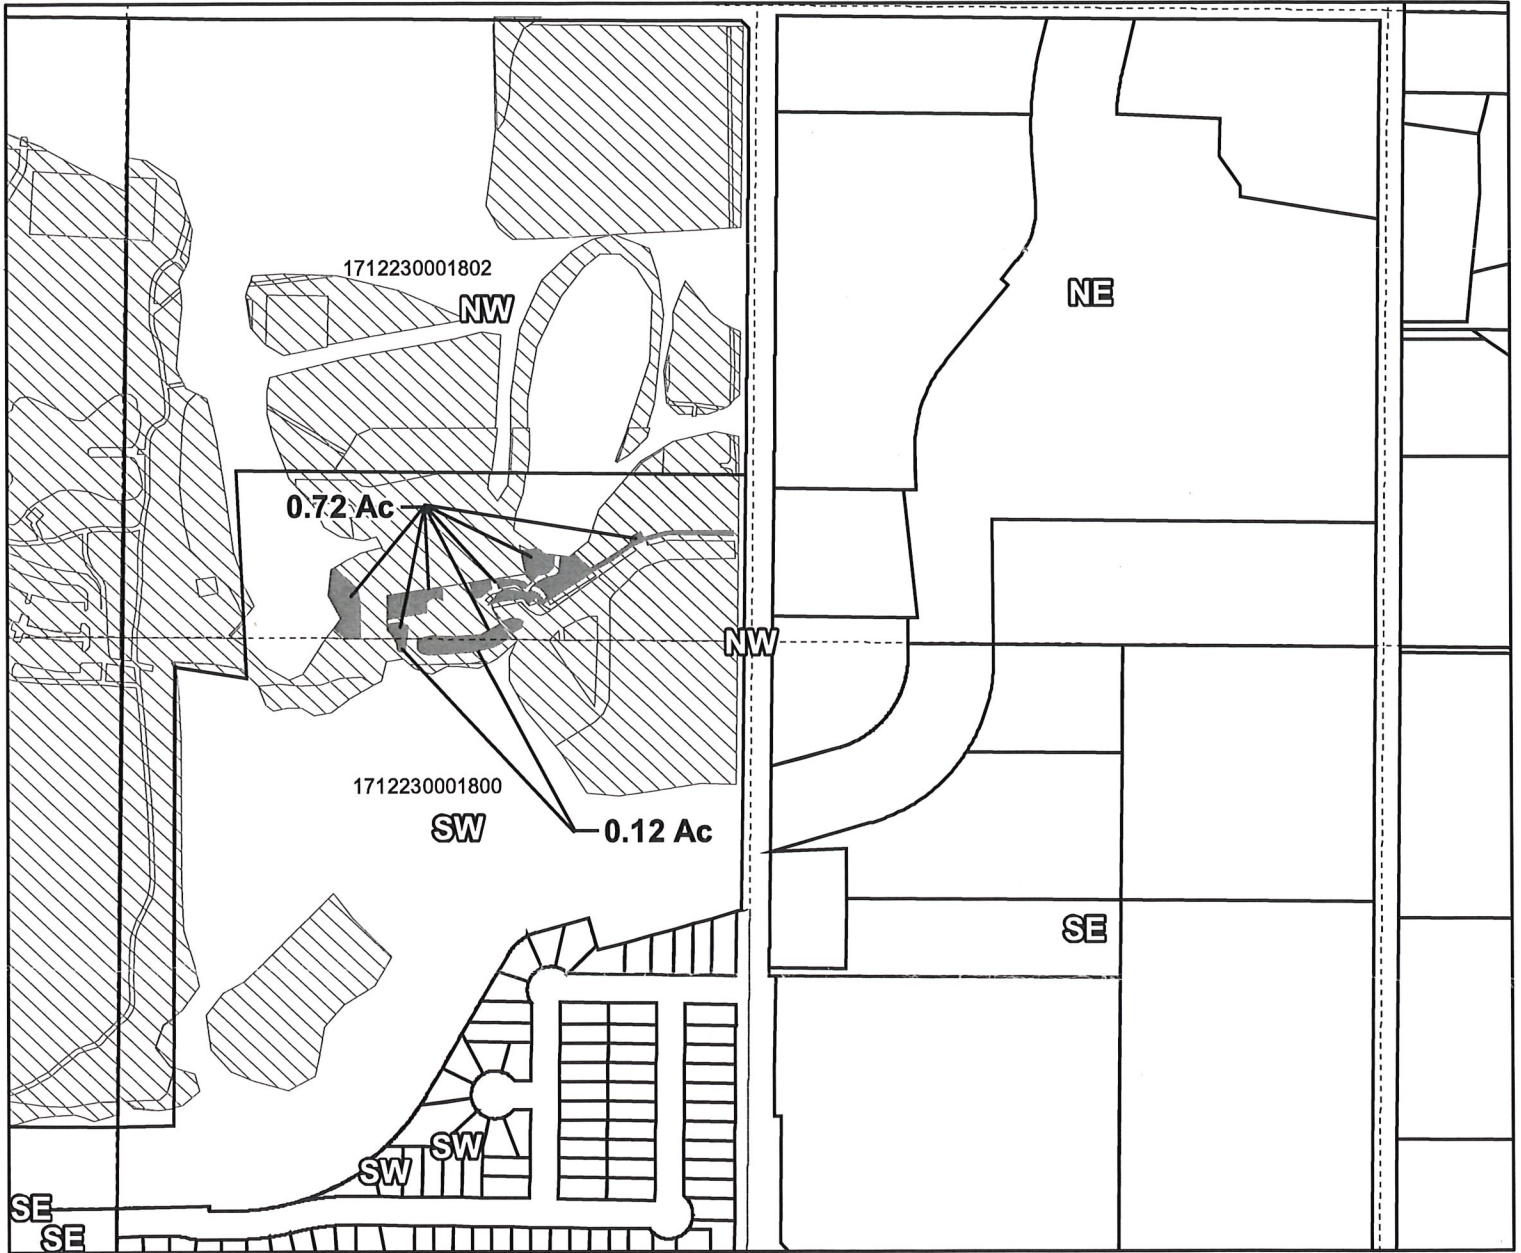

Taxlot 1712230001800, T17S R12E 23 NW/NW: 0.72 Acres changed from Nursery to Irrigation
 Taxlot 1712230001800, T17S R12E 23 SW/NW: 0.12 Acres changed from Nursery to Irrigation

- Pipelines and Canals
- Transfer
- ▨ Primary Water Right
- Taxlots



1 inch = 400 feet



EXPIRES: 12/31/2019

RECEIVED SEP 07 2018

Prepared by Swalley Irrigation District | AUGUST 2018