
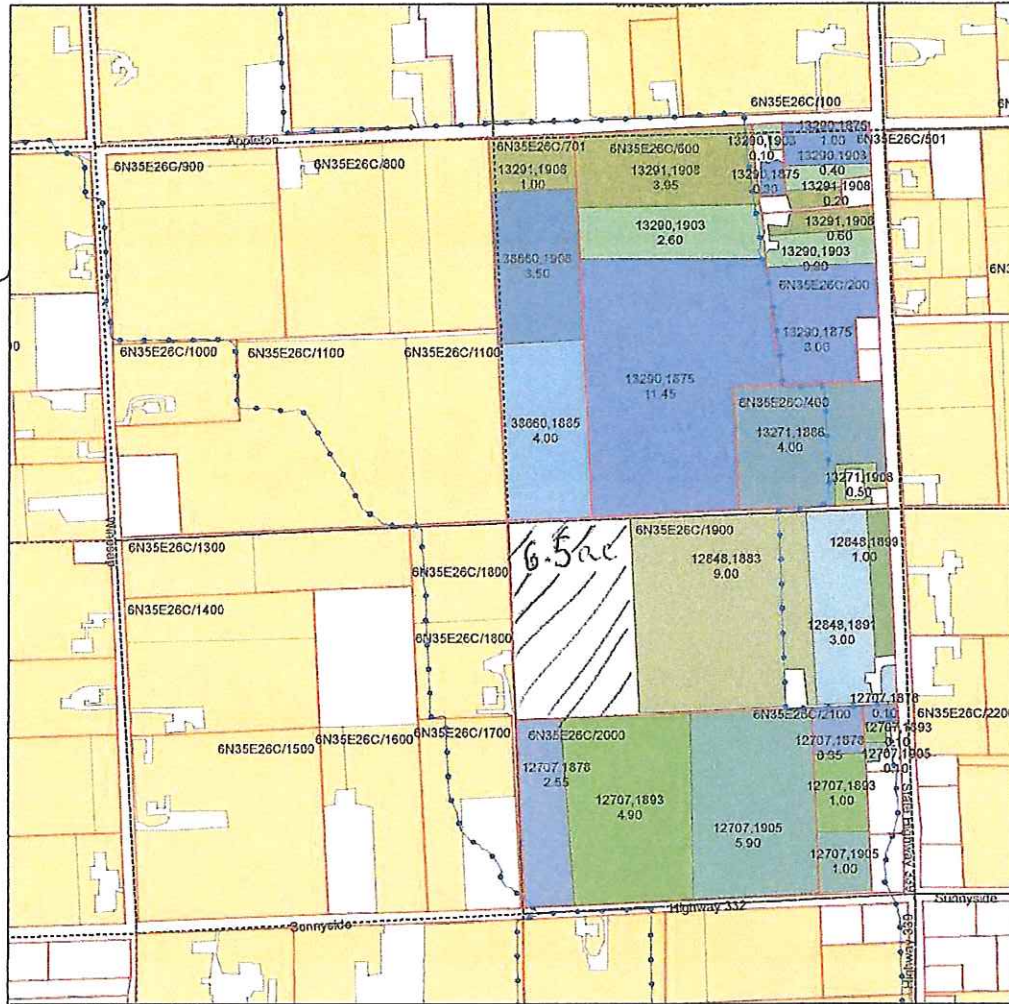


Walla Walla River Irrigation District

3201 Water Rights Map

 cw
to be
moved to
this
acreage



6N35E26/
1900
19.5 acres















RECEIVED
 SEP 14 2013
 WATER RESOURCES DEPT
 SALEM, OREGON

T6N R35E WM Section 26 E1/2 SW Quarter





ASSESSORMAP	CERTIFICATE	PRIORITY	QQ	WR ACRES
6N35E26C/100	13290	1875	NESW	0.30
6N35E26C/100	13290	1903	NESW	0.10
6N35E26C/1900	12848	1883	SESW	9.00
6N35E26C/1900	12848	1899	SESW	1.00
6N35E26C/1900	12848	1891	SESW	3.00
6N35E26C/200	13290	1875	NESW	3.00
6N35E26C/200	13290	1903	NESW	0.90
6N35E26C/200	13291	1908	NESW	0.60
6N35E26C/2000	12707	1878	SESW	2.55
6N35E26C/2000	12707	1905	SESW	5.90
6N35E26C/2000	12707	1893	SESW	4.90
6N35E26C/2100	12707	1878	SESW	0.35
6N35E26C/2100	12707	1893	SESW	1.00
6N35E26C/2100	12707	1905	SESW	1.00
6N35E26C/2200	12707	1878	SESW	0.10
6N35E26C/2200	12707	1893	SESW	0.10
6N35E26C/2200	12707	1905	SESW	0.10
6N35E26C/400	13271	1886	NESW	4.00
6N35E26C/400	13271	1908	NESW	0.50
6N35E26C/501	13290	1875	NESW	1.00
6N35E26C/501	13290	1903	NESW	0.40
6N35E26C/501	13291	1908	NESW	0.20
6N35E26C/600	13291	1908	NESW	3.95
6N35E26C/600	13290	1875	NESW	11.45
6N35E26C/600	13290	1903	NESW	2.60
6N35E26C/701	38660	1885	NESW	4.00
6N35E26C/701	38660	1908	NESW	3.50
6N35E26C/701	13291	1908	NESW	1.00


Primary Certificates

CERTIFICATION, PRIORITY

-  12707, 1878
-  12707, 1893
-  12707, 1905
-  12848, 1883
-  12848, 1891
-  12848, 1899
-  13271, 1886
-  13271, 1908
-  13290, 1875
-  13290, 1903
-  13291, 1908
-  38660, 1885
-  38660, 1908
-  Water Rights Not Within Quarter

Legend

 -  PIPE
-  Parcel
-  QCDB
-  WWRID Boundary

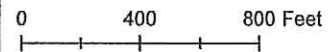

Date March 2011


This map was prepared for Assessment & Taxation purposes only and was NOT prepared nor is it suitable for legal, engineering or surveying purposes.


SEC 31 T6N R36E WM
UMATILLA COUNTY
SCALE 1"=400'

Revised 7/7/03

6N 36 31

AERIAL PHOTO NO. NZ 6P 12-16 & 65-68

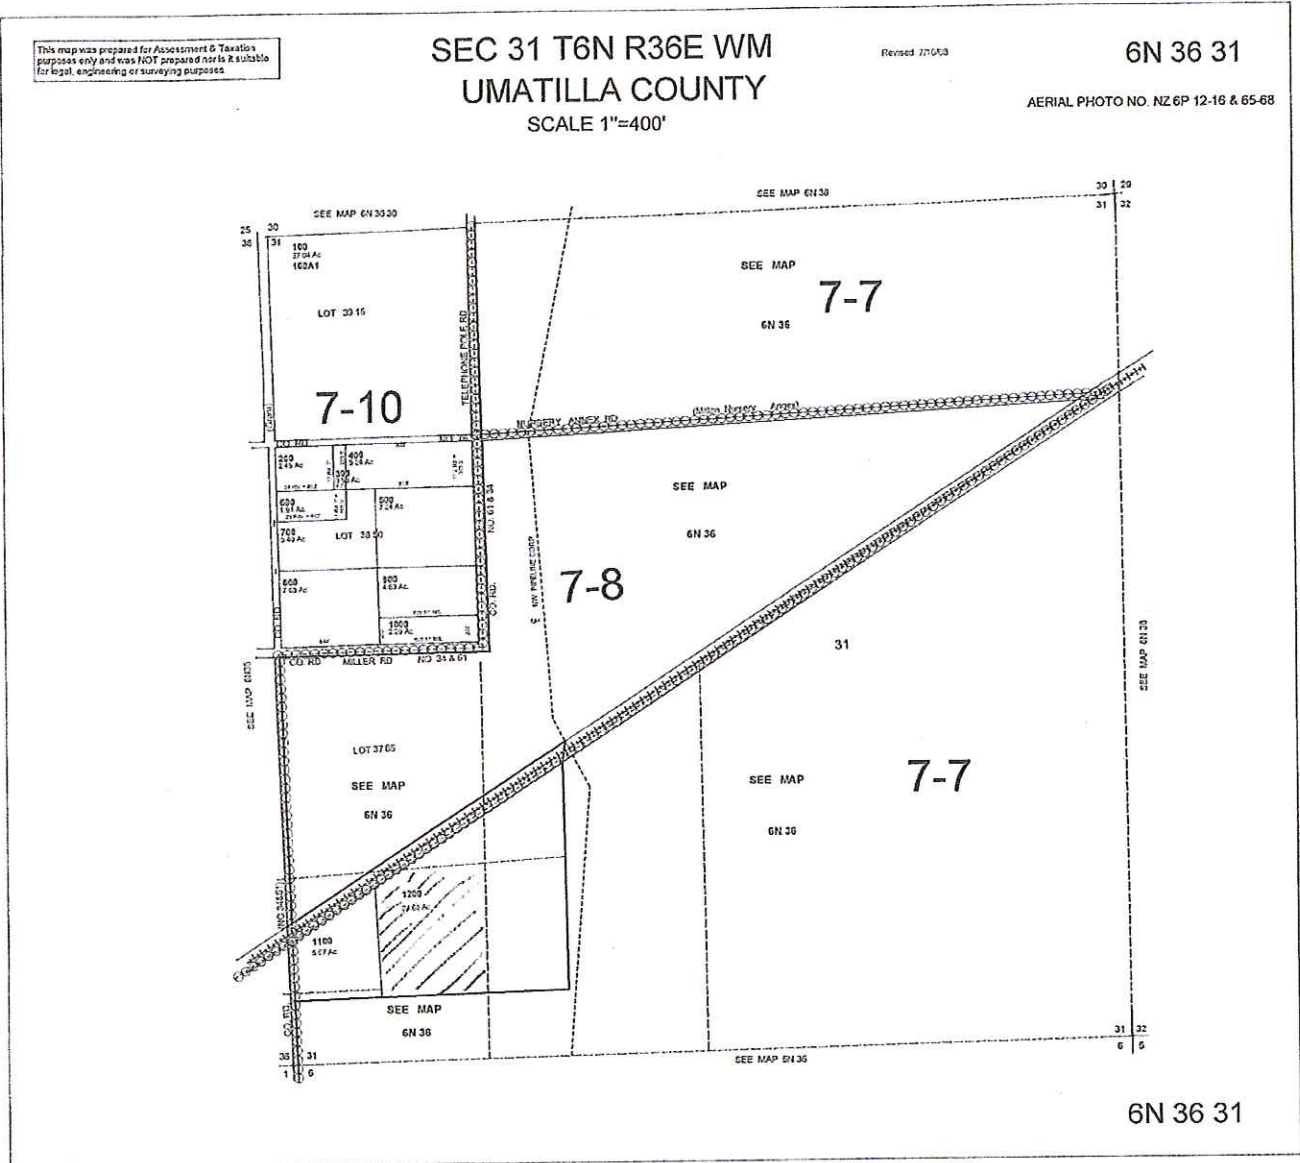

 landowner portion of CW from app # CW-32 is to be placed here after 6.5 acres is designated to 6N35E26C/1900

RECEIVED
SEP 14 2013
WATER RESOURCES DEPT
SALEM, OREGON