

Please use and attach additional pages of Table 2 as needed.
See page 6 for instructions.

Do you have questions about how to fill-out the tables?
Contact the Department at 503-986-0900 and ask for Transfer Staff.

Table 2. Description of Changes to Water Right Certificate # 76839

List the change proposed for the acreage in each 1/4 1/4. If more than one change is proposed, specify the acreage associated with each change.
If there is more than one POD/POA involved in the proposed changes, specify the acreage associated with each POD/POA.

AUTHORIZED (the "from" or "off" lands)										PROPOSED (the "to" or "on" lands)														
The listing that appears on the certificate BEFORE PROPOSED CHANGES List only that part or portion of the water right that will be changed.										The listing as it would appear AFTER PROPOSED CHANGES are made.														
Twp	Rng	Sec	1/4	1/4	Gvt Lot or DLC	Type of USE listed on Certificate	POD(s) or POA(s) (name or number from Table 1)	Priority Date	Proposed Changes (see "CODES" from previous page)	Twp	Rng	Sec	1/4	1/4	Gvt Lot or DLC	Acreage	New Type of USE	POD(s) to be used (from Table 1)	Priority Date					
EXAMPLE																								
2	S	9	E	15	NW	100	15.0	Irrigation	POD #1 POD #2	1901	POU/POD	2	S	9	E	1	NW	NW	500	1	10.0	POD #5	1901	
35	S	12	E	36	SW	2100	5.61	Irrigation	POD 1	9/27/92	POU	36	S	12	E	1	NE	NE	101		4.28	Irrigation	POD 1	9/27/92
35	S	12	E	36	SE	2100	3.57	Irrigation	POD 1	9/27/92	POU	36	S	12	E	1	NW	NE	101		3.62	Irrigation	POD 1	9/27/92
36	1	12	E	1	NE	100	1.52	Irrigation	POD 1	9/27/92	POUNA	36	S	12	E	1	NE	NW	100-800		8.07	Irrigation	POD 1	9/27/92
36	S	12	E	1	NW	100	5.27	Irrigation	POD 1	9/27/92														
TOTAL ACRES: 15.97										TOTAL ACRES: 15.97														

Additional remarks: NA.

RECEIVED

RIGHT TRANSFER

FOR

3M LIVESTOCK COMPANY LLC

SECTION 36, TOWNSHIP 35 SOUTH RANGE 12 EAST
SECTION 1, TOWNSHIP 36 SOUTH RANGE 12 EAST
KLAMATH COUNTY, OREGON



RENEWAL 12/31/19

LEGEND

- SECTION LINE
 ——— 1/4 SECTION LINE
 - - - 1/16 SECTION LINE
 - - - - - IRRIGATION MAIN LINE



EXISTING PLACE OF USE TO REMAIN
CERTIFICATE 76839 - 95.83 ACRES




EXISTING PLACE OF USE TO BE
TRANSFERRED - 15.97 ACRES



PROPOSED PLACE OF USE
15.97 ACRES

TRANSFER NO.

NOTE:
PREPARATION OF THIS MAP IS FOR IDENTIFYING PROPOSED
WATER RIGHTS ONLY. IT HAS NO INTENT TO PROVIDE
LOCATIONS OR DIMENSIONS OF PROPERTY BOUNDARIES.

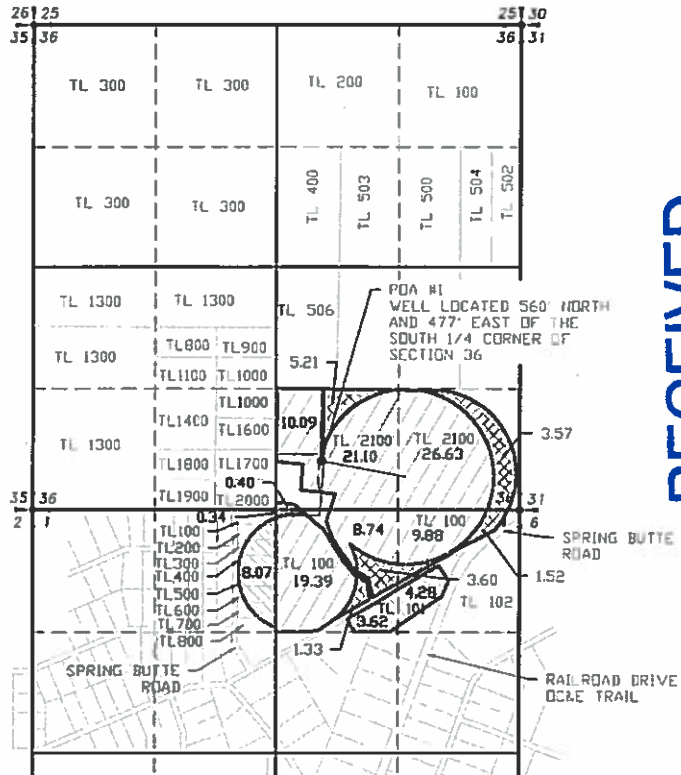

RECEIVED

OCT 9 2018

OWRD

REVISION	BY

**ANDERSON ENGINEERING
AND SURVEYING, INC.**
P.O. BOX 28
LAKEVIEW, OREGON 97030
(541) 947-4407 FAX: 947-2321
www.andersonengineering.com

**FOR:

MAP TO ACCOMPANY WATER
RIGHT TRANSFER
CERTIFICATE 76839

DATE:	7/24/2018
SCALE:	1"=1320'
DWG. BY:	RC
JOB:	76839
FILE:	FINAL
SHEET:	1 OF 1