



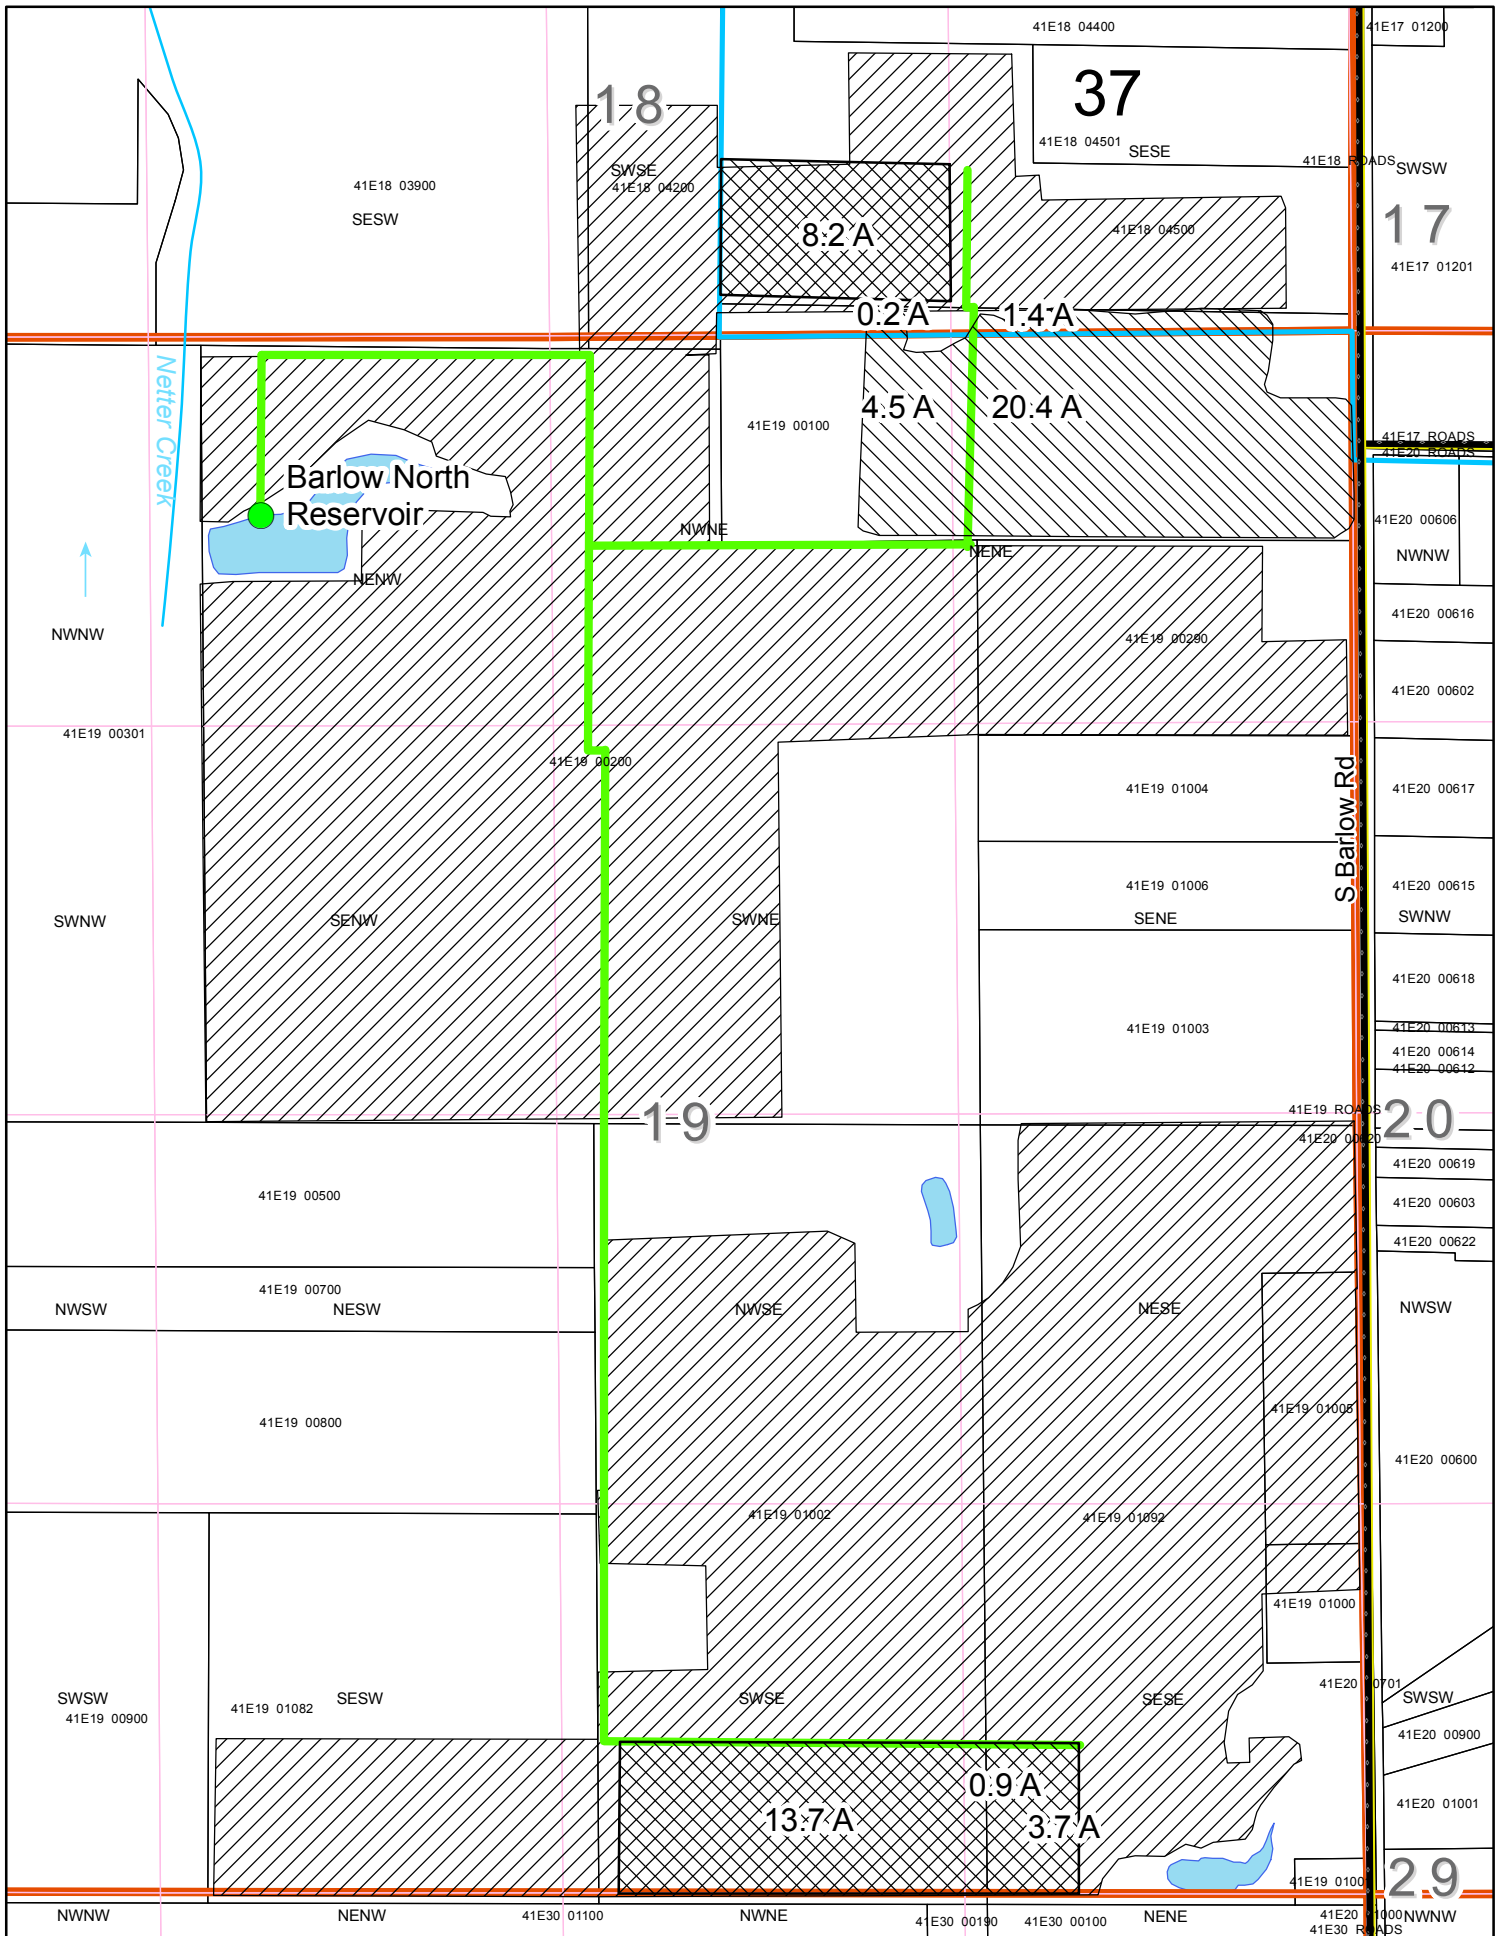

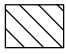






# Water Right Certificate 93382

T.4S.R.1E Sec. 18 & 19



BARLOW RESERVOIR IS LOCATED 650 FEET SOUTH AND 1450 FEET EAST FROM NW CORNER, SECTION 19

-  Proposed temporary place of use
-  Existing place of use
-  Unchanged place of use
-  Quarter-Quarter section boundary
-  Section boundary
-  DLC boundary
-  Tax lot boundary
-  Road
-  Point of Diversion
-  Irrigation mainline

1 in = 650 ft      Date: 12/18/2018

0      487.5      975      1,950 Feet

