


~~"FROM" MAP~~
TO:

T.6S.,R.1&2W.,W.M.

Well authorized under Certificate 65958
is proposed POA for GR-810.
(470 ft. South and 850 ft. West from NE
corner of DLC 38)

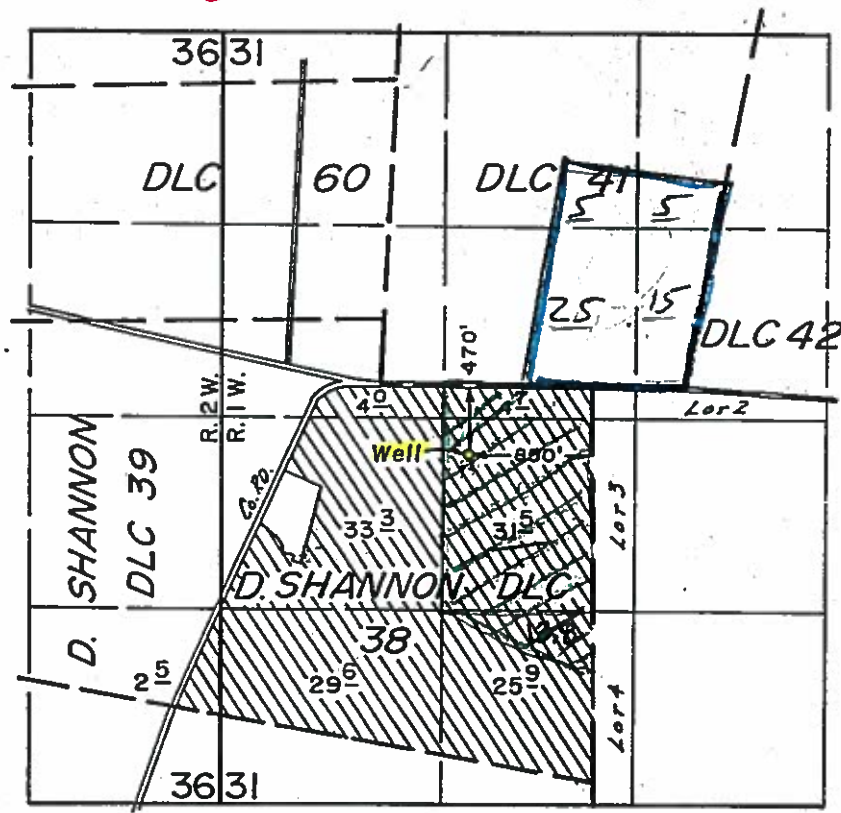

RECEIVED
FEB 01 2019
OWRD

exact Acres

SCALE: 1"=1320'



FINAL PROOF SURVEY UNDER

Application No. G-10608 Permit No. G-2617.....
IN NAME OF

.....WESLEY J. JOHNSON.....

Surveyed July 23... 1984, by B.W. BISHOP.....

RECEIVED
DEC 04 2018
OWRD


13071

Township 6S Range 142W West, W.M.
North

GR-810
"FROM"

SE NW 4.7a
NE SW 31.5a
SE SW 13.8a

50.0a

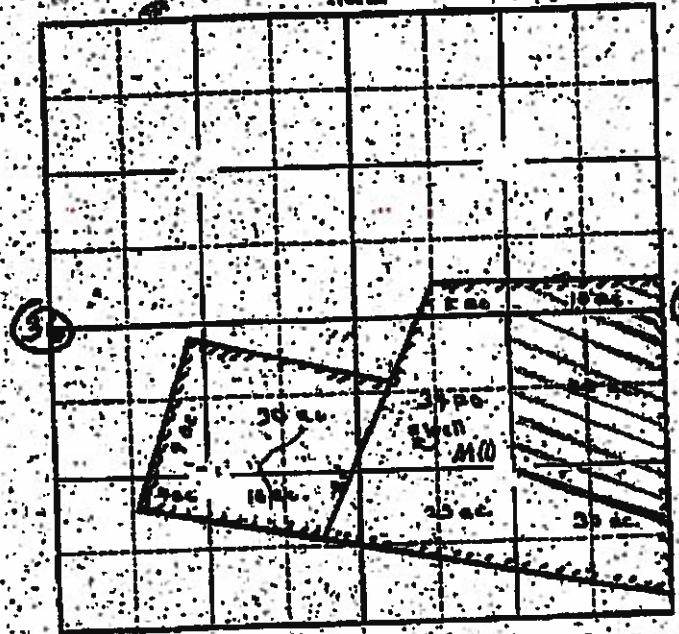

Locate well and acreage of irrigated land on plat.
Scale: 1" = 1 Mile

RECEIVED
FEB 01 2019
OWRD

STATE OF OREGON

County of Marion

I, Clark [unclear] being first duly sworn, do hereby certify that I have read the foregoing Registration Statement and that all of the items therein contained are true to the best of my knowledge and belief.

[Signature]
(Signature of Registrant)

Subscribed and sworn to before me this 18th day of December, 1957

My commission expires June 12, 1961

Wm. S. Bartholomew
(Notary Public)

(SEAL)

CERTIFICATE OF REGISTRATION

STATE OF OREGON

County of Marion

This is to certify that the foregoing Registration Statement was received in the office of the State Engineer on the 18 day of December, 1957 at 10:00 o'clock A. M. and has been duly recorded in said office in Book No. 4 of Registration Statements on page 755

Witness my hand this 21 day of February, 1958

[Signature]
(State Engineer)

By _____ (Notary)