

Part 4a of 4b – Groundwater Registration Information

Please use a separate Part 4 for each registration being modified. See instructions on page 5, to copy and paste additional Part 4s, or to add additional rows to tables within the form.

Applicant Information: Scotts Company LLC (TL 05 2W 35 2000)

Table 1. Location of Authorized and Proposed Point(s) of Appropriation (POA)
 (Note: If the POA name is not specified in the registration, assign it a name or number here.)

| | | | | | | | | | | | |
|-------------------------|---|--------------|---|---|---|---|----|----|----|-----------|--|
| | | | | | | | | | | | |
| East Well 1 | <input checked="" type="checkbox"/> Authorized <input type="checkbox"/> Proposed | MARI 2857 | 5 | S | 2 | W | 35 | SW | NW | DLC 84 | Reference: 2,840 feet north 1° 15' east from the SE corner, Section 34. As re-described: 2,685 feet north and 115 feet east from the SE corner, Section 34. |
| Proposed East Well 2 | <input type="checkbox"/> Authorized <input checked="" type="checkbox"/> Proposed | NA | 5 | S | 2 | W | 34 | SE | NE | DLC 84 | 2,170 feet south and 515 feet west from the NE corner, Section 34 |

*Revised
3-19-19
RH*

Check all type(s) of modifications(s) proposed below (modification "CODES" are provided in parentheses):


- | | |
|--|--|
| <input checked="" type="checkbox"/> Place of Use (POU) | <input type="checkbox"/> Point of Appropriation (well) (POA) |
| <input type="checkbox"/> Character of Use (USE) | <input checked="" type="checkbox"/> Additional Point of Appropriation (APOA) |

Will all of the proposed changes affect the entire Groundwater registration?

- Yes Complete only the proposed ("to" lands) section of Table 2 on the next page. Use the "CODES" listed above to describe the proposed changes.
- No Complete all of Table 2 to describe the portion of the registration to be changed.

RECEIVED
MAR 19 2019
OWRD

T.5S. R.2W. Sec. 34 & 35, W.M.

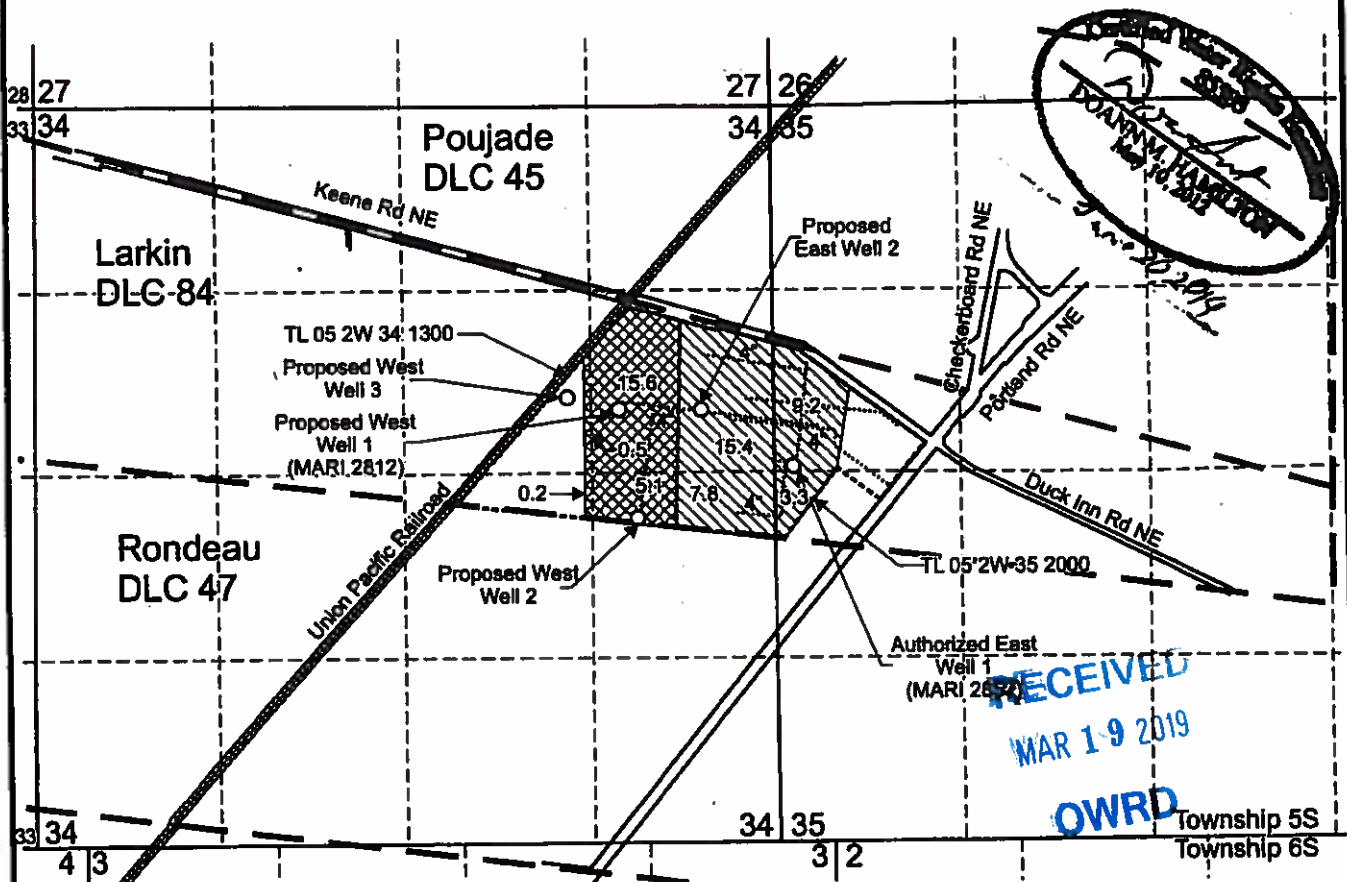

Authorized East Well 1 (MARI 2857) is located as re-described: 2,685 feet north and 115 feet east from the SE corner, Section 34.


Proposed East Well 2 is located 2,170 feet south and 515 feet west from the NE corner, Section 34.

Proposed West Well 1 (MARI 2812) is located 2,170 feet south and 1,100 feet west from the NE corner, Section 34.

Proposed West Well 2 is located 2,320 feet north and 995 feet west from the SE corner, Section 34.

Proposed West Well 3 is located 2,085 feet south and 1,465 feet west from the NE corner, Section 34.

 Area (35.7 Acres) irrigated under GR-898, priority date September 1, 1951, assigned to Scotts Miracle-Gro Company, LLC, using Authorized East Irrigation Well and Proposed Well.

 Area (21.4 Acres) irrigated under GR-898, priority date September 1, 1951 assigned to TSW Nursery Sales, Inc., Using Proposed West Irrigation Well.

----- Tax lot boundary

— . Donation Land Claim boundary

..... Water main line

Scale: 1" = 1,320'



This map was prepared for the purpose of identifying the location of a water right only and is not intended to provide legal dimensions or location of property ownership lines.

Groundwater Registration Modification "To" Map GR-898

Pacific Hydro-Geology Inc.

12/2018
Rev. 02/2019
Rev2. 03/2019

The Scotts Company, LLC
T.5S. R.2W. Sec. 34 & 35, W.M.