

Please use and attach additional pages of Table 2 as needed.
See page 6 for instructions.

Do you have questions about how to fill-out the tables?
Contact the Department at 503-986-0900 and ask for Transfer Staff.

Table 2. Description of Temporary Changes to Water Right Certificate # 45586


List only the part of the right that will be changed. For the acreage in each 1/4 1/4, list the change proposed. If more than one change, specify the acreage associated with each change. If more than one POD/POA, specify the acreage associated with each POD/POA.

AUTHORIZED (the "from" or "off" lands)										PROPOSED (the "to" or "on" lands)																	
The listing that appears on the certificate BEFORE PROPOSED CHANGES										The listing as it would appear AFTER PROPOSED CHANGES																	
List only that part or portion of the water right that will be changed.										are made.																	
Twp	Rng	Sec	1/4	1/4	Tax Lot	Gvt Lot or DLC	Acres	Type of USE listed on Certificate	POD(s) or POA(s) (name or number from Table 1)	Priority Date	Proposed Changes (see "CODES" from previous page)	Twp	Rng	Sec	1/4	1/4	Tax Lot	Gvt Lot or DLC	Acres	New Type of USE	POD(s)/ POA(s) to be used (from Table 1)	Priority Date					
2	S	2	W	5	SW	SE	600	6	3.4	Irrig	Well	1975	POU	2	S	2	W	5	SW	SW	600	-	2.6	Irrig	Well	1975	
2	S	2	W	5	SE	SE	600	7	6.8	Irrig	Well	1975	POU	2	S	2	W	5	SE	SW	600	-	17.9	Irrig	Well	1975	
2	S	2	W	5	SE	SE	600	42	10.3	Irrig	Well	1975	POU														
TOTAL ACRES										20.5	TOTAL ACRES										20.5						


Additional remarks: **The newest application form will not allow me to check boxes so they are shaded.**

RECEIVED
JUN 05 2019
OWRPD

MAP FOR
Temporary Water Right Transfer
 S5, T2S, R2W, WASHINGTON COUNTY
 Certificate 45586

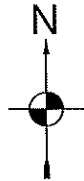


1 IN = 1320 FT
 0 660 1320

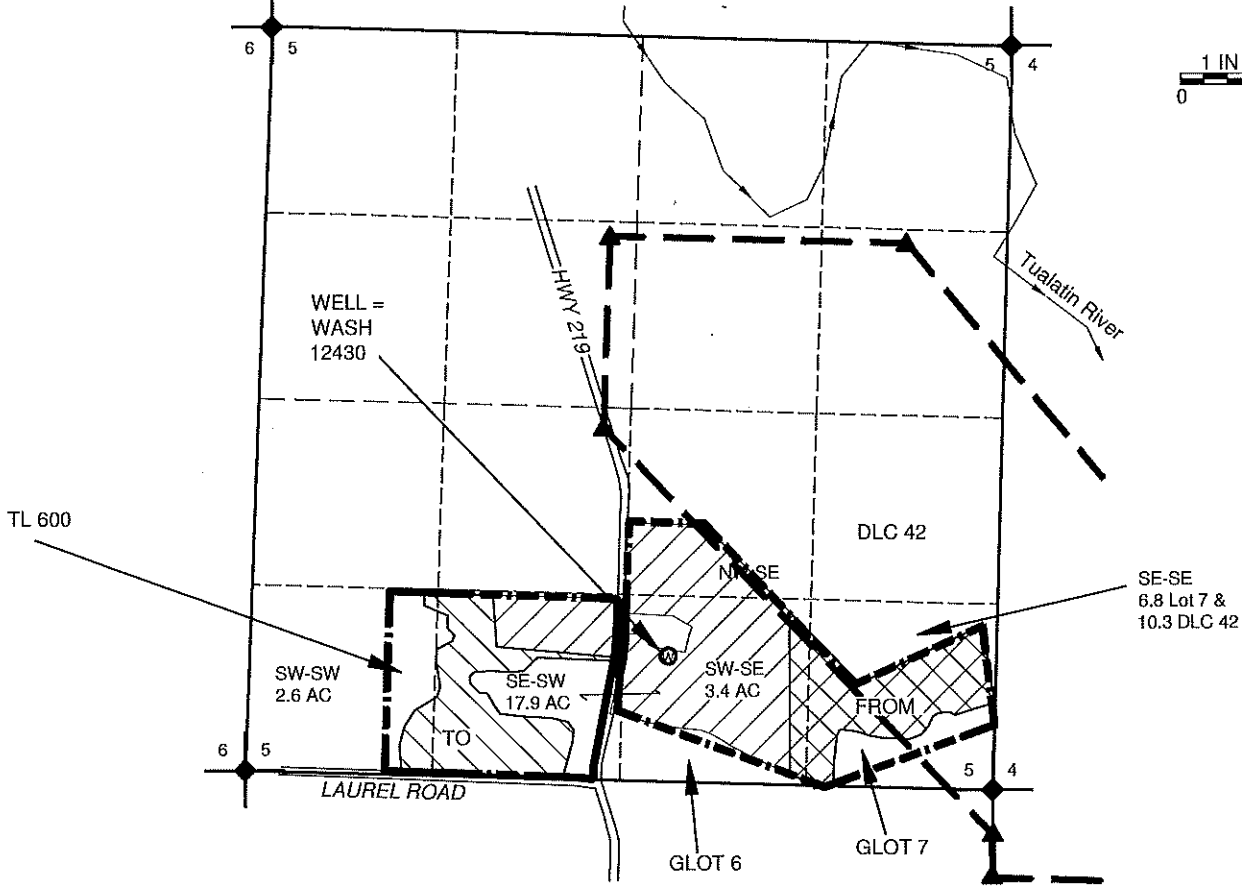

Well is located 930' North & 360' East from the S1/4 Section 5 (per certificate).

NOTES:
 THIS MAP IS NOT INTENDED TO PROVIDE LEGAL DIMENSIONS OR LOCATIONS OF PROPERTY OWNERSHIP LINES.
 -PROPERTY LINES AND QUARTER-QUARTER LINES ARE BASED ON THE TAX ASSESSOR MAP FOR SECTION 5, T2S, R2W.
 -WATER CONVEYANCE LINES SHALL BE ALL WITHIN THE PROPERTY AND THEREFORE ARE NOT SHOWN.
 -IRRIGATION AREAS ARE PER DIRECTION BY MR. UNGER AND MR. KRAXBERGER AND USE OF 2018 AERIAL PHOTO.

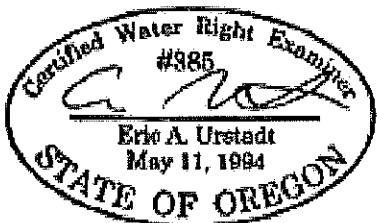

- LEGEND**
- DONATION LAND CLAIM (DLC) CORNER
 - SECTION CORNER
 - POINT OF APPROPRIATION (WELL)
 - STREAM OR SURFACE DRAINAGE
 - TAX LOT LINE
 - SECTION LINE
 - QUARTER-QUARTER LINE
 - DLC LINES
 - IRRIGATION TO
 - IRRIGATION REMAINING
 - IRRIGATION FROM

RECEIVED
 JUN 05 2019
 OWRD

MAP BY:
ASPEN RURAL LAND CONSULTING
 ERIC URSTADT, PE, PLS
 971-250-1520
 Jun 2019
 UngertF