


ACM II Oregon 2, LLC

T8S R1W Sec. 14 & 23

REVISED 6/12/2019 REVISED 7/31/2019

RECEIVED
AUG 05 2019
OWRD

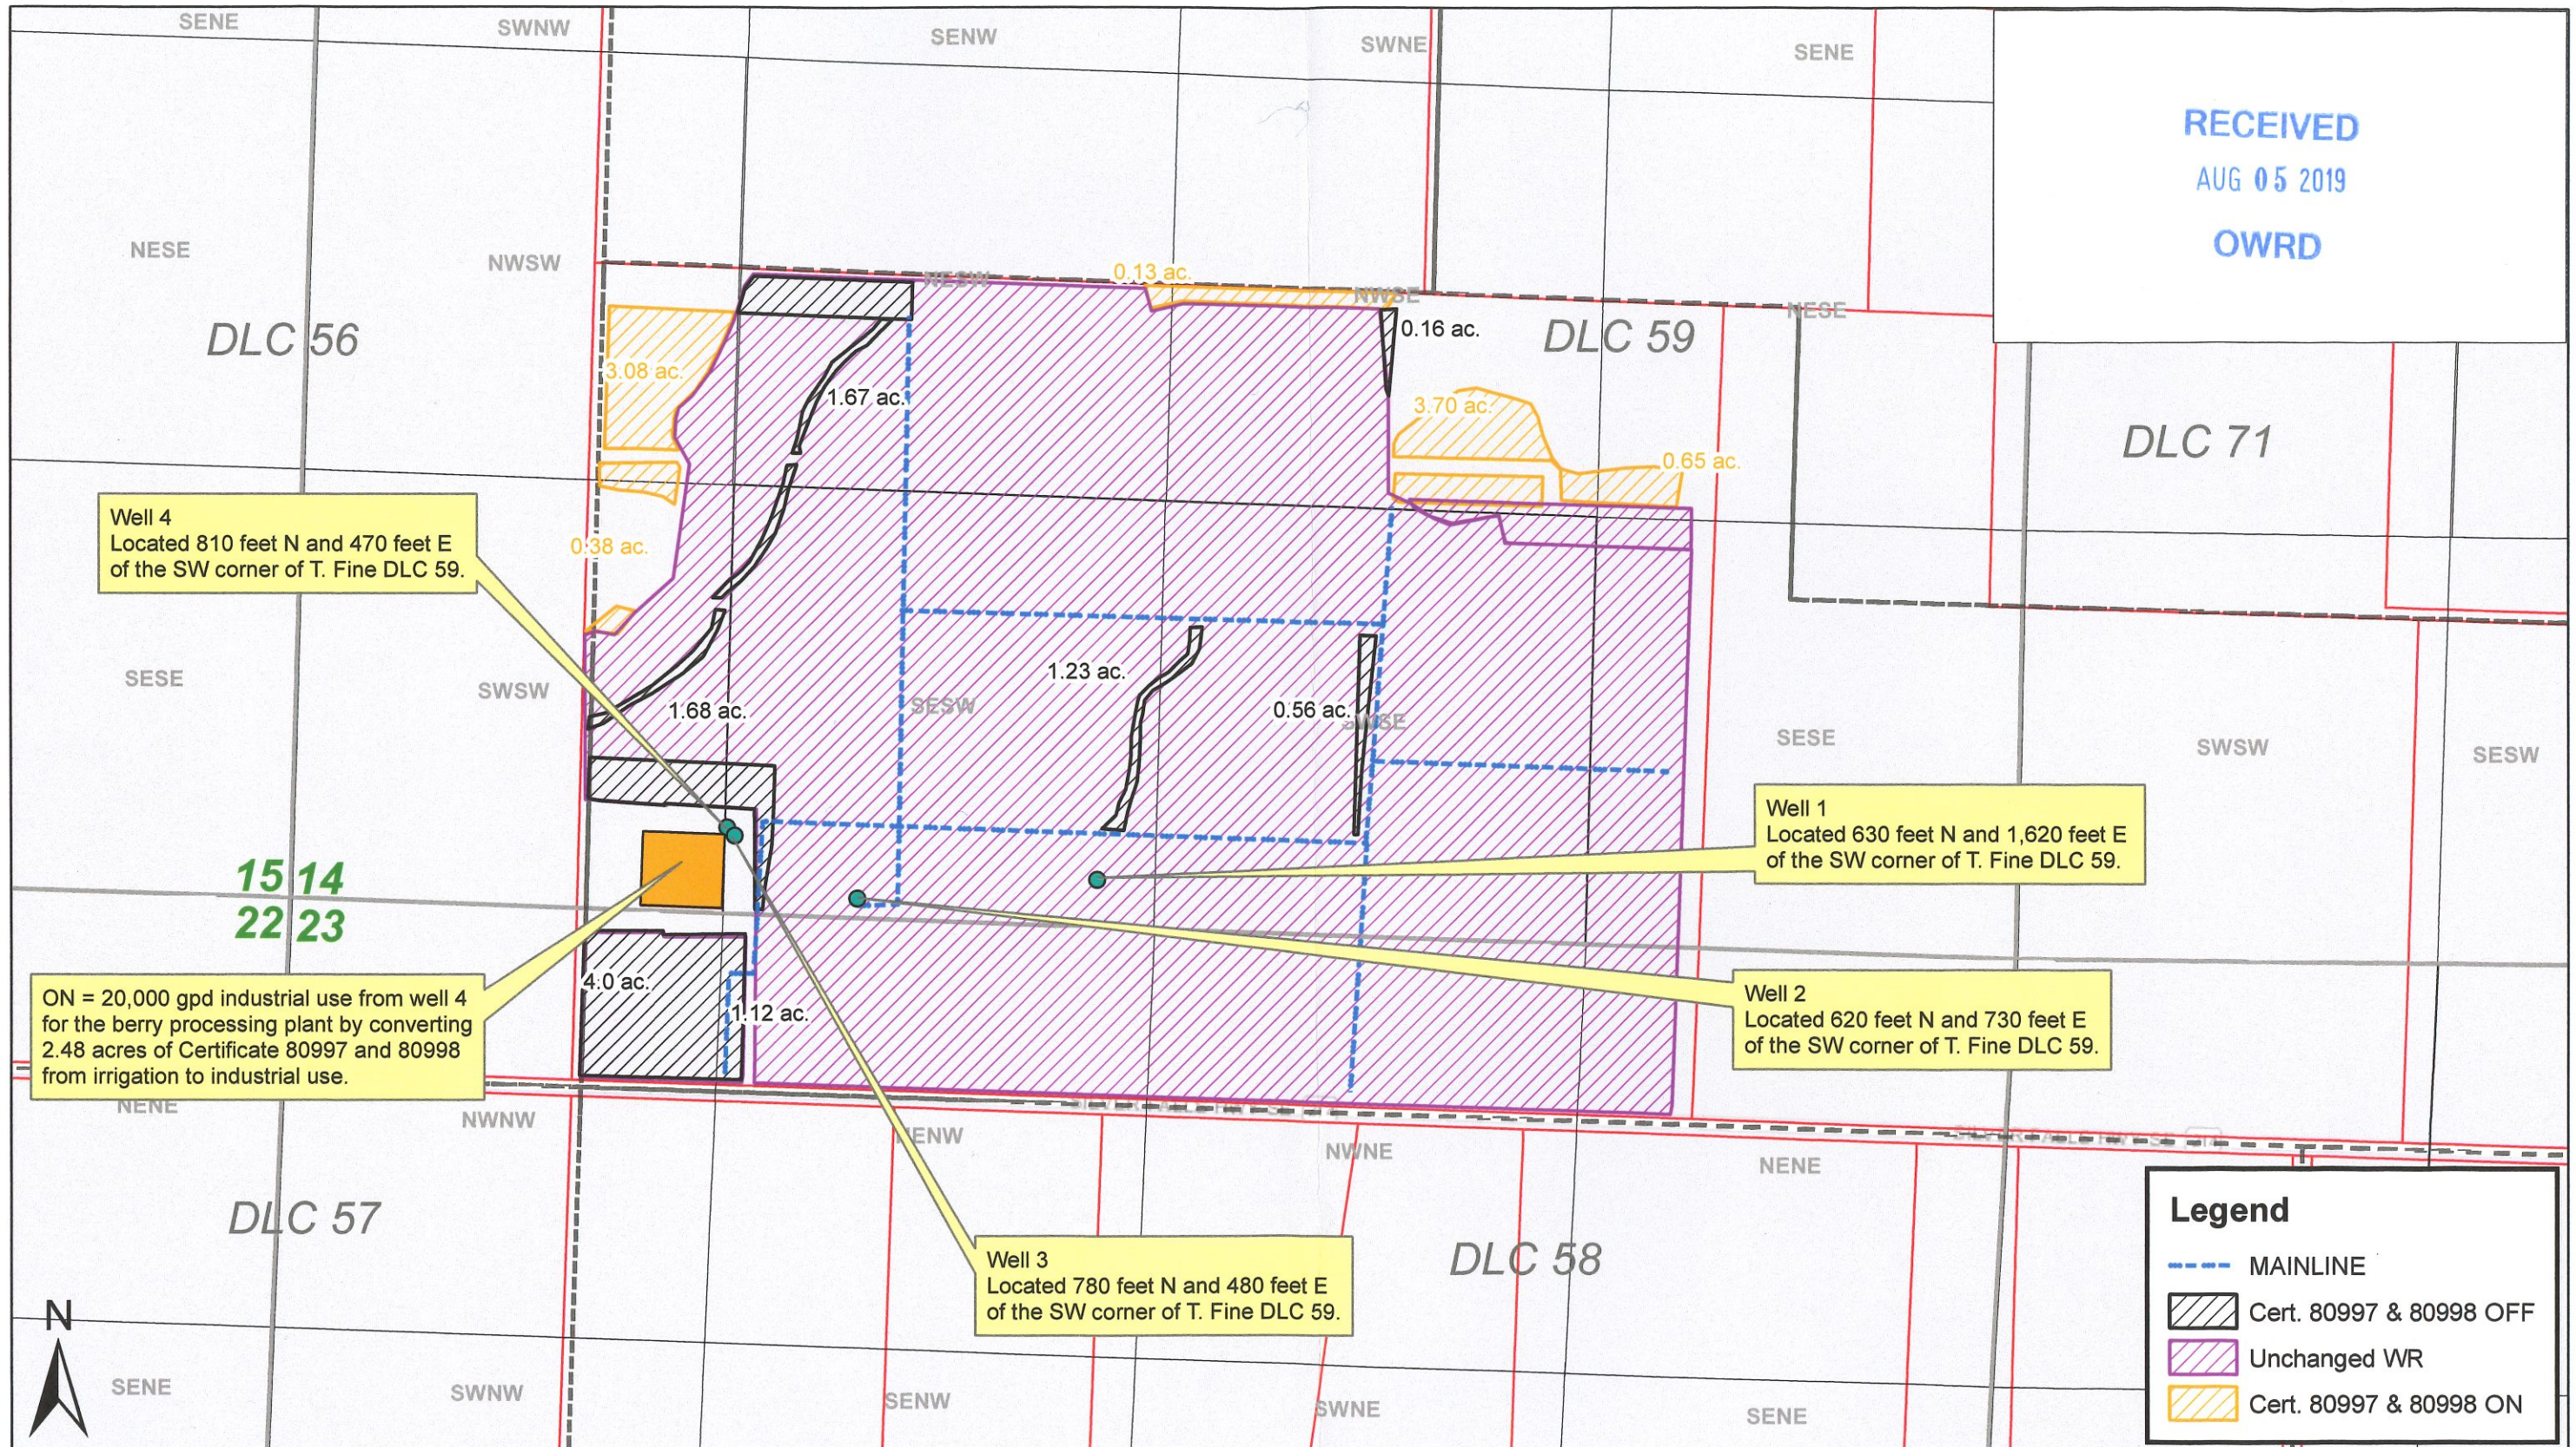

Well 4
Located 810 feet N and 470 feet E
of the SW corner of T. Fine DLC 59.

Well 1
Located 630 feet N and 1,620 feet E
of the SW corner of T. Fine DLC 59.

Well 2
Located 620 feet N and 730 feet E
of the SW corner of T. Fine DLC 59.

Well 3
Located 780 feet N and 480 feet E
of the SW corner of T. Fine DLC 59.

ON = 20,000 gpd industrial use from well 4
for the berry processing plant by converting
2.48 acres of Certificate 80997 and 80998
from irrigation to industrial use.

15 14
22 23

