


MAP TO ILLUSTRATE LOCATIONS OF WELLS FOR JESSE VAN DE STROET

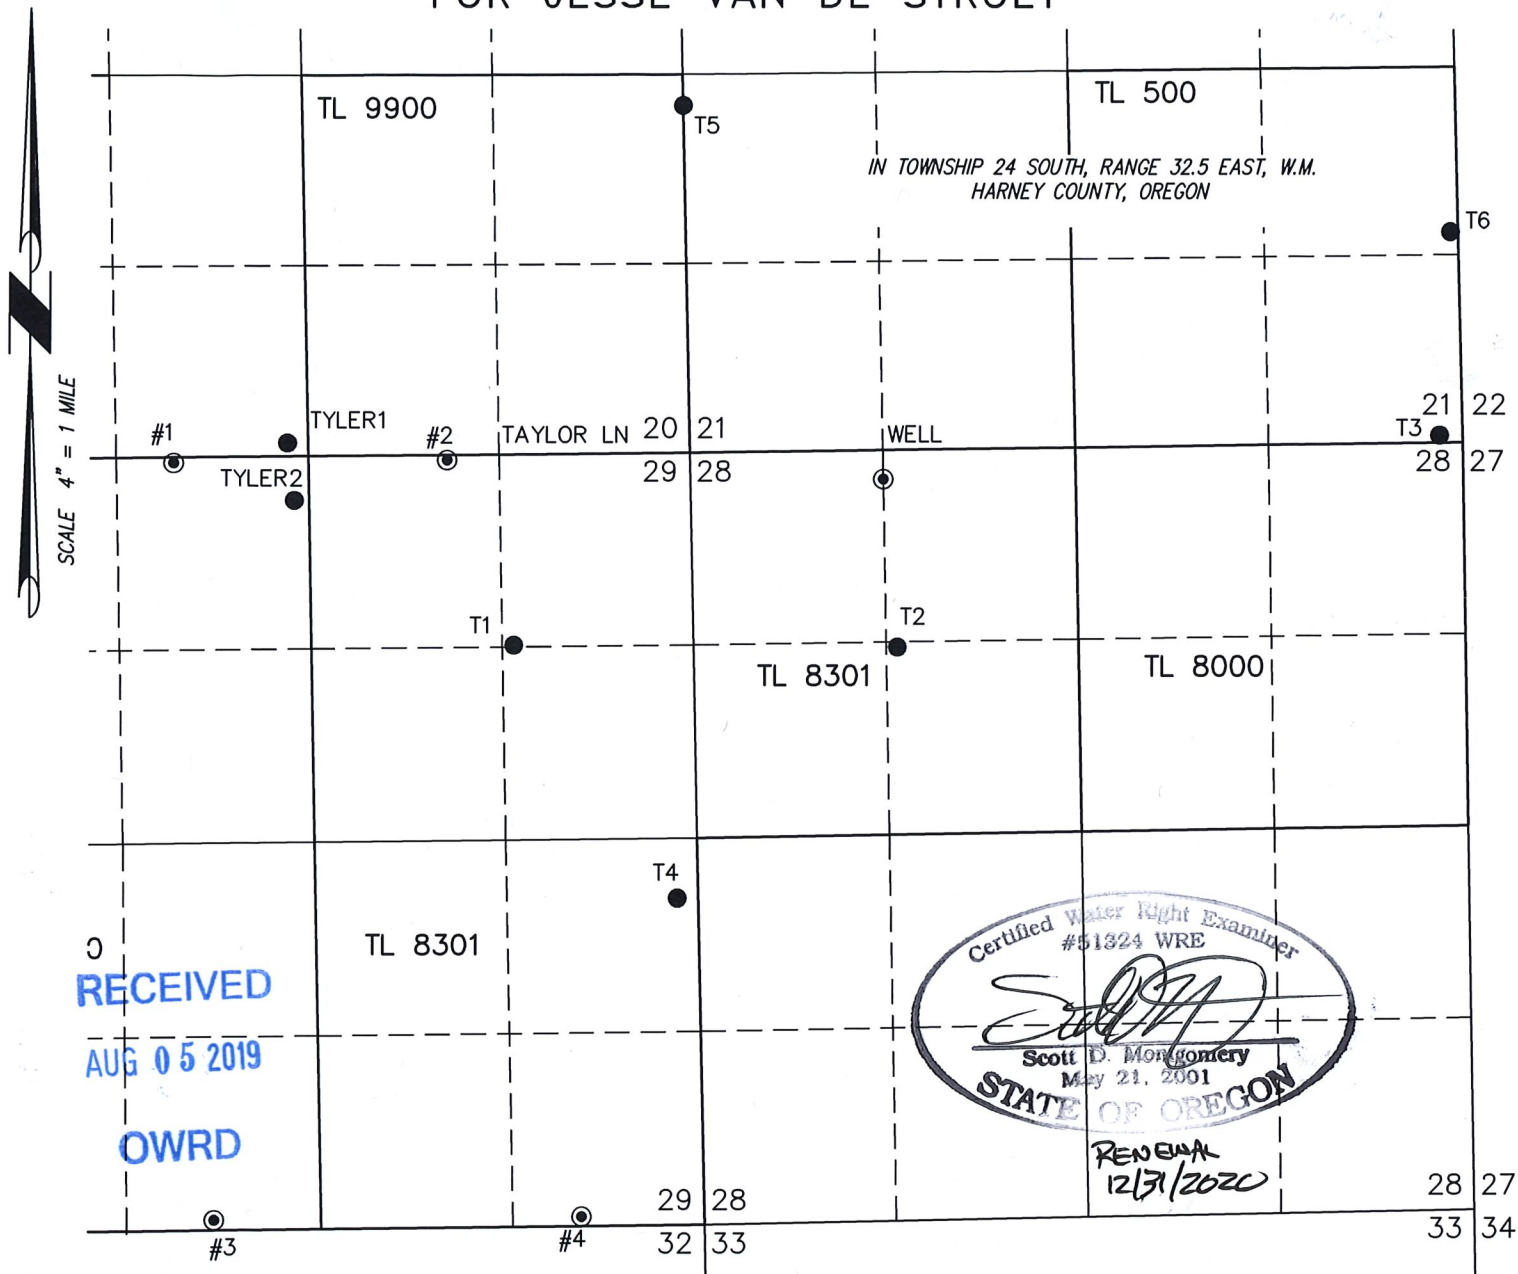

- T1 'GUND2' IN THE NE 1/4 OF THE NE 1/4 SECTION 29 & 1335' NORTH & 1395' EAST FROM THE C 1/4 CORNER SECTION 29.
- T2 'GREG3' IN THE SE 1/4 OF THE NW 1/4 SECTION 28 & 1355' SOUTH & 1400' EAST FROM THE NW CORNER SECTION 28.
- T3 IN THE SE1/4 OF THE SE 1/4 SECTION 21 & 50' NORTH & 160' WEST FROM THE SE CORNER SECTION 21.
- T4 'GUND4' IN THE NE 1/4 OF THE SE 1/4 SECTION 29 & 410' SOUTH & 2490' EAST FROM THE C 1/4 CORNER SECTION 29.
- T5 'CULP1' IN THE NE 1/4 OF THE SE 1/4 SECTION 20 & 2385' NORTH & 2630' EAST FROM THE 1/4 CORNER BETWEEN SECTIONS 20 & 29.
- T6 'CULP2' IN THE NE 1/4 OF THE SE 1/4 SECTION 21 & 1130' SOUTH & 50' WEST FROM THE 1/4 CORNER BETWEEN SECTIONS 21 & 22.

PROJECT No. 17-132

PREPARED AT THE REQUEST OF:
JESSE VAN DE STROET
1524 29TH STREET
INWOOD, IA 51240

ALL POINTS ENGINEERING
& SURVEYING, INC.



P.O. BOX 767
TERREBONNE, OREGON 97760
(541) 548-5833 PH
scott@apeands.com
www.APEandS.com


Part 5 of 5 – Water Right Information

Please use a separate Part 5 for each water right being changed. See instructions on page 6, to copy and paste additional Part 5s, or to add additional rows to tables within the form.

CERTIFICATE # **51515**

Description of Water Delivery System

System capacity: **1.58** cubic feet per second (cfs) OR
 _____ gallons per minute (gpm)

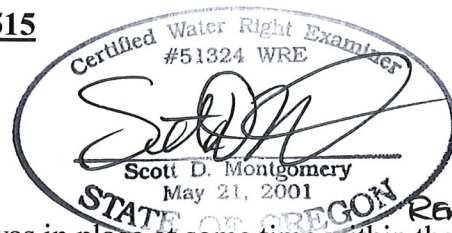

Describe the current water delivery system or the system that was in place at some time within the last five years. Include information on the pumps, canals, pipelines, and sprinklers used to divert, convey, and apply the water at the authorized place of use. **Water is pumped from well to a hand line configuration for irrigation. Pictures were provided by the owners agent showings the lands were irrigated within the last 5 years.**

Table 1. Location of Authorized and Proposed Point(s) of Diversion (POD) or Appropriation (POA)
 (Note: If the POD/POA name is not specified on the certificate, assign it a name or number here.)

POD/POA Name or Number	Is this POD/POA Authorized on the Certificate or is it Proposed?	If POA, OWRD Well Log ID# (or Well ID Tag # L-___)	Twp	Rng	Sec	¼ ¼	Tax Lot, DLC or Gov't Lot	Measured Distances (from a recognized survey corner)
Well	☒ Authorized ☐ Proposed	HARN 1136	25 S	31 E	22	NW NW	4500	1280' S & 30' E from NW cor, Sec 22
#4	☐ Authorized ☒ Proposed	HARN 52456	24 S	32.5 E	28	NW NE	8300	1320' S & 1320' W from NE cor Sec 28
Culp 2	☐ Authorized ☒ Proposed	HARN 50285	24 S	32.5 E	21	NE SE	9900	1120' S & 50' W from E1/4 cor Sec 21 & 22
Culp 1	☐ Authorized ☒ Proposed	HARN 50789	24 S	32.5 E	20	NE SE	500	2258' N & 2609' E from ¼ cor, Sec 20 & 29
Greg 3	☐ Authorized ☒ Proposed	HARN 51944/ 52119	24 S	32.5 E	28	NW NW	8301	1320' S & 1320' E from NW cor, Sec 28
Gund 2	☐ Authorized ☒ Proposed	HARN 52490	24 S	32.5 E	29	NE NE	8301	1330' N & 1330' E from C ¼ cor, Sec 29
Gund 4	☐ Authorized ☒ Proposed	HARN 52624	24 S	32.5 E	29	SE SE	8301	2580' S & 1785' E from C ¼ cor, Sec 29

Check all type(s) of change(s) proposed below (change "CODES" are provided in parentheses):

- | | |
|--|--|
| ☒ Place of Use (POU) | ☐ Supplemental Use to Primary Use (S to P) |
| ☐ Character of Use (USE) | ☒ Point of Appropriation/Well (POA) |
| ☐ Point of Diversion (POD) | ☒ Additional Point of Appropriation (APOA) |
| ☐ Additional Point of Diversion (APOD) | ☐ Substitution (SUB) |
| ☐ Surface Water POD to Ground Water POA (SW/GW) | ☐ Government Action POD (GOV) |

RECEIVED
AUG 05 2019

NOTE: PROPOSED POA #4 WILL BE THE REPLACEMENT WELL FOR AUTHORIZED "WELL"