

RECEIVED

AUG 16 2019

OWRD

Revised

Please use and attach additional pages of Table 2 as needed. See page 6 for instructions.	Do you have questions about how to fill-out the tables? Contact the Department at 503-986-0900 and ask for Transfer Staff.
--	---

Table 2. Description of Changes to Water Use Permit # G-15571
 List the change proposed for the acreage in each 1/4 1/4. If more than one change is proposed, specify the acreage associated with each change.
 If there is more than one POD/POA involved in the proposed changes, specify the acreage associated with each POD/POA.

AUTHORIZED (the "from" or "off" lands) The listing that appears on the certificate BEFORE PROPOSED CHANGES List only that part or portion of the water right that will be changed.											Proposed Changes (see "CODES" from previous page)	PROPOSED (the "to" or "on" lands) The listing as it would appear AFTER PROPOSED CHANGES are made.											
Twp	Rng	Sec	1/4	1/4	Tax Lot	Gvt Lot or DLC	Acre (if applicable)	POD(s) or POA(s) (name or number from Table 1)	Priority Date			Twp	Rng	Sec	1/4	1/4	Tax Lot	Gvt Lot or DLC	Acre (if applicable)	POD(s) or POA(s) to be used (from Table 1)	Priority Date		
EXAMPLE																							
2	S	9	E	15	NE	NW	100	15.0	POD #1 POD #2		POU/POD	2	S	9	E	15	NW	NW	100	1	10.0	POD #5	
"	"	"	"	"	"	"	"	EXAMPLE	"		"	2	S	9	E	15	SW	NW	200		5.0	POD #6	
3	S	3	W	28	NE	NE	102	9.1	POA #1 POA #2	5/13/2003	APOA												
											APOA/POU	3	S	3	W	27	NW	NW	900		19.2	POA #1 POA #2	5/13/2003
											APOA/POU	3	S	3	W	22	SW	SW	1100		11.7	POA #1 POA #2	5/13/2003
TOTAL ACRES								9.1	TOTAL ACRES											30.9			

Additional remarks: _____.

RECEIVED

Part 4 of 5 – Applicant Information and Signature

AUG 16 2019

OWRD *Revised*

Applicant Information

APPLICANT/BUSINESS NAME Broadpeak BW LLC & Black Walnut LLC (Attn: John Hull, RandE Holdings LLC)		PHONE NO. 503.830.9039	ADDITIONAL CONTACT NO.
ADDRESS 47 State St., Suite 200			FAX NO.
CITY Lake Oswego	STATE OR	ZIP 97034	E-MAIL
BY PROVIDING AN E-MAIL ADDRESS, CONSENT IS GIVEN TO RECEIVE ALL CORRESPONDENCE FROM THE DEPARTMENT ELECTRONICALLY. COPIES OF THE FINAL ORDER DOCUMENTS WILL ALSO BE MAILED.			

Agent Information – The agent is authorized to represent the applicant in all matters relating to this application.

AGENT/BUSINESS NAME RNSA Inc.		PHONE NO. 503.241.5444	ADDITIONAL CONTACT NO.
ADDRESS 1400 SW Davenport St			FAX NO.
CITY Portland	STATE OR	ZIP 97201	E-MAIL rnsagroundwater@gmail.com
BY PROVIDING AN E-MAIL ADDRESS, CONSENT IS GIVEN TO RECEIVE ALL CORRESPONDENCE FROM THE DEPARTMENT ELECTRONICALLY. COPIES OF THE FINAL ORDER DOCUMENTS WILL ALSO BE MAILED.			

Explain in your own words what you propose to accomplish with this permit amendment; and why:
We would like to shift 31 acres of the existing permit to contiguous land and add an additional Point of Appropriation. This will shift a portion of the permit Place of Use to an area more suitable for cultivating grapes and to create better access to water for irrigation.

If you need additional space, continue on a separate piece of paper and attach to the application as "Attachment 1".

Check this box if this project is fully or partially funded by the American Recovery and Reinvestment Act. (Federal stimulus dollars)

Is the applicant the permit holder of record? Yes No

If NO, include either:

- A completed assignment form (with required statutory assignment fee), assigning all or a portion of the permit to the applicant(s), **OR**
- An affidavit of consent from the permit holder(s) of record that gives permission for the applicant to amend the permit.

Has the Completion ("C") Date of the permit(s) in this application expired? Yes No


If YES, this application will not be accepted by the Department.

If NO, what are the completion dates of the permit(s)? 10/1/2024

- If the permit completion date expires while the Permit Amendment Application is pending, the Department will not approve the Permit Amendment Application until an Extension of Time Application is approved for the permit.
- You may consider using the Reimbursement Authority process to expedite the processing of this Permit Amendment Application if the completion date of the permit expires within 6 months of the date of filing this application.

By my signature below, I confirm that I understand:

- Prior to Department approval of the permit amendment, I may be required to submit payment to the Department for publication of a notice in a newspaper with general circulation in the area where the permit is located, once per week for two consecutive weeks. If more than one qualifying newspaper is available, I suggest publishing the notice in the following newspaper: _____.

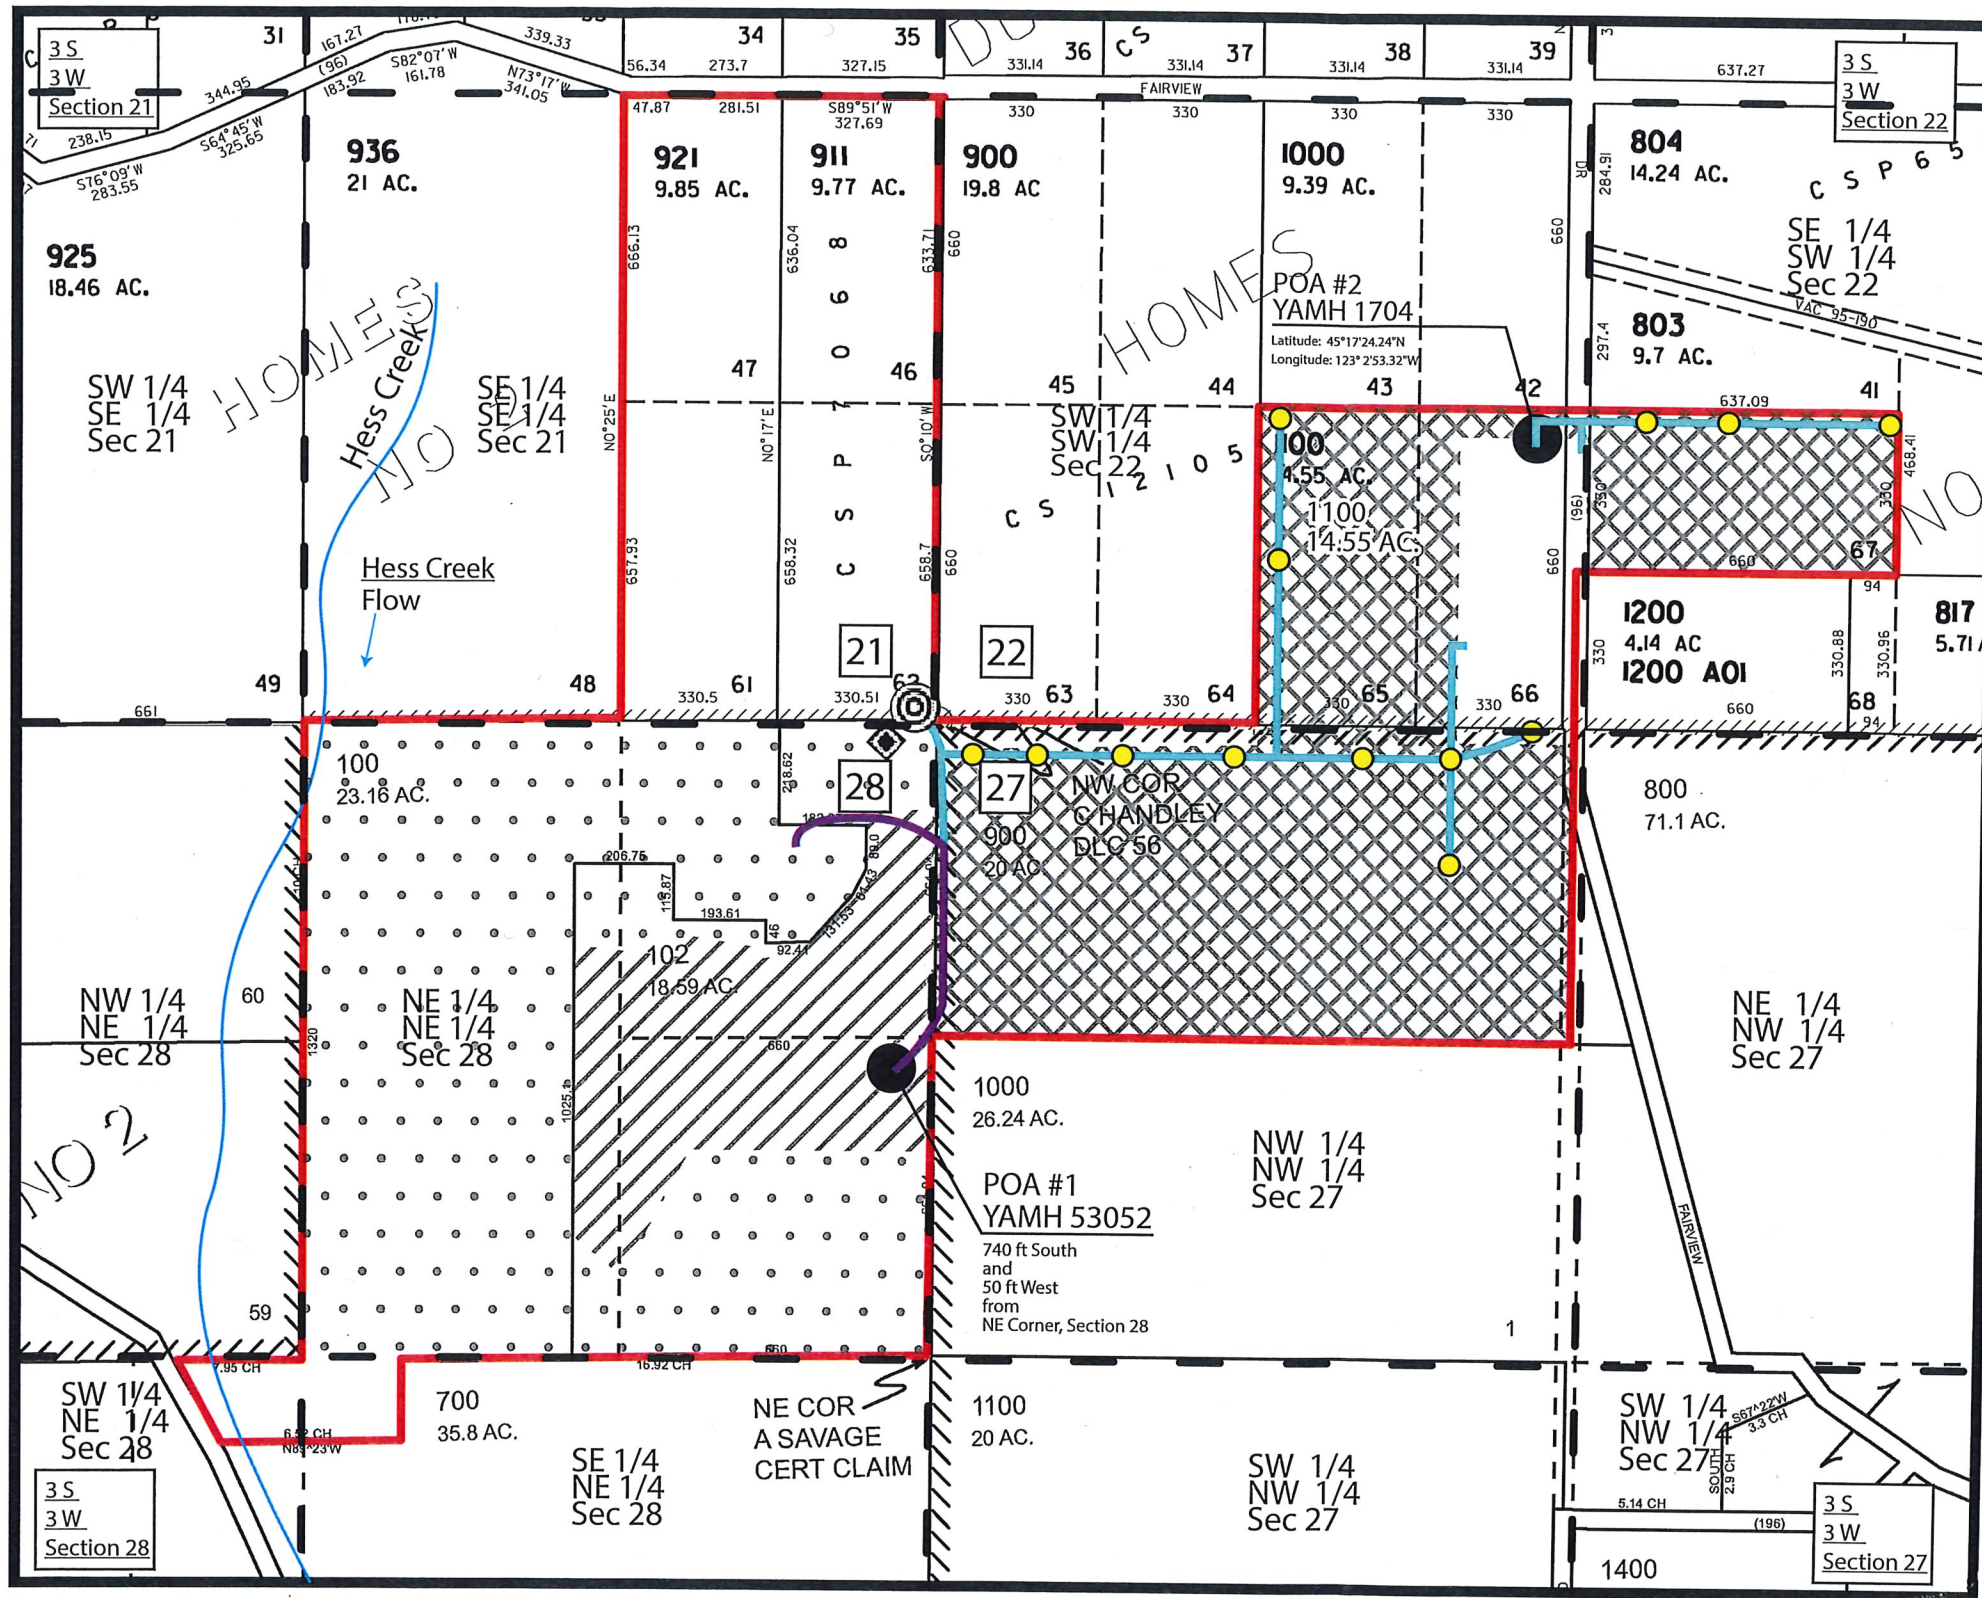

Legend

- Property Line
- Original Place of Use Area for Permit G15571 (40 acres)
- Unchanged Place of Use Area for Permit G15571 (9.1 acres)
- Proposed Change to Place of Use Area for Permit G15571 (30.9 acres)
- YAMH 53052 Existing Point of Appropriation
- YAMH 1704 Proposed Additional Point of Appropriation
- 1.5" Water Distribution Line
- Existing Water and Power Lines to Well
- Fire Hydrant with 3" Cam Lock Fitting
- Pressure Reducer Valve with Spigot
- Water Tank

<u>New Place of Use</u>	<u>Acerage</u>
T3S, R3W, 22, SE 1/4, SW 1/4	5
T3S, R3W, 22, SW 1/4, SW 1/4	6.7
T3S, R3W, 27, NW 1/4, NW 1/4	19.2
Total:	30.9 AC
<u>Unchanged Place of Use</u>	<u>Acerage</u>
T3S, R3W, 28, NE 1/4, NE 1/4	9.1
Total:	9.1 AC

ROGER N. SMITH ASSOCIATES, INC.
Groundwater and Environmental Consultants

Project Manager Roger Smith	Permit Amendment Application Map	
Adapted from Yamhill County Assessment and Tax Cartography Maps by Darin Frisone		
Project Number 19-1122	9600 NE Worden Hill Rd Dundee, OR 97115	Scale: 1" = 400'
Date Last Modified April 3, 2019		

RECEIVED
AUG 16 2019

OWRD
Revised