Permit Transfer Map
Application G-15936
Permit G-15670
April 11, 2019

SE 1/4 OF NE 1/4 OF SECTION 27
NE 1/4 OF SE 1/4 OF SECTION 27
NW 1/4 OF SW 1/4 OF SECTION 26
T1S, R4E of the WM
CLACKAMAS COUNTY, OREGON

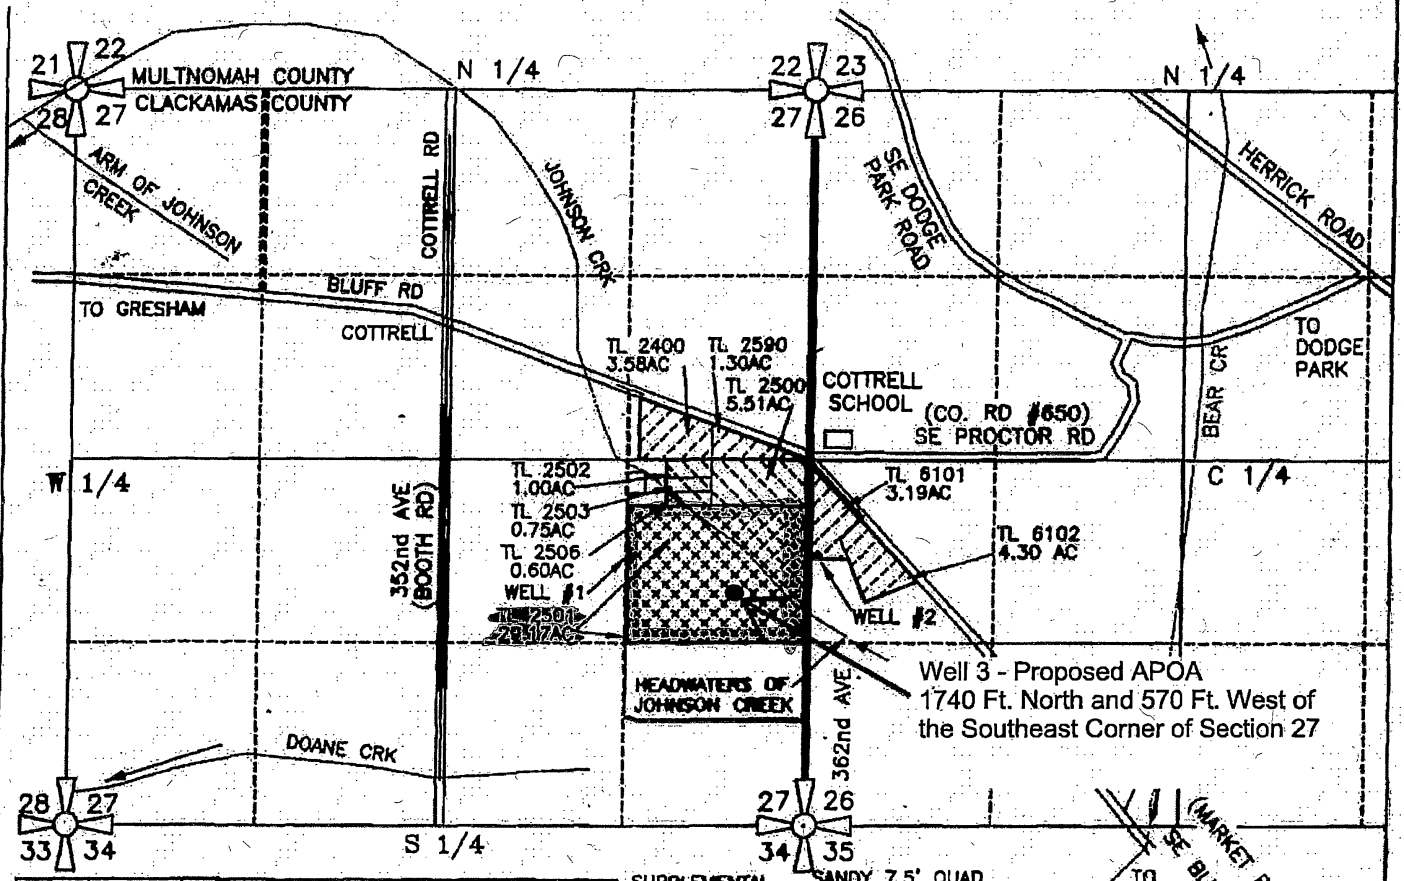

SEC.	1/4 1/4	ACRES IRRIG.	CFS (APPROX. GPM)
27	SE NE	CAN YARDS 4.45 ACRES	(● 1/40 CFS AC) 0.1113 CFS (50 GPM)
27	NE SE	CAN YARDS 6.25 ACRES	(● 1/80 CFS AC) 0.1563 CFS (70 GPM)
27	NE SE	SUPPLEMENTAL [29.17 ACRES]	[(● 1/80 CFS AC)] [0.365 CFS (164 GPM)]
26	NW SW	CAN YARDS 6.70 ACRES	(● 1/40 CFS AC) 0.1675 CFS (75 GPM)
TOTAL		17.40 ACRES	0.4350 CFS (195 GPM)

SUPPLEMENTAL ON THIS APPL.

APPL. G-13065
PERMIT G-11978
(0.365CFS, 29.17AC)

SANDY 7.5' QUAD
ASSESSOR MAP 14E26 & 27

WELL #1 IS LOCATED 690' SOUTH & 1350' EAST OF THE CENTER 1/4 CORNER OF SECTION 27
WELL #2 IS LOCATED 685' SOUTH & 65' EAST OF THE WEST 1/4 CORNER OF SECTION 26
TOWNSHIP 1 SOUTH, RANGE 4 EAST OF WILLAMETTE MERIDIAN, CLACKAMAS COUNTY, STATE OF OREGON

Certified Water Rights Examiner
#71101
Robert E. Long Jr.
May 15, 2002
STATE OF OREGON

EXPIRATION DATE: 12-31-2020

N
SCALE 1"=1320'

PREPARATION OF THIS MAP WAS FOR THE PURPOSE OF IDENTIFYING THE LOCATION OF THE WATER RIGHTS ONLY AND HAS NO INTENT TO PROVIDE DIMENSIONS OR LOCATION OF PROPERTY OWNERSHIP LINES.

GROUNDWATER PERMIT AMENDMENT
GROUNDWATER PERMIT G-___

Received by OWRD
APR 11 2019
Salem, OR

CwM H2O, LLC
1319 SE MLK Jr. Blvd. Suite 204
Portland, Oregon 97219
(503) 954-1326

APPLICATION FOR PERMIT NUMBER G-15936
PERMIT NUMBER G-___ IN THE NAME OF:

SHEET 1/1