


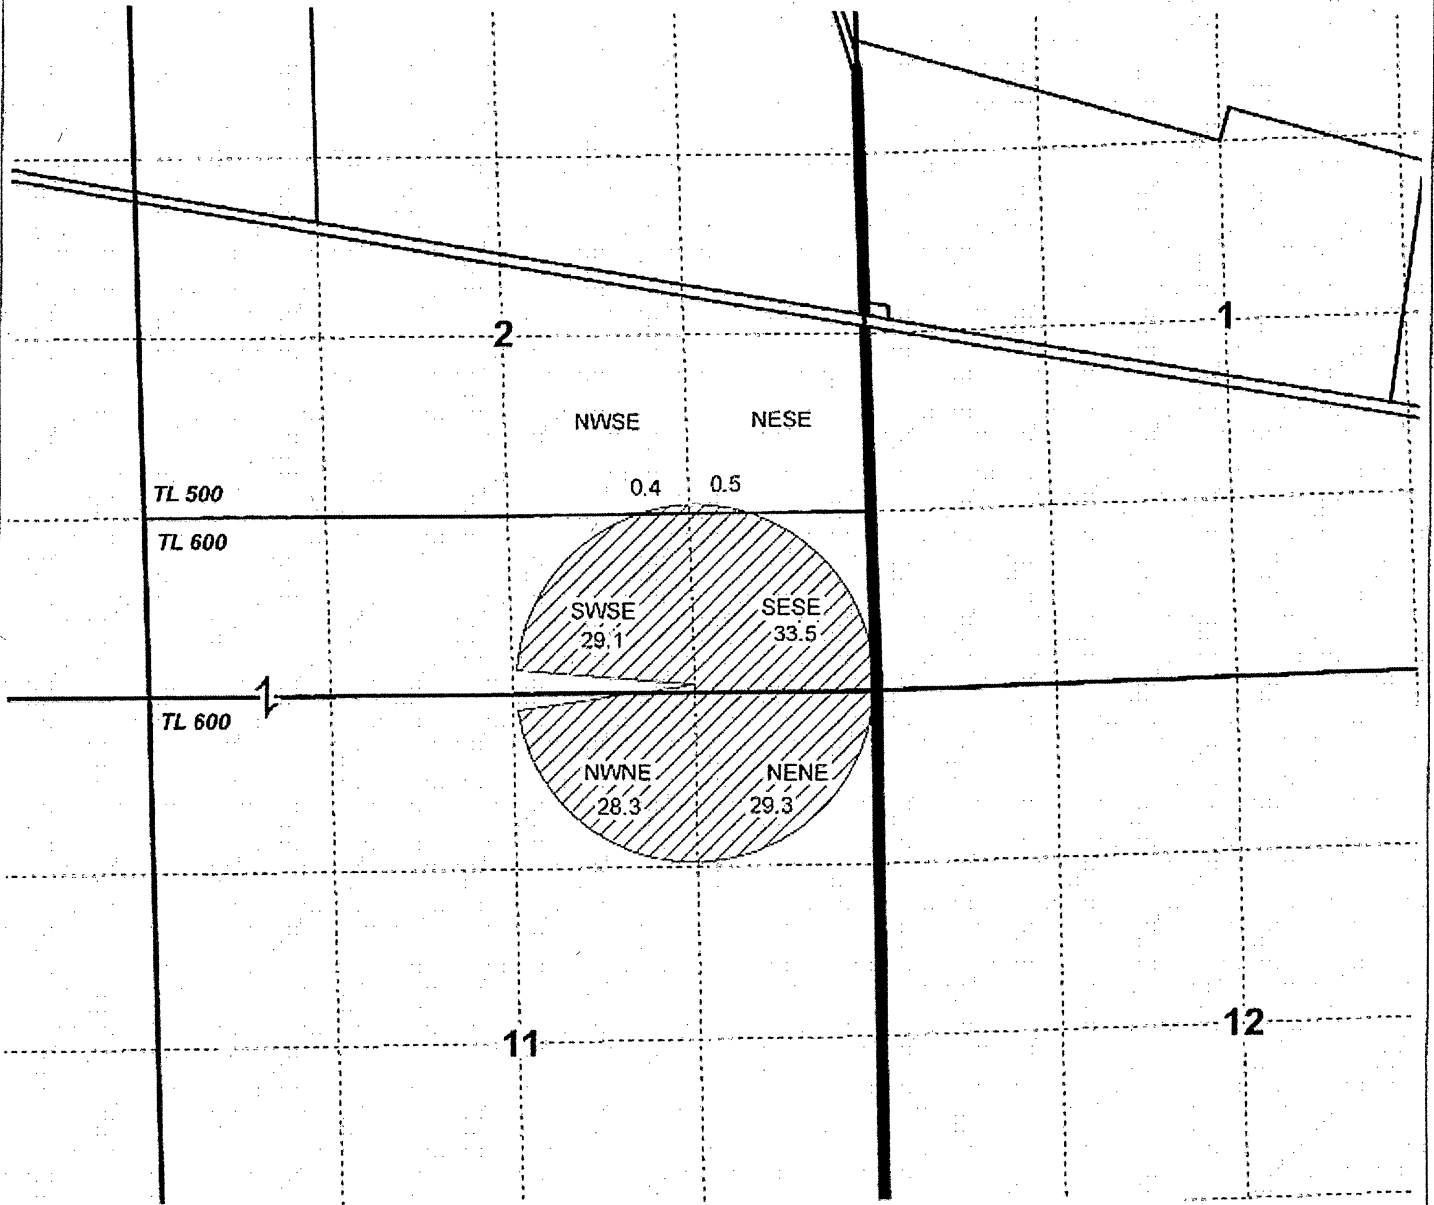

0 1,320 Feet

1" = 1,320'

T15S R40E, WM MALHEUR COUNTY, OREGON




Proposed [redacted] of Cert 18, 20

same as original app from 5/29/15

Section

Quarter Quarter

Tax Lot

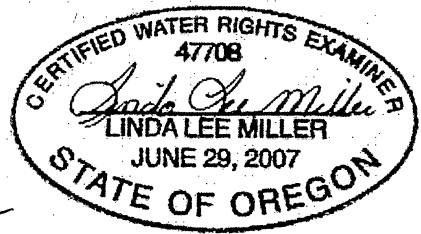

RENEWAL DATE 12/31/2018

**COW VALLEY RANCH
TRANSFER MAP**

This map is not intended to provide legal dimensions or locations of property ownership lines.

Date: 10/5/2018

WATER RIGHT SERVICES, LLC

PO BOX 1830, BEND, OR 97709

CCB# 197121 www.oregonwater.us

541-389-2837 JOHNSHORT@USA.COM




0 1,320 Feet

1" = 1,320'

T15S R40E, WM

MALHEUR COUNTY, OREGON

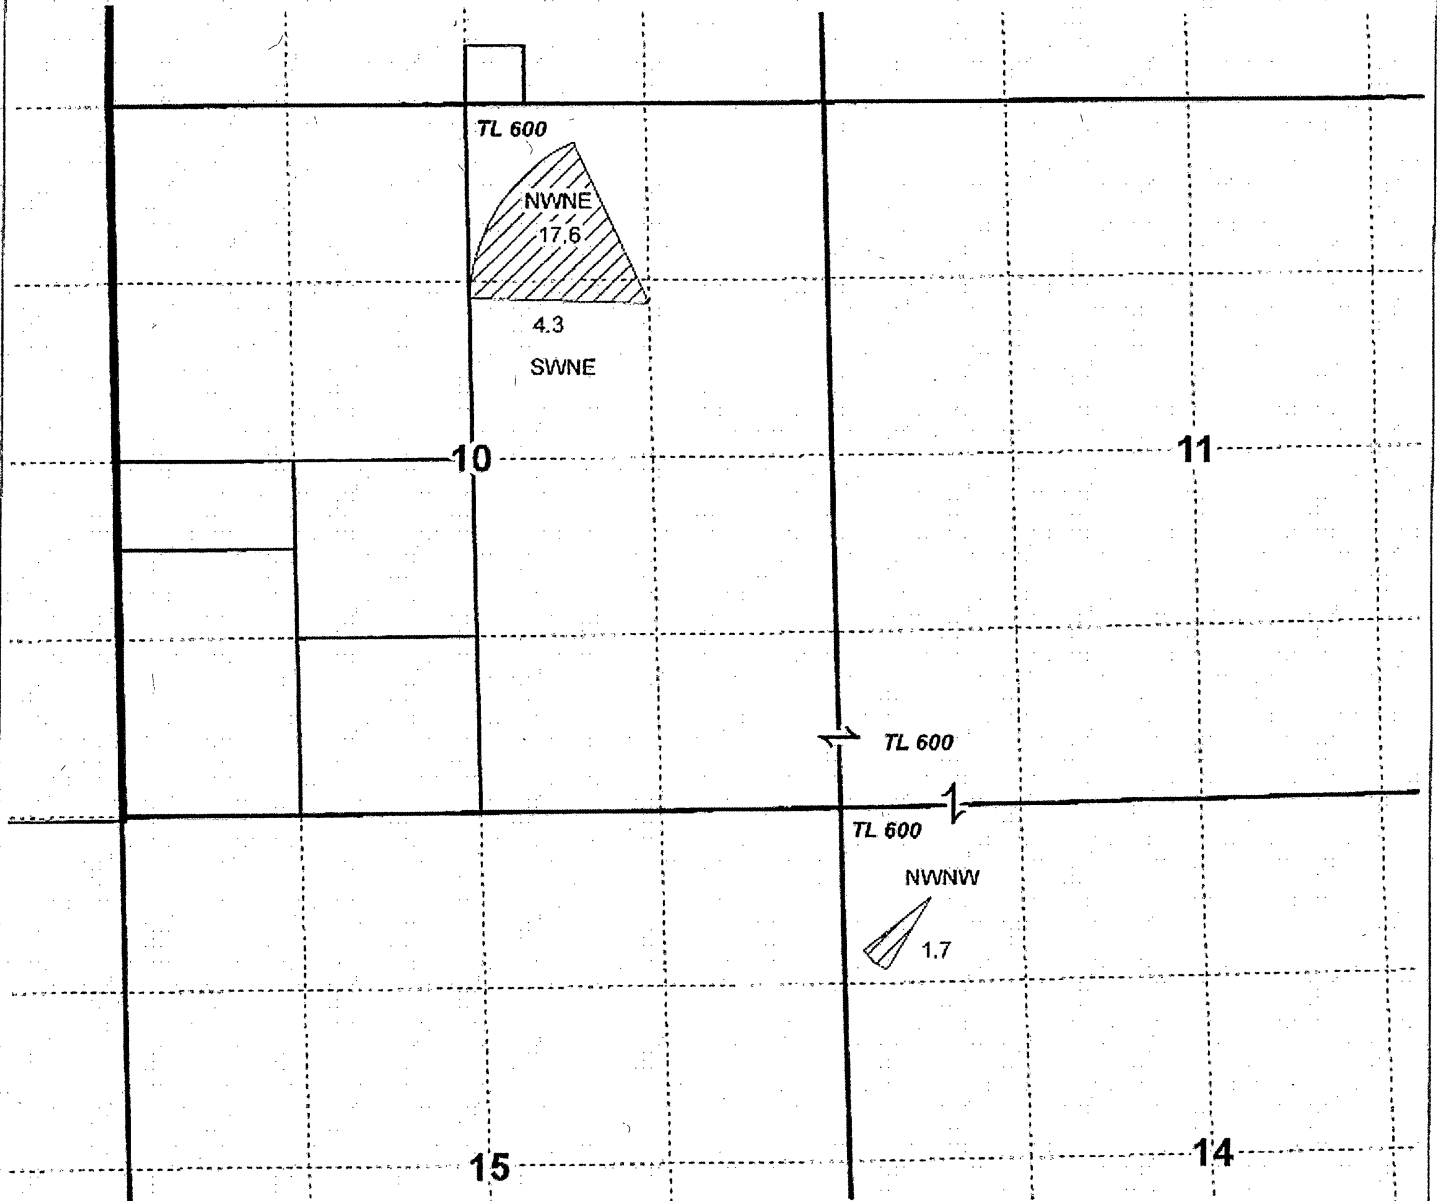

~~Proposed EOU for Car 2009~~



Section




Quarter Quarter



Tax Lot

same as original app from 5/29/15

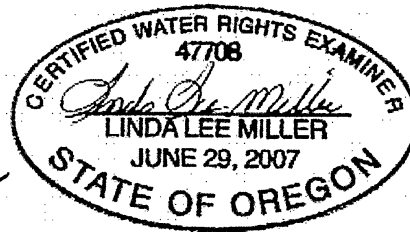

RENEWAL DATE 12/31/2018

COW VALLEY RANCH TRANSFER MAP

This map is not intended to provide legal dimensions or locations of property ownership lines.

Date: 10/5/2018

WATER RIGHT SERVICES, LLC

PO BOX 1830, BEND, OR 97709


CCB# 197121 www.oregonwater.us

541-389-2837 JOHNSHORT@USA.COM



0 1,320 Feet
1" = 1,320'

T15S R40E, WM
MALHEUR COUNTY, OREGON

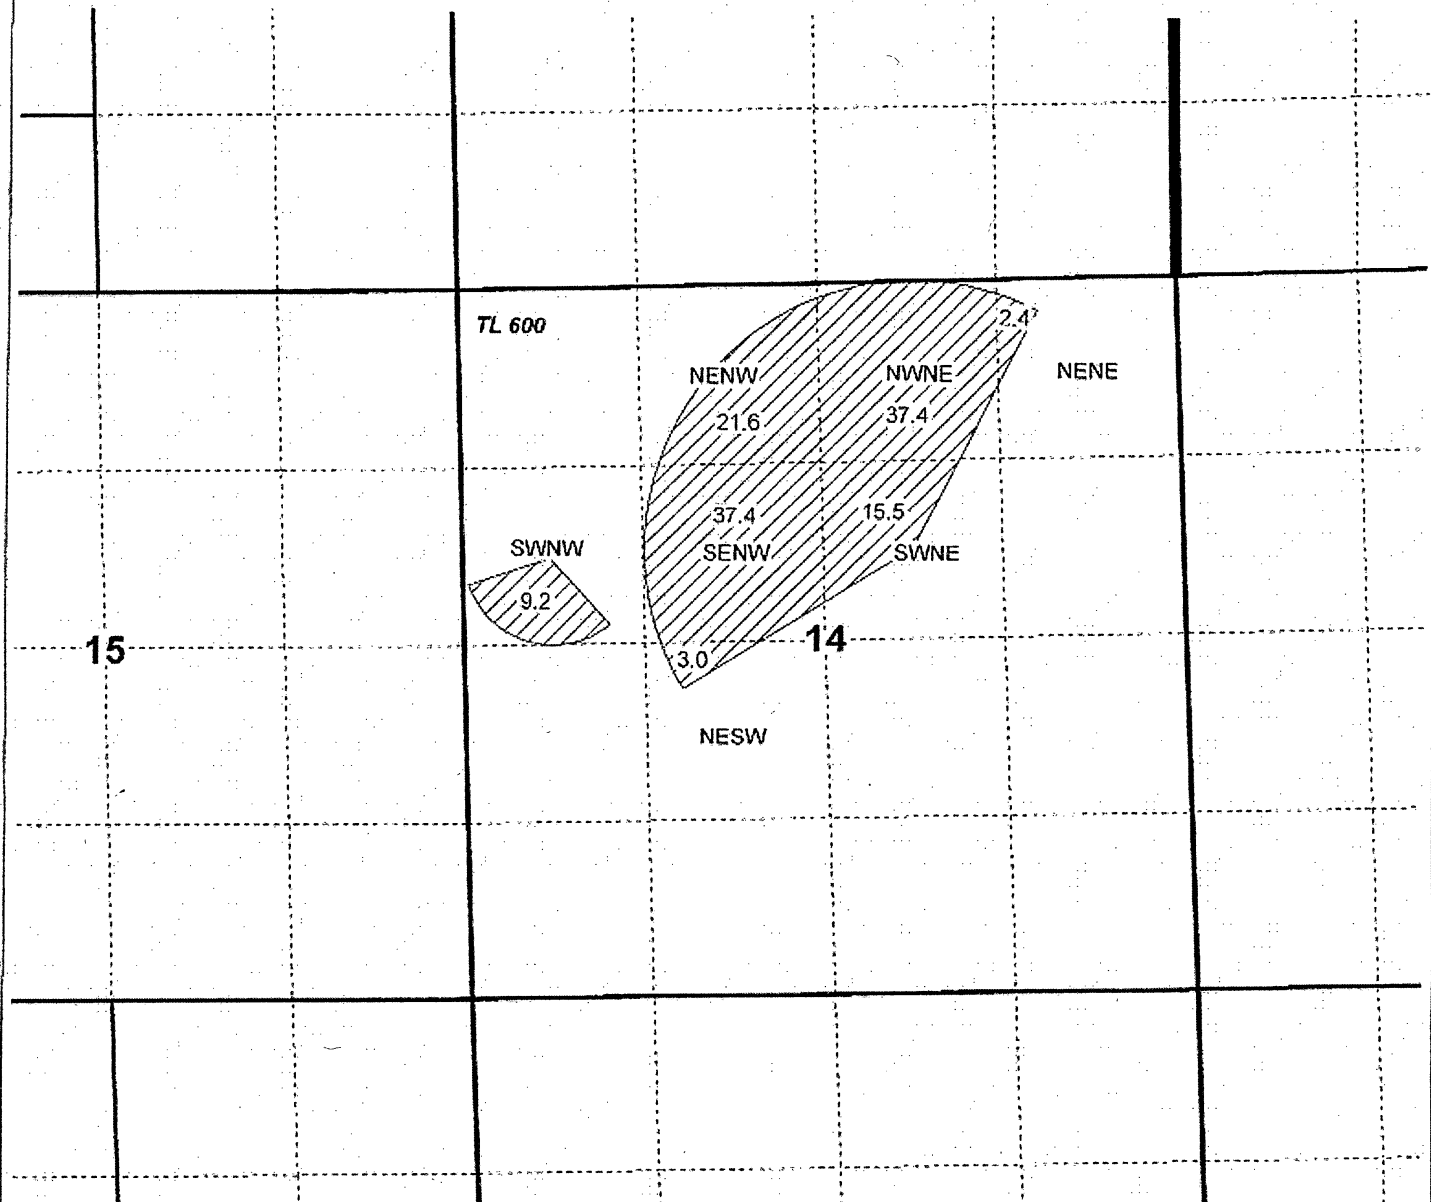

Proposed POU for Cert 81211

differs from



Section



Quarter Quarter



Tax Lot

*5/29/15 original
updated Table 2 provided
by agent*



RENEWAL DATE 12/31/2018

**COW VALLEY RANCH
TRANSFER MAP**

This map is not intended
to provide legal dimensions
or locations of property
ownership lines.

Date: 10/1/2018

WATER RIGHT SERVICES, LLC

PO BOX 1830, BEND, OR 97709


CCB# 197121 www.oregonwater.us



 
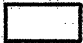
541-389-2837 JOHNSHORT@USA.COM




0 1,320 Feet
1" = 1,320'

T15S R40E, WM
MALHEUR COUNTY, OREGON

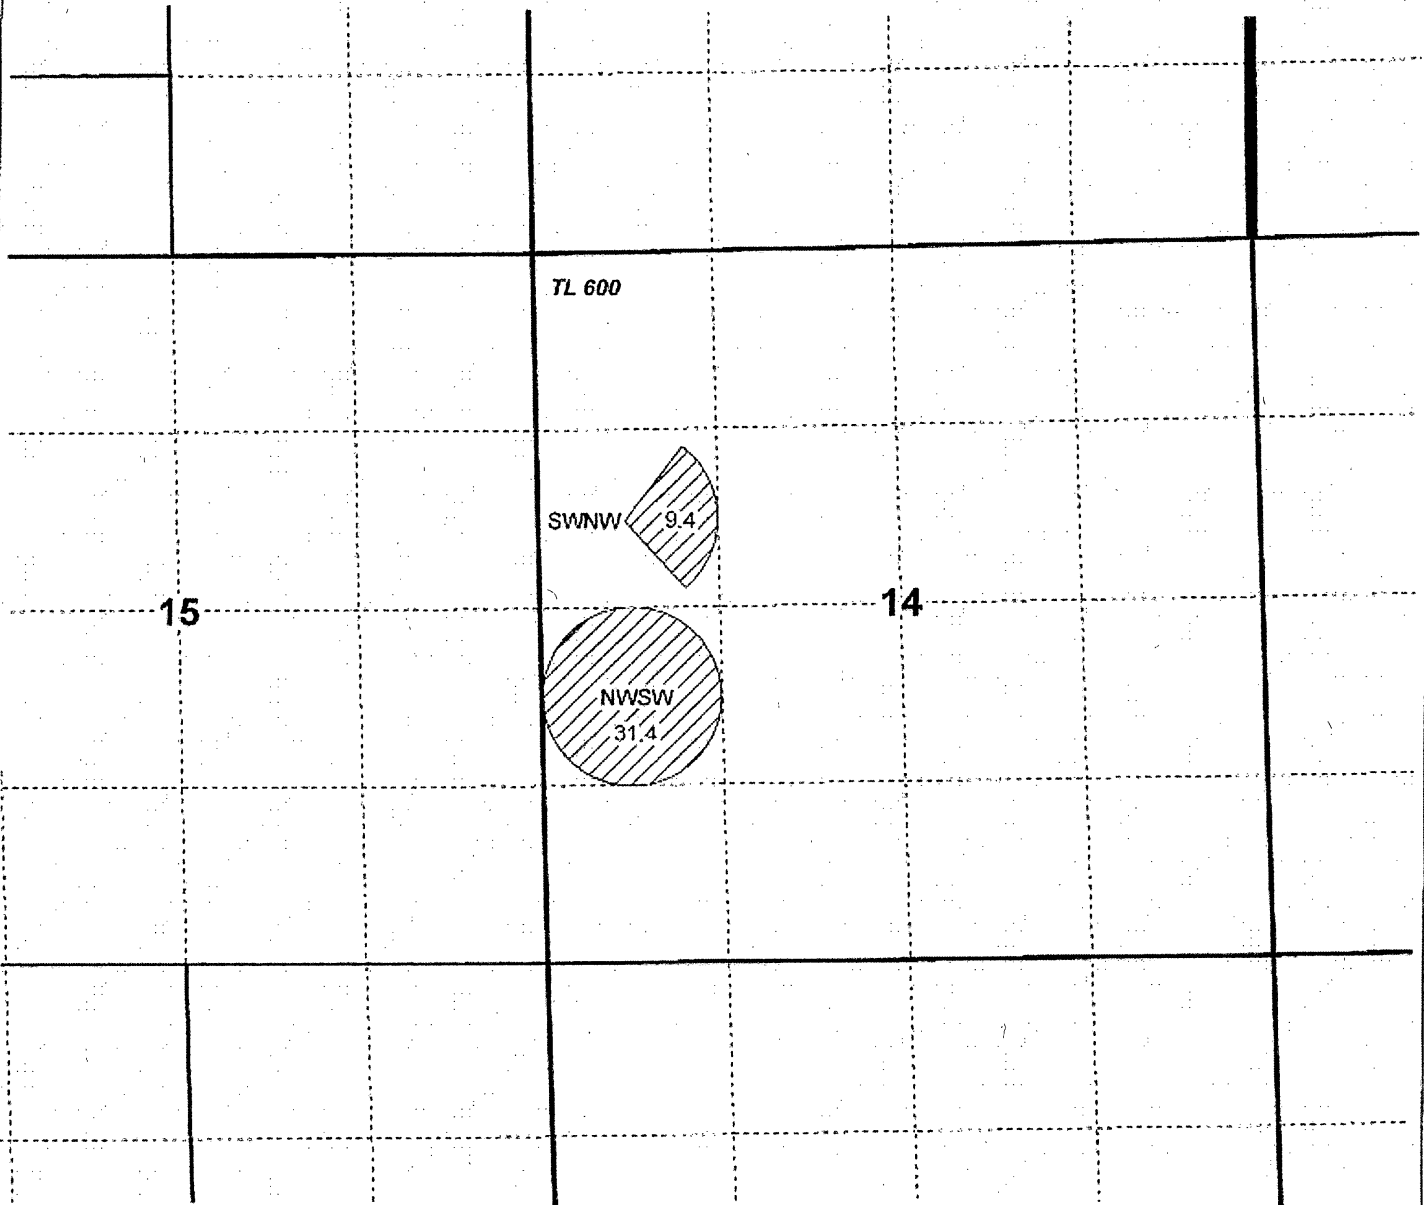

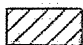-  Proposed ~~_____~~
-  Section
-  Quarter Quarter
-  Tax Lot

Same as original from 5/29/15

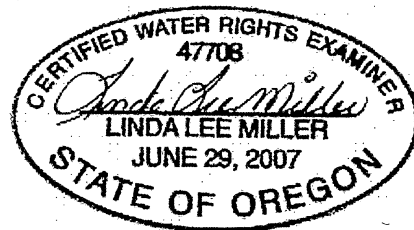

RENEWAL DATE 12/31/2018

**COW VALLEY RANCH
TRANSFER MAP**

This map is not intended to provide legal dimensions or locations of property ownership lines.

Date: 10/5/2018

WATER RIGHT SERVICES, LLC

PO BOX 1830, BEND, OR 97709


CCB# 197121 www.oregonwater.us





541-389-2837 JOHNSHORT@USA.COM




0 1,320 Feet
1" = 1,320'

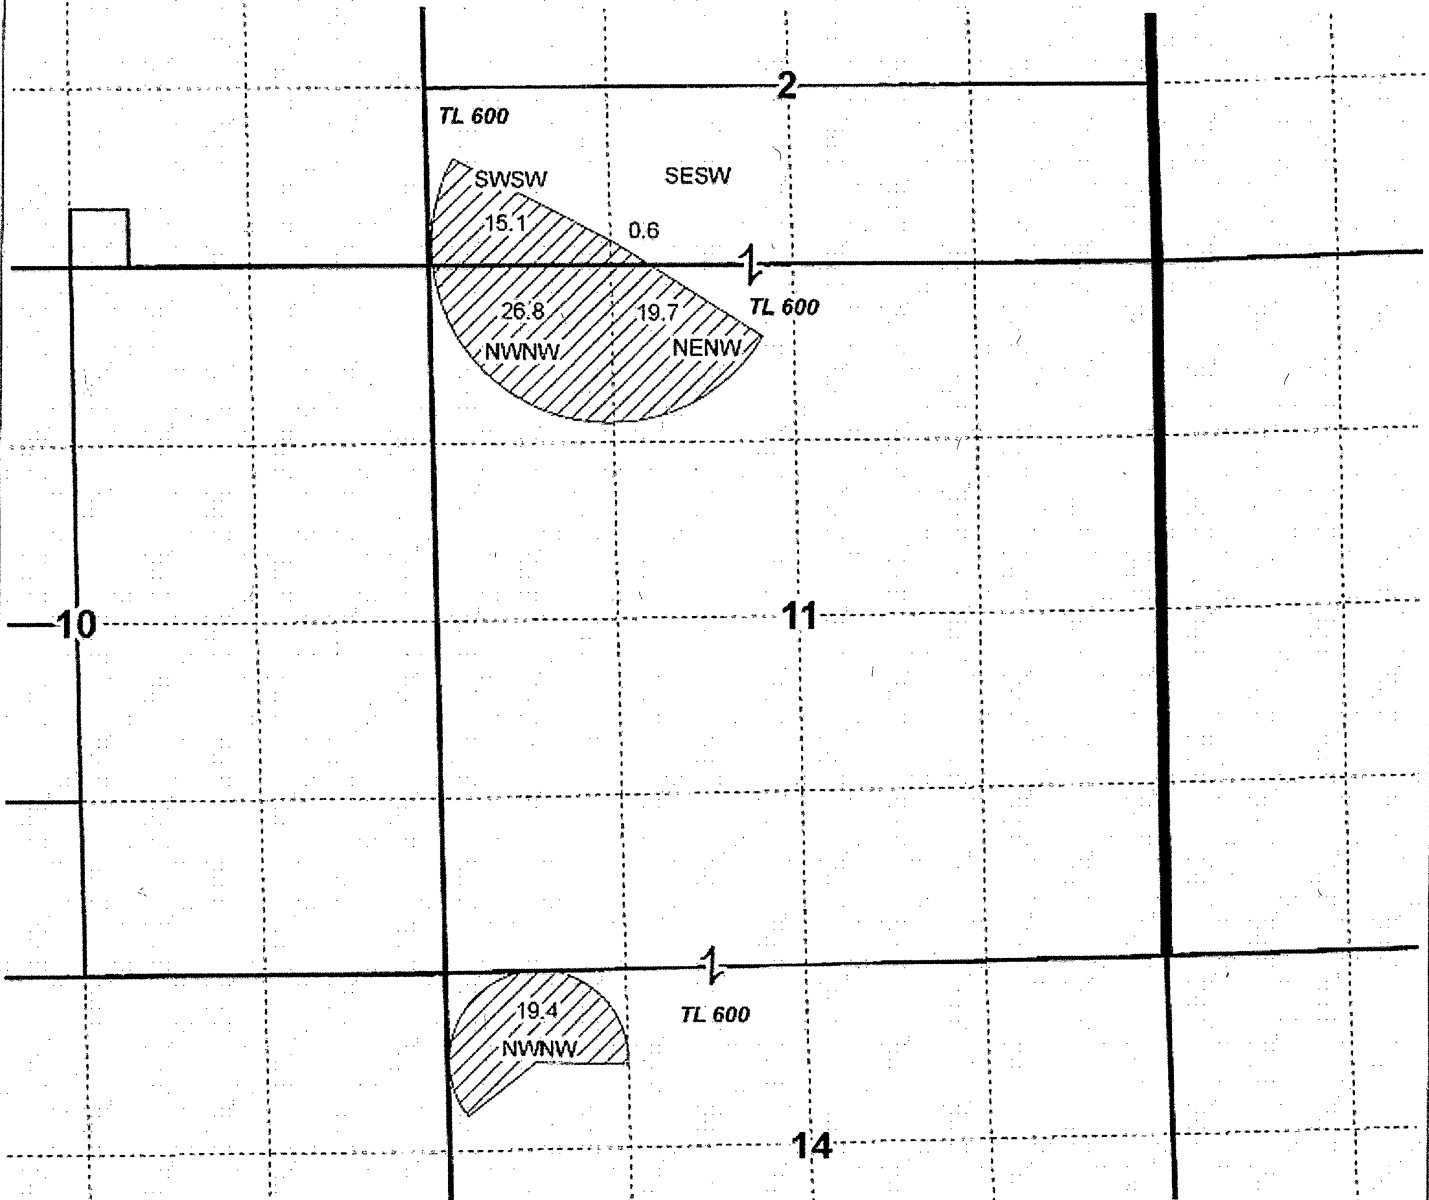T15S R40E, WM
MALHEUR COUNTY, OREGON

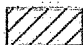

-  Proposed ~~2017 Cert 3/213~~
-  Section
-  Quarter Quarter
-  Tax Lot

Same as original from 5/29/15

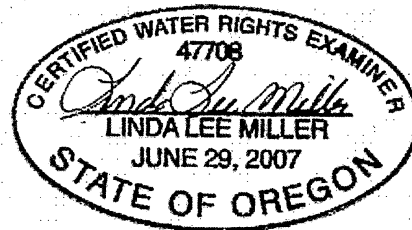

RENEWAL DATE 12/31/2018

**COW VALLEY RANCH
TRANSFER MAP**

This map is not intended to provide legal dimensions or locations of property ownership lines.

Date: 10/6/2018

WATER RIGHT SERVICES, LLC

PO BOX 1830, BEND, OR 97709

CCB# 197121 www.oregonwater.us

541-389-2837 JOHNSHORT@USA.COM




0 1,320 Feet

1" = 1,320'

T15S R40E, WM

MALHEUR COUNTY, OREGON

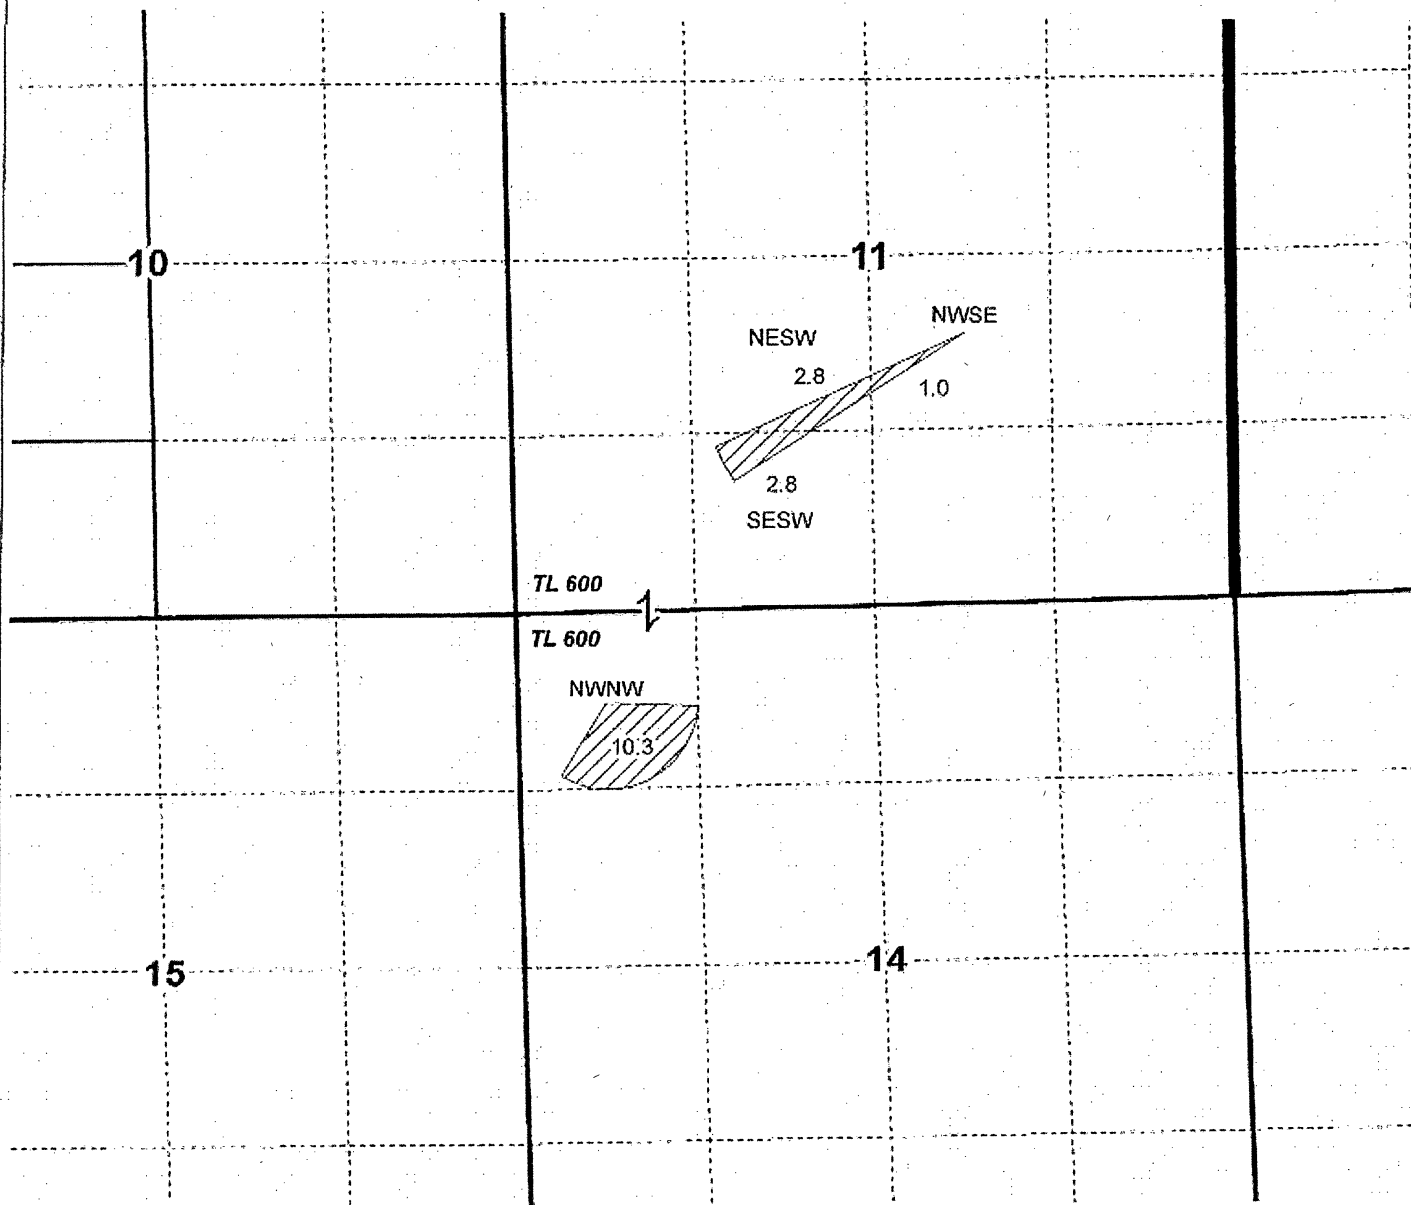

Proposed ~~BOC for Cert 199173~~



Section



Quarter Quarter



Tax Lot

differ from original 512915 updated table 2 received



RENEWAL DATE 12/31/2018

**COW VALLEY RANCH
TRANSFER MAP**

This map is not intended to provide legal dimensions or locations of property ownership lines.

Date: 10/5/2018

WATER RIGHT SERVICES, LLC

PO BOX 1830, BEND, OR 97709

CCB# 197121 www.oregonwater.us

541-389-2837 JOHNSHORT@USA.COM




0 1,320 Feet


1" = 1,320'

T15S R41E, WM

MALHEUR COUNTY, OREGON

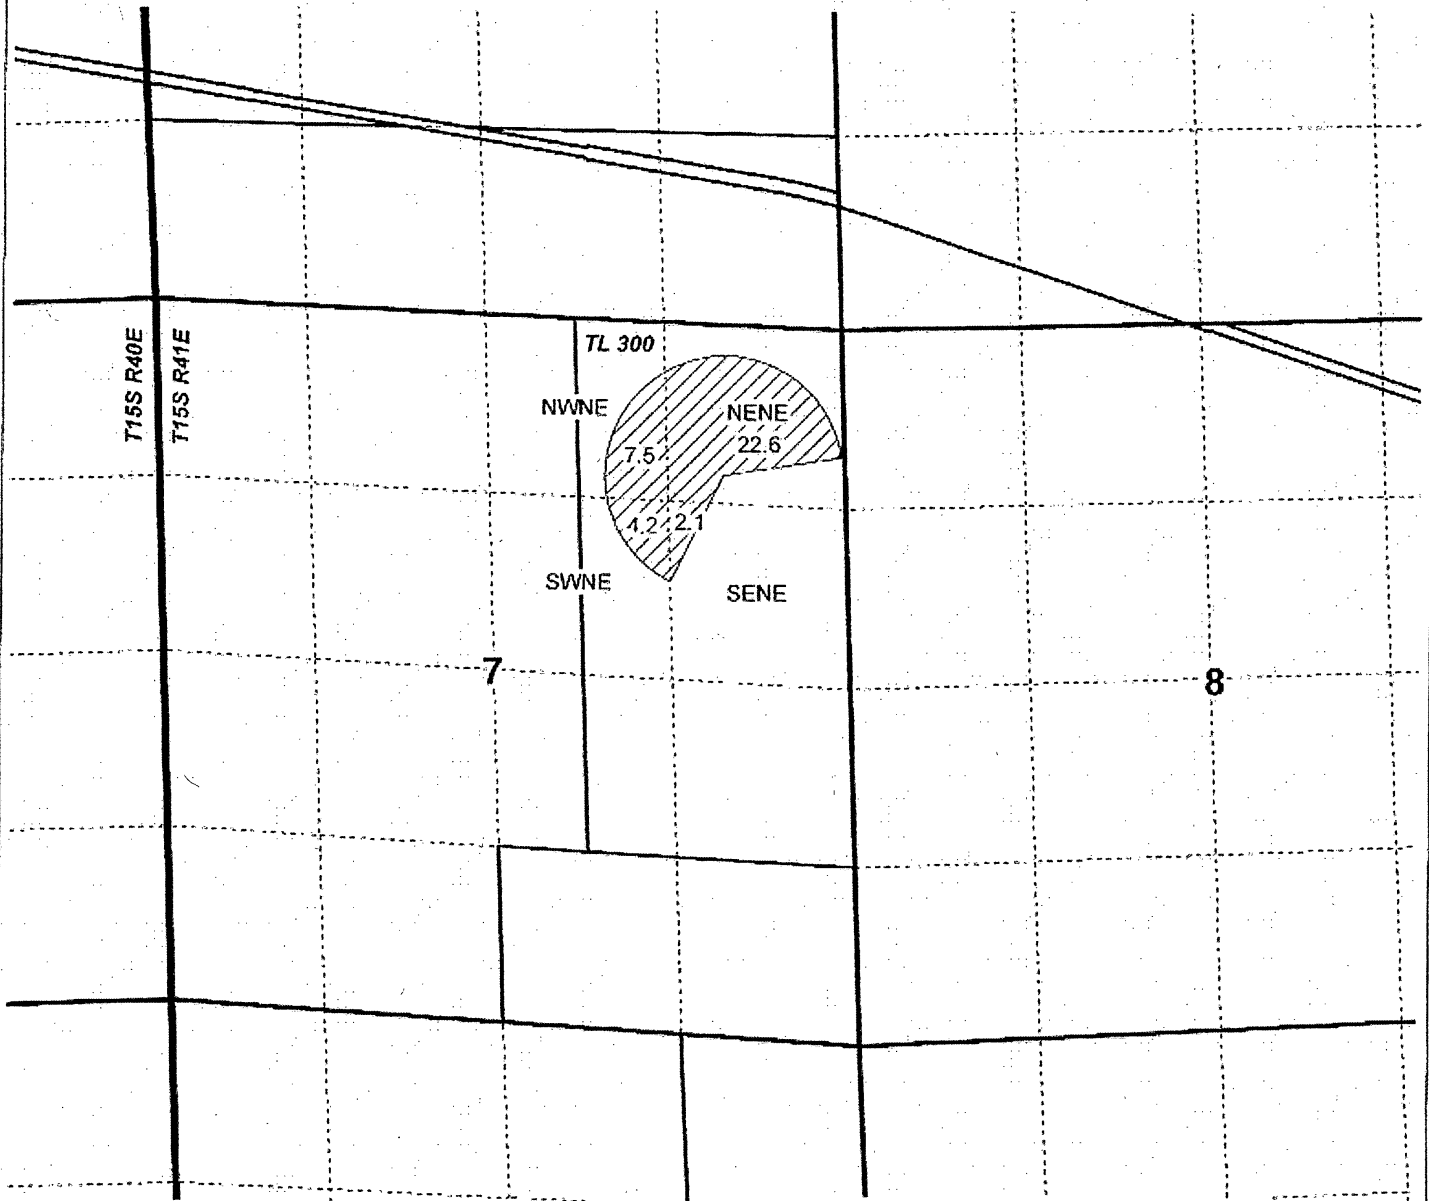


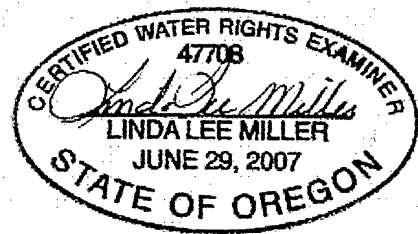
 Proposed ~~POU for Cert. 89177 Page 1 of 2~~

 Township

 Section

 Quarter Quarter

 Tax Lot



RENEWAL DATE 12/31/2018

**COW VALLEY RANCH
TRANSFER MAP**

This map is not intended to provide legal dimensions or locations of property ownership lines.

Date: 10/5/2018

WATER RIGHT SERVICES, LLC

PO BOX 1830, BEND, OR 97709

CCB# 197121 www.oregonwater.us

541-389-2837 JOHNSHORT@USA.COM




0 1,320 Feet

1" = 1,320'

T15S R40E, WM


MALHEUR COUNTY, OREGON


TL 600

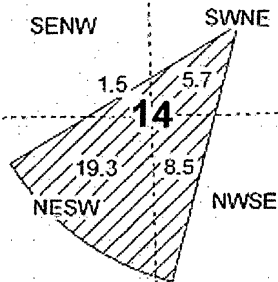


13

 Proposed POU for ~~Cert 89177 Page 2 of 2~~

 Section

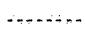 Quarter Quarter

 Tax Lot



RENEWAL DATE 12/31/2018

COW VALLEY RANCH TRANSFER MAP

This map is not intended
to provide legal dimensions
or locations of property
ownership lines.

Date: 10/5/2018

WATER RIGHT SERVICES, LLC

PO BOX 1830, BEND, OR 97709

CCB# 197121 www.oregonwater.us

541-389-2837 JOHNSHORT@USA.COM




0 1,320 Feet

1" = 1,320'

T15S R40E, WM

MALHEUR COUNTY, OREGON

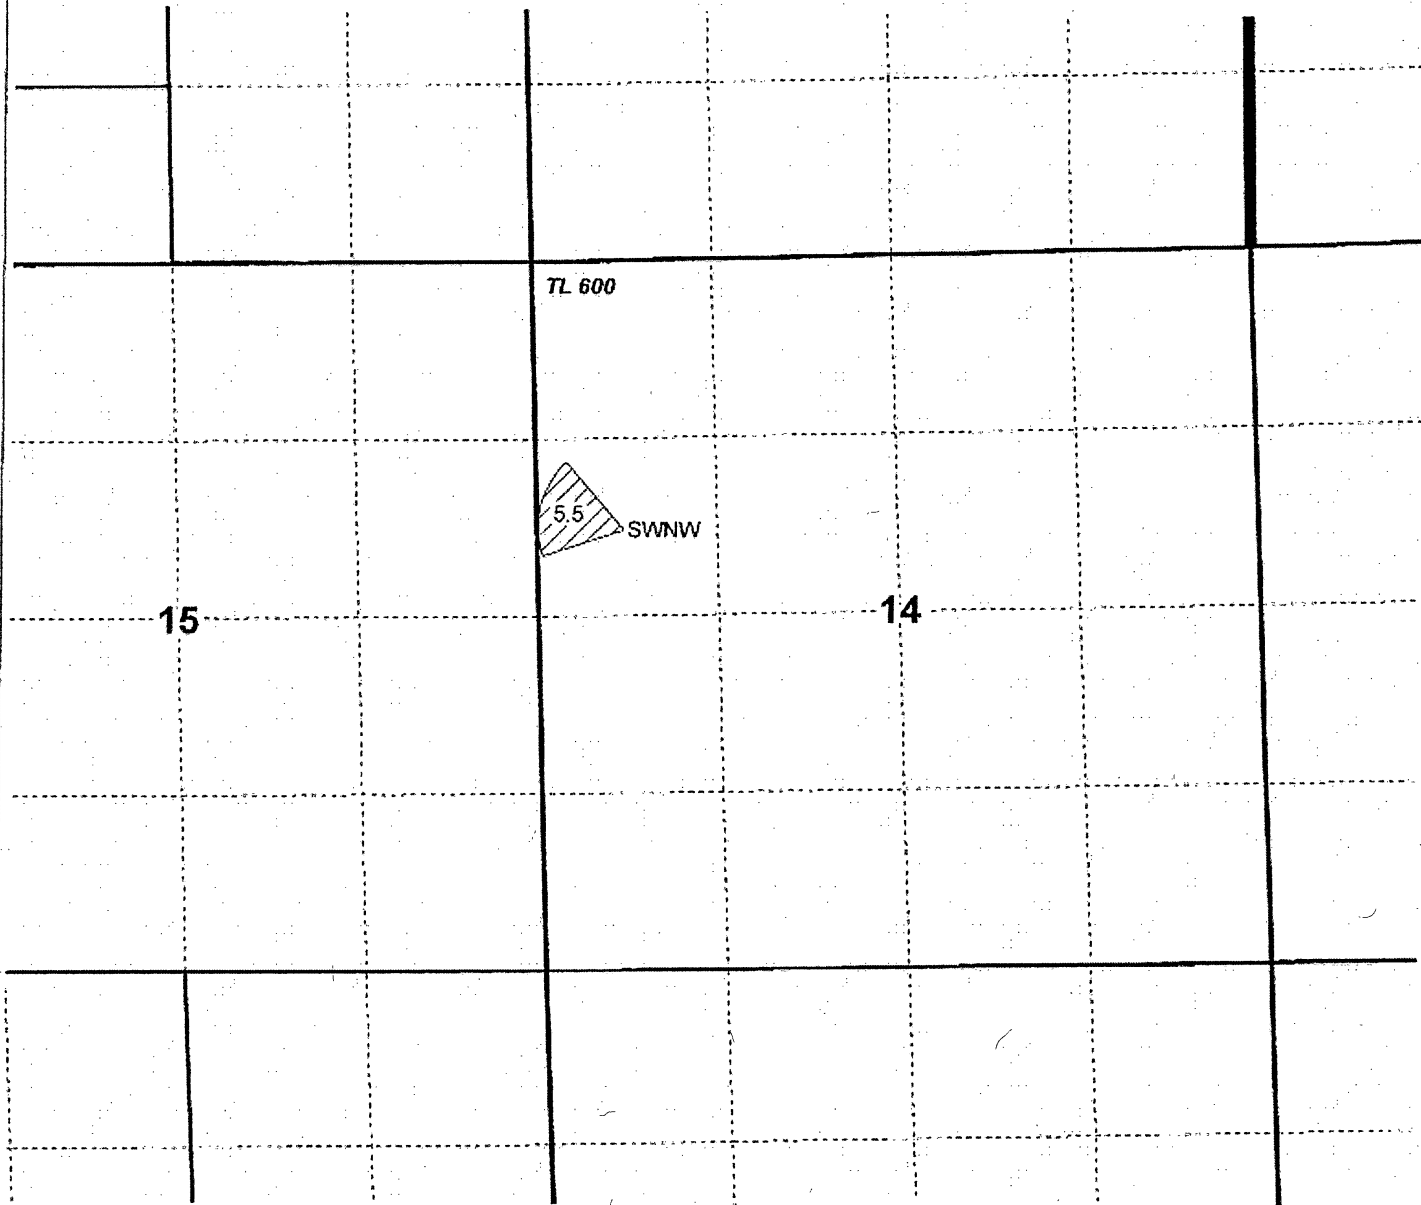


Proposed POU for Cert 89178

— Section

- - - Quarter Quarter

□ Tax Lot

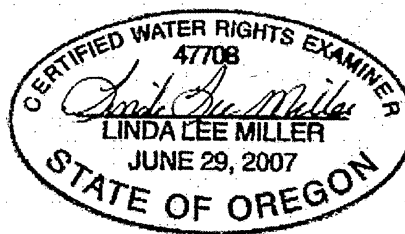

RENEWAL DATE 12/31/2018

COW VALLEY RANCH TRANSFER MAP

This map is not intended to provide legal dimensions or locations of property ownership lines.

Date: 10/5/2018

WATER RIGHT SERVICES, LLC

PO BOX 1830, BEND, OR 97709

CCB# 197121 www.oregonwater.us

541-389-2837 JOHNSHORT@USA.COM






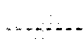
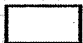
0 1,320 Feet


1" = 1,320'

T15S R40E, WM

MALHEUR COUNTY, OREGON

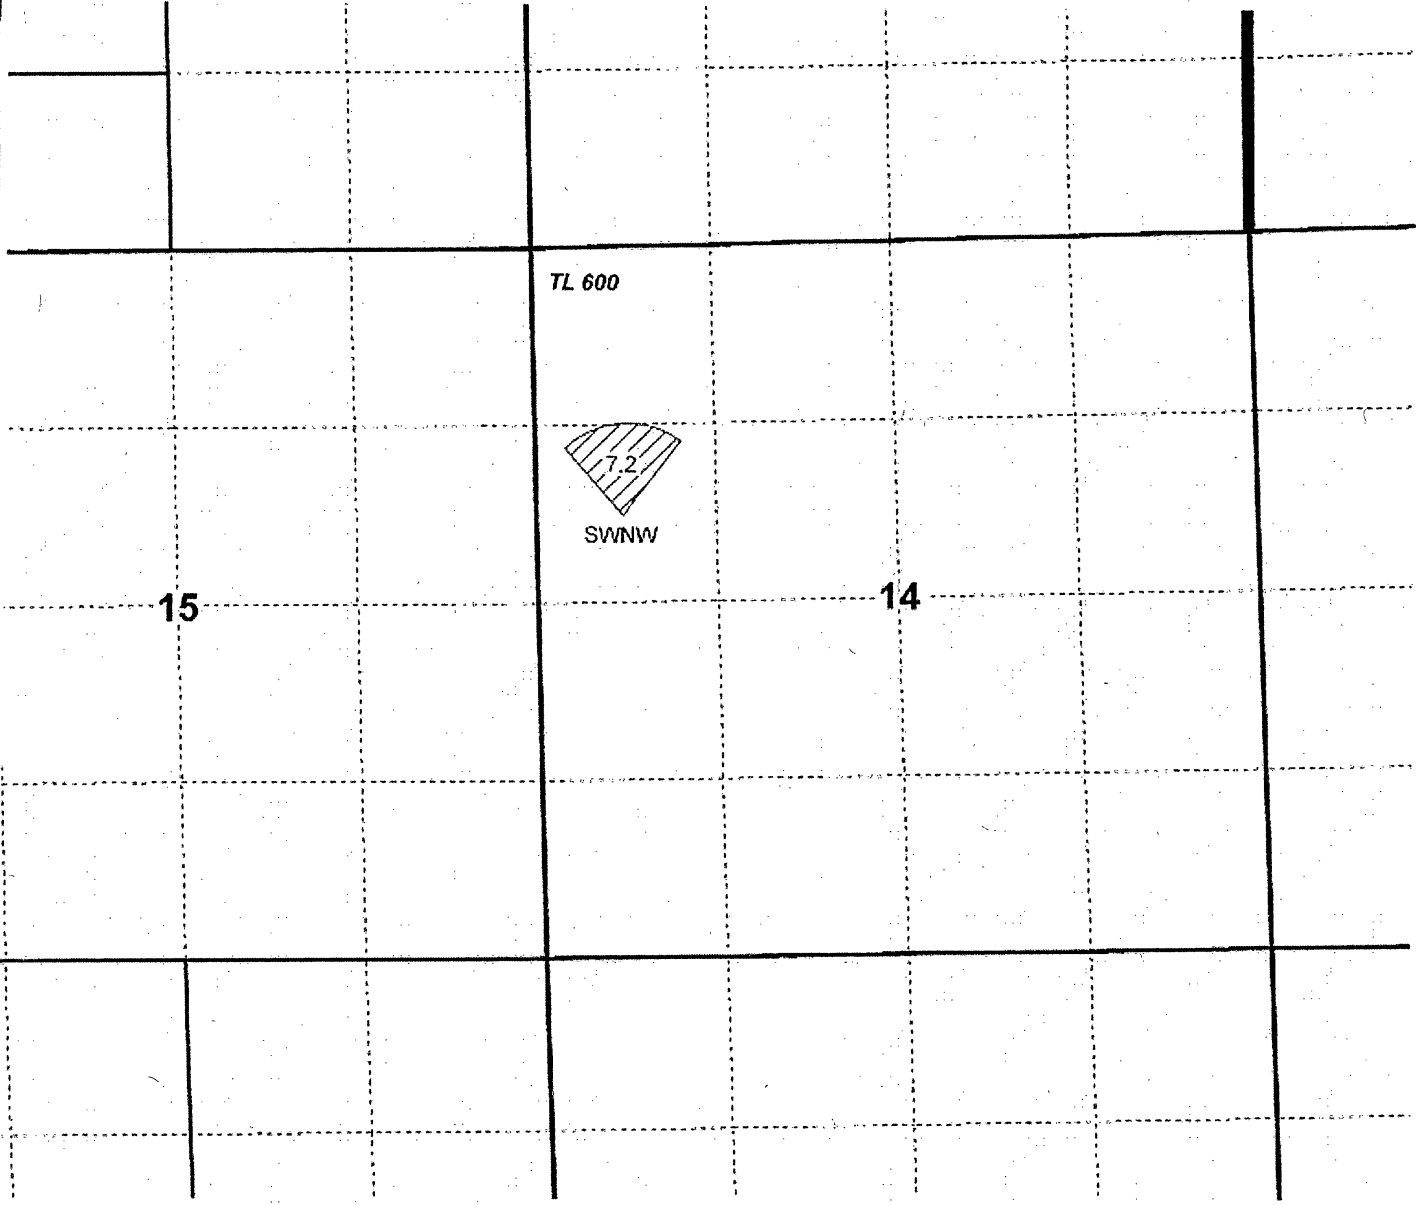

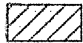-  Proposed POU for Cert 89179
-  Section
-  Quarter Quarter
-  Tax Lot

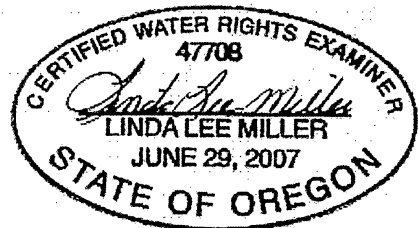

RENEWAL DATE 12/31/2018

COW VALLEY RANCH TRANSFER MAP

This map is not intended to provide legal dimensions or locations of property ownership lines.

Date: 10/5/2018

WATER RIGHT SERVICES, LLC
PO BOX 1830, BEND, OR 97709
CCB# 197121 www.oregonwater.us
541-389-2837 JOHNSHORT@USA.COM








0 1,320 Feet


1" = 1,320'

T15S R40E, WM

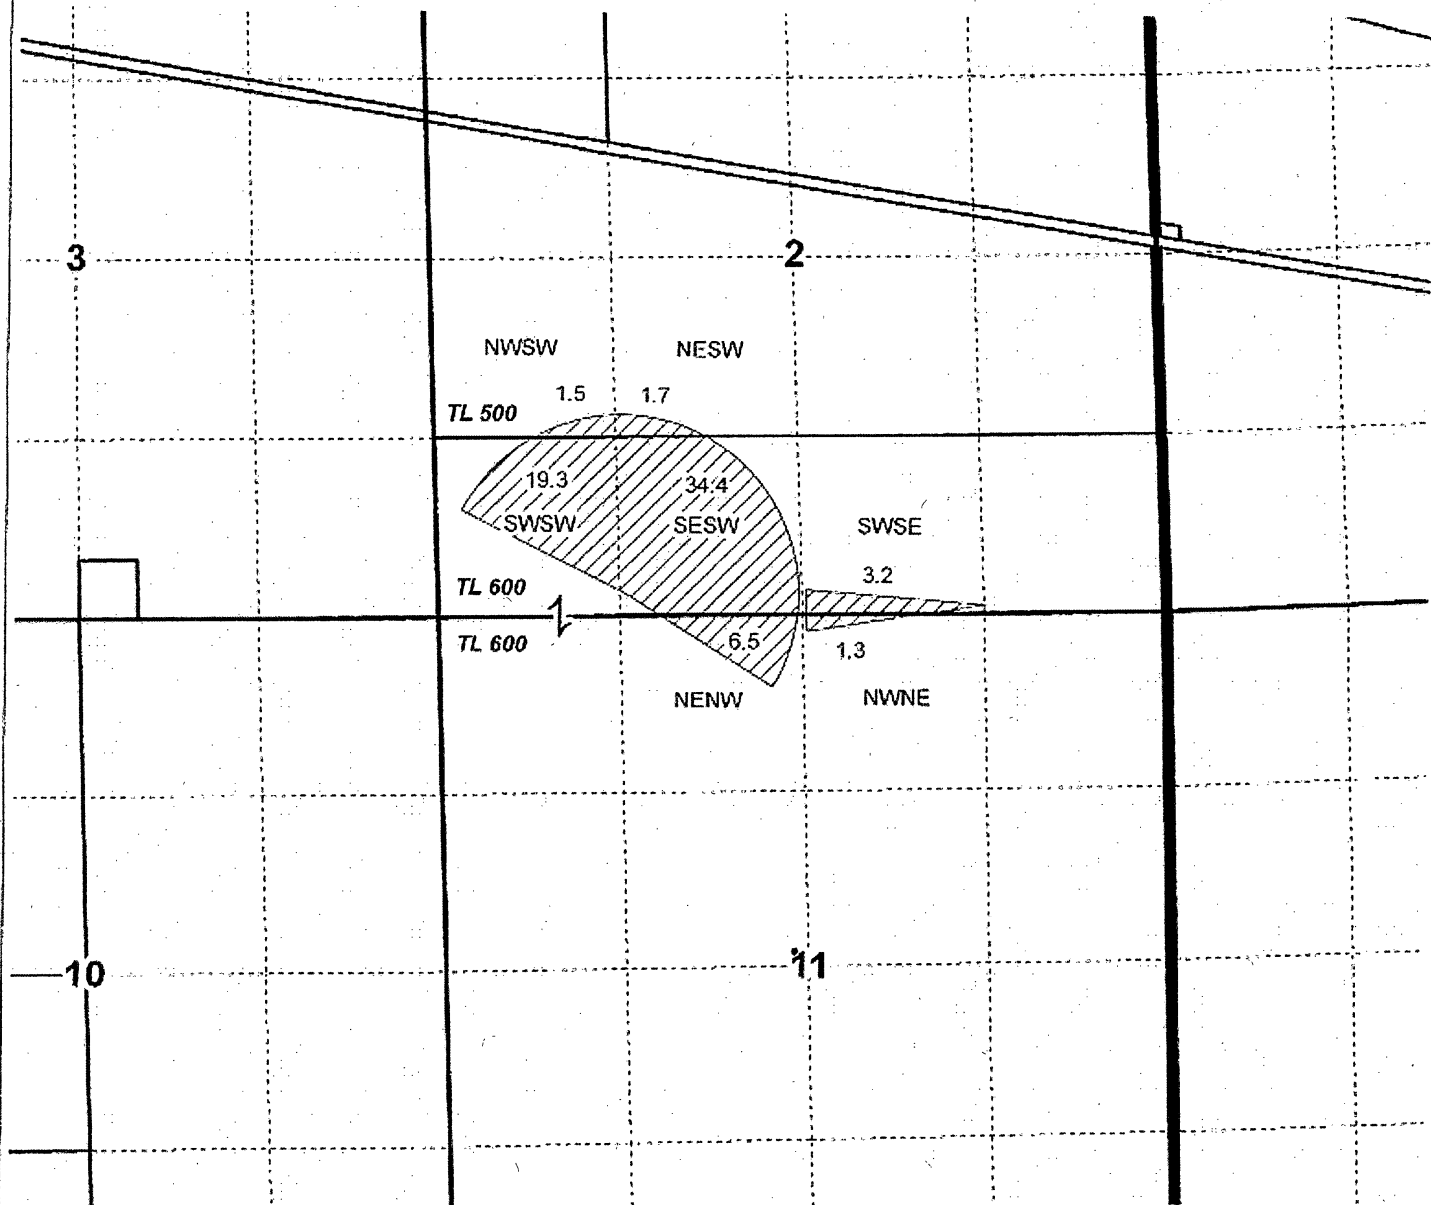MALHEUR COUNTY, OREGON

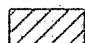

-  Proposed POU for Cert 89180
-  Section
-  Quarter Quarter
-  Tax Lot

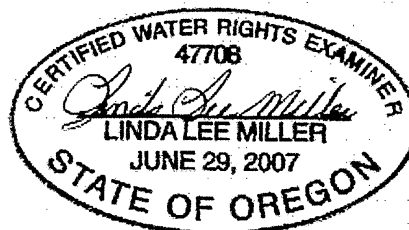

RENEWAL DATE 12/31/2018

COW VALLEY RANCH TRANSFER MAP

This map is not intended to provide legal dimensions or locations of property ownership lines.

Date: 10/5/2018

WATER RIGHT SERVICES, LLC

PO BOX 1830, BEND, OR 97709

CCB# 197121 www.oregonwater.us

541-389-2837 JOHNSHORT@USA.COM








0 1,320 Feet


1" = 1,320'

T15S R40E, WM

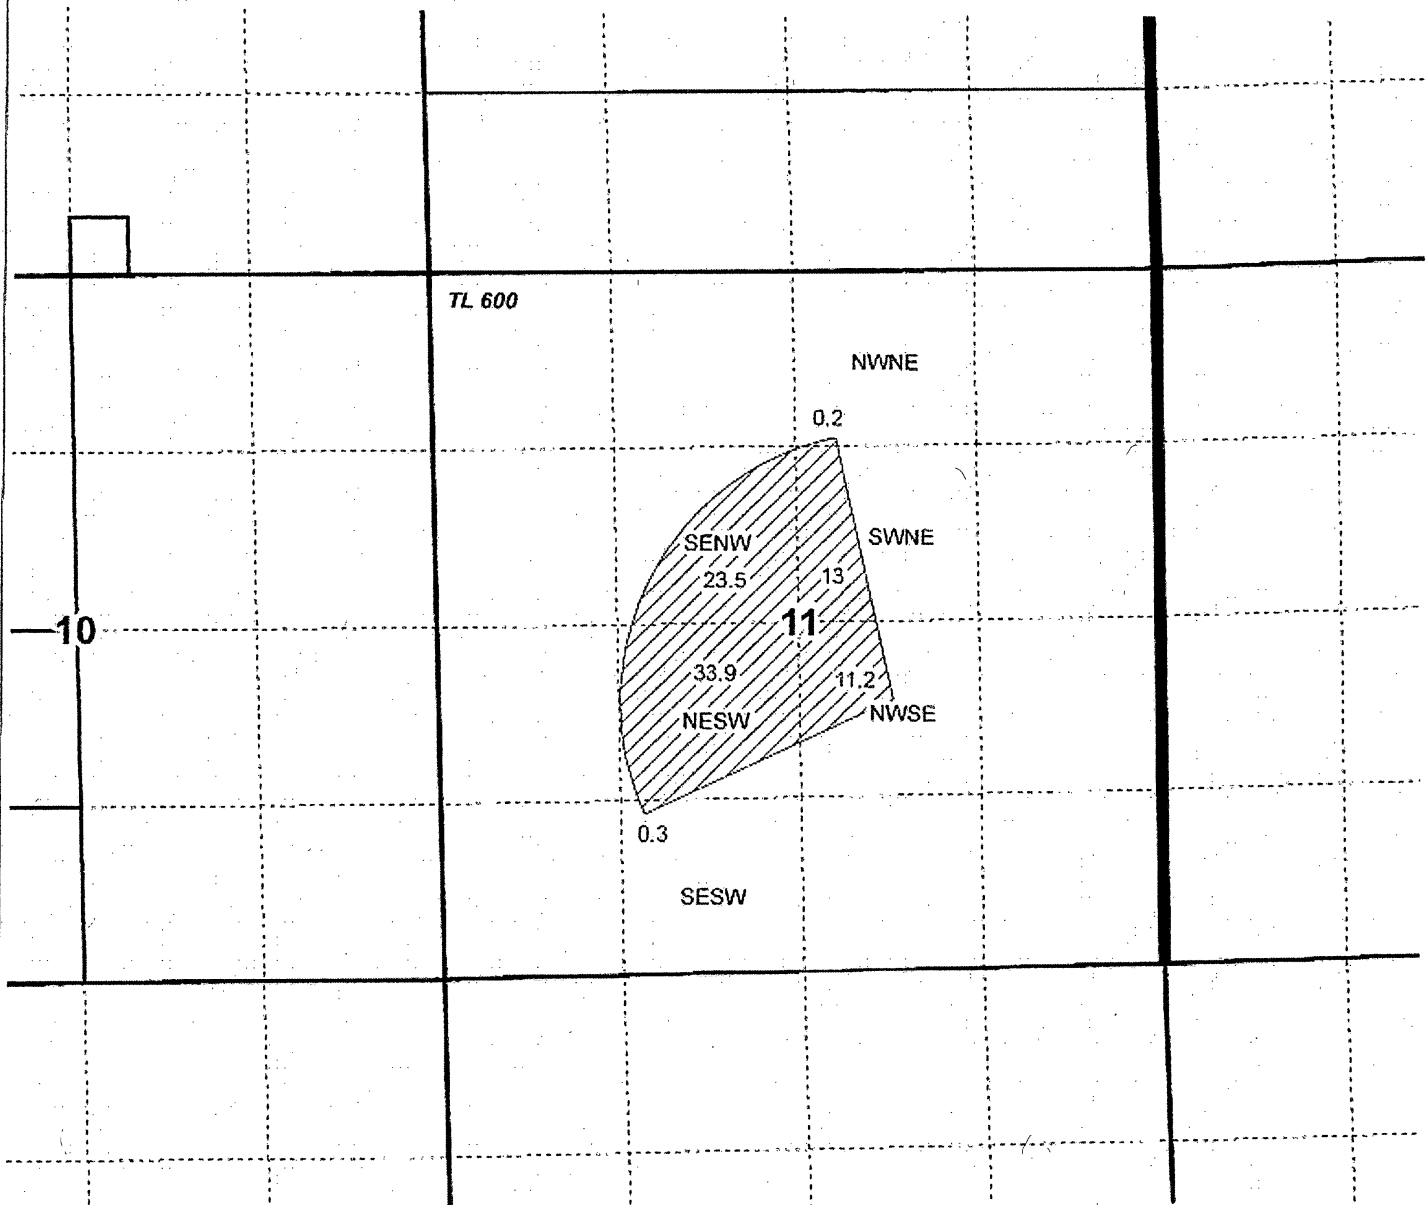MALHEUR COUNTY, OREGON

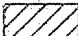

-  Proposed POU for Cert 89181
-  Section
-  Quarter Quarter
-  Tax Lot

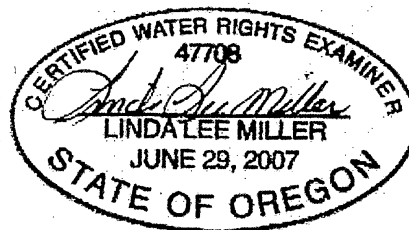

RENEWAL DATE 12/31/2018

COW VALLEY RANCH TRANSFER MAP

This map is not intended to provide legal dimensions or locations of property ownership lines.

Date: 10/5/2018

WATER RIGHT SERVICES, LLC

PO BOX 1830, BEND, OR 97709

CCB# 197121 www.oregonwater.us

541-389-2837 JOHNSHORT@USA.COM








0 1,320 Feet


1" = 1,320'

T15S R40E, WM

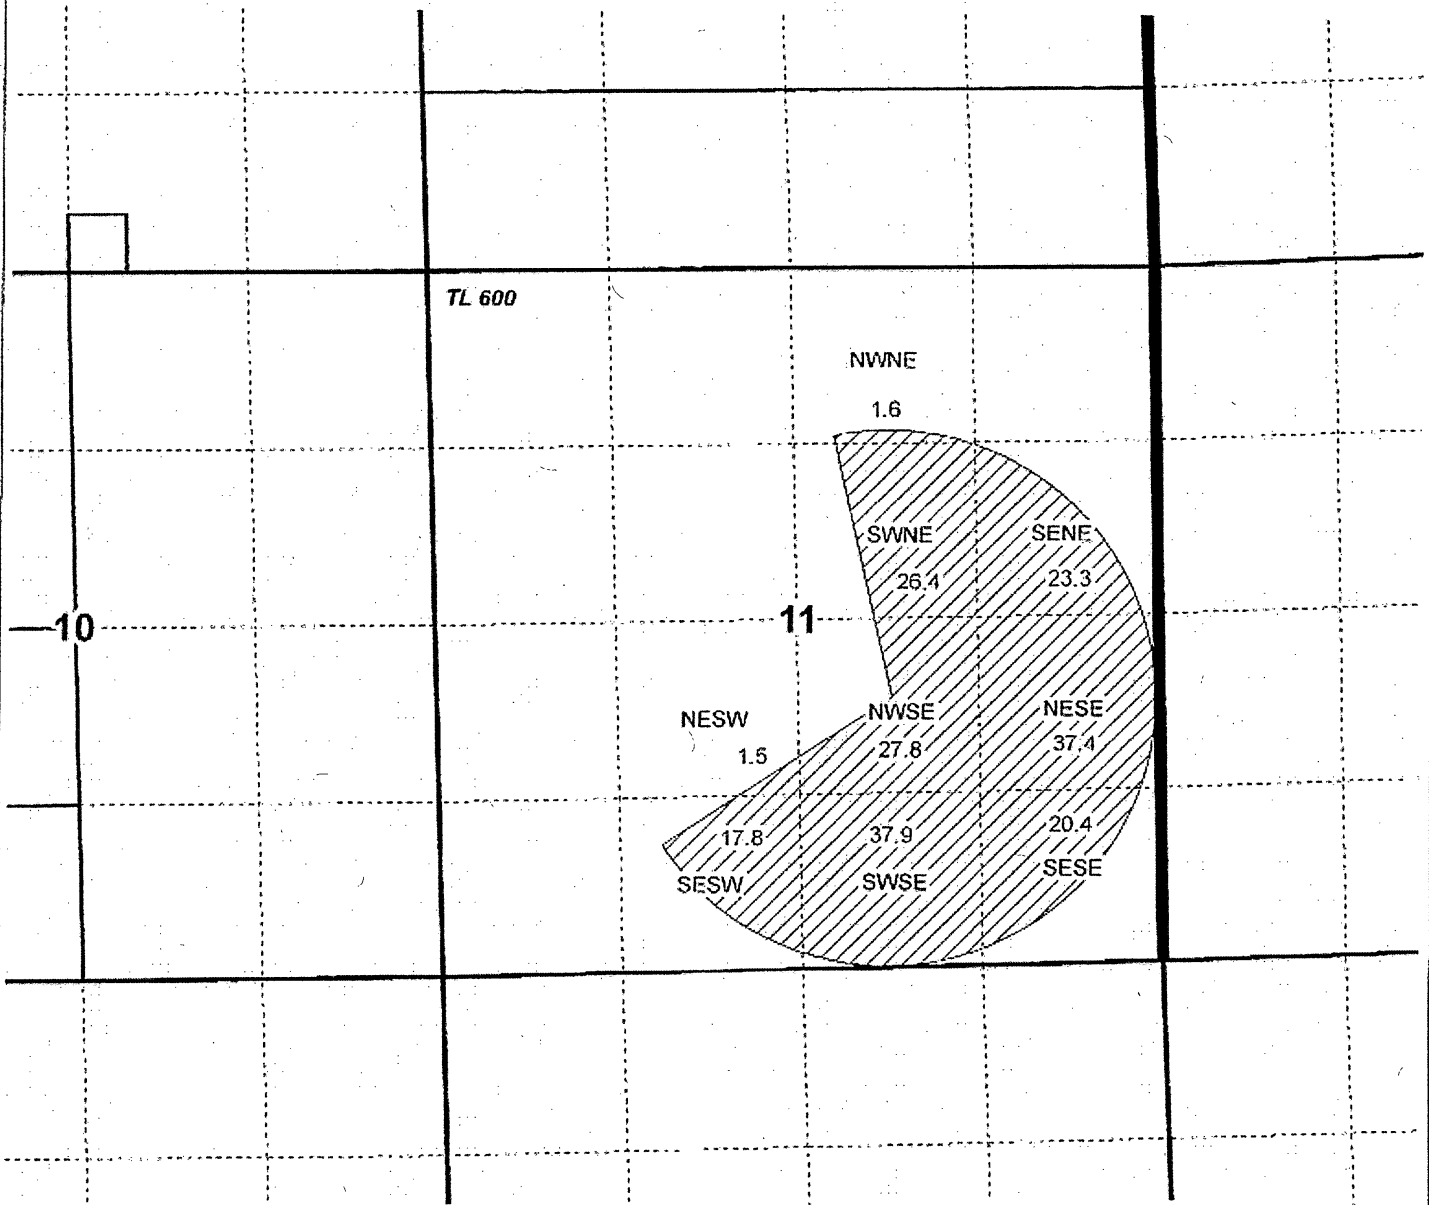MALHEUR COUNTY, OREGON

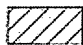

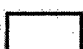-  Proposed POU for Cert 89182
-  Section
-  Quarter Quarter
-  Tax Lot

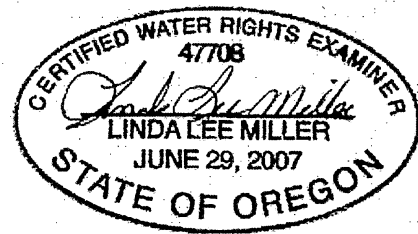

RENEWAL DATE 12/31/2018

COW VALLEY RANCH TRANSFER MAP

This map is not intended to provide legal dimensions or locations of property ownership lines.

Date: 10/5/2018

WATER RIGHT SERVICES, LLC

PO BOX 1830, BEND, OR 97709

CCB# 197121 www.oregonwater.us

541-389-2837 JOHNSHORT@USA.COM








0 1,320 Feet


1" = 1,320'

T15S R40E, WM

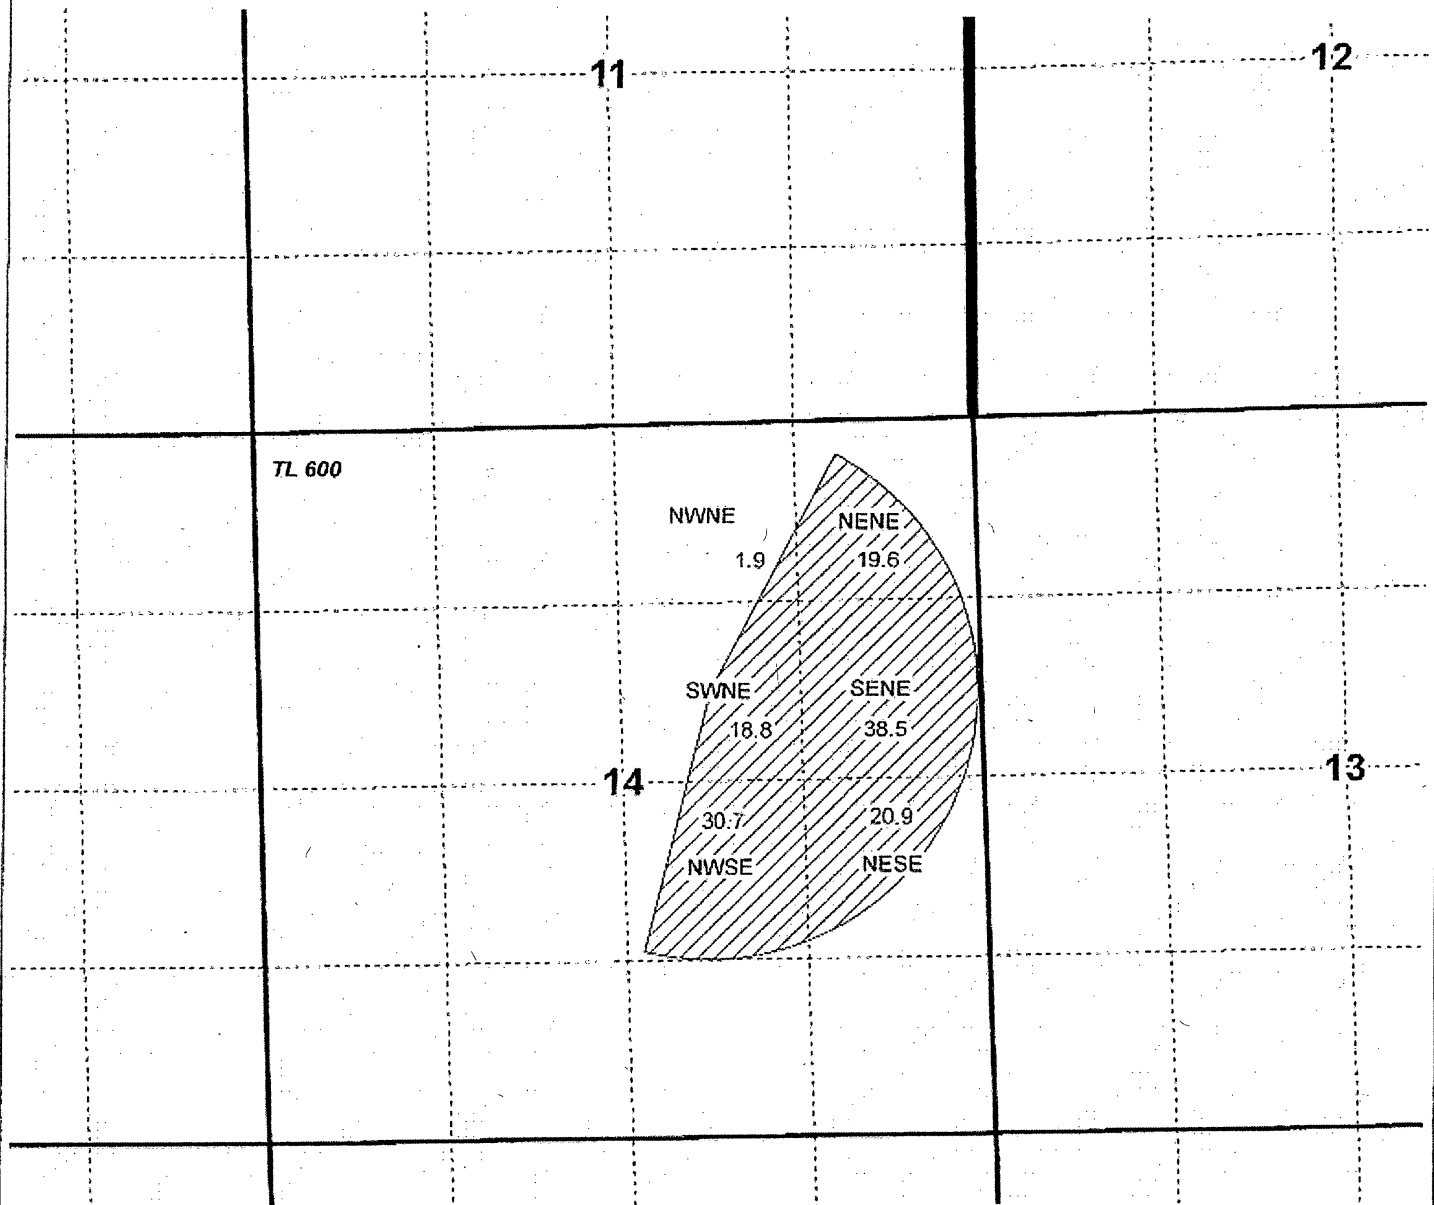MALHEUR COUNTY, OREGON

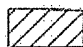

-  Proposed POU for Cert 89183
-  Section
-  Quarter Quarter
-  Tax Lot

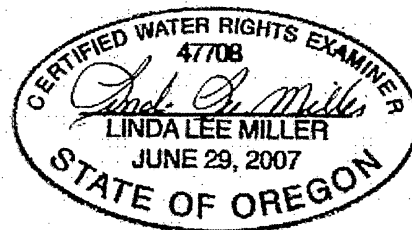

RENEWAL DATE 12/31/2018

COW VALLEY RANCH TRANSFER MAP

This map is not intended to provide legal dimensions or locations of property ownership lines.

Date: 10/5/2018

WATER RIGHT SERVICES, LLC

PO BOX 1830, BEND, OR 97709

CCB# 197121 www.oregonwater.us

541-389-2837 JOHNSHORT@USA.COM








0 1,320 Feet


1" = 1,320'

T15S R40E, WM

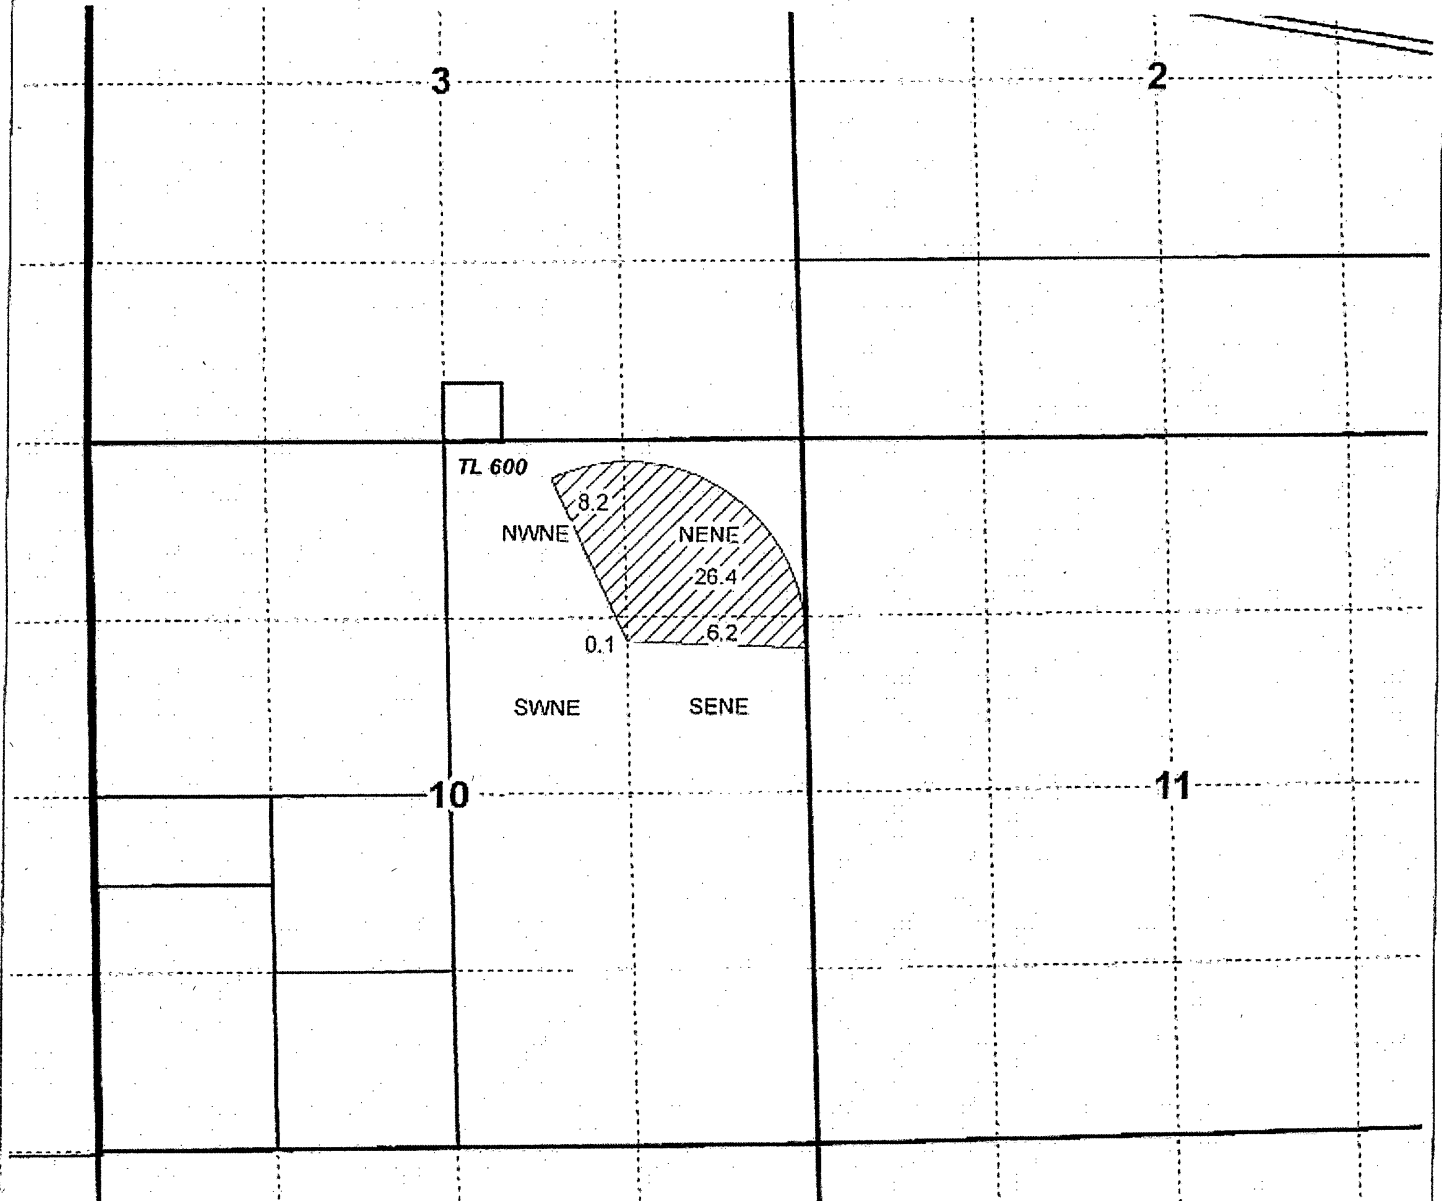MALHEUR COUNTY, OREGON

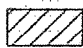

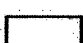-  Proposed POU for Cert 89184
-  Section
-  Quarter Quarter
-  Tax Lot

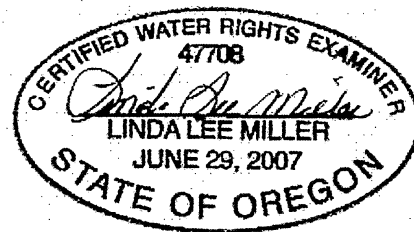

RENEWAL DATE 12/31/2018

COW VALLEY RANCH TRANSFER MAP

This map is not intended to provide legal dimensions or locations of property ownership lines.

Date: 10/6/2018

WATER RIGHT SERVICES, LLC

PO BOX 1830, BEND, OR 97709

CCB# 197121 www.oregonwater.us

541-389-2837 JOHNSHORT@USA.COM






 
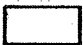
0 1,320 Feet

1" = 1,320'

T15S R40E, WM

MALHEUR COUNTY, OREGON

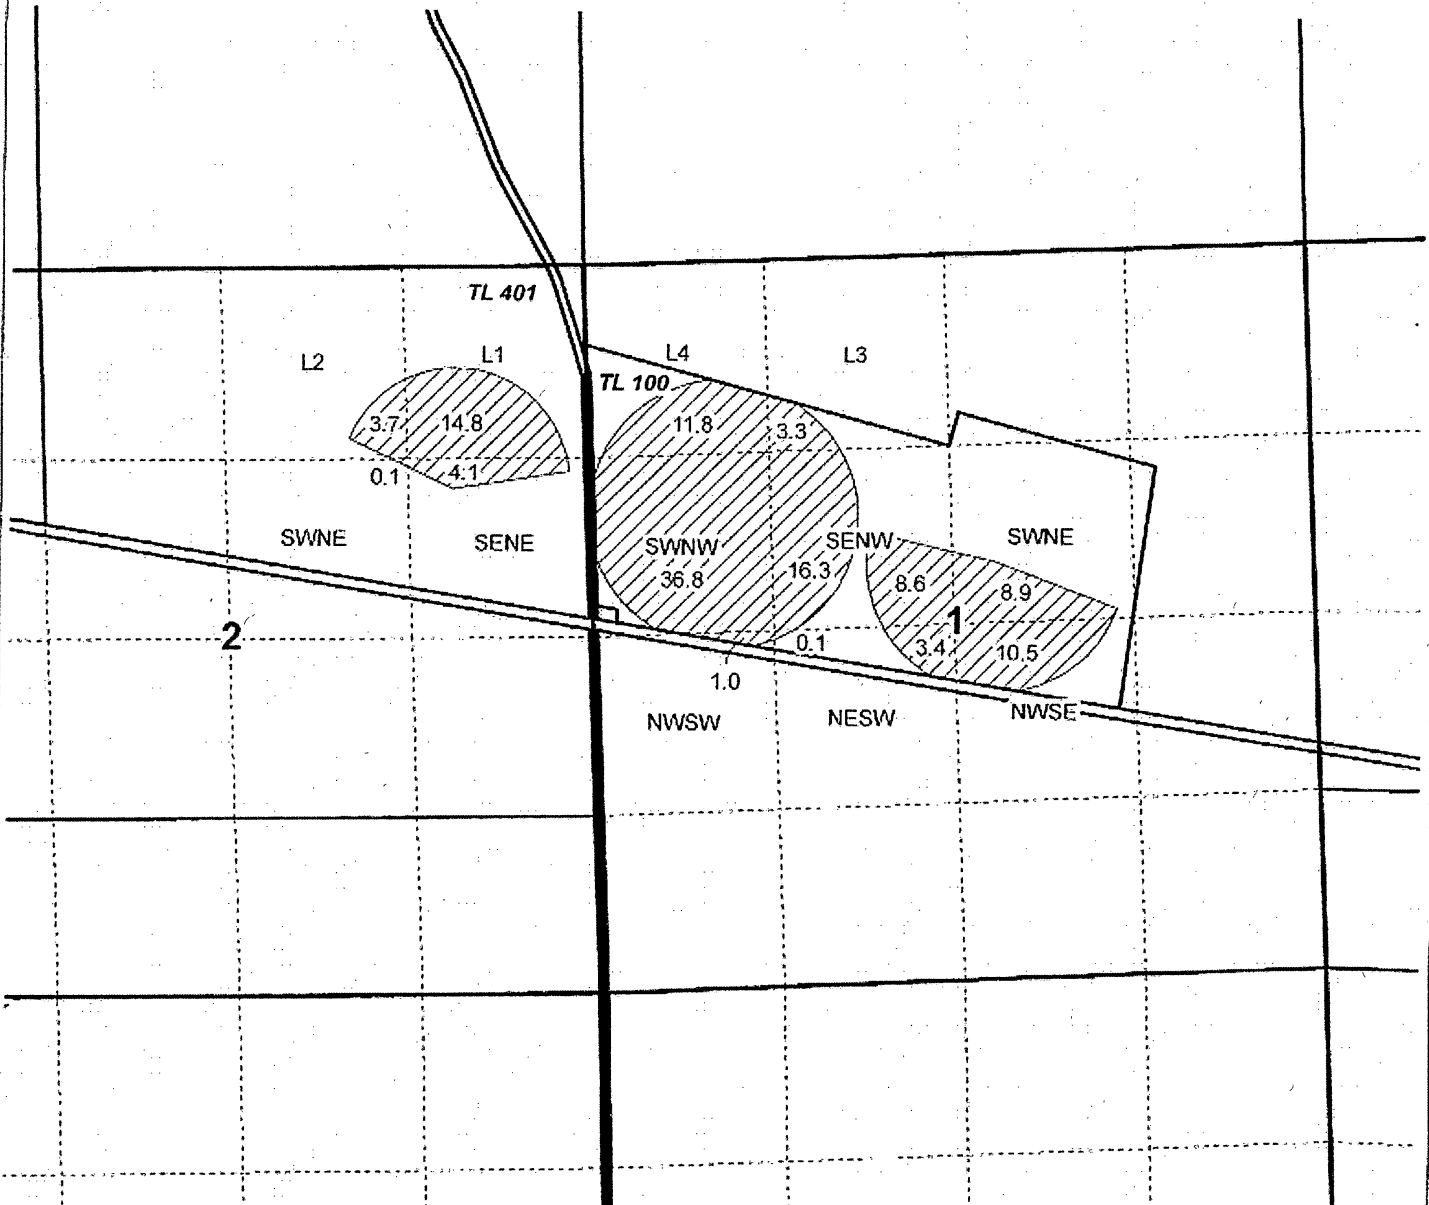

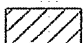-  Proposed POU for Cert 89198
-  Section
-  Quarter Quarter
-  Tax Lot



RENEWAL DATE 12/31/2018

COW VALLEY RANCH TRANSFER MAP

This map is not intended to provide legal dimensions or locations of property ownership lines.

Date: 10/5/2018

WATER RIGHT SERVICES, LLC

PO BOX 1830, BEND, OR 97709


CCB# 197121 www.oregonwater.us



 

541-389-2837 JOHNSHORT@USA.COM



0 1,320 Feet
1" = 1,320'

T15S R40E, WM
MALHEUR COUNTY, OREGON

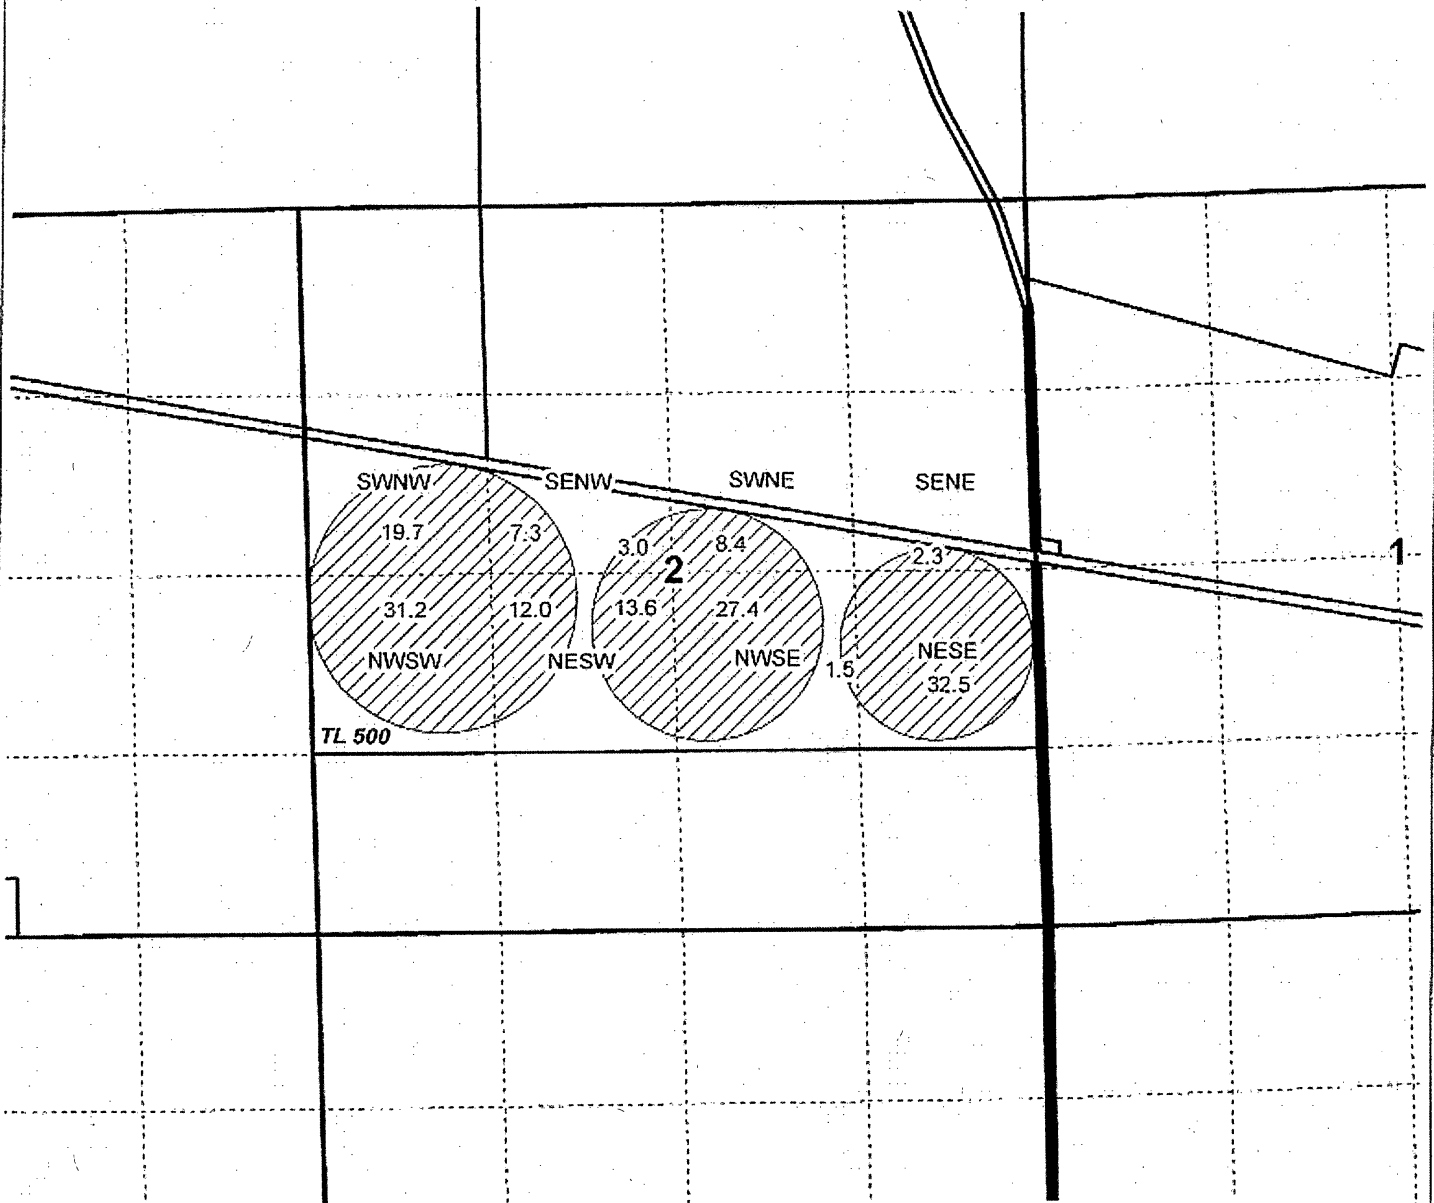

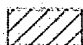-  Proposed POU for 89199
-  Section
-  Quarter Quarter
-  Tax Lot



RENEWAL DATE 12/31/2018

**COW VALLEY RANCH
TRANSFER MAP**

This map is not intended
to provide legal dimensions
or locations of property
ownership lines.

Date: 10/6/2018

WATER RIGHT SERVICES, LLC

PO BOX 1830, BEND, OR 97709

CCB# 197121 www.oregonwater.us

541-389-2837 JOHNSHORT@USA.COM








0 1,320 Feet


1" = 1,320'

T15S R40E, WM

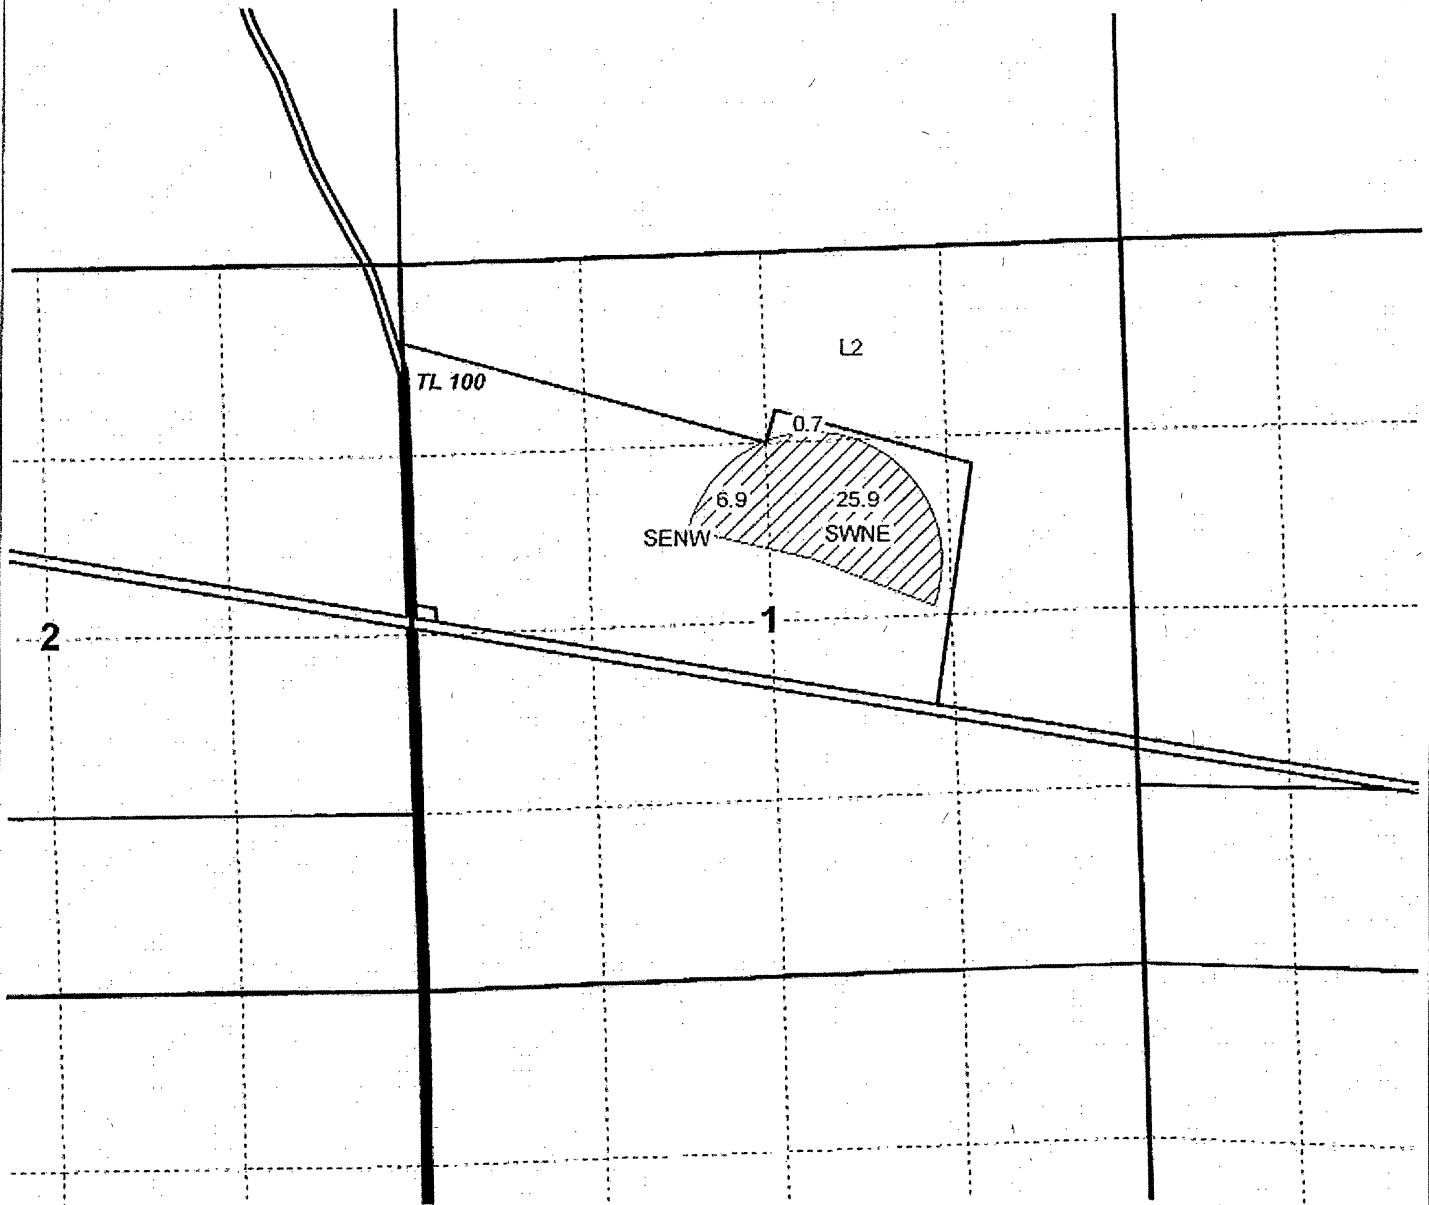MALHEUR COUNTY, OREGON

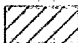

-  Proposed POU for Cert 89526
-  Section
-  Quarter Quarter
-  Tax Lot

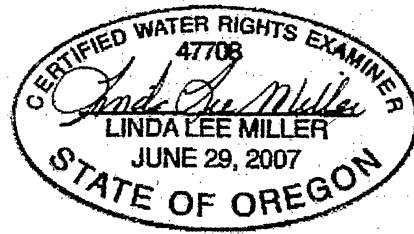

RENEWAL DATE 12/31/2018

COW VALLEY RANCH TRANSFER MAP

This map is not intended to provide legal dimensions or locations of property ownership lines.

Date: 10/4/2018

WATER RIGHT SERVICES, LLC

PO BOX 1830, BEND, OR 97709


CCB# 197121 www.oregonwater.us





541-389-2837 JOHNSHORT@USA.COM




0 1,320 Feet
1" = 1,320'

T15S R40E, WM
MALHEUR COUNTY, OREGON

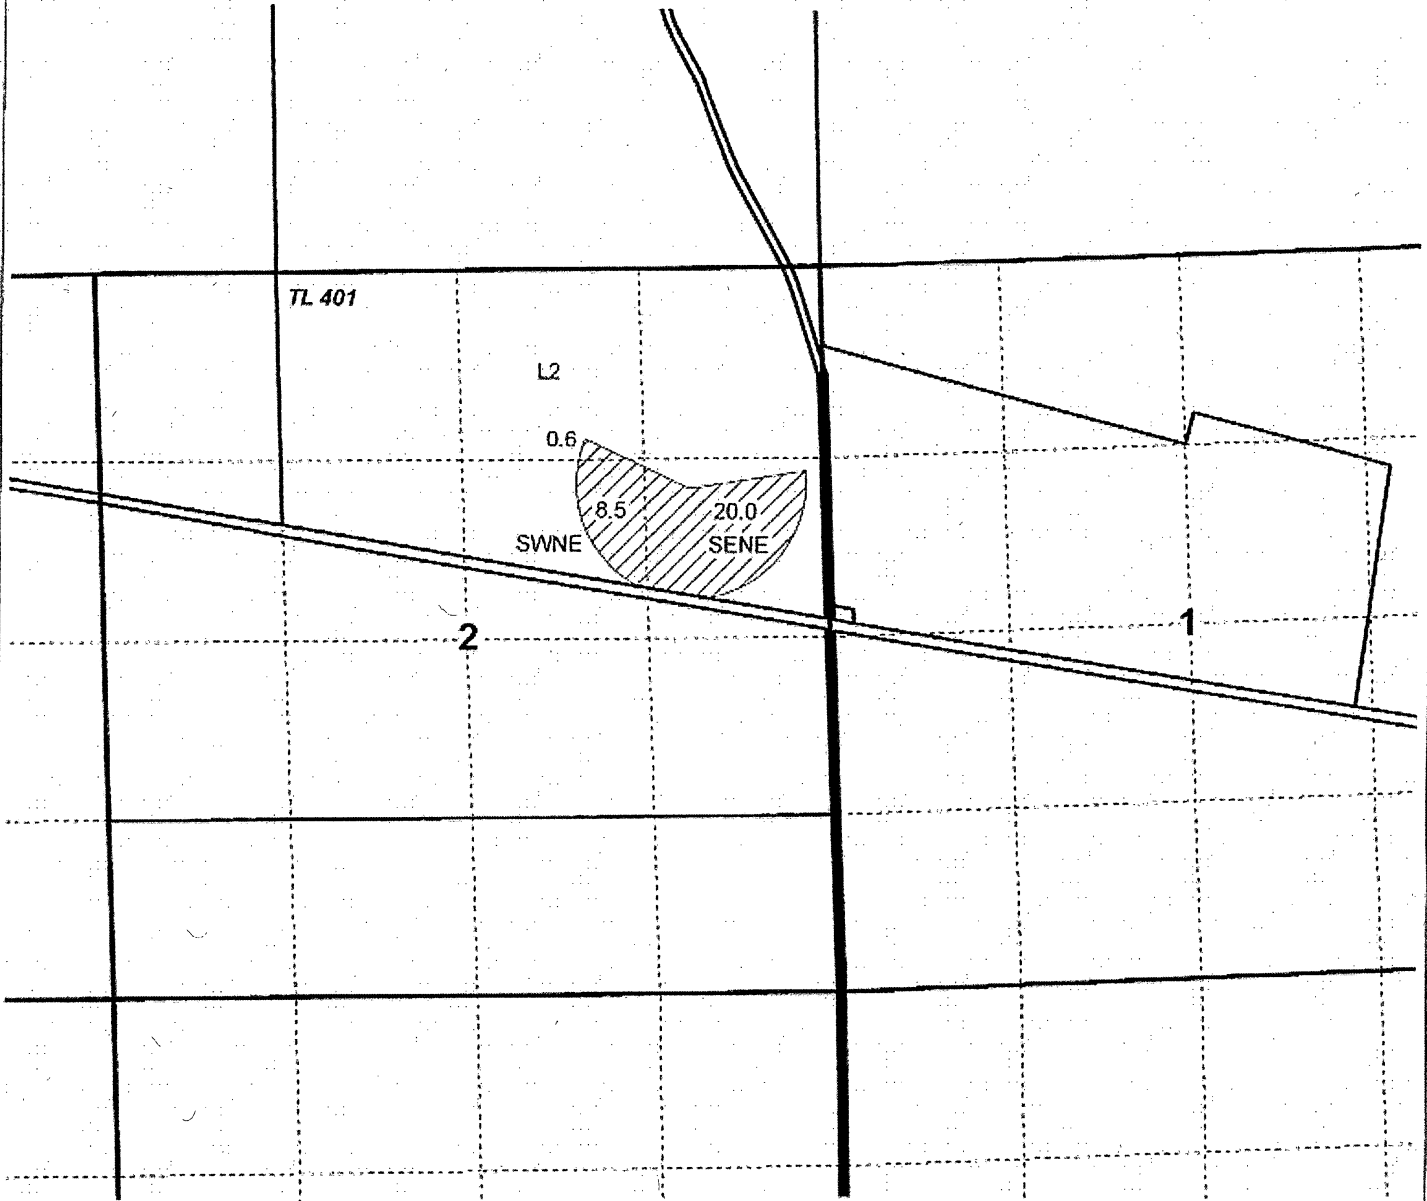

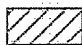  -  Proposed POU for Cert 89527
-  Section
-  Quarter Quarter
-  Tax Lot

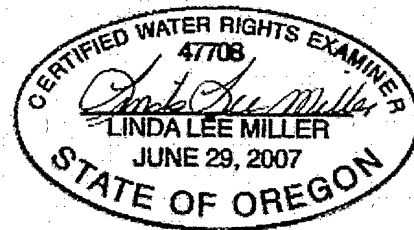

RENEWAL DATE 12/31/2018

**COW VALLEY RANCH
TRANSFER MAP**

This map is not intended
to provide legal dimensions
or locations of property
ownership lines.

Date: 10/6/2018

WATER RIGHT SERVICES, LLC

PO BOX 1830, BEND, OR 97709

CCB# 197121 www.oregonwater.us

541-389-2837 JOHNSHORT@USA.COM