



RECEIVED

OCT 29 2019

OWRD

October 22, 2019

Ann Reece
District Transfer Advisor
Oregon Water Resources Department
725 Summer St NE Ste A
Salem, OR 97301-1266

RE: FINAL PROOFS – Claim of Beneficial Use for T-12543

Dear Ann,

Central Oregon Irrigation District is submitting our claim of beneficial use for a permanent District transfer ("385").

Enclosed is a list of the authorized lands. Site reports are attached to each map and any specific details about the properties are contained in each site report.

Please Note: The below noted properties have had the following changes:

1. 17-13-22 NENW 205: Name Changes and Mapping Changes.
2. 16-12-12 SWSW 505: Name Changes and Mapping Changes.
3. 17-14-33 SENW 600: Mapping Changes.

The District certifies that it has inspected the place of use and confirms the change in place of use has been completed consistent with the terms and conditions of the final order approving the transfer.

Craig Horrell

Managing Director, Central Oregon Irrigation District

Date: 10.23.19



Oregon Water Resources Department
 725 Summer Street NE, Suite A
 Salem, Oregon 97301-1266
 (503) 986-0900
 www.wrd.state.or.us

District Permanent Water Right Transfer Claim of Beneficial Use

1. APPLICANT INFORMATION

District: CENTRAL OREGON IRRIGATION DISTRICT

Contact Person: LESLIE CLARK

Phone: 541-548-6047

Mailing Address: 1055 SW LAKE COURT

City: REDMOND

State: OR

Zip: 97756

E-Mail address:

lesliec@coid.org

Transfer Number: T - 12543

RECEIVED
 OCT-29 2019
 OWRD

2. WATER RIGHT(S)

Pursuant to OAR Chapter 690, Division 385, the district is submitting to the Water Resources Department this claim of beneficial use, with the appropriate fee, for the following water right(s):

NOTE: Fees do not apply if the priority date is prior to July 9, 1987.

PERMIT NUMBER	CERTIFICATE NUMBER	DECREE (name, volume, and page)	PRIMARY (P) OR SUPP (S)
-	83571		<input checked="" type="checkbox"/> P <input type="checkbox"/> S
-	76714		<input type="checkbox"/> P <input checked="" type="checkbox"/> S
-			<input type="checkbox"/> P <input type="checkbox"/> S
-			<input type="checkbox"/> P <input type="checkbox"/> S

3. AUTHORIZED POINT(S) OF DIVERSION (POD) / APPROPRIATION (POA)

The authorized point(s) of diversion / appropriation for the water right modified by the transfer are as follows:

PERMIT NUMBER	DECREE or CERTIFICATE	POD / POA #	SOURCE	LOCATION – MEASURED DISTANCES
-	83571	1	Deschutes River	SW ¼ NE ¼ SEC. 13, T. 18 S., R. 11 E., W.M.; 1520' S. & 1535' W. FROM THE NE CORNER OF SEC. 13
-	83571	11	Deschutes River	SE ¼ NE ¼ SEC. 29, T. 17 S., R. 12 E., W.M.; 850' N. AND 630' W. FROM THE E ¼ CORNER OF SEC. 29
-				
-				

AUTHORIZED PLACE OF USE

Cert/Decree	Cert/Perm	TRANSFER NBR	POD USE	TWP	RNG	SEC	QQ	LOT	ACRES	USER NAME
83571	76714	T-2016-017	#11 IRRIG	14	13	21	SWNW	00500	4.000	Beaird, Casey B.
83571	76714	T-2016-020	#1 IRRIG	14	14	36	SWNW	00201	0.250	Belfast Ranch, LLC
83571	76714	T-2016-018	#11 IRRIG	16	12	11	SESE	01000	0.800	Prusak Farm, LLC
83571	76714	T-2016-021	#11 IRRIG	16	12	12	SWSW	00505	1.640	Hayden, Richard/Lori
83571	76714	T-2016-019	#1 IRRIG	17	13	22	NENW	00205	1.050	Alexander, Kathryn/Spediacci, Steve
83571	76714	T-2016-022	#1 IRRIG	17	14	33	SENW	00600	11.060	80 Acres LLC


RECEIVED

OCT 29 2019

OWRD

6. SIGNATURES

The district certifies that it has inspected the place of use listed in Table I, and confirms the change in place of use has been completed consistent with the terms and conditions of the final order approving the transfer.

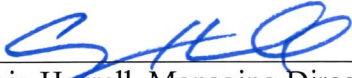

Craig Horrell, Managing Director
Central Oregon Irrigation District

10.23.19

Date

RECEIVED

OCT 29 2019

OWRD

FINAL PROOF SITE REPORT

Claim of Beneficial Use

Property Owner (Applicant): Beard, Casey B.

Current Owner:

Property Address: 1511 NW Odem Ave

ID #: 4799

Petition #: P-2016-005

OWRD #: T-12543

Notice #: T-2016-020

POD	USE	HG	TWP	RNG	SEC	QQ	TAX LOT	ACRES
1	IRRIG	H-1-4	14	13	21	SWNW	500	4.00

RECEIVED
OCT 29 2019

OWRD


- Person interviewed (if any): Casey
- Method of irrigation (pump, flood, etc): sprinkler
- Use (crops produced): hay
- Method used to calculate area irrigated: GPS
- Is beneficial use achieved: Yes
 - Dated photos of beneficial use: 6/10/19
 - Are there any mapping changes: No
 - Submit map changes to mapping for updates to ARC. Date submitted: _____
 - Enter use into WWIN: _____

IF NO:

- Failure to Prove up _____ acres of transferred water right
- Extension Filed: _____

NOTES:

6/10/19 - Good use -> Thigh High

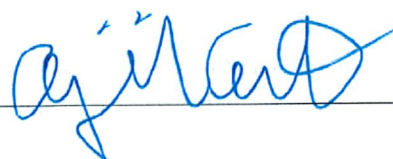Final Inspection by:  Date: 6/10/19

DESCHUTES COUNTY SEC.21 T14S R13E


RECEIVED
OCT 29 2019
OWRD

SCALE - 1" = 400'




SW 1/4 OF THE NW 1/4

OWRD #: T-12543

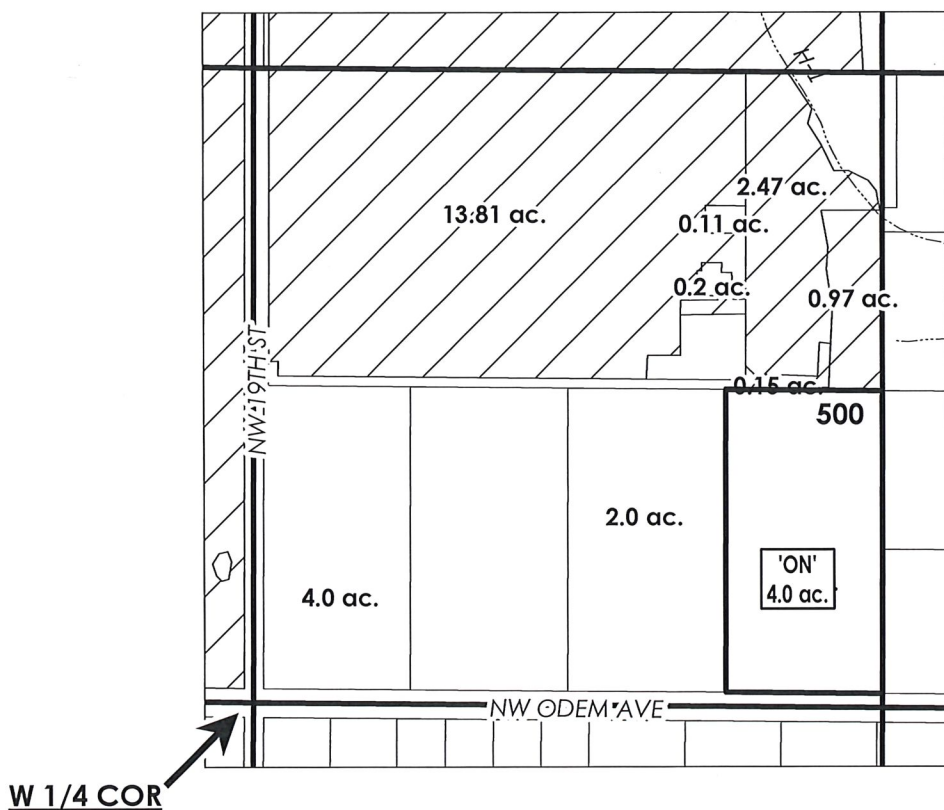

# ac.	PARCELS W/ WATER RIGHTS
	EXISTING WATER RIGHTS
# ac.	'ON' LAND PARCELS

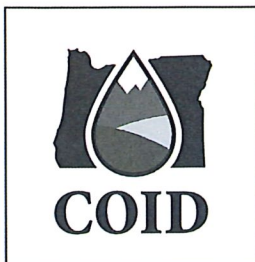

FINAL PROOF MAP

NAME: Baird, Casey B.

TAXLOT #: 500

4.0 ACRES

Date: 10/22/2019

Document Path: I:\GIS\TRANSFER MAPS\2019\FINAL_PROOF\141321SWNW00500.mxd

Due: 10/2018

RECEIVED

OCT 29 2019

OWRD

FINAL PROOF SITE REPORT

Claim of Beneficial Use

ID #: 3183
Petition #: P-2016-005
OWRD #: T-12543
Notice #: T-2016-005

Property Owner (Applicant): Belfast Ranch, LLC
Current Owner:
Property Address: 12512 SW Cornett Loop

POD	USE	HG	TWP	RNG	SEC	QQ	TAX LOT	ACRES
1f	IRRIG	COC-81-1	14	14	36	SWNW	201	0.25

- Person interviewed (if any): NA
- Method of irrigation (pump, flood, etc): K-line
- Use (crops produced): grass
- Method used to calculate area irrigated: GPS
- Is beneficial use achieved: Yes
 - Dated photos of beneficial use: 5/21/19
 - Are there any mapping changes: No
 - Submit map changes to mapping for updates to ARC. Date submitted: _____
 - Enter use into WWIN: _____

IF NO:

- Failure to Prove up _____ acres of transferred water right
- Extension Filed: _____

NOTES:

5/21/19 - Full use, good healthy grass

Final Inspection by: *Agil Carter* Date: 5/21/19

CROOK COUNTY
SEC.36 T14S R14E

RECEIVED

OCT 29 2019


OWRD

SCALE - 1" = 400'



SW 1/4 OF THE NW 1/4

OWRD #: T-12543

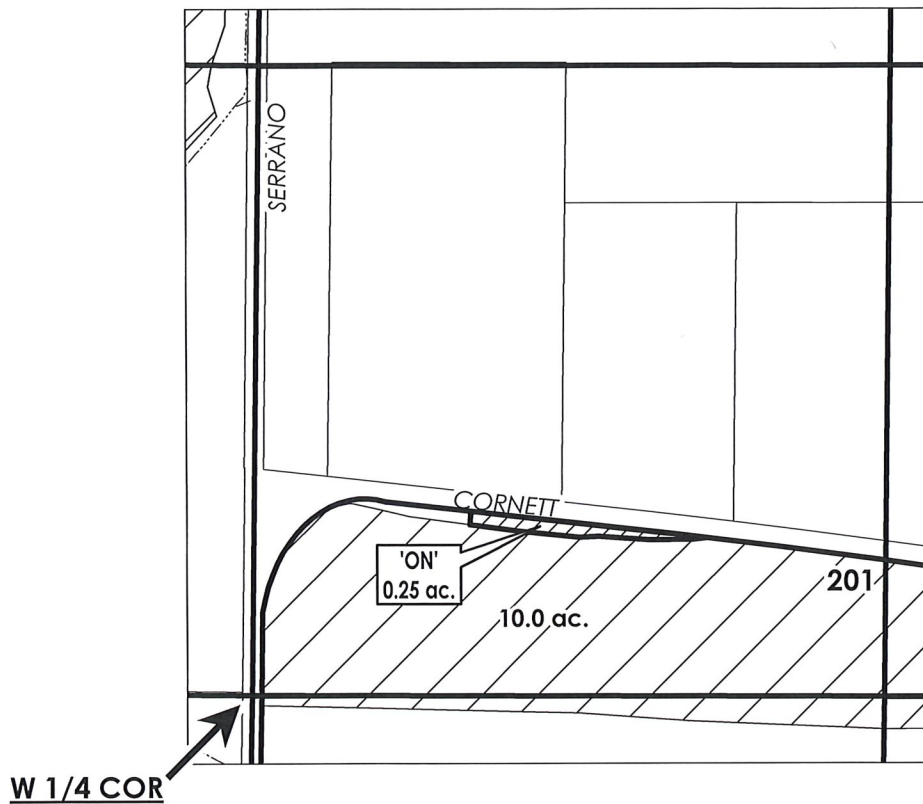

FINAL PROOF MAP

NAME: Belfast Ranch, LLC

TAXLOT #: 201

0.25 ACRES

Date: 10/22/2019

Document Path: I:\GIS\TRANSFER MAPS\2019\FINAL_PROOF\141436SWNW00201.mxd

FINAL PROOF SITE REPORT

Claim of Beneficial Use

ID #: 4079
 Petition #: P-2016-005
 OWRD #: T-12543
 Notice #: T-2016-018

OWRD

Property Owner (Applicant): Prusak Farm, LLC
 Current Owner:
 Property Address: 21510 Young Ave

POD	USE	HG	TWP	RNG	SEC	QQ	TAX LOT	ACRES
11	IRRIG	A-16-10-2	16	12	11	SESE	1000	0.80

- Person interviewed (if any): Mr. Prusak
- Method of irrigation (pump, flood, etc): hand-line
- Use (crops produced): Rye
- Method used to calculate area irrigated: GPS
- Is beneficial use achieved: Yes
 - Dated photos of beneficial use: 6/4/19, 6/27/19, 9/20/2019
 - Are there any mapping changes: No
 - Submit map changes to mapping for updates to ARC. Date submitted: _____
 - Enter use into WWIN: _____

IF NO:

- Failure to Prove up _____ acres of transferred water right
- Extension Filed: _____

NOTES:

9-20-2019 Bo site visit. I spoke with Mr. Prusak about the area being transferred. He says that he planted rye last season and it was able to establish itself.

- patches of rye is still visible in 2019 (per site visit) Daniel Downing

2018 Google Earth showed entire 0.80 area fully irrigated - Attached

Final Inspection by: Justin Clark Date: 9/20/19
 Approved


16-12-11 SESE 1000
7/2018 Google Earth

21510 SW Young Ave

Legend
21510 SW Young Ave

Google Earth

1000 ft

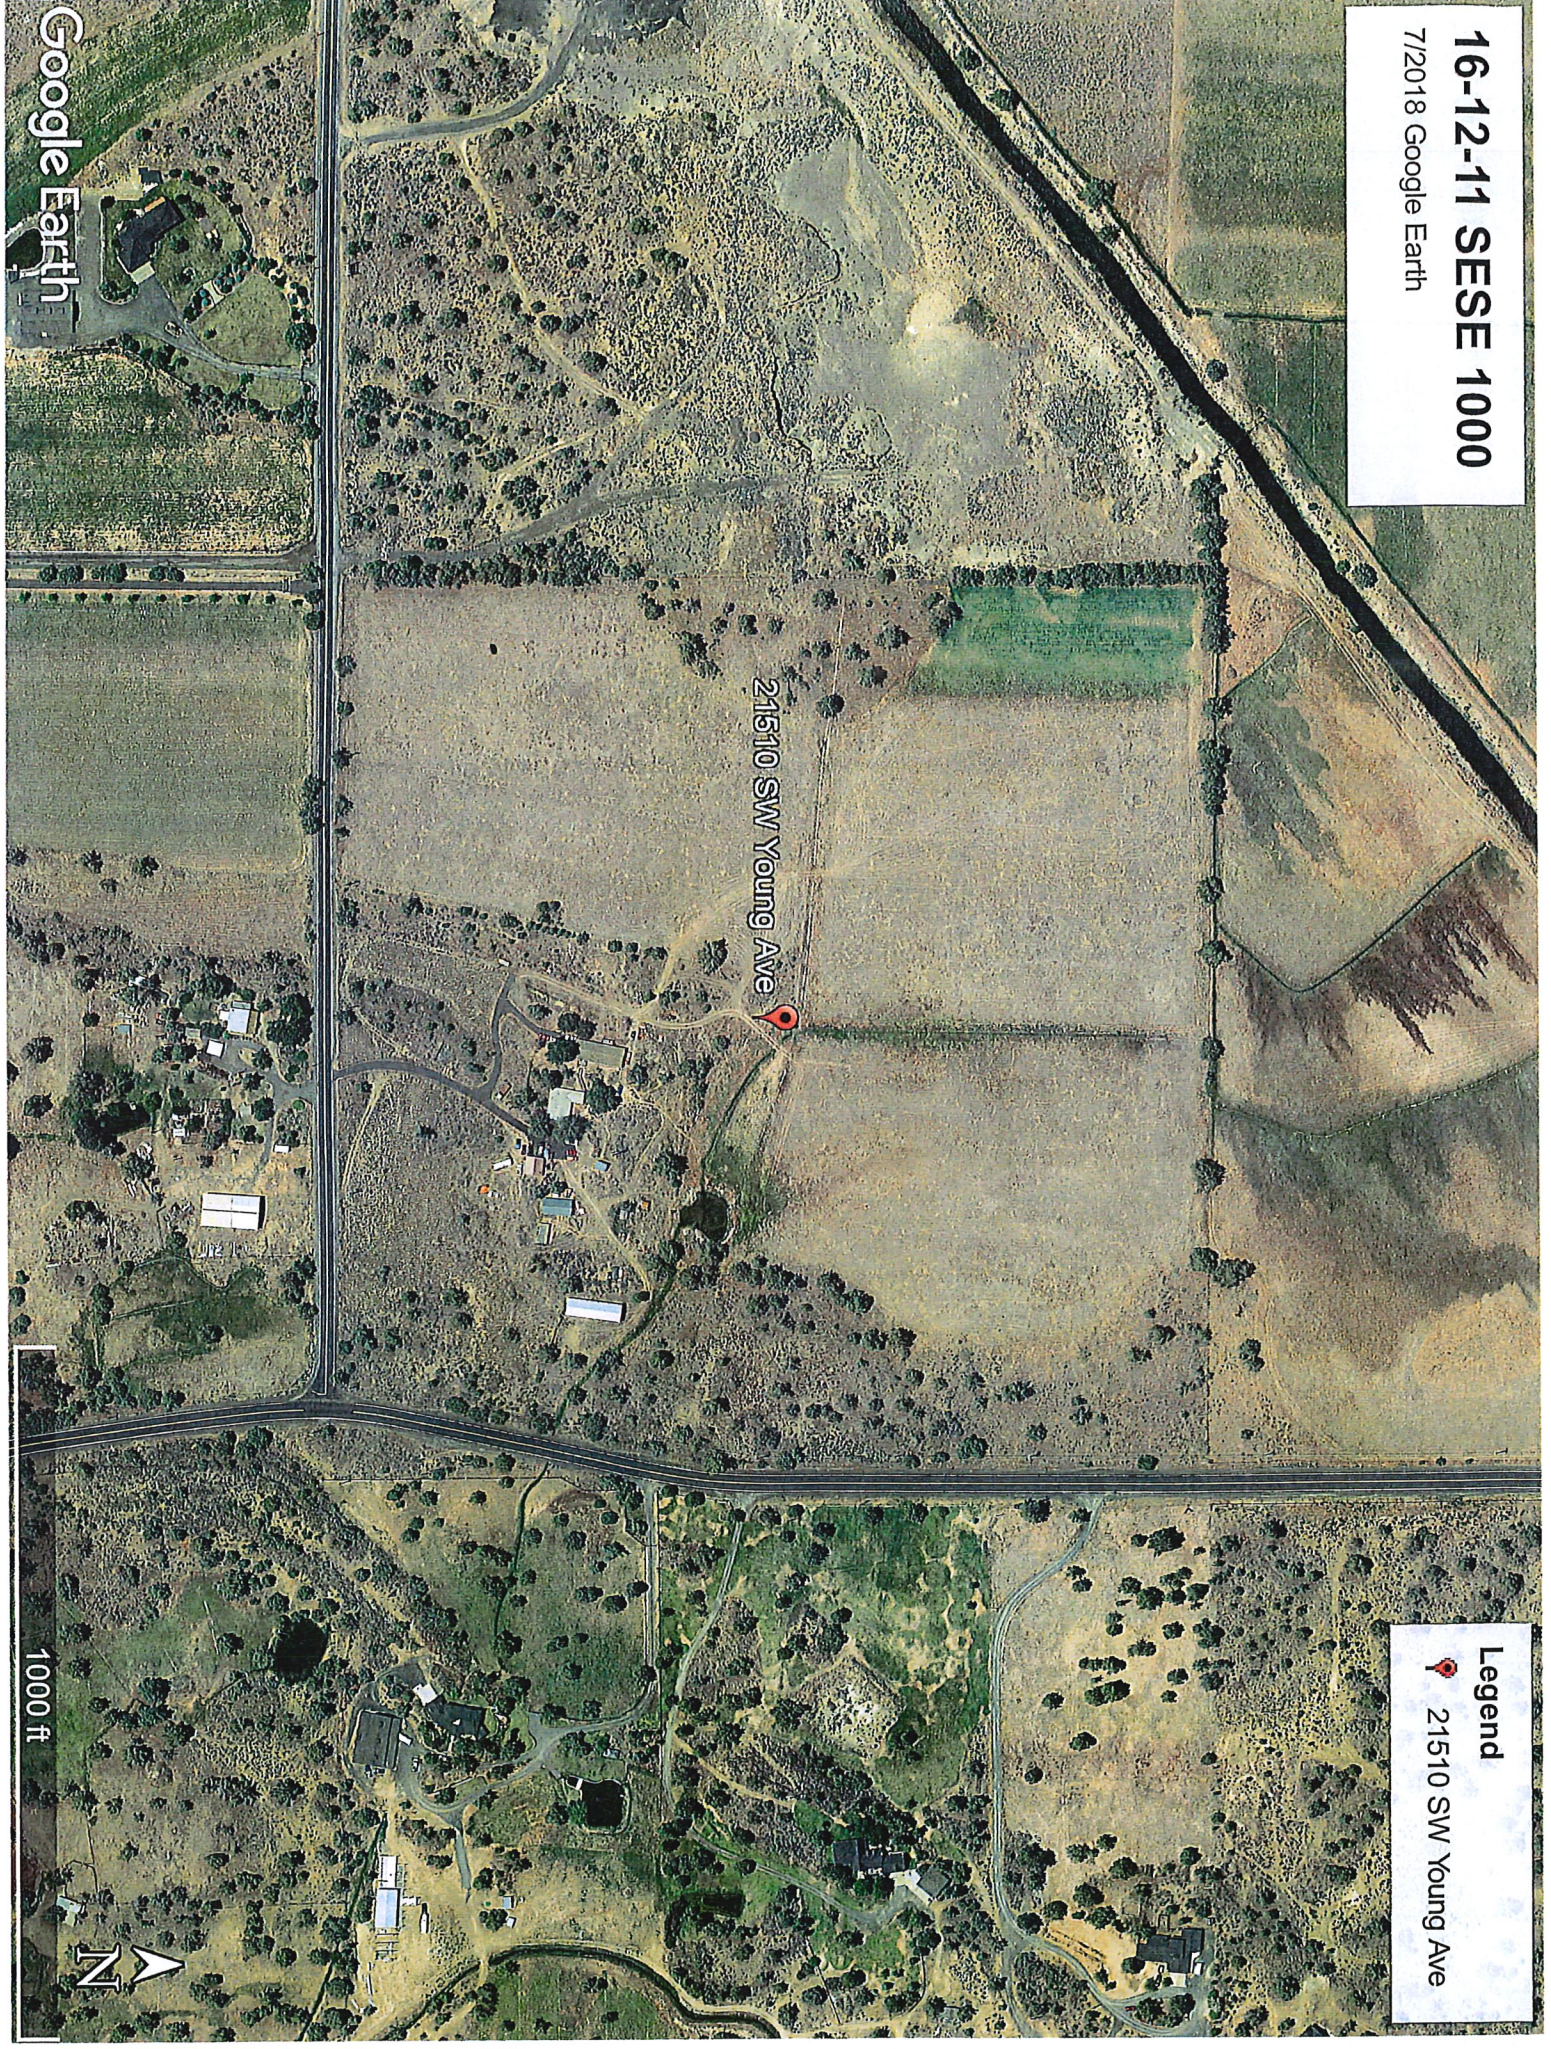



DESCHUTES COUNTY
SEC.11 T16S R12E

SCALE - 1" = 400'



SE 1/4 OF THE SE 1/4

OWRD #: T-12543

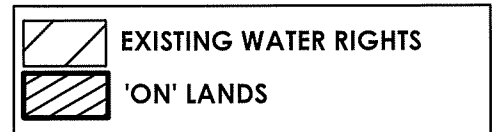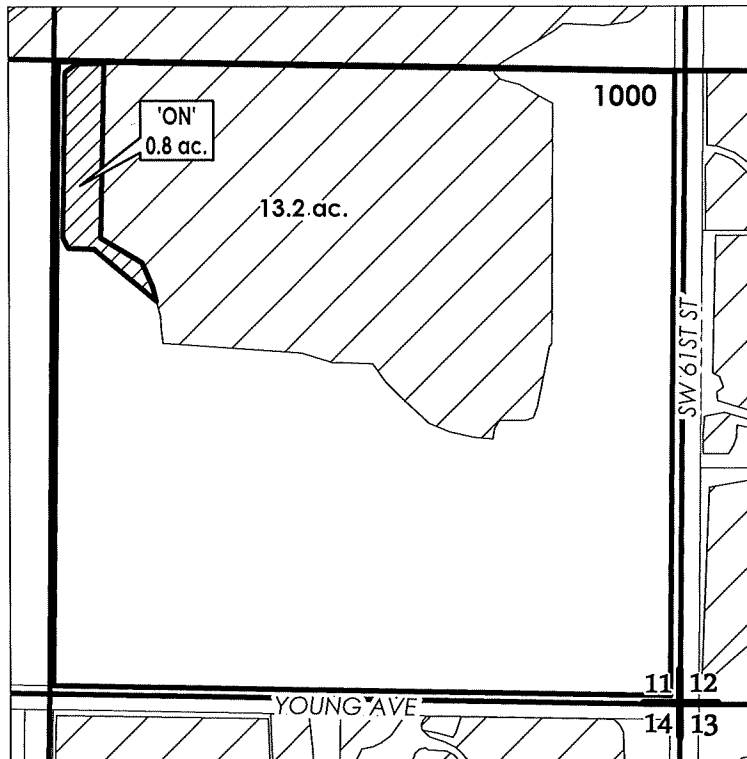

FINAL PROOF MAP

NAME: Prusak Farm, LLC

TAXLOT #: 1000

0.8 ACRES

Date: 10/22/2019

Document Path: I:\GIS\TRANSFER MAPS\2019\FINAL_PROOF\161211SESE01000.mxd

FINAL PROOF SITE REPORT

Claim of Beneficial Use

Property Owner (Applicant): Hayden, Richard/Lori

Current Owner:

Property Address: 8414 SW 61st Street

Petition #: P-2016-005

OWRD#: T-12543

Notice #: T-2016-021

USE	CANAL	HG	TWP	RNG	SEC	QQ	TAX LOT	ACRES
IRRIG	PBC	A-16-11-1	16	12	12	SWSW	505	1.64

- Person interviewed (if any): Rick
- Method of irrigation (pump, flood, etc): sprinklers
- Use (crops produced): pasture & landscape
- Method used to calculate area irrigated: GPS
- Is beneficial use achieved: Yes
- Are there any mapping changes: Yes
- Dated photos of beneficial use: 6/4/19, 6/27/19

IF NO:

- Failure to Prove up _____ acres of transferred water right
- Extension Filed: _____

NOTES:

6/4/19 - Around house, along driveway & E side look good
- 0.15ac dry

6/27/19 - 0.15ac good

Final Inspection by: Ajilatto

Date: 6/27/19



DESCHUTES COUNTY SEC.12 T16S R12E

SCALE - 1" = 400'



SW 1/4 OF THE SW 1/4

OWRD #: T-12543

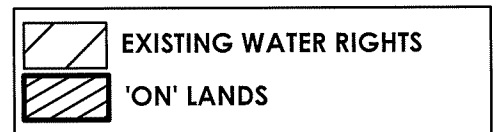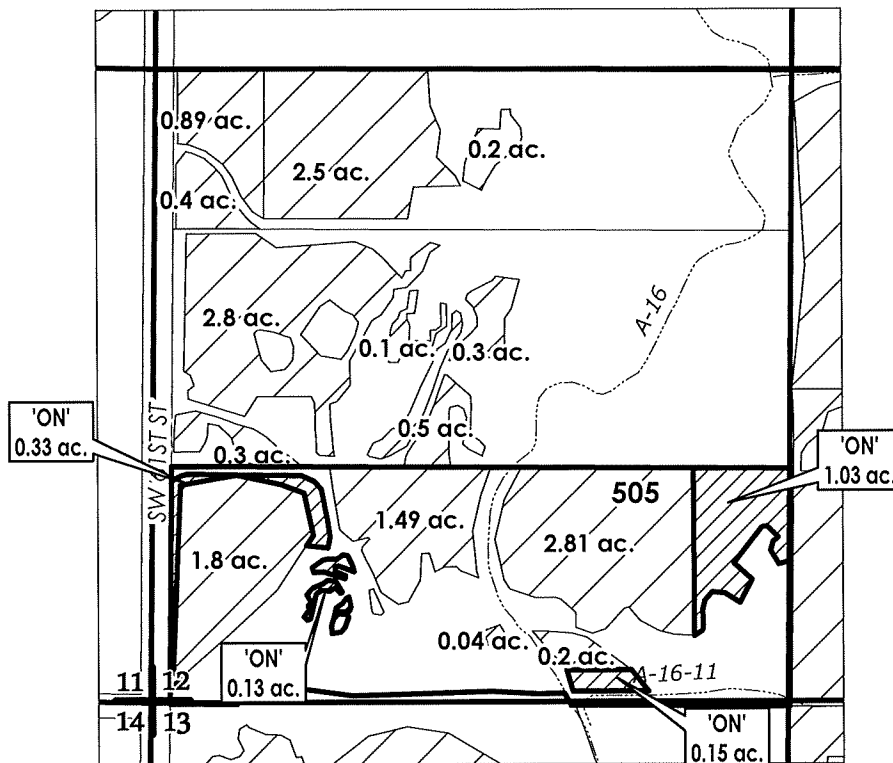

FINAL PROOF MAP

NAME: Hayden, Richard/ Lori

TAXLOT #: 505

1.64 ACRES

Date: 10/22/2019

Document Path: I:\GIS\TRANSFER MAPS\2019\FINAL_PROOF\161212SSW00505.mxd



FINAL PROOF SITE REPORT

Claim of Beneficial Use

Property Owner (Applicant): ~~Casiorowski, John/Victoria~~
Alexander, Kathryn
Current Owner:
Property Address: 63112 Terry Dr

ID #: 3431
Petition #: P-2016-005
OWRD #: T-12543
Notice #: NA

POD	USE	HG	TWP	RNG	SEC	QQ	TAX LOT	ACRES
1	IRRIG	C-18	17	13	22	NENW	205	1.05

- Person interviewed (if any): Kathryn
- Method of irrigation (pump, flood, etc): sprinklers
- Use (crops produced): pasture
- Method used to calculate area irrigated: GPS
- Is beneficial use achieved: Yes
 - Dated photos of beneficial use: 5/30/19
 - Are there any mapping changes: Yes
 - Submit map changes to mapping for updates to ARC. Date submitted: _____
 - Enter use into WWIN: _____

IF NO:

- Failure to Prove up _____ acres of transferred water right
- Extension Filed: _____

NOTES:

5/30/19 - Full use - looks great

Final Inspection by: Ayül Centu Date: 5/30/19



DESCHUTES COUNTY SEC.22 T17S R13E

SCALE - 1" = 400'



NE 1/4 OF THE NW 1/4

OWRD #: T-12543

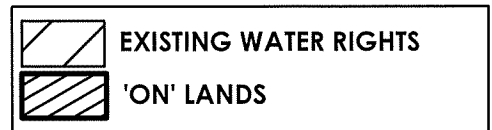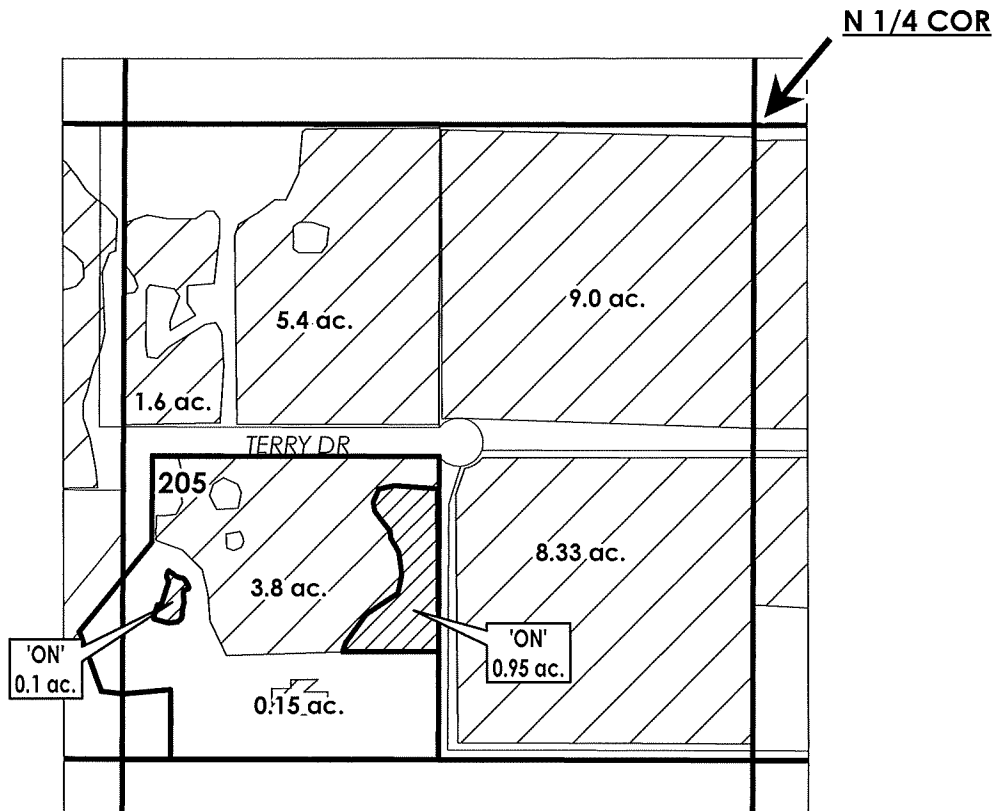

FINAL PROOF MAP

NAME: Spediacci, Steven U./ Alexander, Kathryn

TAXLOT #: 205

1.05 ACRES

Date: 10/22/2019

Document Path: I:\GIS\TRANSFER MAPS\2019\FINAL_PROOF\171322NENW00205.mxd



FINAL PROOF SITE REPORT

Claim of Beneficial Use

Property Owner (Applicant): 80 Acres LLC

Current Owner:

Property Address: 62265 Dodds Rd

ID #: 4438

Petition #: P-2016-005

OWRD #: T-12543

Notice #: T-2016-022

POD	USE	HG	TWP	RNG	SEC	QQ	TAX LOT	ACRES
1	IRRIG	H-5	17	14	33	SENW	600	11.06

- Person interviewed (if any): RICK ?
- Method of irrigation (pump, flood, etc): PUMP
- Use (crops produced): PASTURE GRASS
- Method used to calculate area irrigated: GPS
- Is beneficial use achieved: YES
 - Dated photos of beneficial use: 7/14/17 COLLECTOR
 - Are there any mapping changes: YES
 - Submit map changes to mapping for updates to ARC. Date submitted: _____
 - Enter use into WWIN: _____

IF NO:

- Failure to Prove up _____ acres of transferred water right
- Extension Filed: _____

NOTES:

CHANGE IN SHAPE OF MAP, NOT NECESSARILY BY QQ TOTALS. ALL AREAS OF TRANSFER ARE TALL HEAVY STANDS OF PASTURE GRASS.

Final Inspection by: [Signature] Date: 7/14/17


DESCHUTES COUNTY
SEC.33 T17S R14E

SCALE - 1" = 400'



SE 1/4 OF THE NW 1/4

OWRD #: T-12543

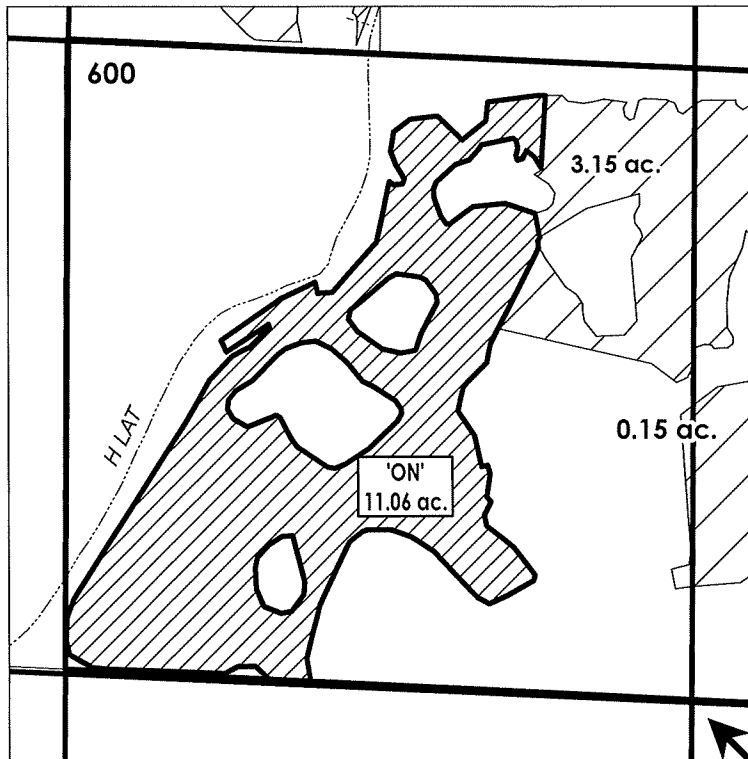

C 1/4 COR



FINAL PROOF MAP

NAME: 80 Acres LLC

TAXLOT #: 600

11.06 ACRES

Date: 10/22/2019

Document Path: I:\GIS\TRANSFER MAPS\2019\FINAL_PROOF\171433SENW00600.mxd