



T.4S. R.2W. Sec. 29, 30, 31 & 32, W.M.

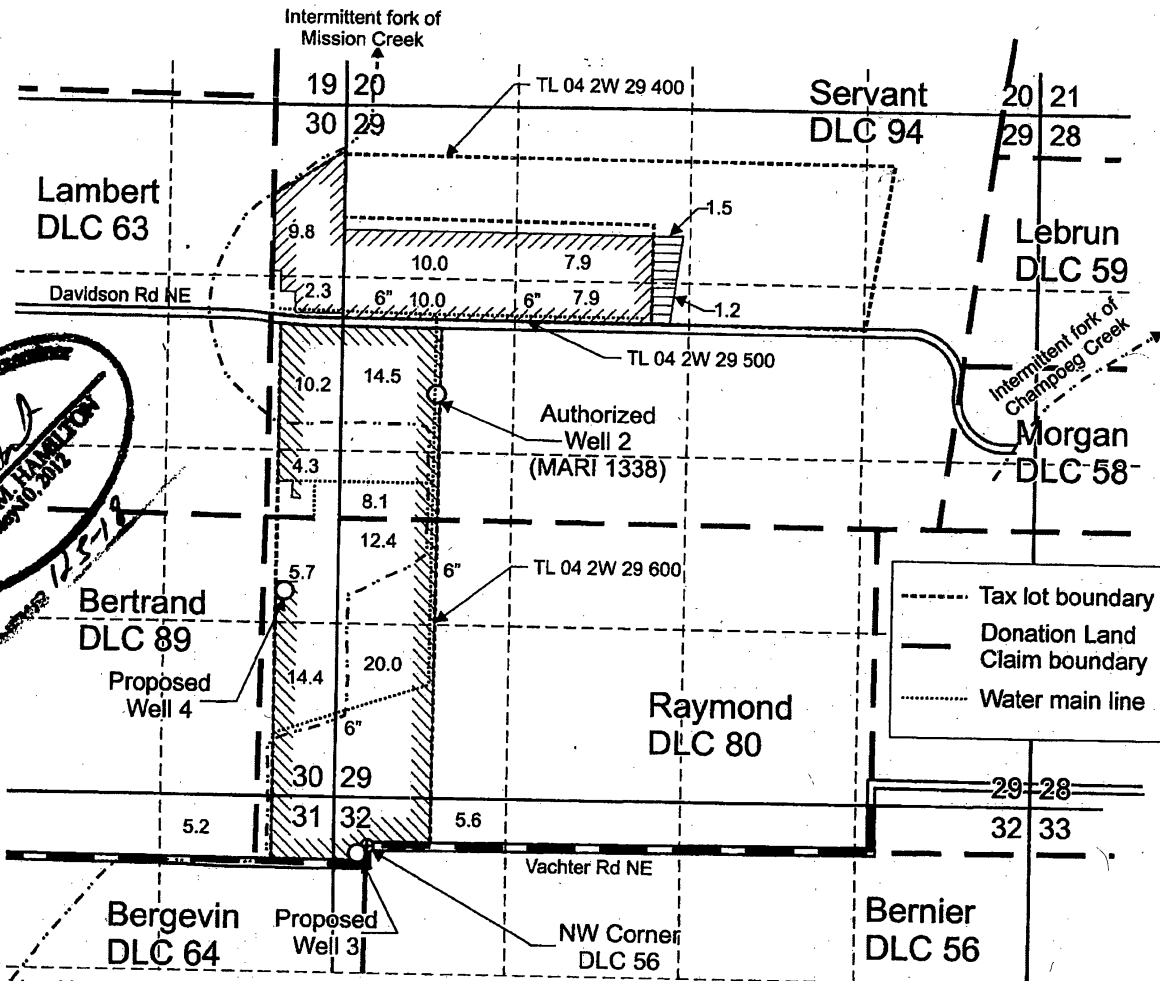

- - - - Tax lot boundary
 ——— Donation Land Claim boundary
 Water main line

Authorized Well 2 (MARI 1338) is located 3,450 feet north and 470 feet east from the NW corner, DLC 56.
 Proposed Well 3 is located 425 feet south and 180 feet east from the NW corner, Section 32.
 Proposed Well 4 is located 1,565 feet north and 400 feet west from the SE corner, Section 30.

- Area (47.9 Acres) primary irrigated under Certificate 40215, priority date 4-16-68.
- Area (2.7 Acres) primary irrigated under Certificate 40215, priority date 4-16-68, not affected by this transfer.
- Area (100.4 Acres) supplemental irrigated under Certificate 40215, priority date 4-16-68.

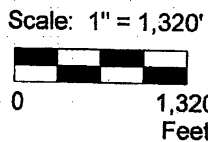

This map was prepared for the purpose of identifying the location of a water right only and is not intended to provide legal dimensions or location of property ownership lines.



Transfer Application Map
Certificate 40215

11/2016
 Revised 04/2018 RD Farms Inc. c/o Steve Davidson
 2nd Revised 08/2018 T.4S. R.2W. Sec. 29 & 30, W.M.
 3rd Revised 12/2018

Pacific Hydro-Geology Inc.

DavidsonTransMap.cdr