

Please use and attach additional pages of Table 2 as needed.
See page 5 for instructions.

Do you have questions about how to fill-out the tables?
Contact the Department at 503-986-0900 and ask for Transfer

Table 2. Description of Modifications to Registration GR-1202 (Certificate # GR-1162)

List only the part of the registration that will be modified. For the acreage in each ¼ ¼, list the modification proposed. If more than one modification, specify the acreage associated with each modification. If more than one POA, specify the acreage associated with each POA.

AUTHORIZED (the "from" or "off" lands) The listing that appears in the registration BEFORE PROPOSED CHANGES List only that part or portion of the groundwater registration that will be changed.												Proposed Changes (see "CODES" from previous page)	PROPOSED (the "to" or "on" lands) The listing as it would appear AFTER PROPOSED CHANGES are made.									
Twp	Rng	Sec	¼ ¼	Tax Lot	Gvt Lot or DLC	Acres	Type of USE listed on Certificate	POA(s) (name or number from Table 1)	Priority Date	Twp	Rng		Sec	¼ ¼	Tax Lot	Gvt Lot or DLC	Acres	New Type of USE	POA(s) to be used (from Table 1)**	Priority Date		
4	S	2	W 35 NE NE	700	82	21.312	Irrig	Well #2	1947	APOA/POU	4	S	2	W 35 NE NE	700	82	14.6	Irrig	#2 & #3	1947		
4	S	2	W 35 SE NE	700	82	23.631	Irrig	Well #2	1947	APOA/POU	4	S	2	W 35 SE NE	700	82	22.8	Irrig	#2 & #3	1947		
4	S	2	W 35 NE SE	700	82	4.500	Irrig	Well #2	1947	APOA/POU	4	S	2	W 35 NE SE	700	82	4.7	Irrig	#2 & #3	1947		
										APOA/POU	4	S	2	W 35 NE SE	100*	90	10.7	Irrig	#2 & #3	1947		
4	S	2	W 36 NW NE	700	82	3.271	Irrig	Well #2	1947													
4	S	2	W 36 SW NE	700	82	6.714	Irrig	Well #2	1947	APOA/POU	4	S	2	W 36 NW NE	700	82	3.7	Irrig	#2 & #3	1947		
4	S	2	W 36 NE NW	700	82	12.258	Irrig	Well #2	1947	APOA/POU	4	S	2	W 36 SW NE	700	82	6.5	Irrig	#2 & #3	1947		
4	S	2	W 36 NW NW	700	82	21.840	Irrig	Well #2	1947	APOA/POU	4	S	2	W 36 NE NW	700	82	14.085	Irrig	#2 & #3	1947		
4	S	2	W 36 SW NW	700	82	40.000	Irrig	Well #2	1947	APOA/POU	4	S	2	W 36 NW NW	700	82	20.5	Irrig	#2 & #3	1947		
4	S	2	W 36 SE NW	700	82	38.969	Irrig	Well #2	1947	APOA/POU	4	S	2	W 36 SW NW	700	82	36.5	Irrig	#2 & #3	1947		
4	S	2	W 36 NE SW	700	82	21.177	Irrig	Well #2	1947	APOA/POU	4	S	2	W 36 SE NW	700	82	34.5	Irrig	#2 & #3	1947		
4	S	2	W 36 NW SW	700	82	24.213	Irrig	Well #2	1947	APOA/POU	4	S	2	W 36 NE SW	700	82	21.9	Irrig	#2 & #3	1947		
										APOA/POU	4	S	2	W 36 NW SW	700	82	18.7	Irrig	#2 & #3	1947		
										APOA/POU	4	S	2	W 36 NW SW	100*	90	3.3	Irrig	#2 & #3	1947		
										APOA/POU	4	S	2	W 36 NW SW	200*	90	4.8	Irrig	#2 & #3	1947		
										APOA/POU	4	S	2	W 36 SW SW	200*	90	0.6	Irrig	#2 & #3	1947		
TOTAL ACRES						217.885	TOTAL ACRES						217.885									

Additional remarks: Acres were rounded to tenths of an acre where possible, yet certificate acres to the thousandth of an acres were kept constant as needed. *TAXLOT 100 is in tax map of Section 35(D), taxlot 200 is in tax map of Section 36(C). **The POA's here correspond to well numbers 2 & 3 (well #2 and well #3)


Received by OWRD

Transfer Map - FROM Lands

Sections 26, 35, & 36, T4S, R2W
GR-1202

Note: The areas of lands not being transferred are shown on the TO map.

Area not moving
Area being transferred

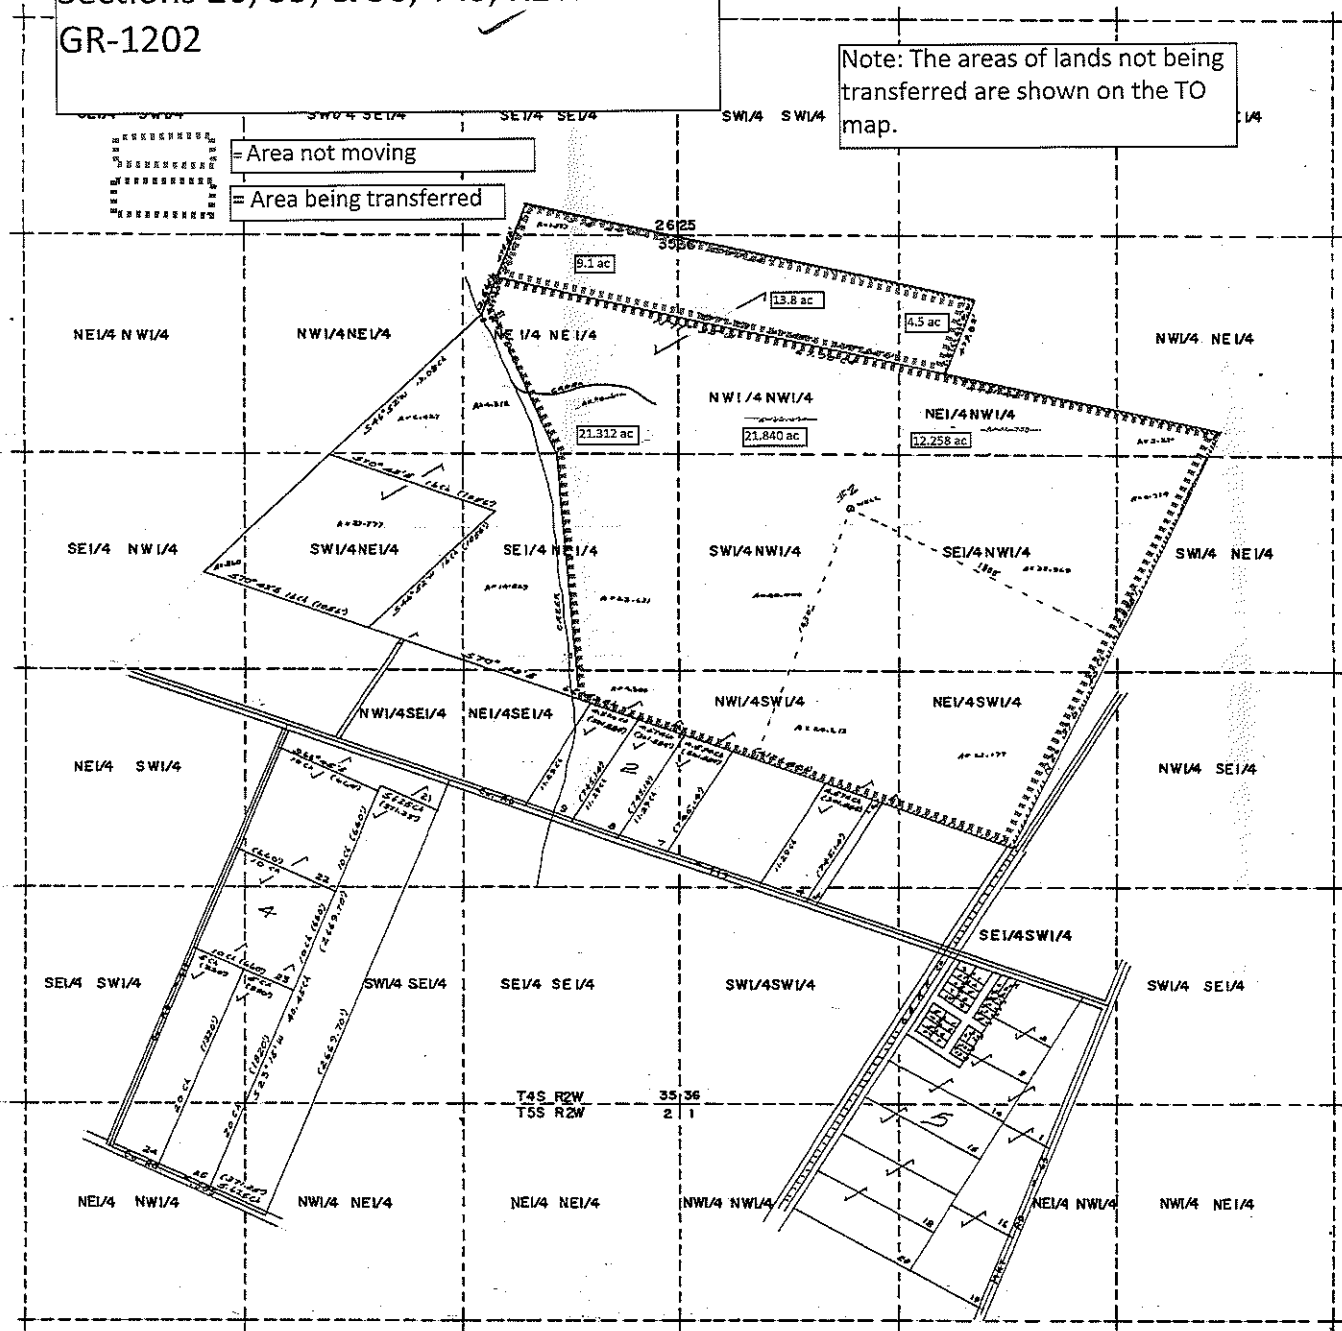

Received by OWRD

DEC 06 2019


Salem, OR

Map For Groundwater Registration Modification

Section 26, 35, & 36, T4S, R2W, Marion County
GR 1202, Cert. GR 1162



1 IN = 1320 FT
0 660 1320

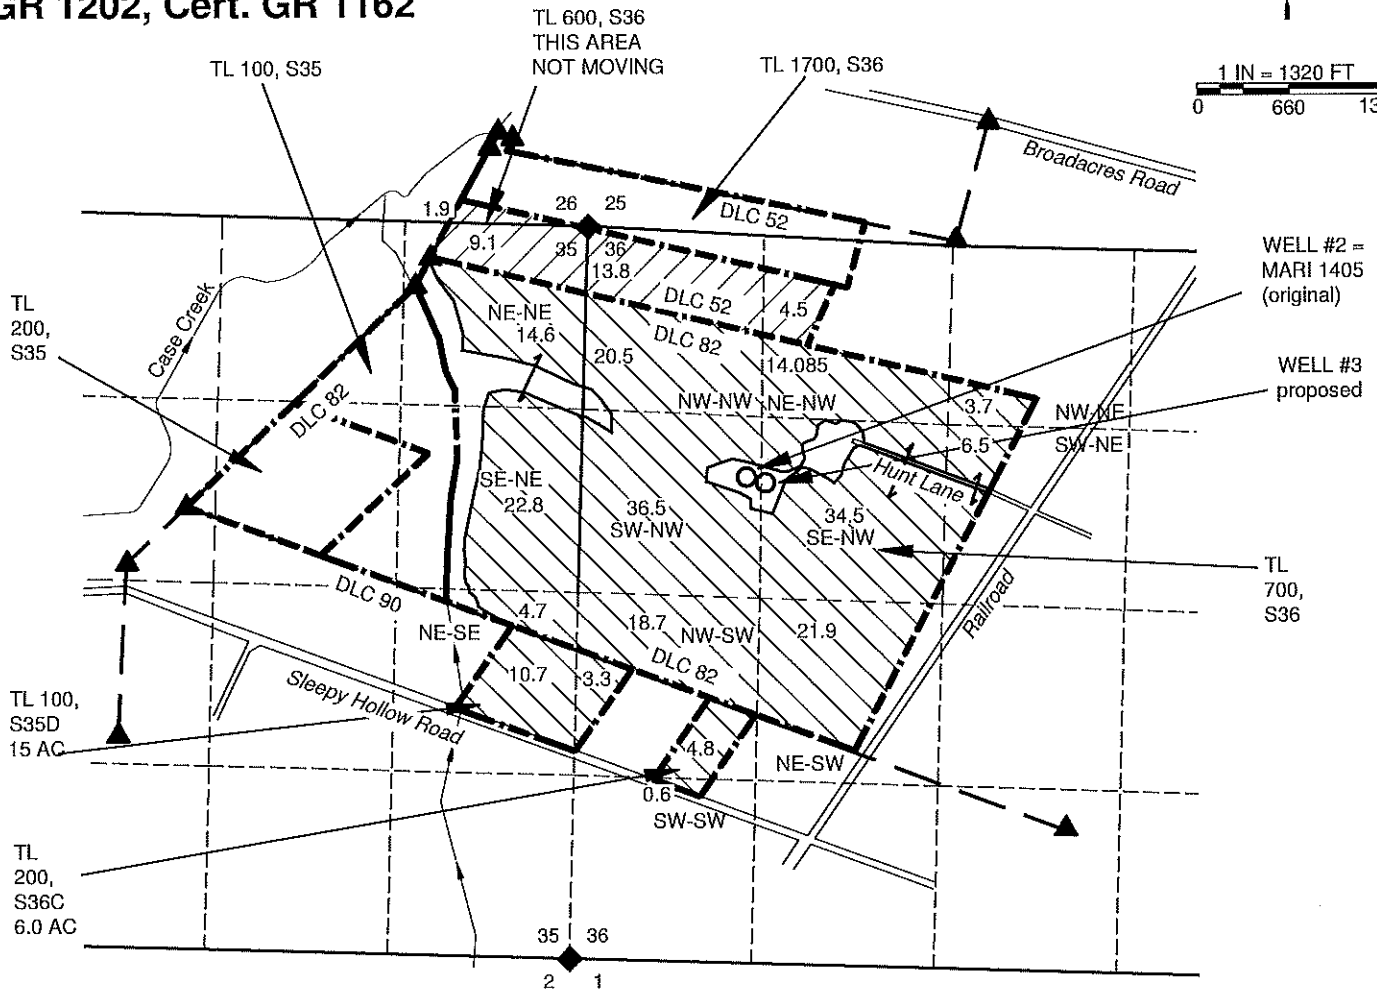

NOTES:
THIS MAP IS NOT INTENDED TO PROVIDE LEGAL DIMENSIONS OR LOCATIONS OF PROPERTY OWNERSHIP LINES.

- QUARTER-QUARTER AND DONATION LAND CLAIM (DLC) LINES ARE BASED ON THE TAX ASSESSOR MAP FOR SECTIONS 35 & 36, T4S, R2W. THE PROPERTY LINES ARE ALSO BASED ON SAID TAX MAP EXCEPT FOR THE WESTERN BOUNDARY OF TAX LOT 700, WHICH IS BASED ON THE CENTERLINE OF THE CREEK (PER DEED) AS DETERMINED FROM A 2018 AERIAL PHOTO.
- THE ORIGINAL WATER RIGHT BOUNDARY IS BASED ON AN ASSESSORY MAP FOR GR-1202, ADJUSTED TO THE TAX LOT BOUNDARY PER THE TAX MAP.
- WATER CONVEYANCE LINES SHALL BE ALL WITHIN THE PROPERTY AND THEREFORE ARE NOT SHOWN.


LOCATIONS OF POA'S
WELL #2 S35°E 1950' (per GR 1202)
WELL #3 S35°45'E & 2240'
both from NW S36

Received by OWRD

DEC 06 2019

Salem, OR

- LEGEND**
- DONATION LAND CLAIM (DLC) CORNER
 - SECTION CORNER
 - POINT OF DIVERSION (WELL)
 - STREAM OR SURFACE DRAINAGE
 - TAX LOT LINE
 - SECTION LINE
 - QUARTER-QUARTER LINE
 - DLC LINES
 - TO land
 - Land not moving

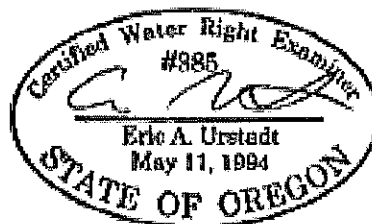

MAP BY:
ASPEN RURAL LAND CONSULTING
ERIC URSTADT, PE, PLS
971-250-1520
Dec 2019
BlueSky-Brown3A