



Oregon Water Resources Department  
725 Summer Street NE, Suite A  
Salem, Oregon 97301-1266  
(503) 986-0900  
www.wrd.state.or.us

# District Permanent Water Right Transfer Claim of Beneficial Use

RECEIVED

NOV 14 2019

OWRD

## 1. APPLICANT INFORMATION

District: Medford Irrigation District

Contact Person: Jack Friend

Phone: 541-899-9913

Mailing Address: PO Box 70

City: Jacksonville State: OR Zip: 97530

E-Mail address: Medid@medfordid.org

Transfer Number: T - 12238

## 2. WATER RIGHT(S)

Pursuant to OAR Chapter 690, Division 385, the district is submitting to the Water Resources Department this claim of beneficial use, with the appropriate fee, for the following water right(s):

PERMIT NUMBER	CERTIFICATE NUMBER	DECREE (name, volume, and page)	PRIMARY (P) OR SUPP (S)
5 -	83381		<input checked="" type="checkbox"/> P <input type="checkbox"/> S
-	83383		<input type="checkbox"/> P <input checked="" type="checkbox"/> S
-	83728		<input type="checkbox"/> P <input checked="" type="checkbox"/> S
-	80578		<input type="checkbox"/> P <input checked="" type="checkbox"/> S

P--4951

X

## 3. AUTHORIZED POINT(S) OF DIVERSION (POD) / APPROPRIATION (POA)

The authorized point(s) of diversion / appropriation for the water right modified by the transfer are as follows:

PERMIT NUMBER	DECREE or CERTIFICATE	POD / POA #	SOURCE	LOCATION - MEASURED DISTANCES
-	83381	1		N & S Forks of Little Butte Creek NF: 40' N, 620' W of E 1/4 corner Sec 20, (SE1/4NE 1/4 Sec 20) of T36, R2E, WM SF: 780' S 400' W of E1/4 corner sec 29, (NE1/4SE1/4, of sec 29) T36S, R1E, Bradshaw: SW 1/4SW1/4, Sec 8, T-36S, R1E, Bradshaw: SW1/4, SW1/4, Sec 8, T36S, R1E, all of WM
-	83383	2		9, Fourmile Lake Reservoir Fourmile: 3600' N, 4200' E from SW corner, T36S, R4E, Sec 9 Fish: 4000' S & 600' E from NE corner of Sec 4.
-	83728	3		Phoenix Canal-1500' ft. North and 100 ft East from the SE corner of DLC 59, being within the SW1/4NE1/4 of Sec 23 381W, WM.
P- 4951	80578	4		Bear Creek, tributary of Rogue River, Phoenix Canal-1500 feet North and 100 feet East of from the SE corner of DLC 59, being within the SW 1/4 NE1/4 of Section 23, Township 38 South, R1 West, WM.
		5		

6. SIGNATURES

The district certifies that it has inspected the place of use listed in Table I, and confirms the change in place of use has been completed consistent with the terms and conditions of the final order approving the transfer.

Jack G. Friend  
Signature of District Manager  
or District Board Chairperson

10-9-19  
Date

RECEIVED  
NOV 14 2019  
OWRD

Jack G. Friend  
Type or Print Name of District Manager  
or District Board Chairperson

Watson 15-01-12238  
541-773-1182  
44

### CLAIM OF BENEFICIAL USE Site Report

RECEIVED  
NOV 14 2019  
OWRD

Transfer Number: T - 12238 District Internal Notice #: T-2015-01

User Name: WATSON, DAVID & SHERRY

Place of Use: 1555 Magnolia Ave. Medford

USE	POD #	TWP	RNG	SEC	QQ	DLC	GOV'T LOT	TAX LOT	ACRES
IR	1	37	2W	34D	NE SE	X	X	201	1.50

**District Conveyance System:**

Description of Delivery System: pump out of lateral from canal to drip irr. system

Headgate: No Canal: W Main Canal

**Beneficial Use:**

Description of Beneficial Use: Landscape & Greenhouse

Method Used to Apply Water: pump & drip emitters

Method Used to Calculate Beneficial Use:

User Interviewed: ( ) Yes (x) No

Beneficial Use Made as Authorized: (x) Yes ( ) No

Description of Beneficial Use if Less than Authorized:

Inspected By: 

Date: 23 Oct 2019

**Instructions:** Attach and label the corresponding final proof map.



# JACKSON COUNTY SEC.34 T37S R2W

Watson '15-01  
T-12238  
"ON"

SCALE - 1" = 400'




NE 1/4 OF THE SE 1/4

RECEIVED

NOV 14 2019

OWRD

OWRD #: 12238

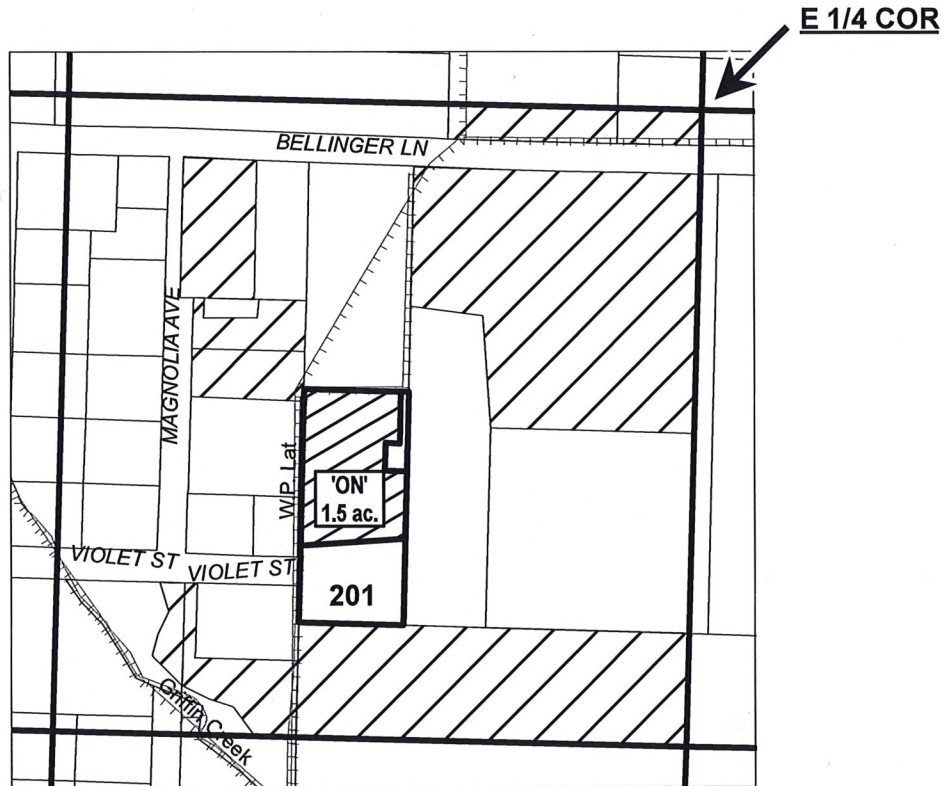

NESE -  
EXISTING RIGHT: 14.63 AC

	EXISTING WATER RIGHTS
	ON LANDS
	CANAL/LATERAL

"ON" MAP



Date: 9/30/2018

## CLAIM OF BENEFICIAL USE

NAME: DAVID & SHERRY WATSON

TAXLOT #: 201 WATSON 1.5 ACRES

37 2W 34 D1

CERTIFICATE #:

- 83381
- 83383
- 80578
- 83728
- P- 4951

CLAIM OF BENEFICIAL USE  
Site Report

RECEIVED

NOV 14 2019

OWRD

Transfer Number: T - 12238 District Internal Notice #: T-2015-01B

User Name: DANIEL HOLSTIEN

Place of Use: 5346 Devanna Dr., Eagle Point

USE	POD #	TWP	RNG	SEC	QQ	DLC	GOV'T LOT	TAX LOT	ACRES
IR	1	36	1W	36	NE SE	X	X	2400	1.00

**District Conveyance System:**

Description of Delivery System: pumps out of canal

Headgate: \_\_\_\_\_ Canal: East+ main canal

**Beneficial Use:**

Description of Beneficial Use: for lawn and shrubs

Method Used to Apply Water: sprinklers and drip systems

Method Used to Calculate Beneficial Use: The water user irrigates off of a schedule to calculate water use

User Interviewed:  Yes  No

Beneficial Use Made as Authorized:  Yes  No

Description of Beneficial Use if Less than Authorized:

The water user irrigates lawn and shrubs

Inspected By: Jeff Lucas Date: 10-3-19

**Instructions:** Attach and label the corresponding final proof map.

Holstien 15-01B  
12238  
'ON'

# JACKSON COUNTY SEC.36 T36S R1W

SCALE - 1" = 400'




NE 1/4 OF THE SE 1/4

RECEIVED

NOV 14 2019

OWRD

OWRD #: 12238

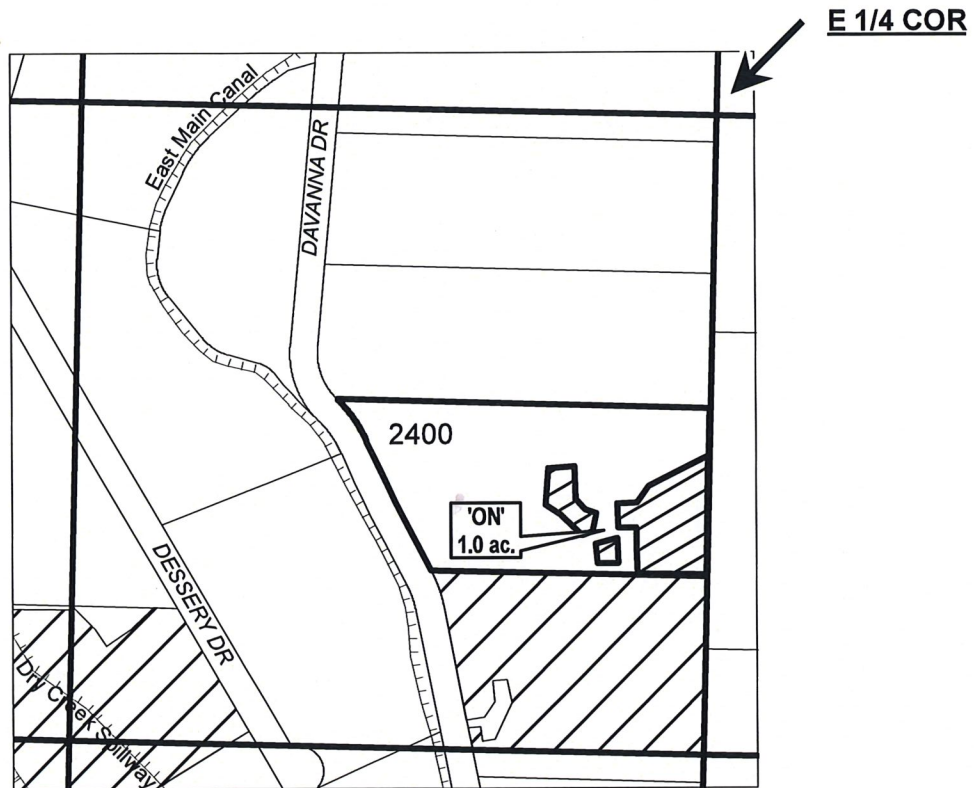

NESE -  
EXISTING RIGHT: 6.16 AC

	EXISTING WATER RIGHTS
	ON LANDS
	CANAL/LATERAL

"ON" MAP



Date: 9/30/2018

## CLAIM OF BENEFICIAL USE

NAME: DANIEL HOLSTIEN

TAXLOT #: 2400

1.0 ACRES

CERTIFICATE #:

- 83381
- 83383
- 80578
- 83728
- P- 4951

T-12238